


DETAILS

ITEM 646.63 DURABLE CROSSWALK MARKING w/ DIAGONAL LINES
 ITEM 675.20 TRAFFIC SIGNS, TYPE A
 ITEM 675.35 TRAFFIC SIGN POSTS, TYPE A

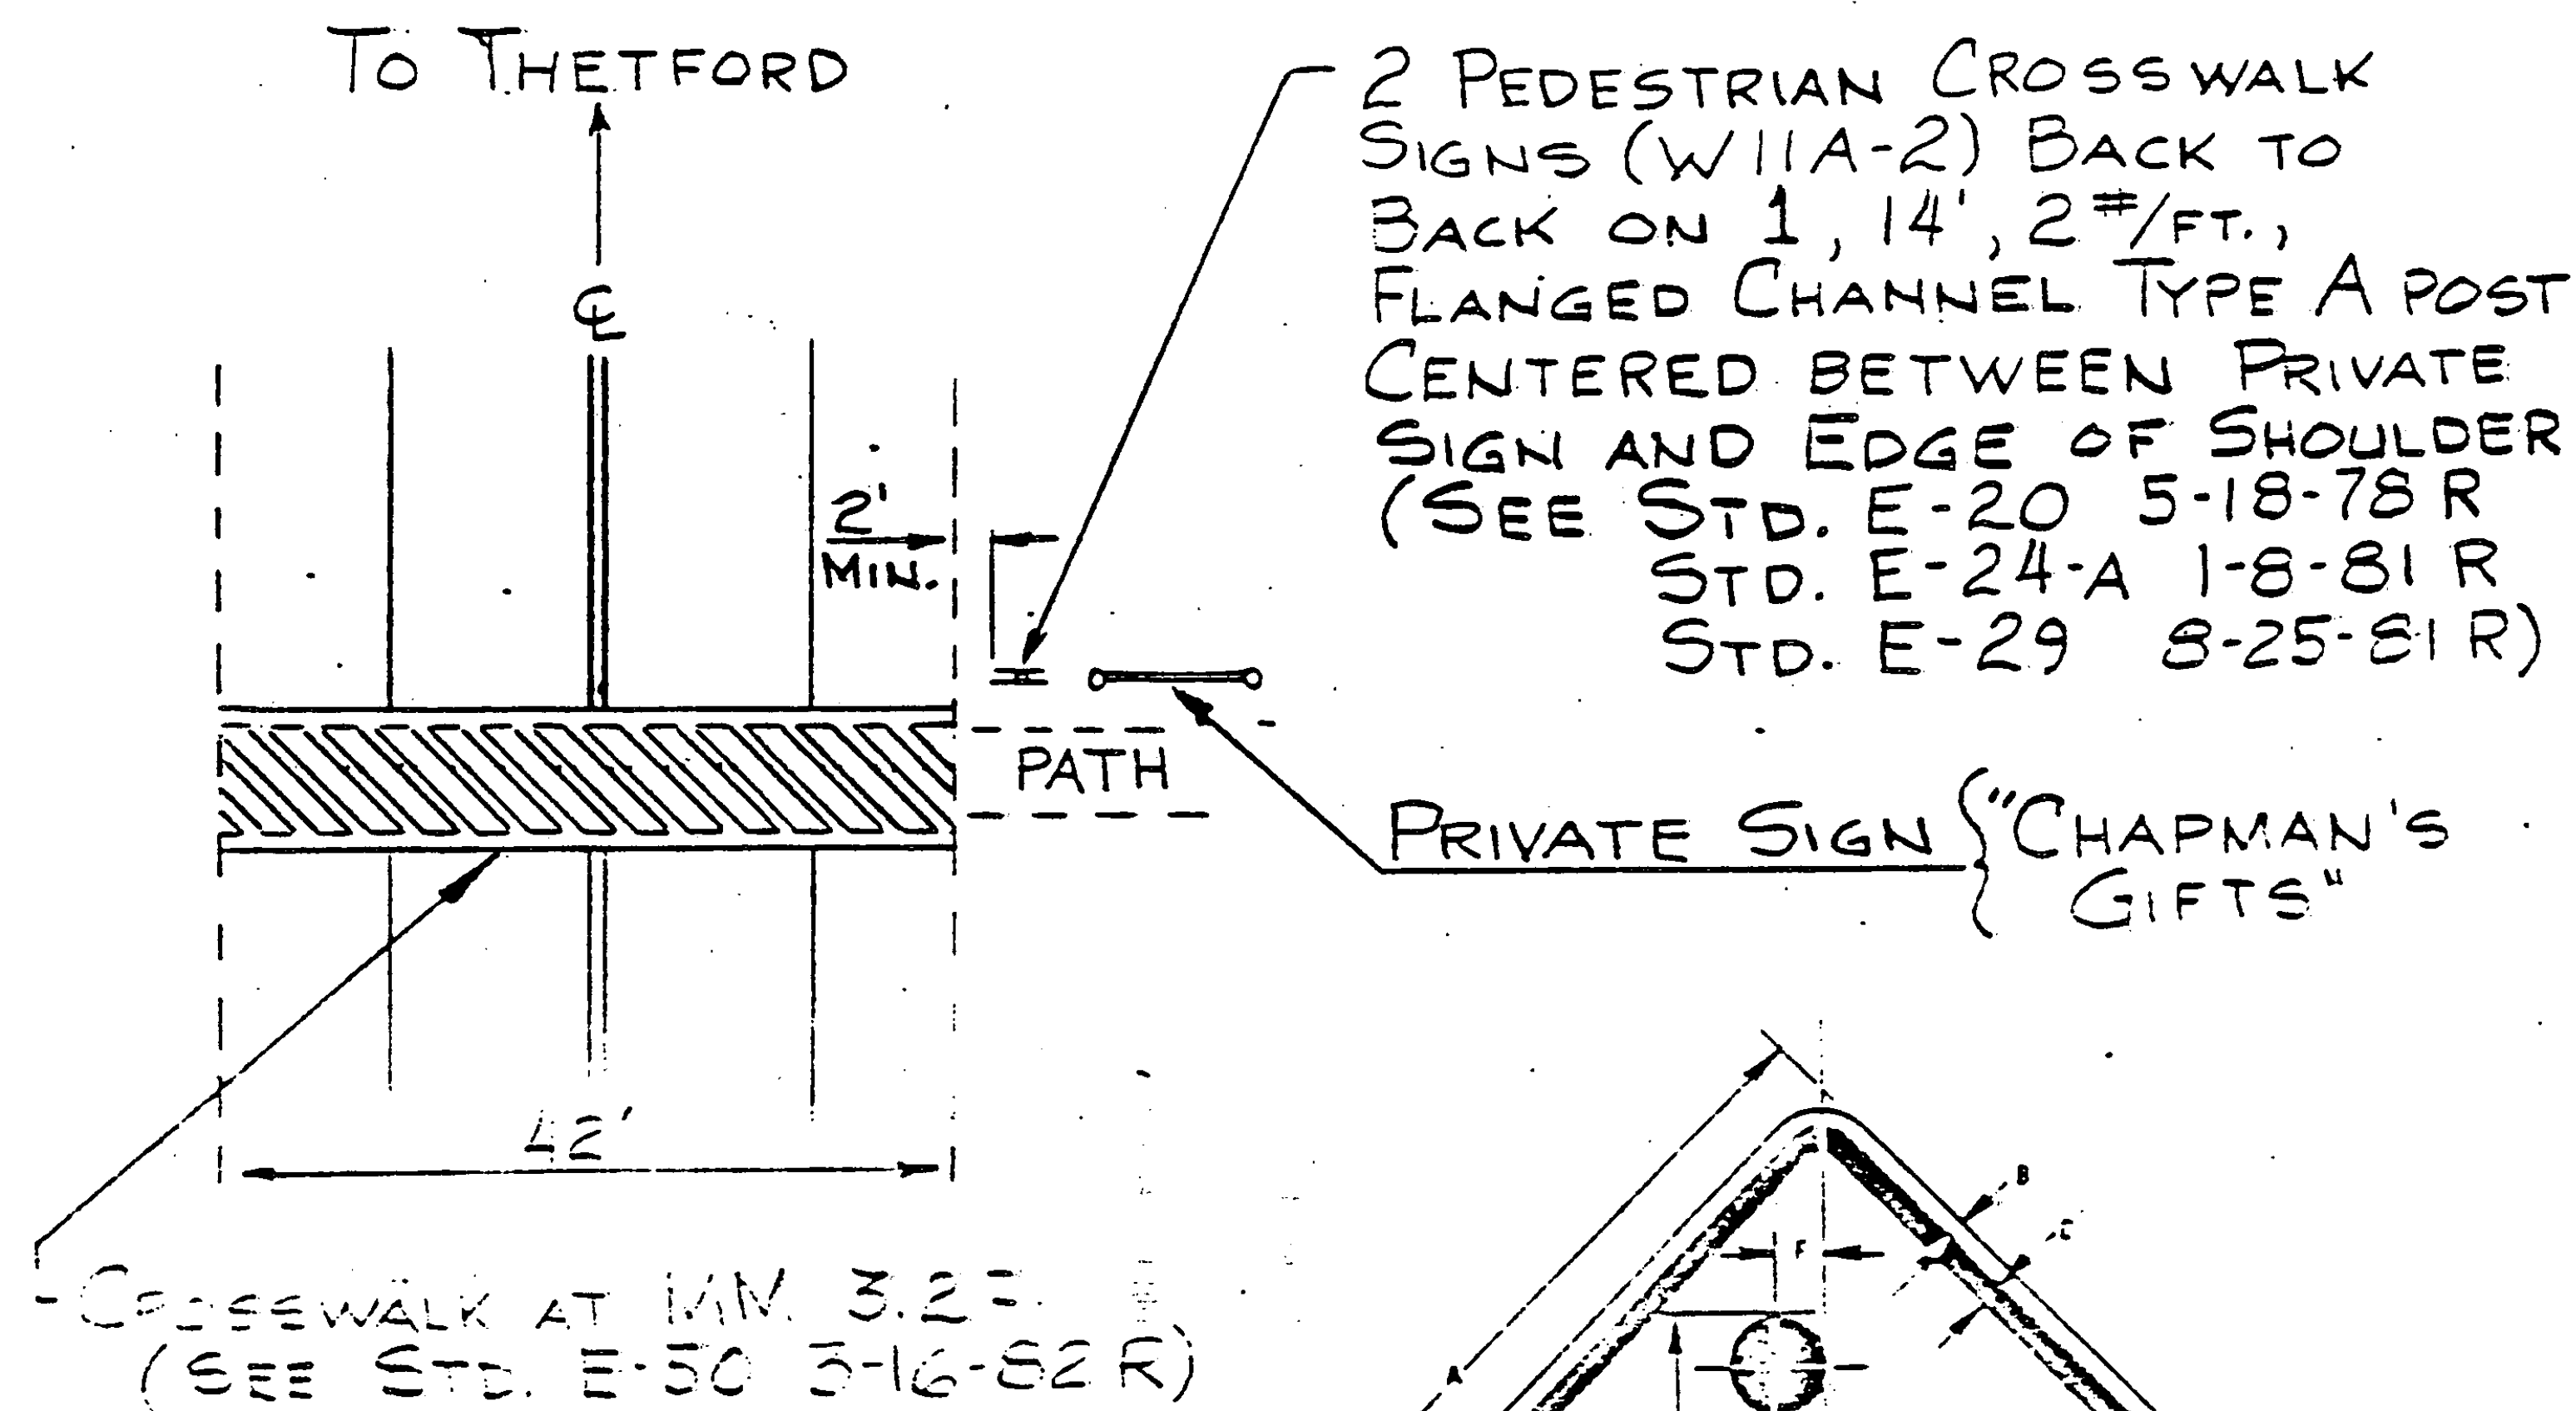

SIGN	DIMENSIONS (INCHES)								
	A	B	C	D	E	F	G	H	J
STD.	30	1/2	3/4	14	8	1-1/2	4	6	1-7/8

COLORS
 - BLACK (NON-REFL)
 BACKGROUND - YELLOW (REFL)

DIMENSIONS AND DETAIL
 FOR W11A-2 SIGN

