

VT-22A TYPICAL SECTIONS - OVERLAY SECTIONS







SEEDING FORMULA , ITEM 651.10 RURAL AREAS

2" BITUMINOUS CONCRETE PAVEMENT (TYPE II - ONE LIFT)
1/2" LEVELING COURSE TO INCLUDE SHLDRS (TYPE IV) (EST. AVE. DEPTH)

SHOULDERS: 2" BITUMINOUS CONCRETE PAVEMENT (TYPE II - ONE LIFT)
4" BITUMINOUS CONCRETE PAVEMENT (TYPE I - ONE LIFT)
12" SUBBASE OF DENSE GRADED CRUSHED STONE

% WT.	LBS./A.	NAME	PUR %	GERM %
3.33	2	CROWN VETCH	97	75
50.00	30	CREeping RED FESCUE	98	85
8.33	5	TIMOTHY	99	85
16.67	10	PERENNIAL RYE GRASS (VAR.PENNFINE)	95	85
8.34	5	ALFAFA (VAR. SARANAC)	99	85
8.33	5	BIRDSFOOT TREFOIL(VAR.EMPIRE)	98	85
5.00	3	HIGHLAND BENT GRASS	92	85
100.00	60			

THE SEED MIXTURE SHALL NOT HAVE A WEED CONTENT EXCEEDING 0.40% BY WEIGHT AND SHALL BE FREE OF ALL NOXIOUS WEED SEED.
SEED- TO BE APPLIED PER SEEDING FORMULAS DIRECTED BY THE ENGINEER.
FERTILIZER- FORMULA 10-20-10 TO BE USED WITH SEED, APPLIED AT THE RATE OF 500 LBS./ACRE. OR AS DIRECTED BY THE ENGINEER.
AGRICULTURAL LIMESTONE- TO BE APPLIED AT THE RATE OF 2 TONS/ACRE OR AS DIRECTED BY THE ENGINEER.
HAY MULCH- TO BE PLACED ON EARTH SLOPES AT THE RATE OF 2 TONS/ACRE, OR AS DIRECTED BY THE ENGINEER.
TOPSOIL- TO BE USED WITH SEED AS INDICATED ON THE PLANS, OR AS DIRECTED BY THE ENGINEER.
MARKER POSTS- TO BE PLACED AS DIRECTED BY THE ENGINEER.
SLOPE ROUNDING- ALL CUT SLOPES TO BE ROUNDED IN ACCORDANCE WITH STANDARD SHEET B-5.
PAY LIMITS OF SAND BORROW WHEN USED IN CONJUNCTION WITH UNDERDRAIN- SEE STANDARD SHEET D-2.

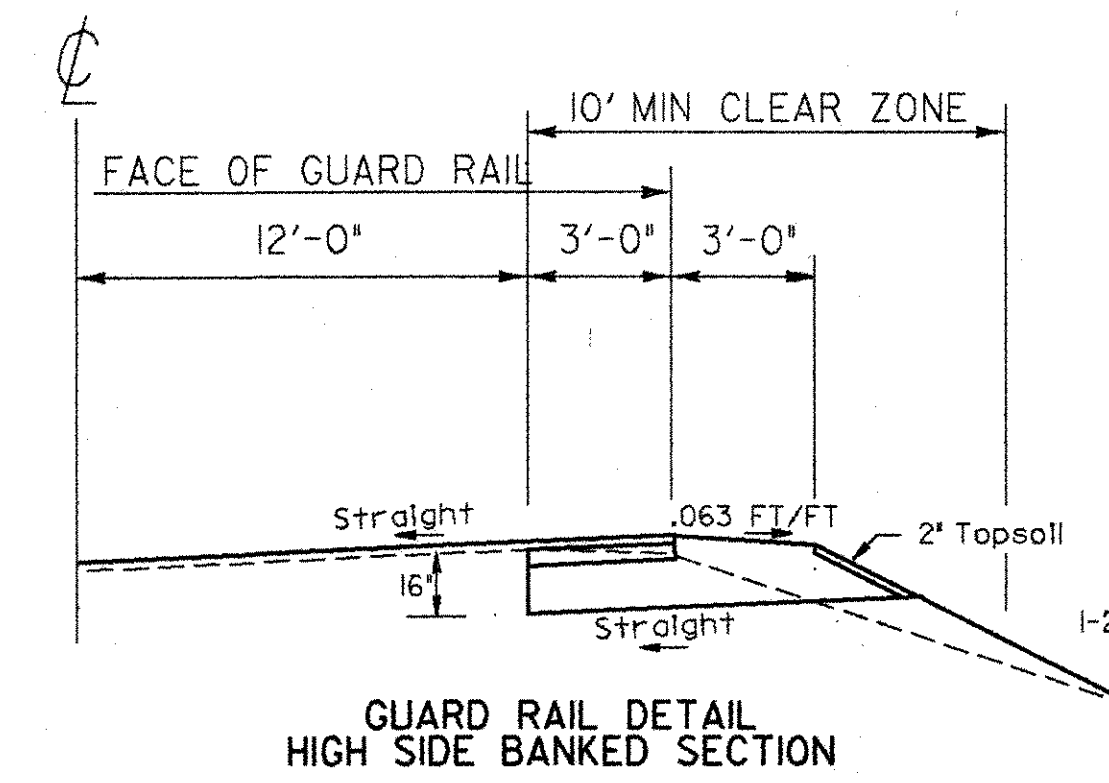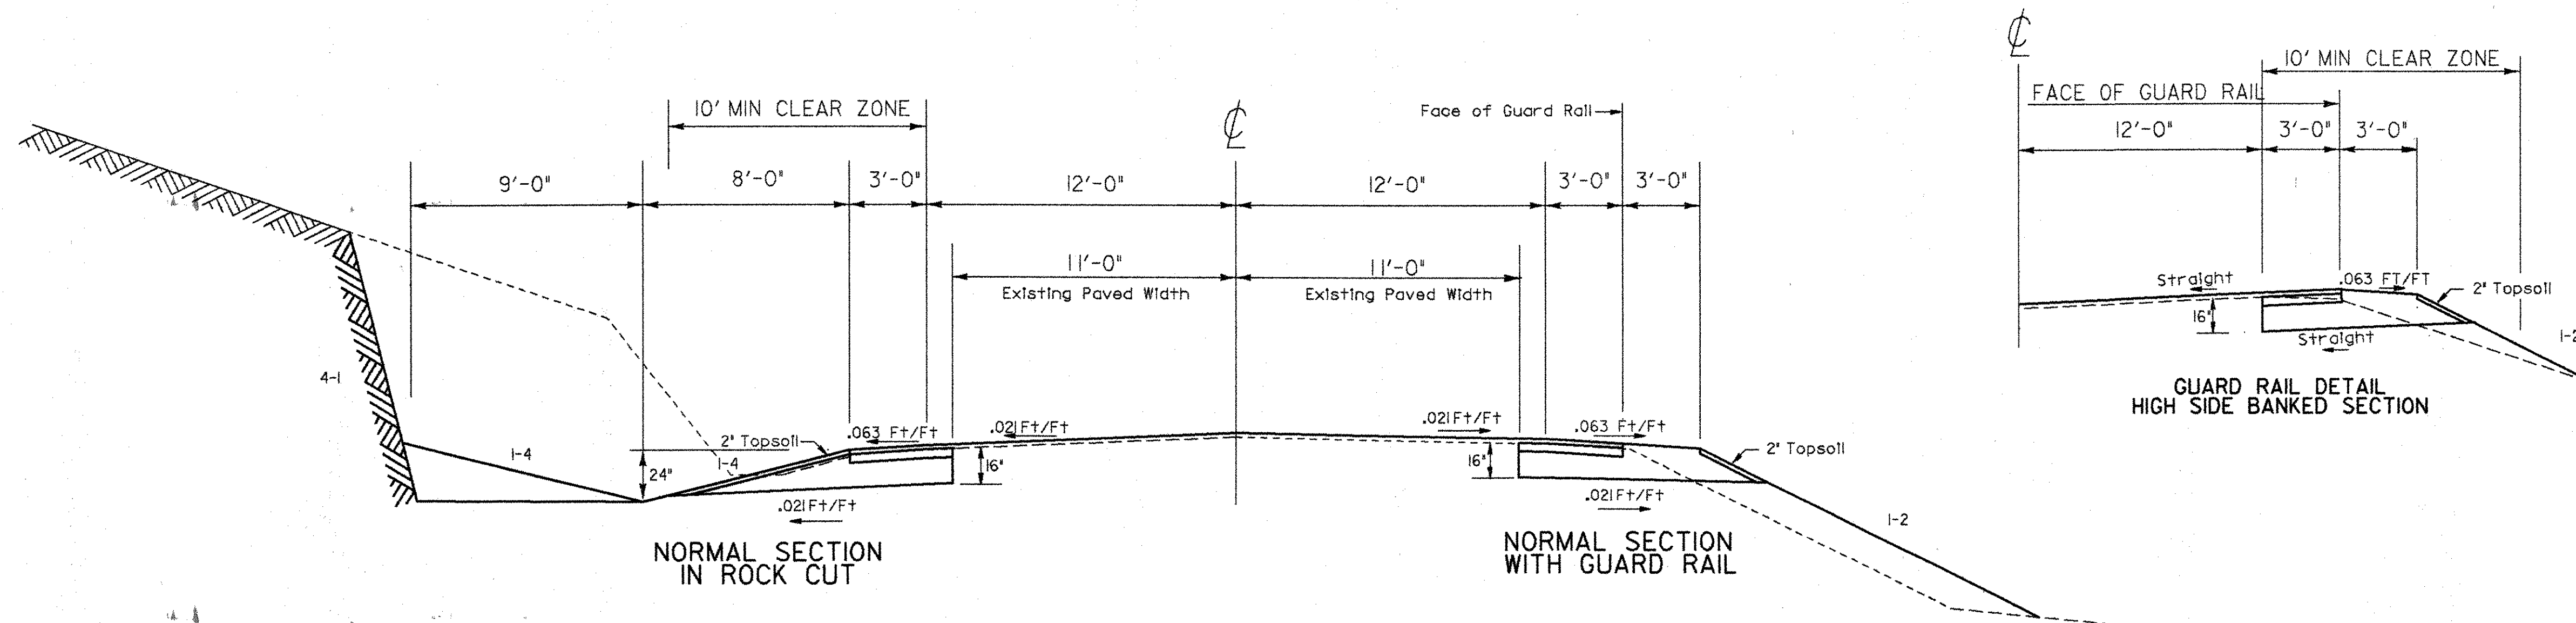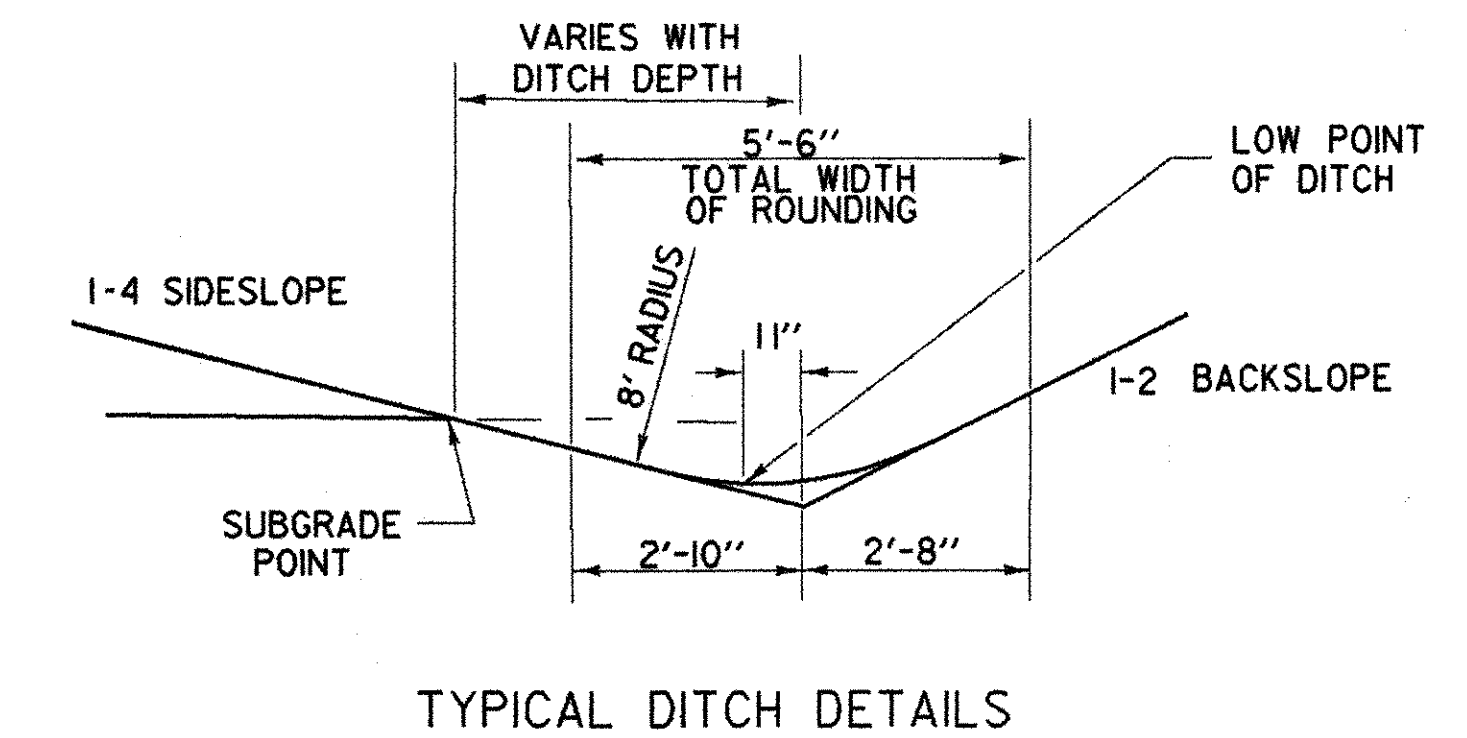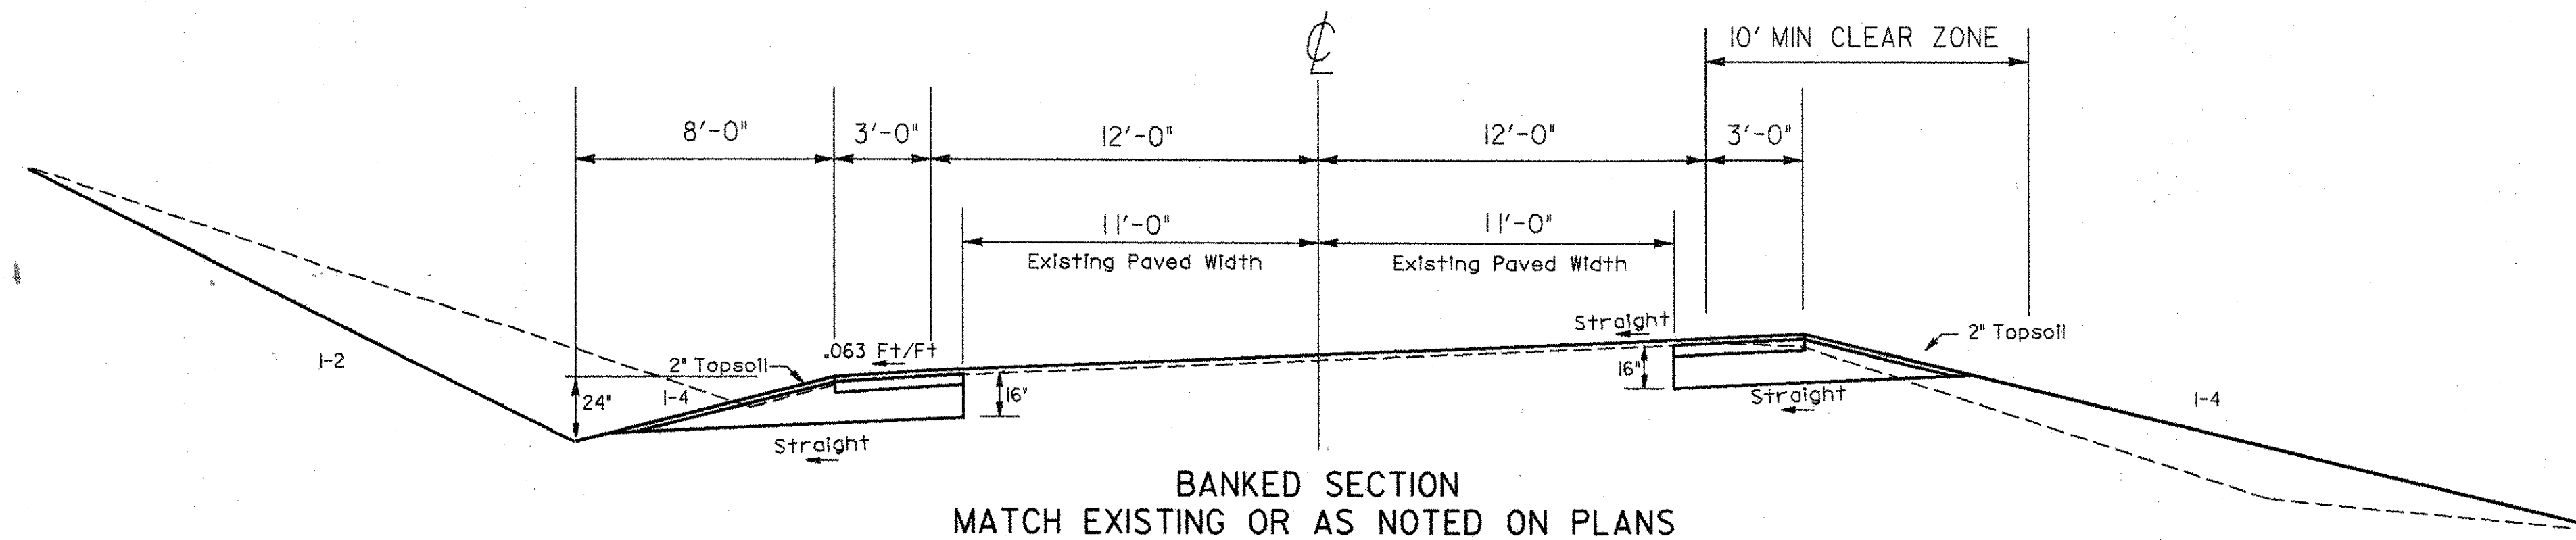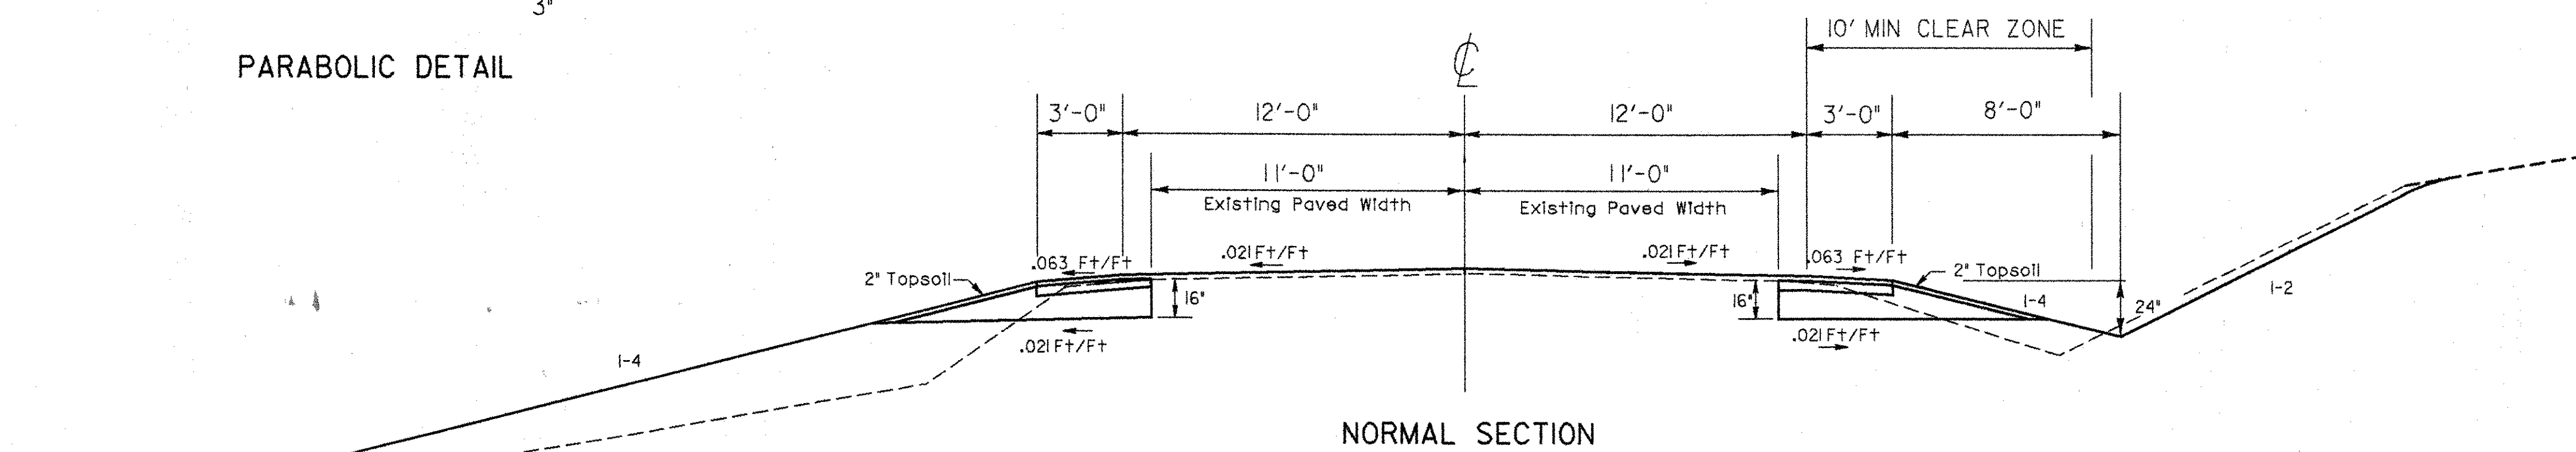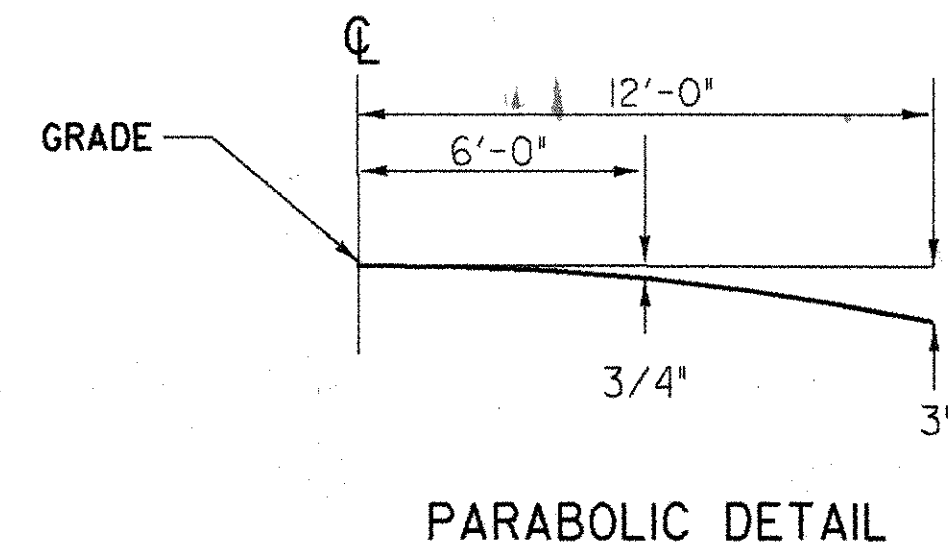

MATERIAL ITEM	THICKNESS TOLERANCE
PAVEMENT	± 1/4"
SUBBASE	± 1"
SAND BORROW	± 1"

DRAWN BY PERKINS DATE _____
SQUAD LEADER PERKINS
DESIGN FILE NO. ZF2150,70183B030TY.DGN
PRF FILE 83B030TY DATE PLOTTED 23-JUN-1989
PROJ. NAME SHOREHAM - ADDISON
PROJ. NO. F 017-1(2)
SHEET 3 OF 420 SHEETS
SHEET 3 OF 477