

REMOVAL & DISPOSAL OF GUIDE POSTS
29+00 LT. - 31+00 LT.

Removing and Resetting Fence
31+00 Rt. ~ 32+00 Rt.
39+75 Rt. ~ 41+50 Rt.


Temporary Barbed Wire Fence (4 Strand)
31+00 Rt. ~ 32+00 Rt.
39+75 Rt. ~ 41+50 Rt.

BARBED WIRE FENCE - FOUR STRAND
29+00 Rt. ~ 44+00 Rt.

WOVEN WIRE FENCE W/ WOOD POSTS
34+00 Lt. ~ 41+36 Rt.

REMOVING OF EXISTING FENCE (NON-PART)
29+00 - 44+00 Rt.

PLAN
SHEET NO. 124 OF 420
NOTE: BOOK NO. 18-A, YEAR 1939
DATE OF WORK CHECKED: 10/1/39
BY: J. B. BULLOCK

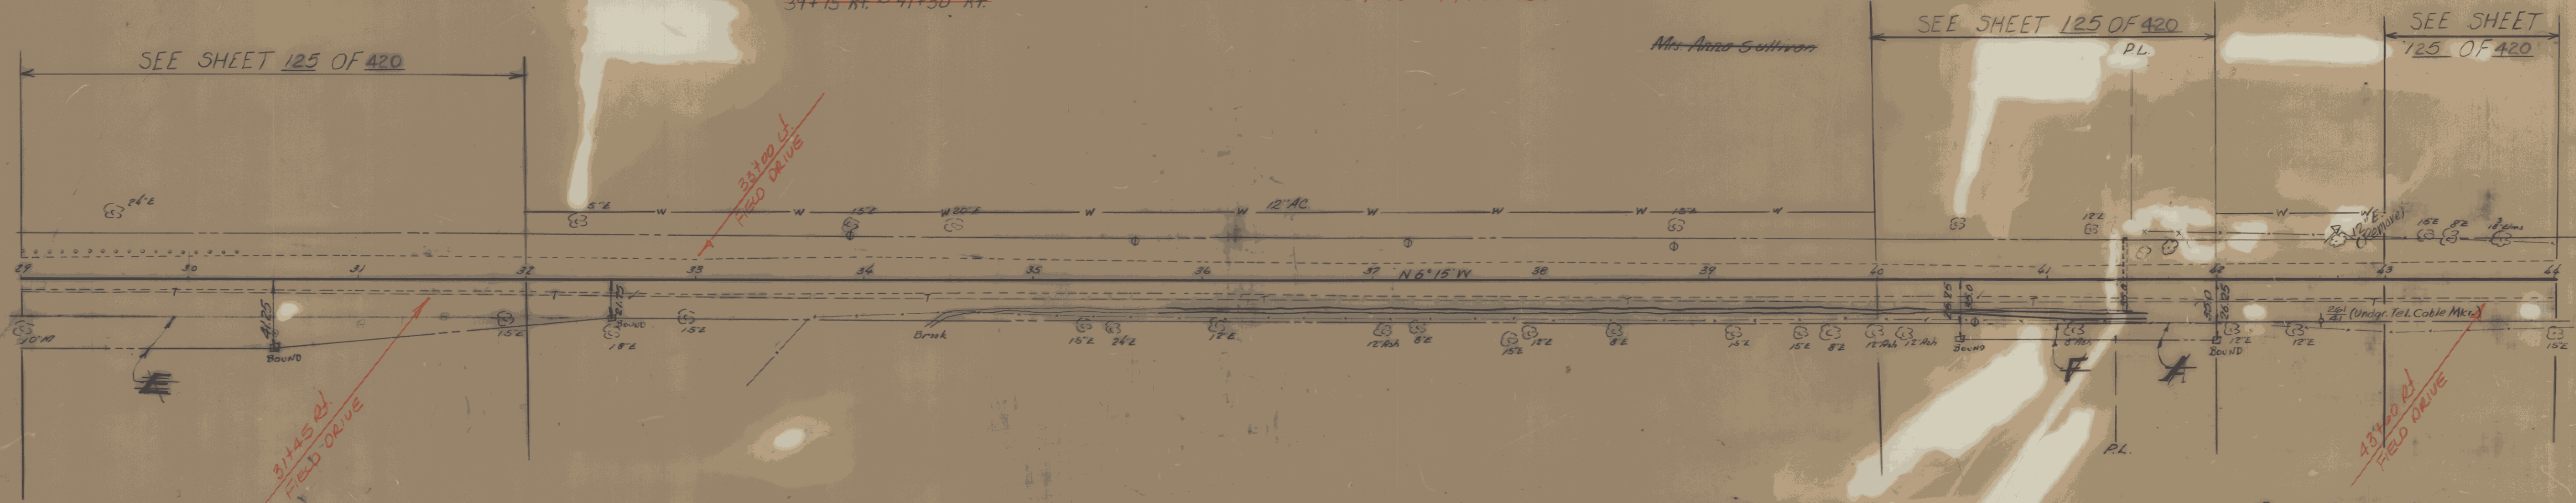

EXIST
NOTE: BURIED TELEPHONE CABLE - 25 pr.
APPROX. LOCATION 1' RT. OF RT. EDGE
OF PAVEMENT

PARCEL	INSTRUMENT	DATE	GRANTOR	GRANTEE	RECORDED	REMARKS
ET	QCD	9-7-39	MRS. ANNA SULLIVAN	ST-OF-14	18-353 9-9-39	SHOREHAM
A	QCD	9-7-39	MRS. DESSIE B. MOORE	ST-OF-14	18-353 9-9-39	SHOREHAM

SHOREHAM 32+00 ~ 40+00
MM 4.18 ~ MM 4.33
42+00 ~ 43+00
MM 4.37 ~ MM 4.39

