

Lt.
~~28+47 ~ 30+47~~
00 31+00

BM #1
SIR 12" M
Ass. Elev. 500.0

Temporary Barbed Wire Fence (4 Strand)
31+00 Rt. ~ 32+00 Rt.
39+75 Rt. ~ 41+50 Rt.

LT RT
44+00 - 44+25
(NON - PART)


SHOREHAM

MM. 4.09 ~ MM 4.18 (Sta. 27+0 ~ 32+0) See Sheets ¹²³⁵124 of 420
MM. 4.33 ~ MM 4.37 (Sta. 40+0 ~ 42+0) See Sheet 124 of 420
MM. 4.39 ~ MM 4.52 (Sta. 43+0 ~ 51+0) See Sheet 126 of 420

NOTE: 15" Basswood at Sta. 45+13.5 marking property corner shall be tied in and replaced with a bound.

CLEARING & GRUBBING

88+00 ~ 28+44 (to Const. Limits)	28+84 ~ 29+78 (to Exist. R.O.W.)
41+50 ~ 44+50 (To ROW Limits)	41+00 ~ 41+72 (to Const. Limits)
44+50 ~ 45+85 (To Construction Limits)	44+47 ~ 50+00 (To Const. Limits)
45+85 ~ 46+50 (To ROW Limits)	

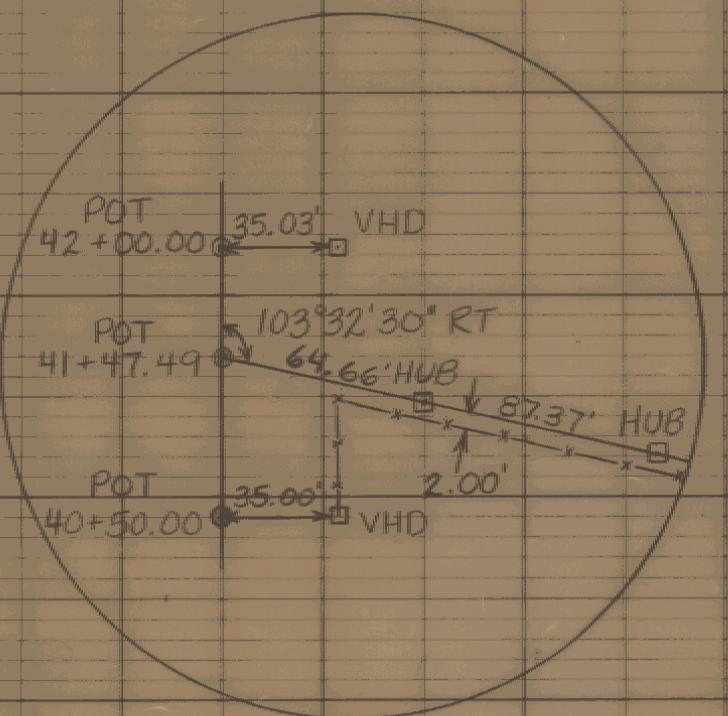

LOCATION OF PROPERTY LINE
FENCE CORNER NEEDED TO
REPLACE BOUNDS AND RELOCATE
FENCE

SHOREHAM~BRIDPORT~ADDISON
FO17-1(2)
Sheet 125 of 420
SHEET 125 OF 477