

SEE SHEET 127 OF 420

$\Delta$  5°-51'-30"  
 D 0'-45'  
 R 7639.44  
 T 390.10  
 L 781.11  
 E 9.99  
 L.C. 782.77


A=4238.17  
 D=1°30'  
 R=38198  
 T=1843  
 L=3083  
 E=3.1

A=2148  
 D=0°30'  
 R=114592  
 T=1360  
 L=2700  
 E=0.6

BARBED WIRE FENCE - 4 STRAND  
75+40 RT. ~ 81+60 RT.

REMOVAL OF EXISTING FENCE  
78+40 RT. ~ 81+60 RT.

PLAN  
 NOTE BOARD  
 NO.

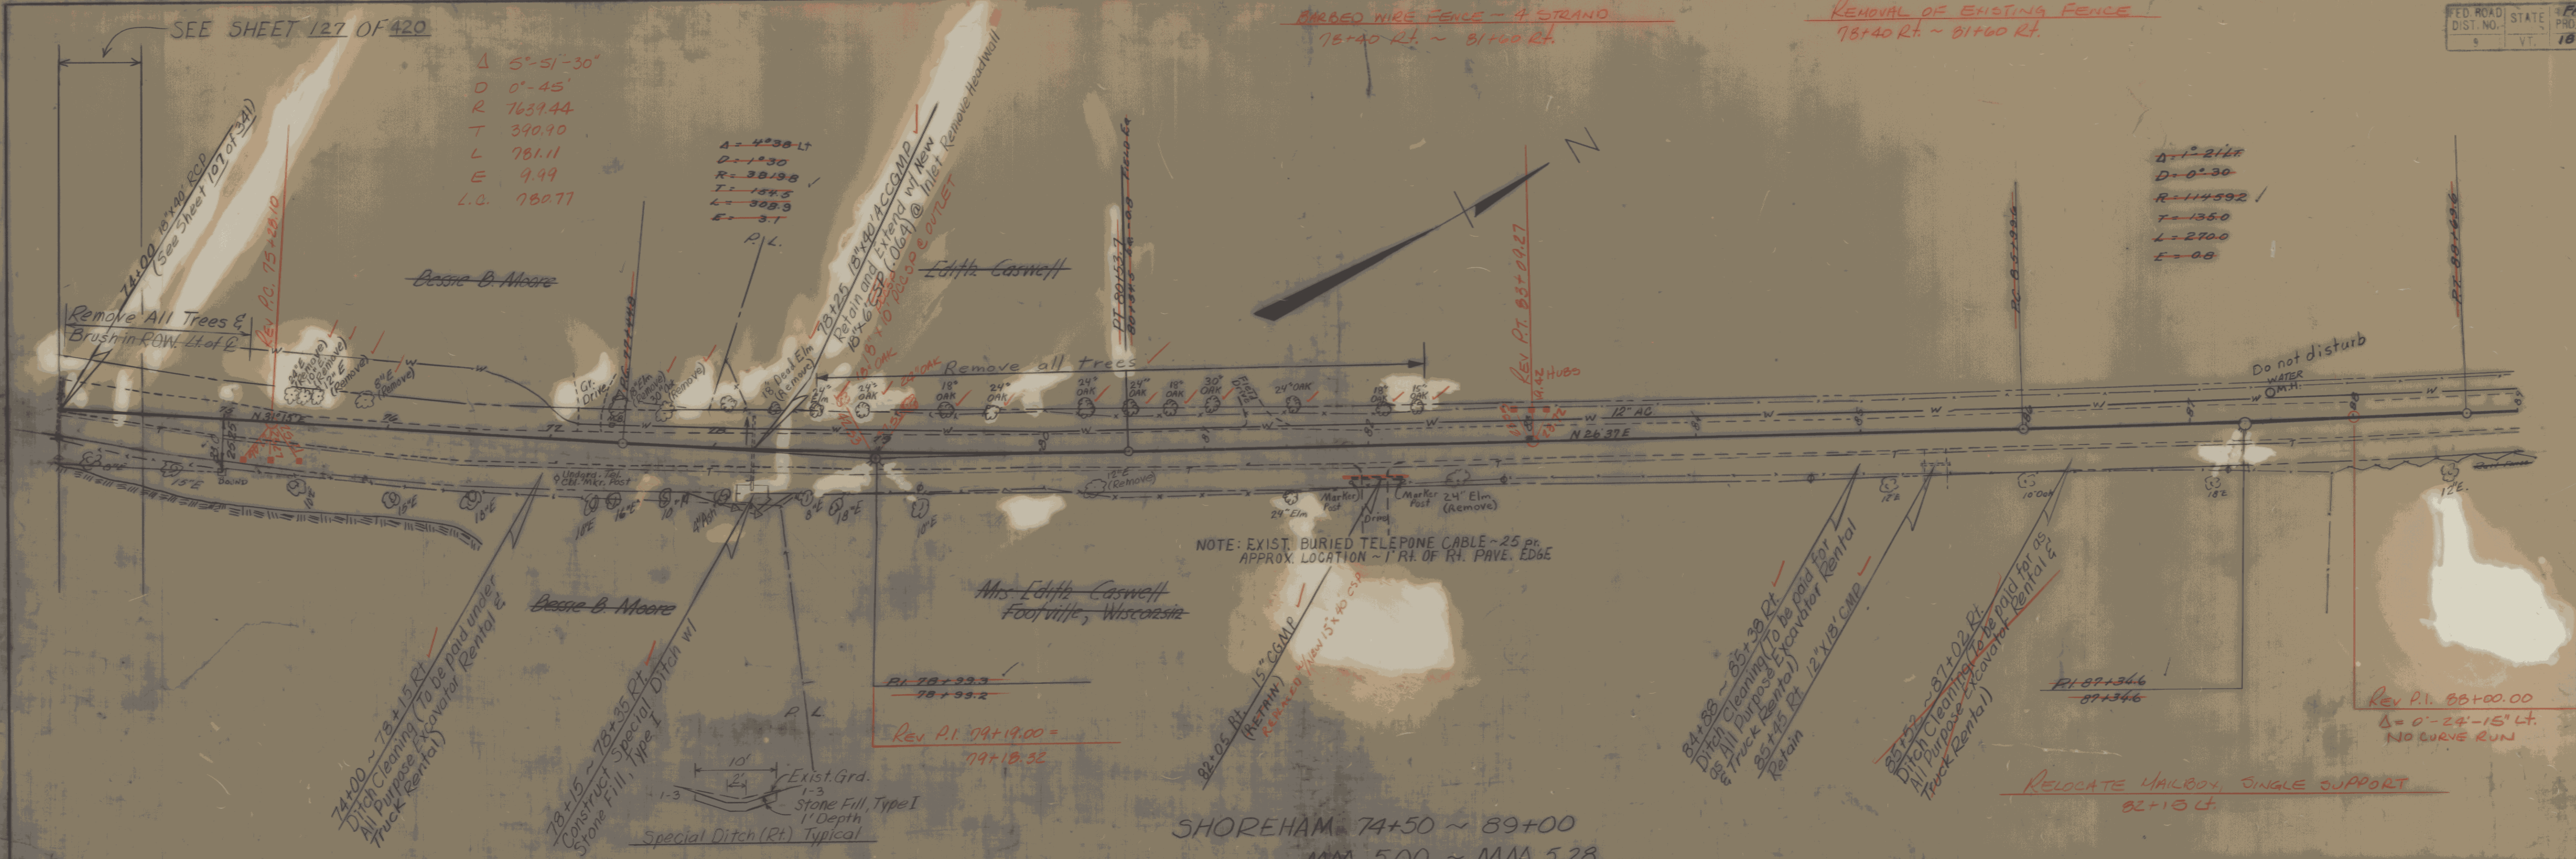

NOTE: EXIST. BURIED TELEPHONE CABLE ~ 25 PR. APPROX. LOCATION ~ 1' RT. OF RT. PAVE. EDGE

