


REMOVAL AND DISPOSAL OF GUARD RAIL
 LT. 116+00 ~ 117+70
 RT. 116+00 ~ 117+70
 54


RELOCATE MAILBOX, SINGLE SUPPORT
 116+50 LT.
 123+50 LT.

CAST IN PLACE CEMENT CONCRETE CURB, TYPE A
 LT. 123+36 ~ 124+08 (6' WIDE ISLAND)
 SEE DETAIL LEFT

Construct Drive
 LT. 130+25 (16 ft. Gravel)

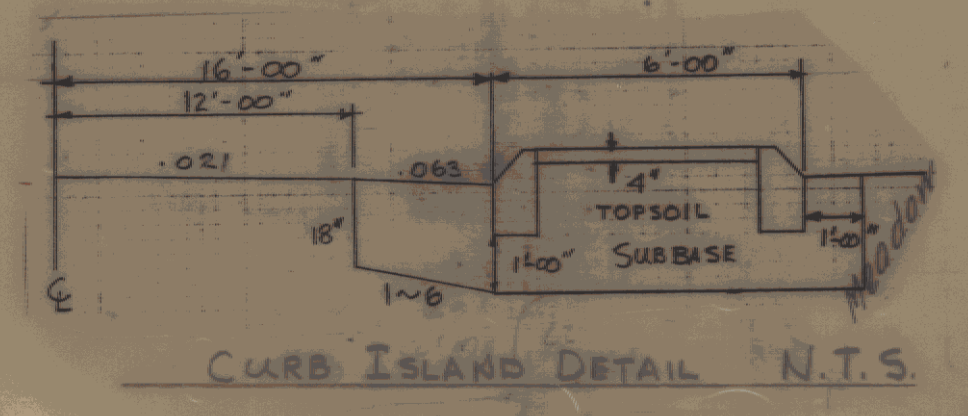

TOPSOIL
 LT. 123+36 ~ 124+08 (6' WIDE ISLAND)
 4" DEPTH OF TOPSOIL

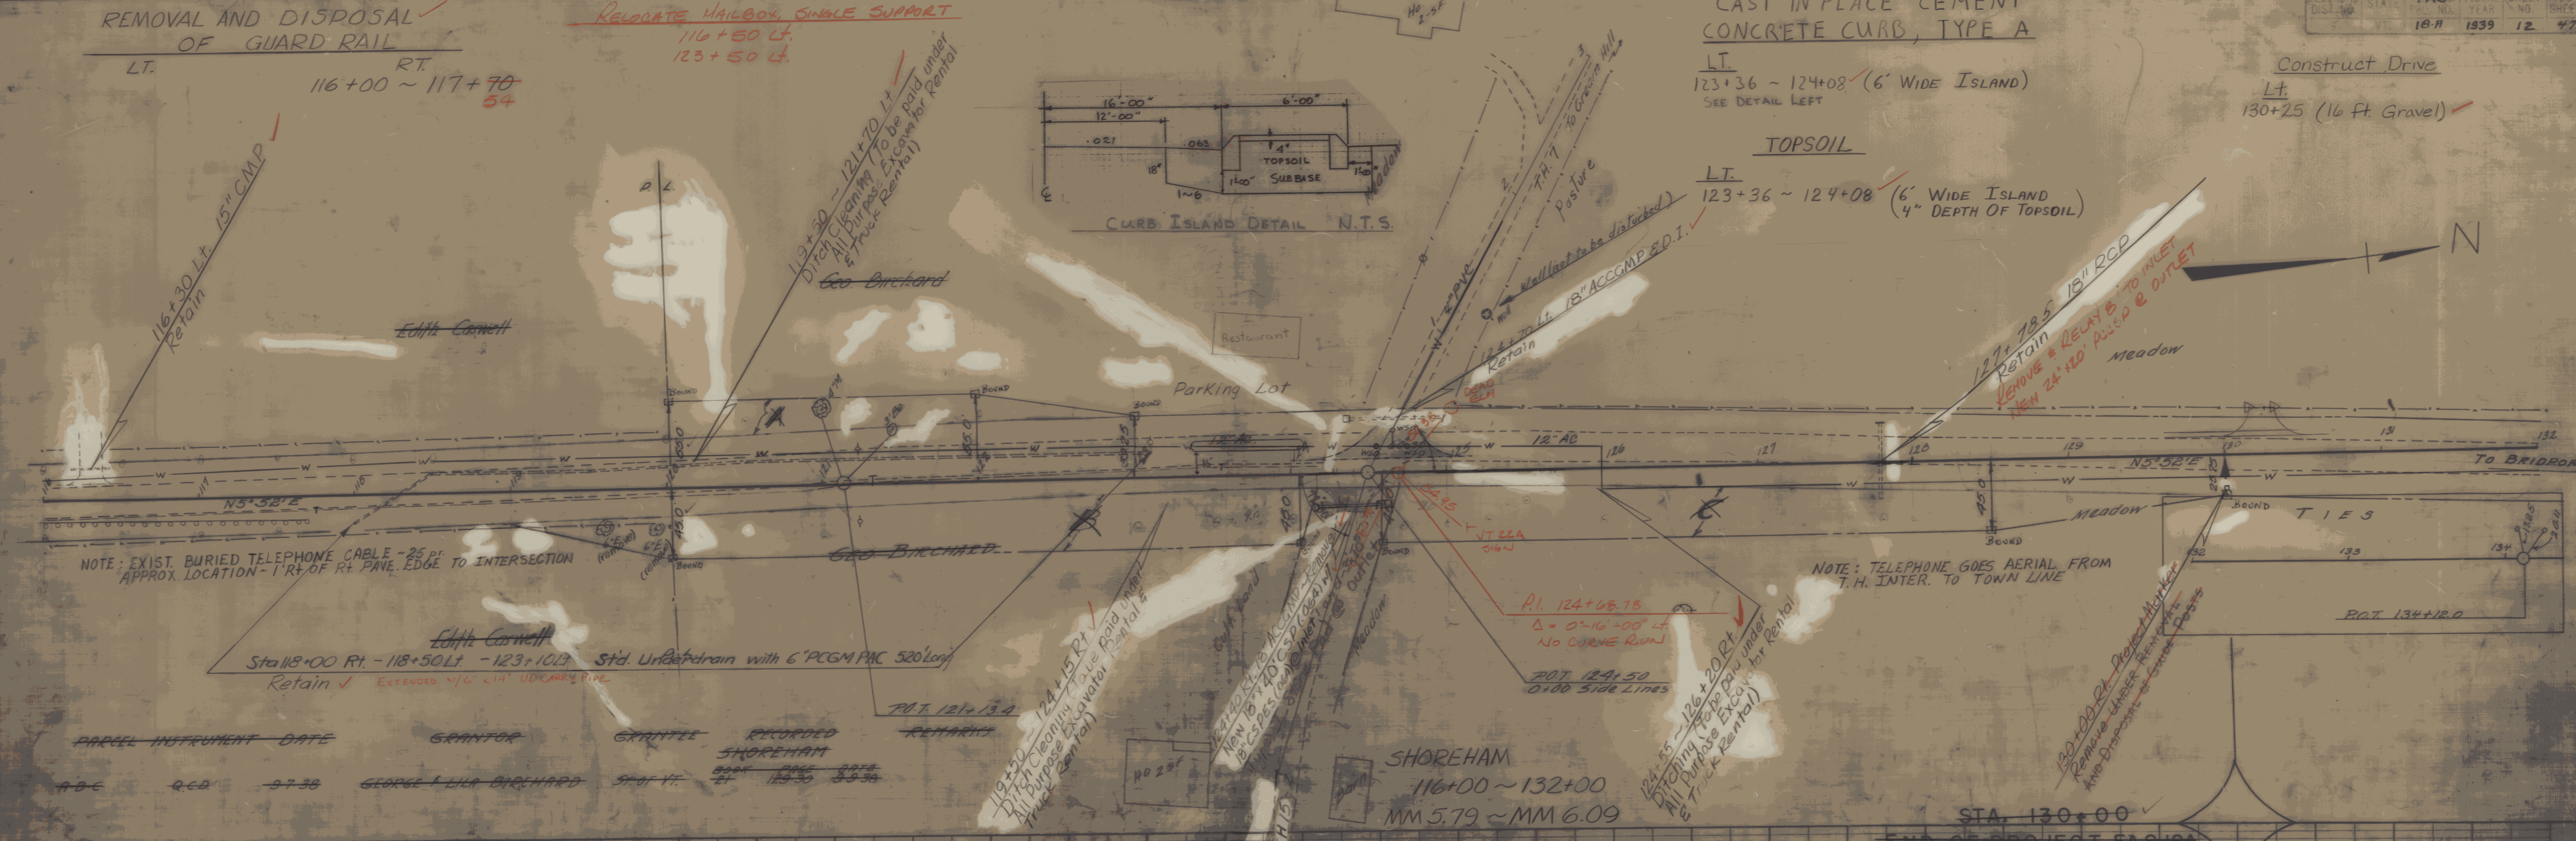

PARCEL INSTRUMENT	DATE	GRANTOR	GRANTEE	RECORDED	REMARKS
A-B-C	Q-C-D	9-7-38	GEORGE L. LARA BIRCHARD	SHOREHAM 9204 PAGE 275 21 1939 8-9-38	

