


PARCEL	INSTRUMENT	DATE	GRANTOR	GRANTEE	RECORDED BRIDPORT	REMARKS
					BOOK PAGE DATE	
A1	W.D.S.E.	10-10-46	WADE A. WALKER	ST. OF VT.	20-615-616-10-10-46	
A2	W.D.S.E.	11-21-46	L.R. & HAZEL B. PAYNE		20-620-629-11-21-46	

22'
 $\Delta 1^{\circ}29' LT.$
 $D 0^{\circ}30'$
 $R 11469.2$
 $T 145.0$
 $L 2900$
 $E 0.9$
 Do not bank

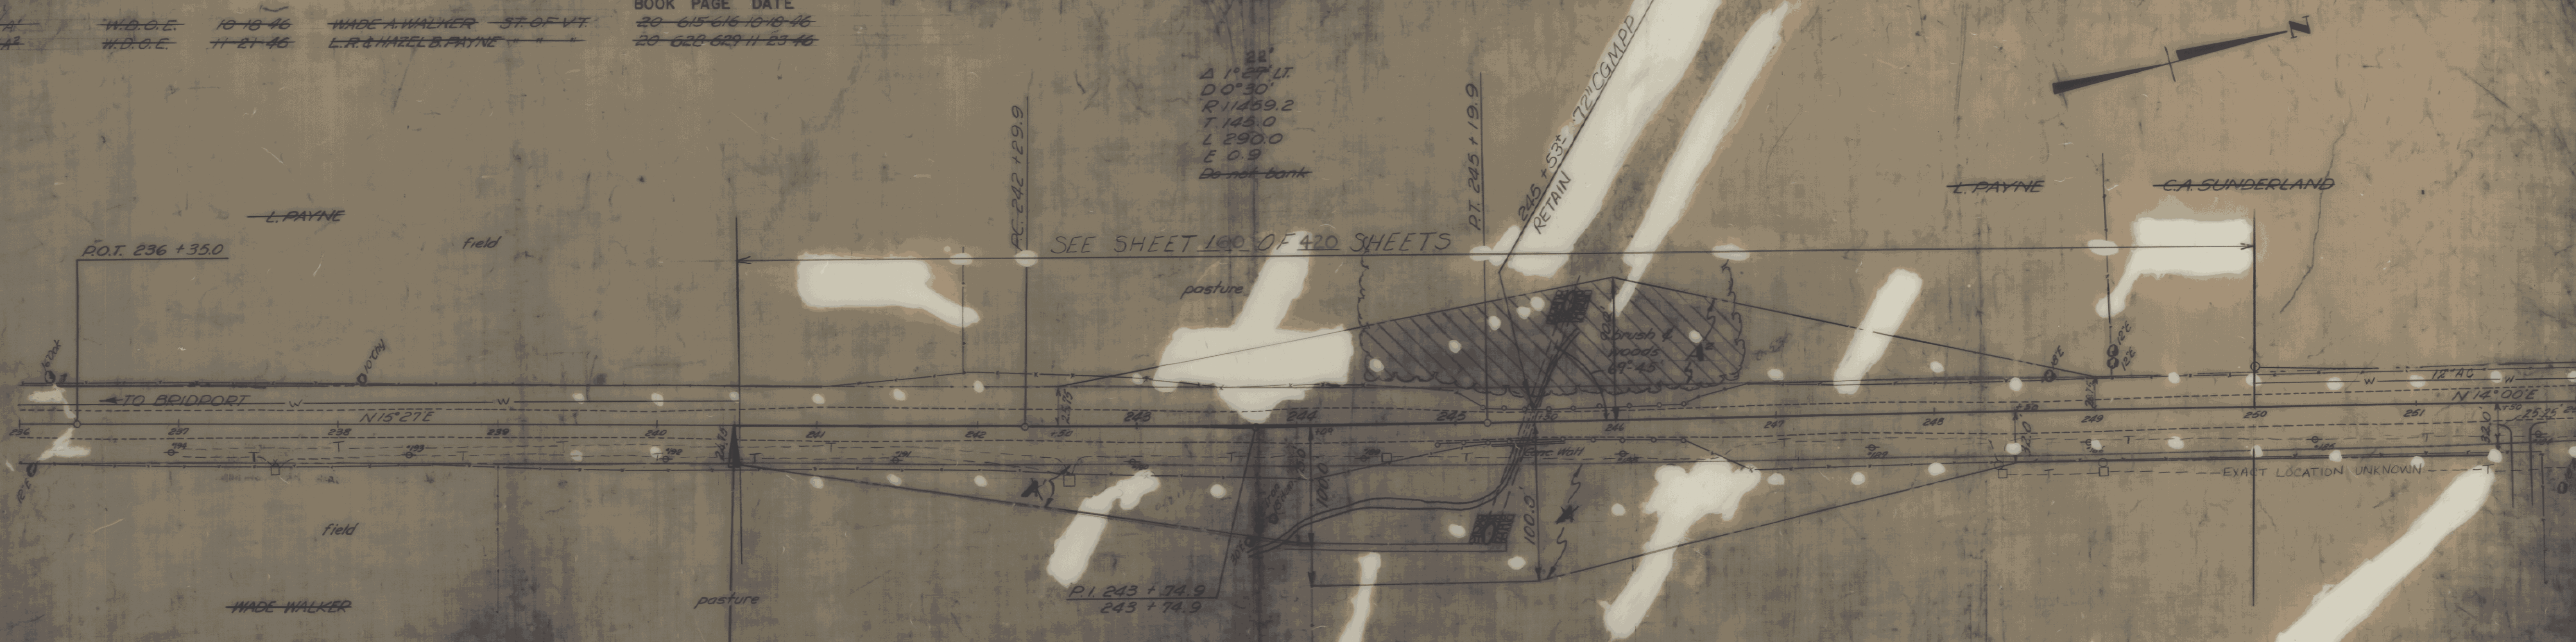

STA 240 + 48.0
BEGINNING OF PROJECT
 $S=18(3)$

M.J. PRATT
 BRIDPORT 236+00 ~ 240+50
 MM 4.47 ~ MM 4.55
 BRIDPORT 250+00 ~ 252+00
 MM 4.73 ~ MM 4.77

