


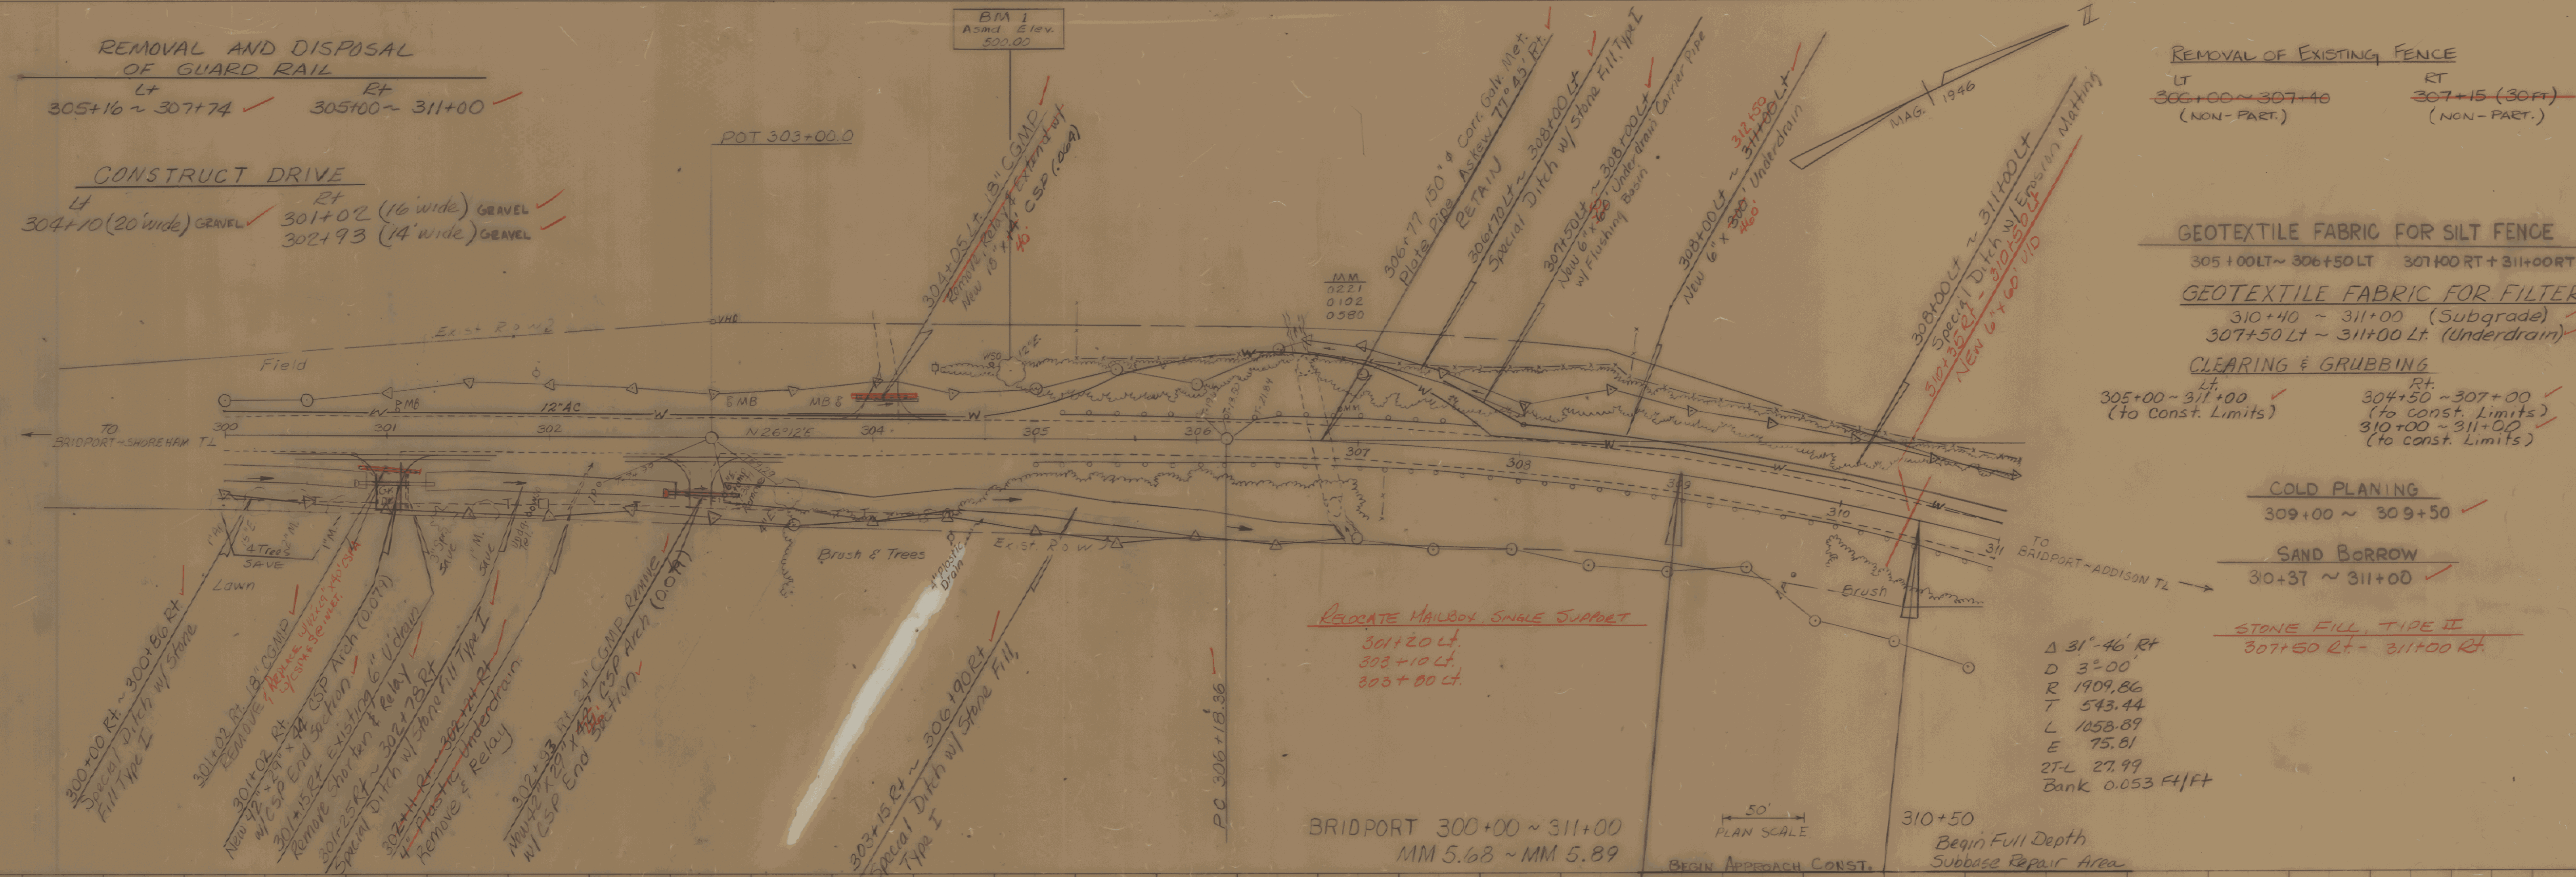

BREAKAWAY CABLE TERMINAL

LT
~~304+25 ~ 304+50~~
~~309+50 ~ 309+75~~
~~304+37.5 ~ 304+42.5~~

RT
303+25 ~ 303+50 ✓

STEEL BEAM GUARD RAIL

LT
304+50 ~ 309+50 ✓
W.S.

RT
303+50 ~ 311+00 ✓

See Sheet 150 of 420 for Details

310+50
Begin Full Depth Subbase Repair Area

