


| PARCEL | INSTRUMENT | DATE | GRANTOR | GRANTEE | RECORDED BOOK | PAGE | DATE | REMARKS |
|----------|------------|----------|-------------|------------|---------------|---------|----------|---------|
| T.A.D.C. | W.D.G.E. | 10-10-46 | W.A. RIVERS | ST. OF VT. | 29 | 624-625 | 10-18-46 | |

| FED. ROAD DIST. | STATE | PROJ. NO. | FISCAL YEAR | SHEET NO. | TOTAL SHEETS |
|-----------------|-------|-----------|-------------|-----------|--------------|
| | | 518(3) | 1946 | 9 | 117 |

REMOVAL & DISPOSAL OF GUARD RAIL
318+15 - 319+50 Rt.

RELOCATE MAILBOX, SINGLE SUPPORT
322+55 Lt.

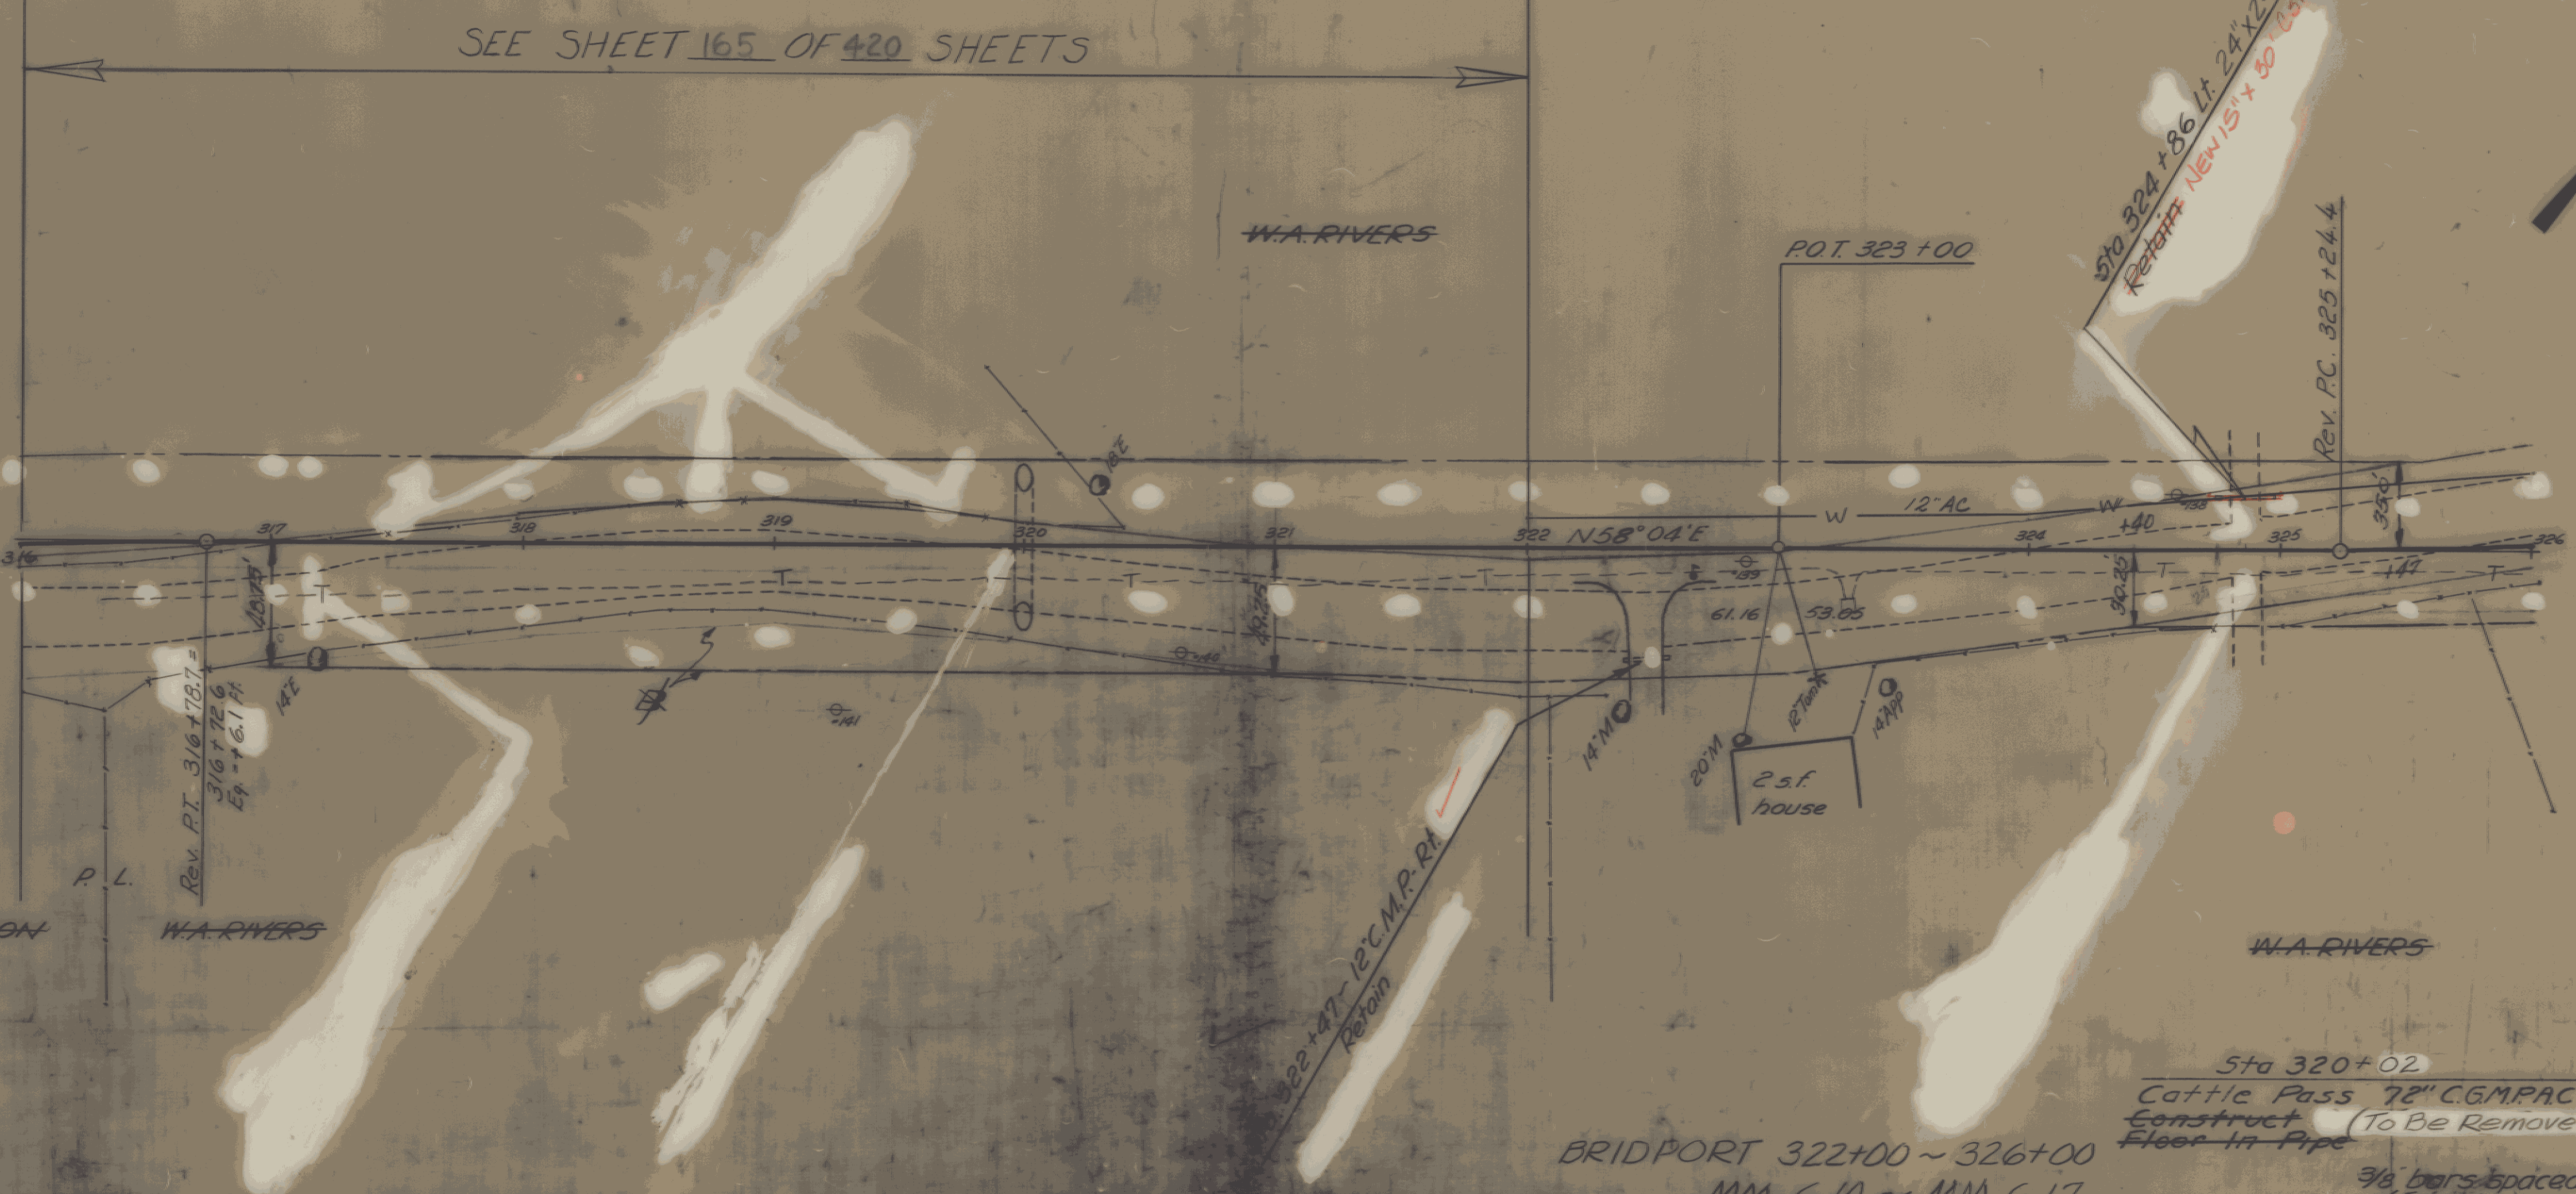

| PLAN | REVISED | BY | DATE |
|-----------|---------|----|----------|
| PLANNED | Checked | | 10-10-46 |
| ALIGNED | Checked | | 10-10-46 |
| NOTE BOOK | Checked | | 10-10-46 |
| NO. | | | |

