


CONSTRUCT TURNOUT (Mailbox)
523+00 ~ 523+50 Lt. ✓
RELOCATE MAILBOX, SINGLE SUPPORT

523+25 Lt.
524+50 Lt.
524+00 Lt.
532+90 Lt.
536+90 Lt.
CHAS SEEGER

FIELD DRIVE
L. 523+15
R. 529+35
524+45
534+45
537+25

A 1'-39' Lt.
D 0'-15'
P 22918.3
T 330.0
L 660.0
E 2.5
Do not bank

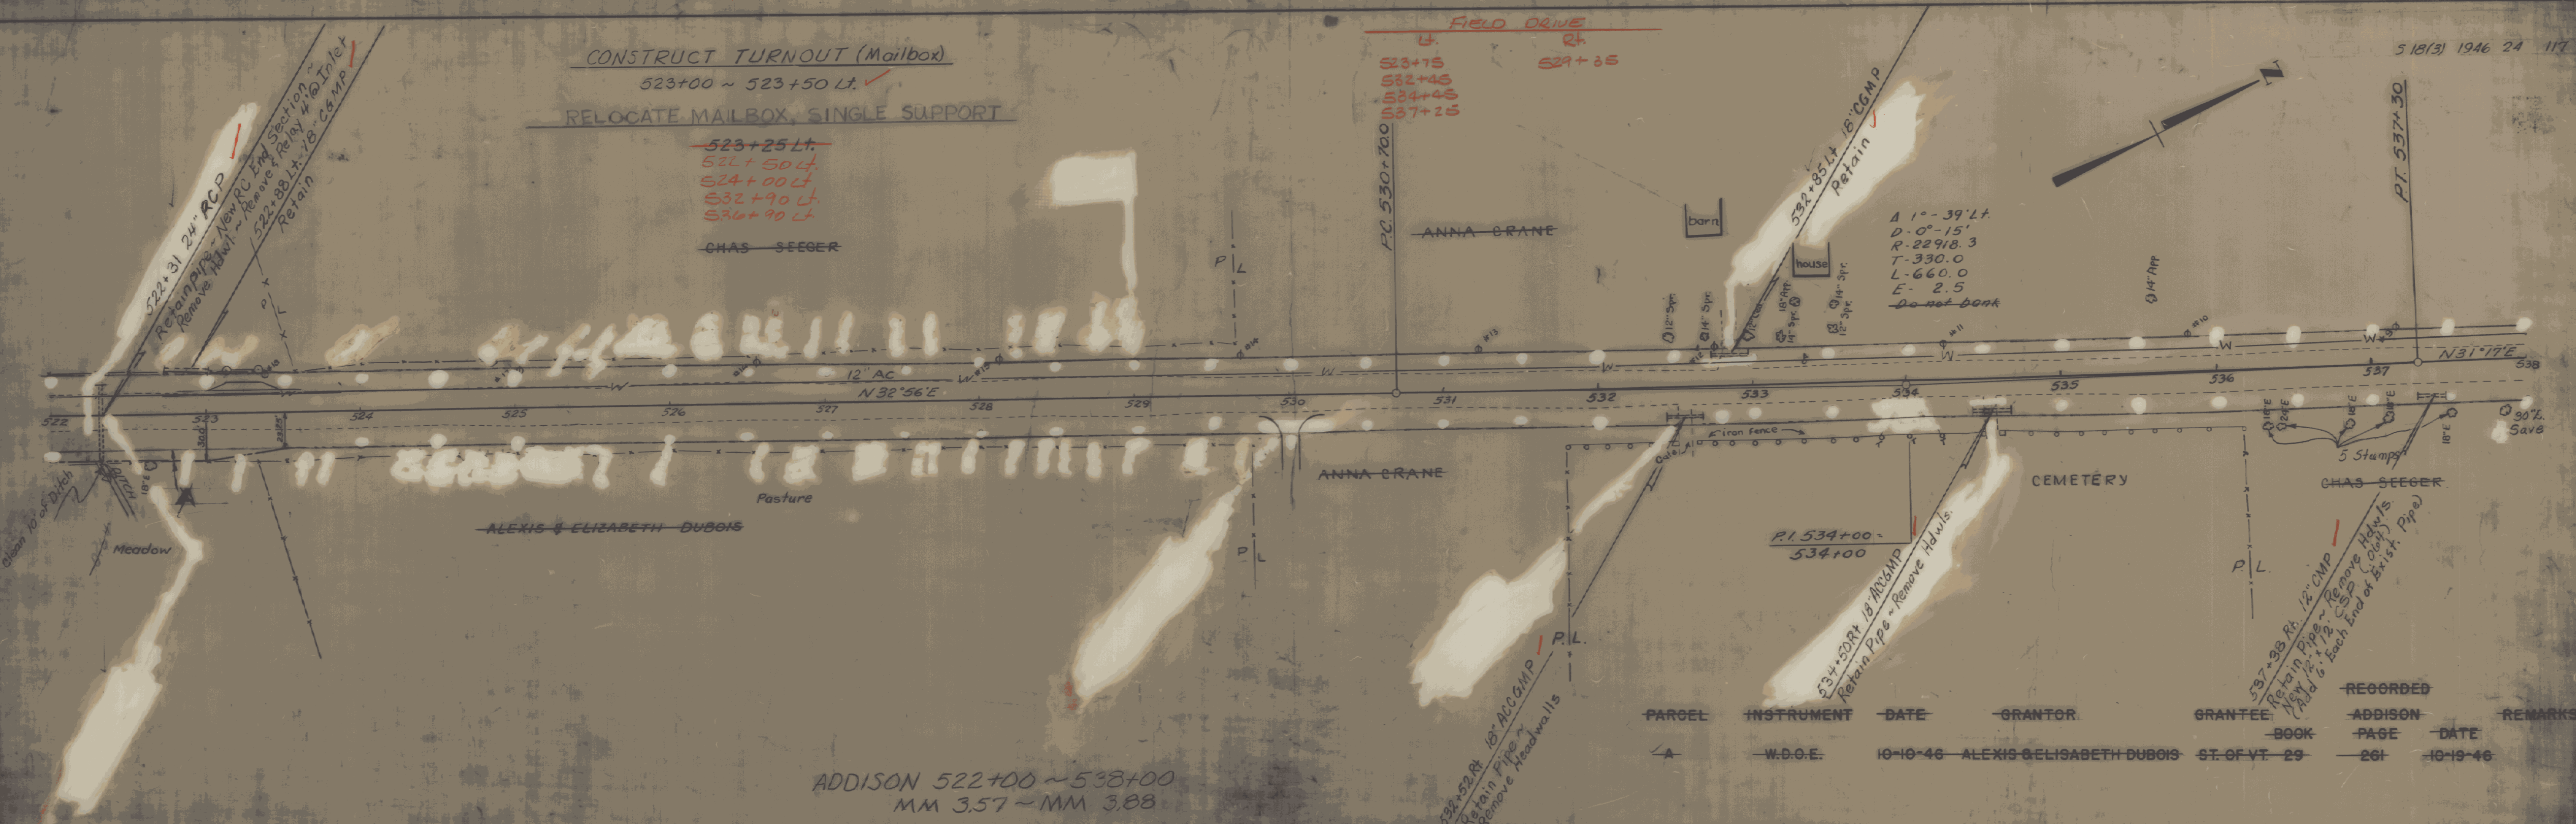

ALEXIS & ELIZABETH DUBOIS

ADDISON 522+00 ~ 538+00
MM 3.57 ~ MM 3.88

PARCEL	INSTRUMENT	DATE	GRANTOR	GRANTEE	BOOK	PAGE	RECORDED DATE	REMARKS
A	W.D.O.E.	10-10-46	ALEXIS & ELIZABETH DUBOIS	ST. OF VT.	29	261	10-19-46	

