


DATUM
 VERTICAL NGVD 1929
 HORIZONTAL N/A

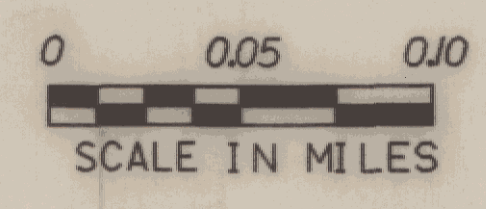

ALL SIGNS SHOWN ARE TO BE REMOVED
 "TIS" ARE TO BE REMOVED AND SALVAGED

SHOREHAM EXISTING SIGNS

83B030ESI.PRF DATE PLOTTED 29-DEC-1989

SURVEYED BY	DATE
DRAWN BY L. BULLOCK	DATE 3/89
SQUAD LEADER J. PERKINS	
DESIGN FILE NO. ZG0450,63183B030.DGN	
PROJ. NAME SHOREHAM-BRIDPORT-ADDISON	
PROJ. NO. F 017-1(2)	
SHEET 190 OF 420 SHEETS	