


SHOREHAM

BRIDPORT

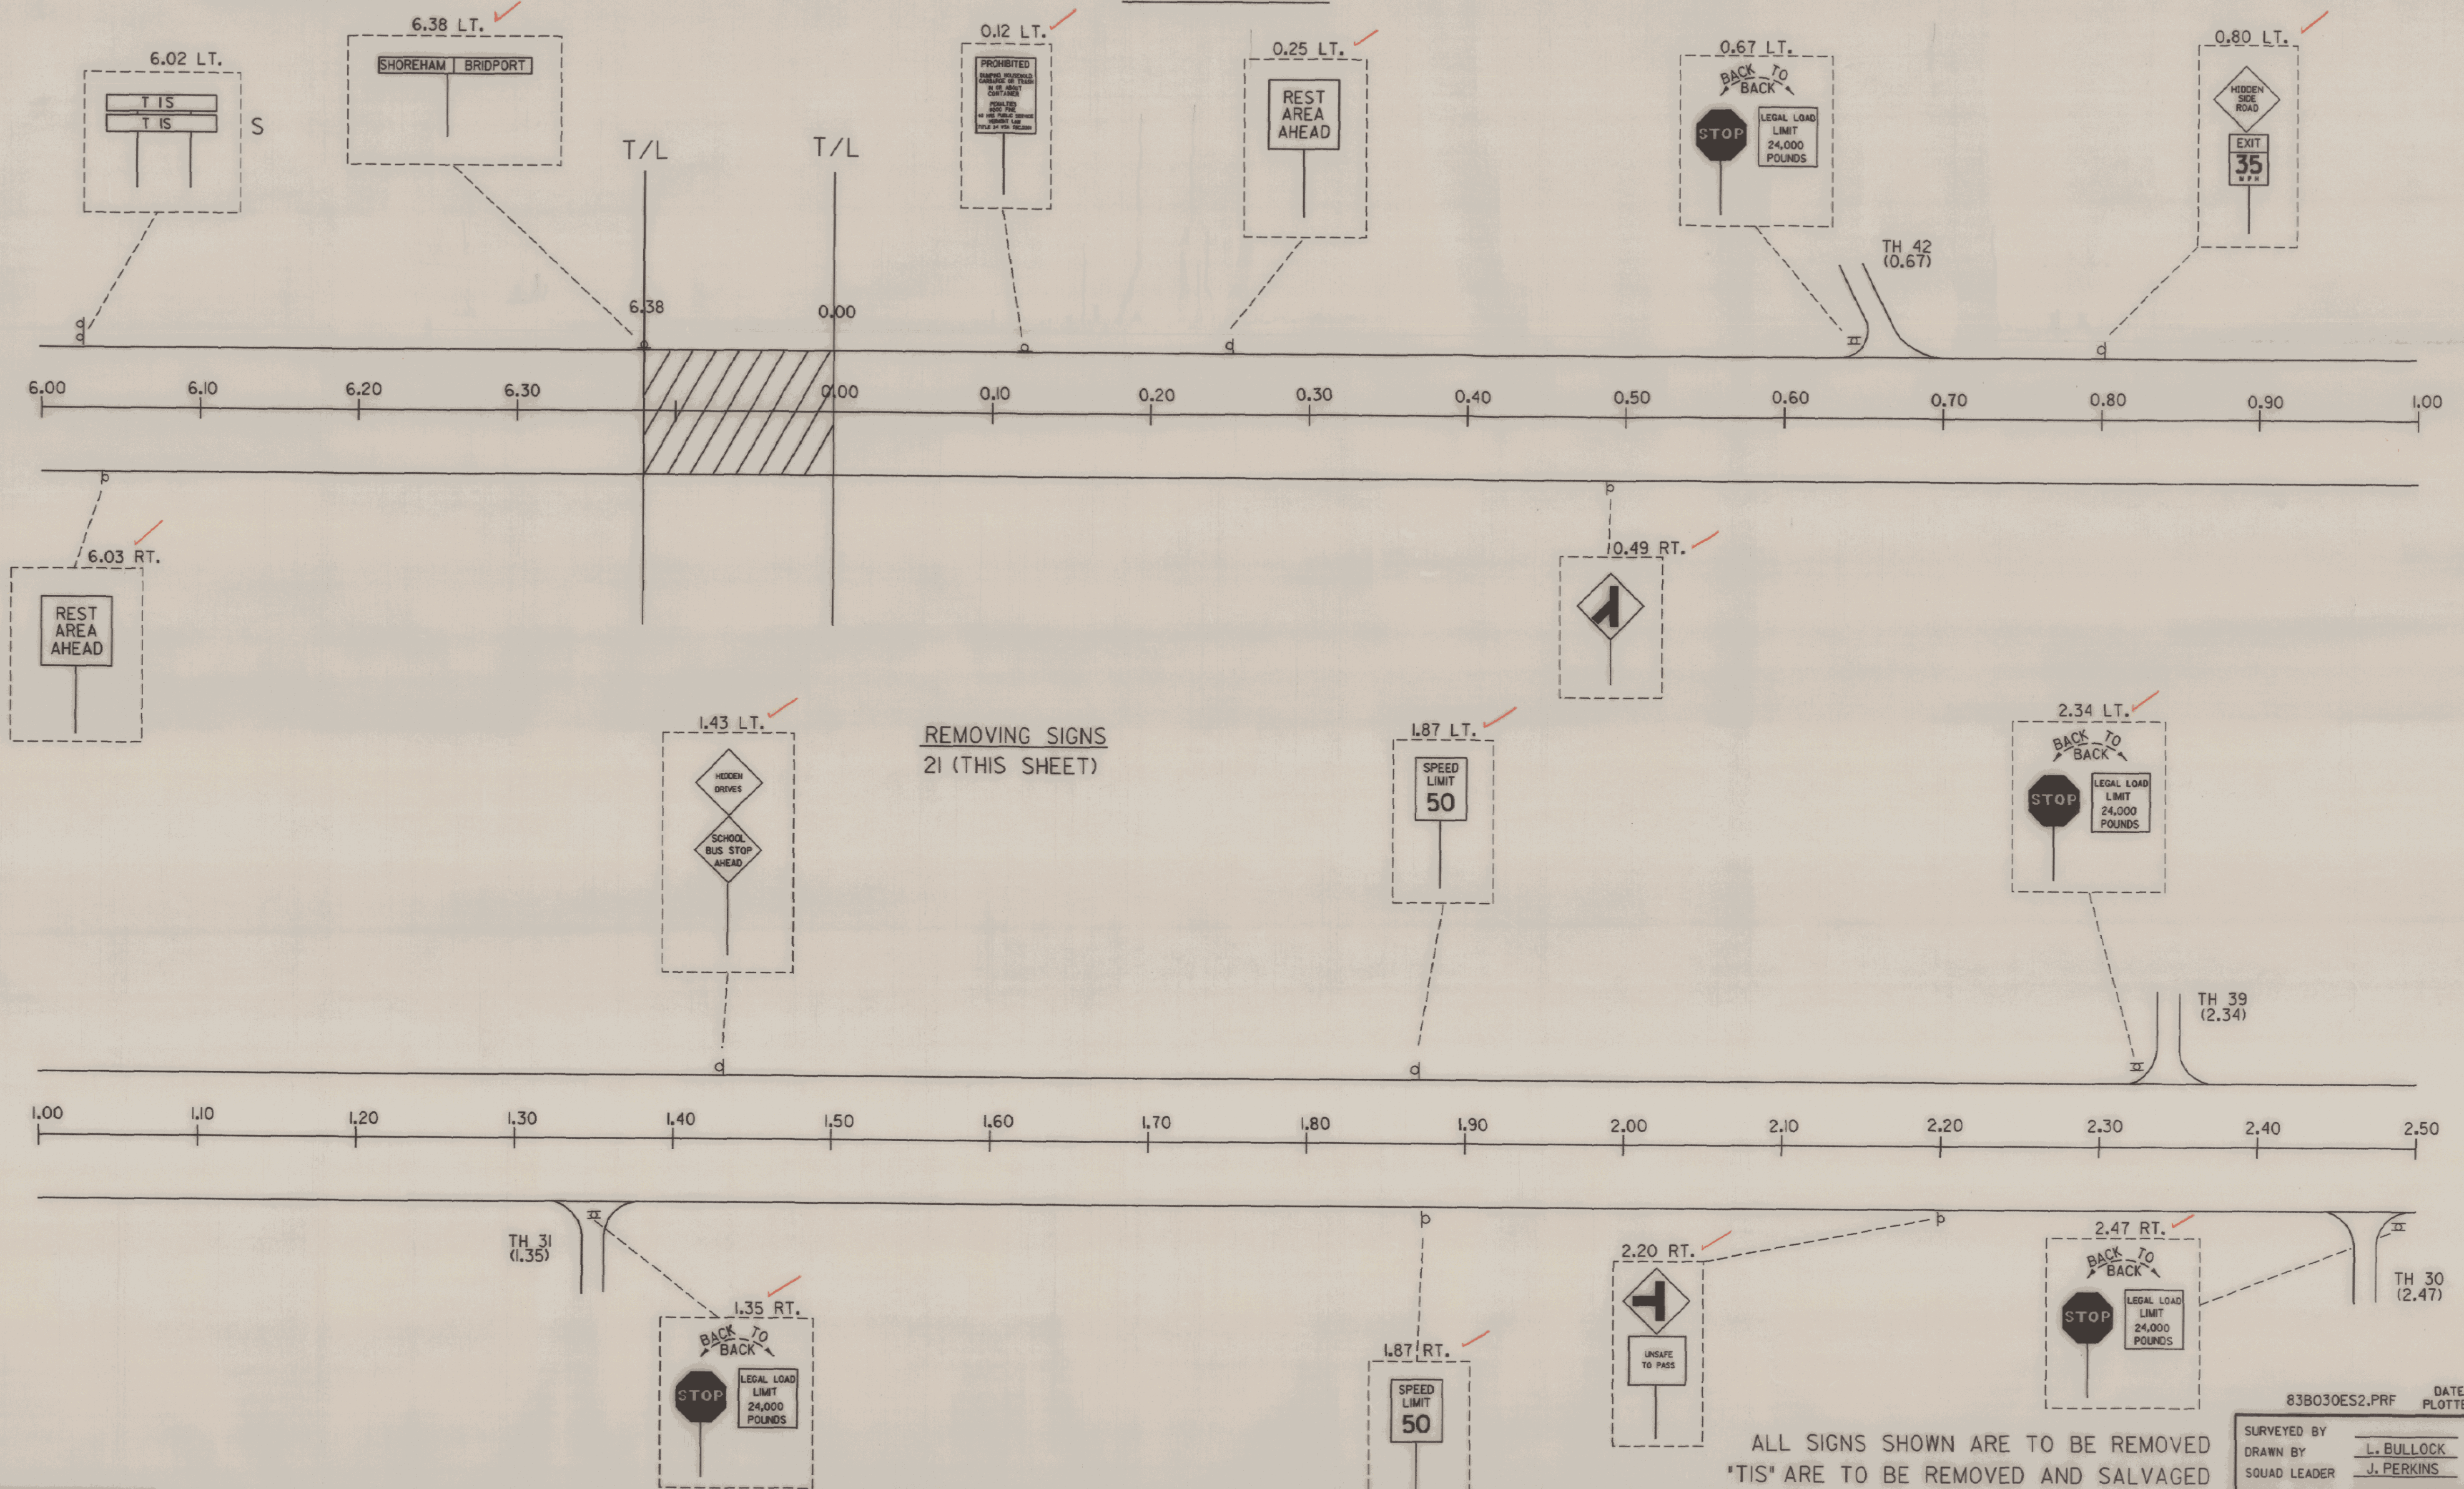

REMOVING SIGNS
21 (THIS SHEET)

DATUM
 VERTICAL NGVD 1929
 HORIZONTAL N/A

0 0.05 0.10
 SCALE IN MILES

ALL SIGNS SHOWN ARE TO BE REMOVED
 *TIS ARE TO BE REMOVED AND SALVAGED
 SHOREHAM-BRIDPORT
 EXISTING SIGNS

83B030ES2.PRF DATE 29-DEC-1989
 SURVEYED BY _____ DATE _____
 DRAWN BY L. BULLOCK DATE 3/89
 SQUAD LEADER J. PERKINS
 DESIGN FILE NO. ZG0150,63J83B030.DGN
 PROJ. NAME SHOREHAM-BRIDPORT-ADDISON
 PROJ. NO. F 017-1(2)
 SHEET 191 OF 420 SHEETS