

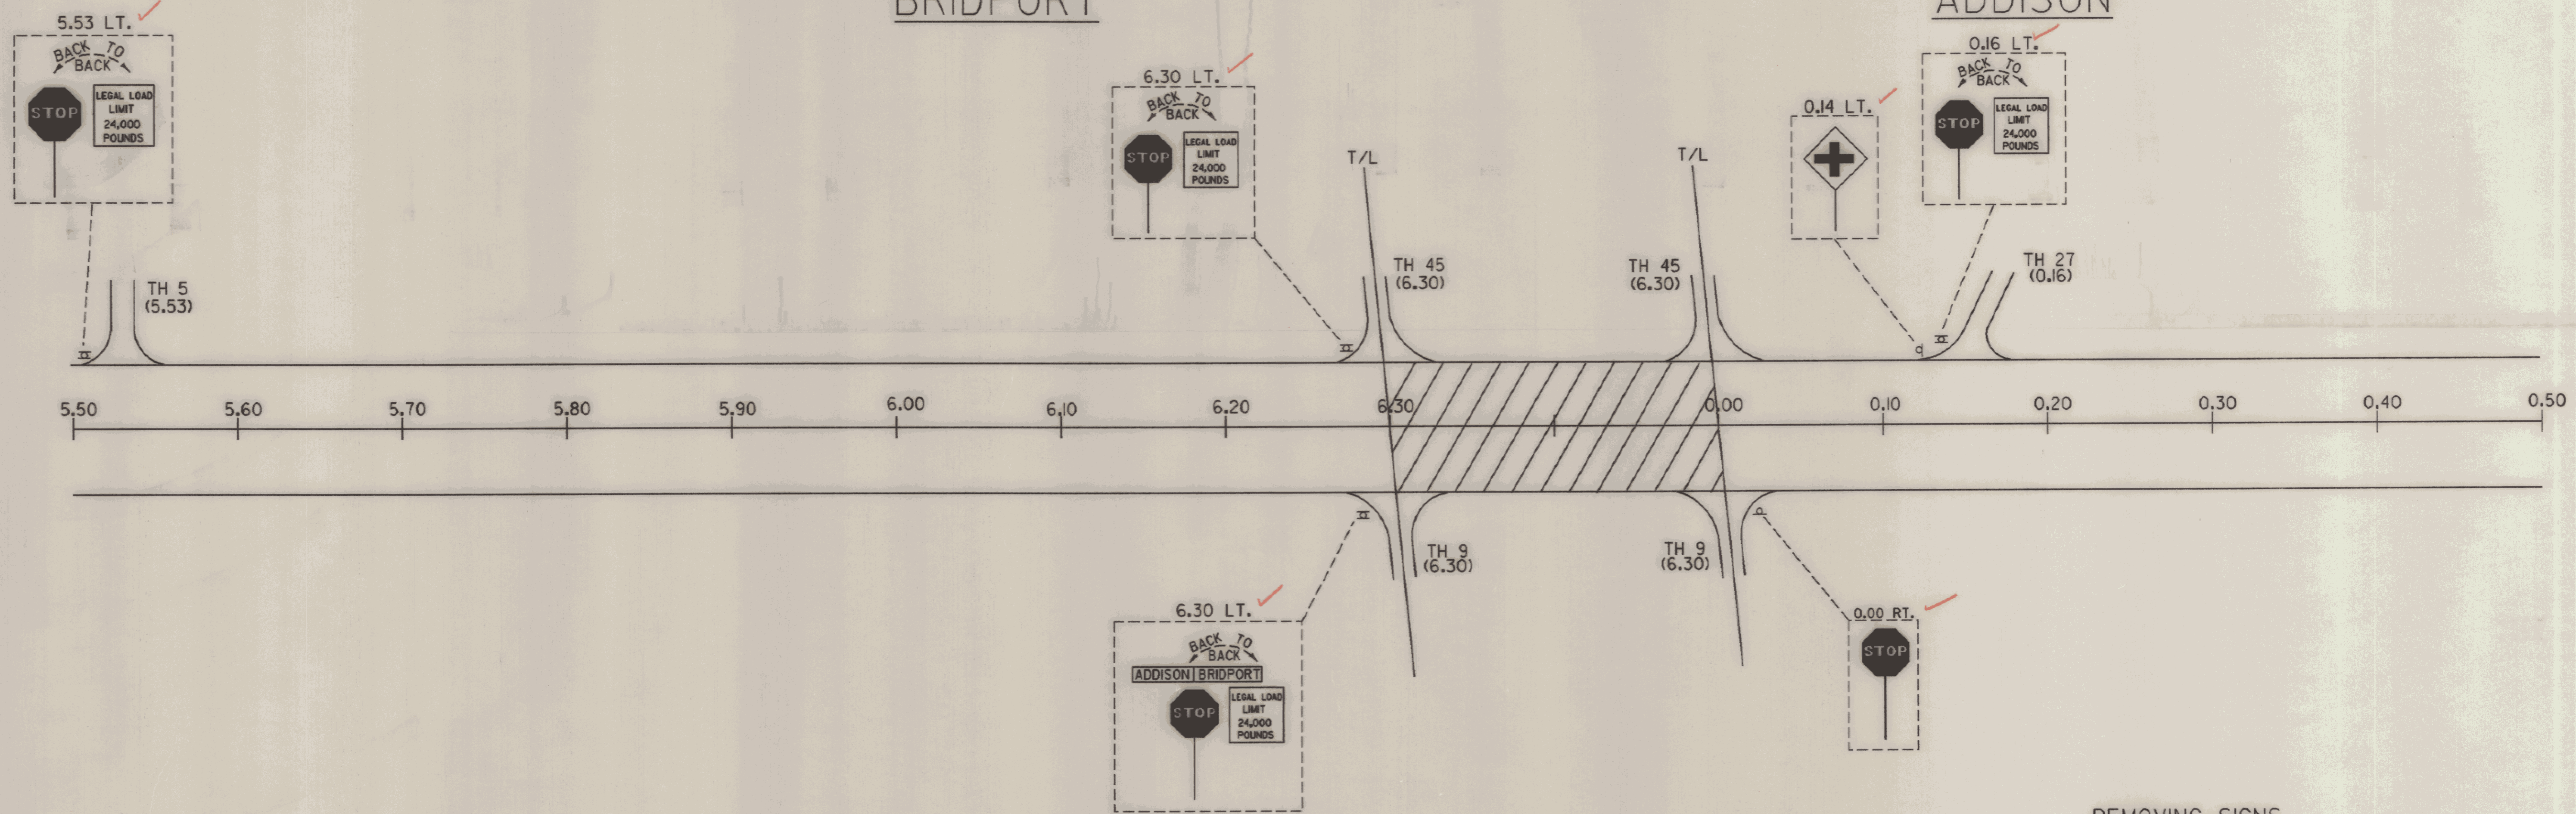


BRIDPORT

ADDISON

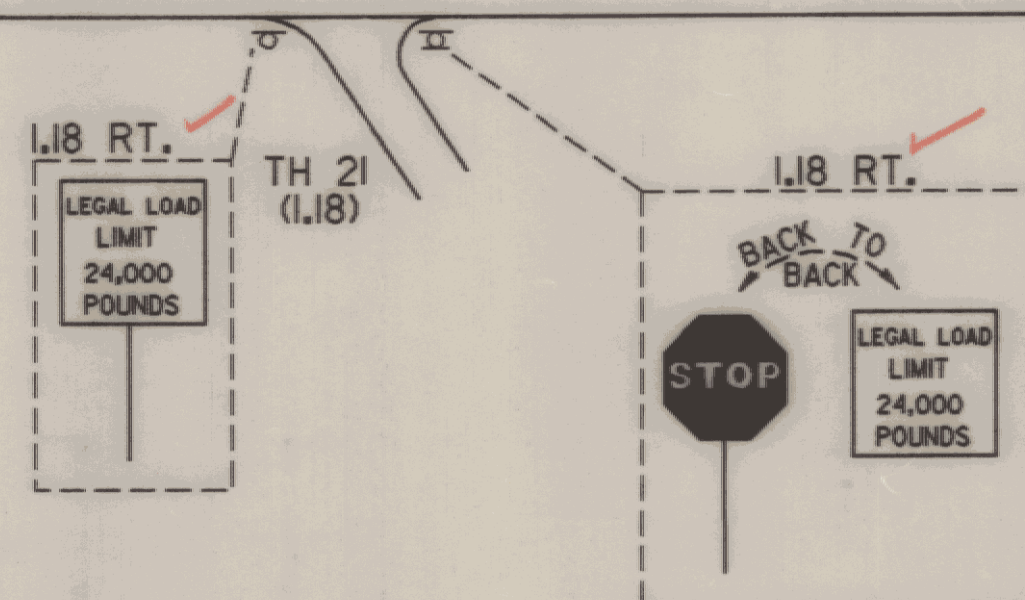

REMOVING SIGNS
14 (THIS SHEET)

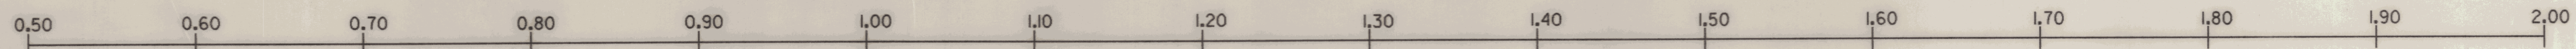

DATUM
VERTICAL NGVD 1929
HORIZONTAL N/A

0 0.05 0.10
SCALE IN MILES

ALL SIGNS SHOWN ARE TO BE REMOVED
BRIDPORT-ADDISON
EXISTING SIGNS

83B030ES4.PRF DATE 29-DEC-1989
PLOTTED

SURVEYED BY _____ DATE _____
DRAWN BY L. BULLOCK DATE 3/89
SQUAD LEADER J. PERKINS
DESIGN FILE NO. ZG0150,63383B030.DGN
PROJ. NAME SHOREHAM-BRIDPORT-ADDISON
PROJ. NO. F 017-1(2)
SHEET 193 OF 420 SHEETS

SHEET 193 OF 477