


DATUM
 VERTICAL NGVD 1929
 HORIZONTAL N/A

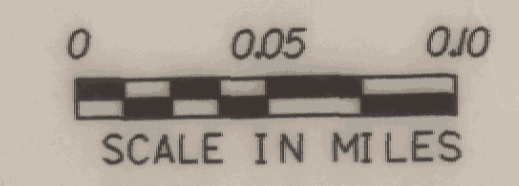

ALL SIGNS SHOWN ARE TO BE REMOVED
 ADDISON
 EXISTING SIGNS

83B030E55.PRF DATE PLOTTED 29-DEC-1989

SURVEYED BY	DATE
DRAWN BY <u>L. BULLOCK</u>	DATE <u>3/89</u>
SQUAD LEADER <u>J. PERKINS</u>	
DESIGN FILE NO. <u>ZGO:H50,63183B030.DGN</u>	
PROJ. NAME <u>SHOREHAM-BRIDPORT-ADDISON</u>	
PROJ. NO. <u>F 017-1(2)</u>	
SHEET <u>194</u> OF <u>420</u> SHEETS	

SHEET 194 OF 477