



DETAIL SHEET I

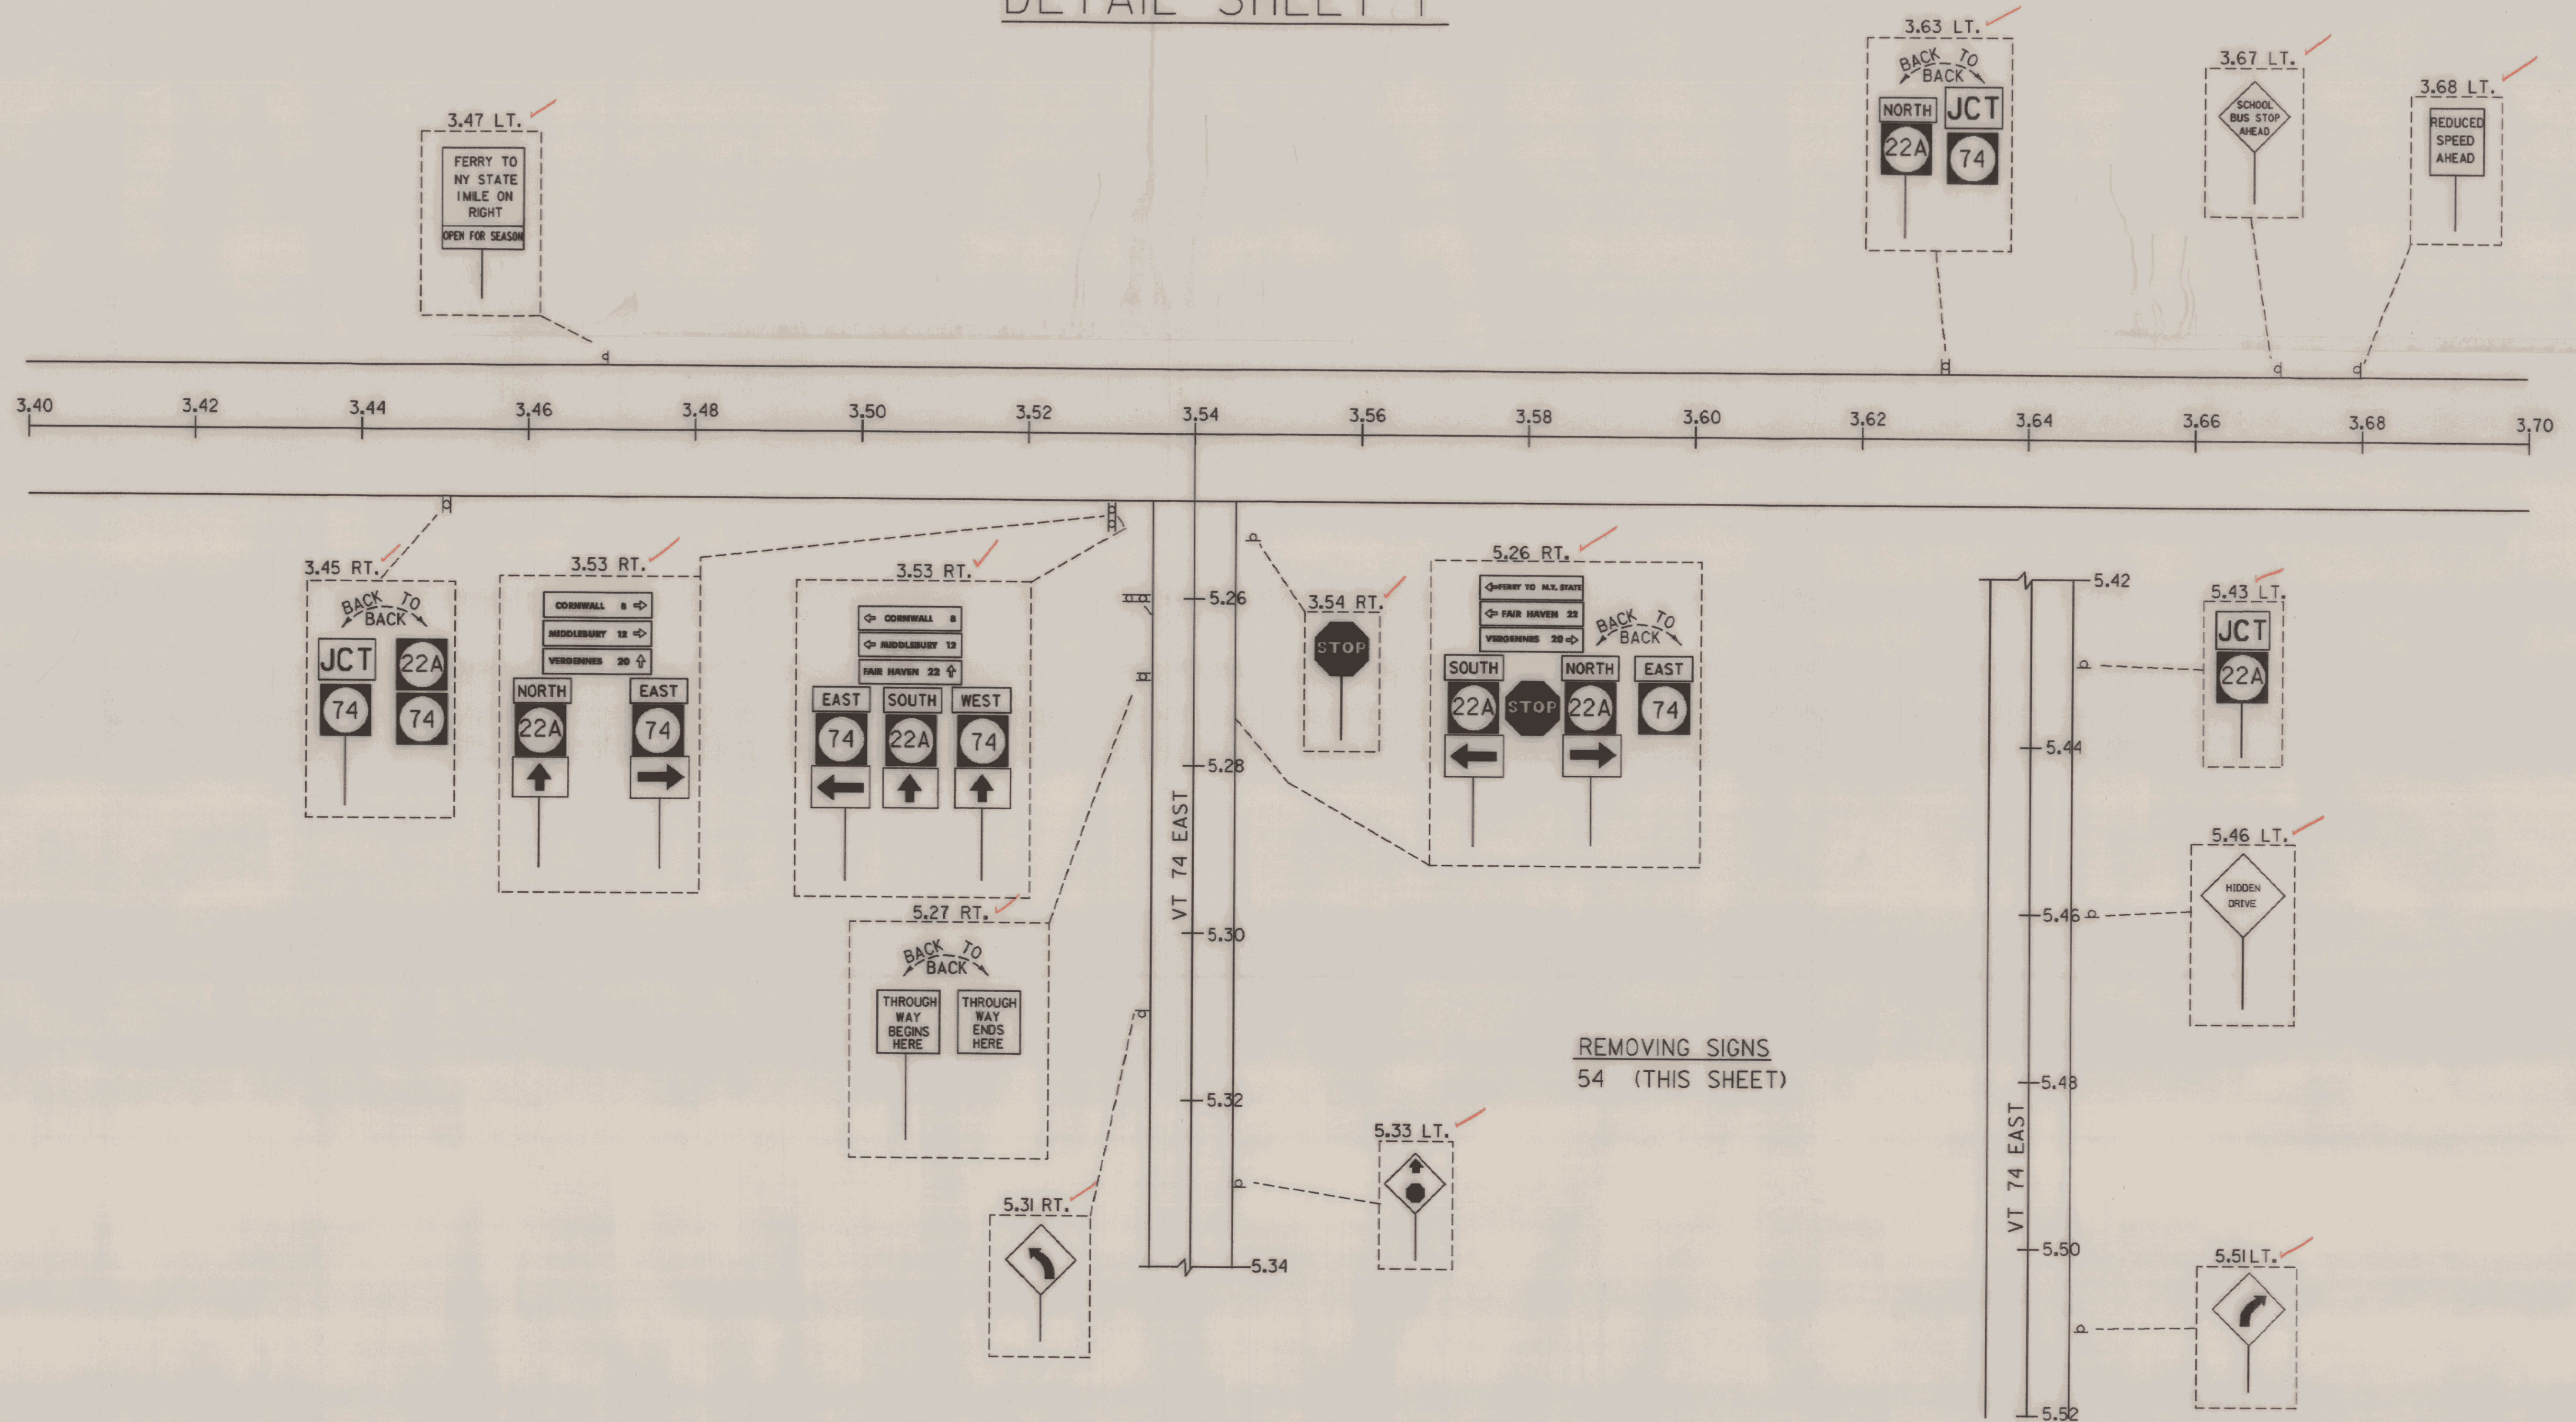

SHOREHAM MM 3.40 ~ 3.70
 INTERSECTION OF VT 22A AND VT 74 EAST

ALL SIGNS SHOWN ARE TO BE REMOVED

SHOREHAM
 EXISTING SIGNS

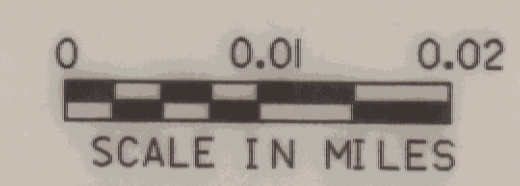

| | |
|------------|-----------|
| DATUM | |
| VERTICAL | NGVD 1929 |
| HORIZONTAL | N/A |

| | |
|--------------------------------------|------------------|
| 83B030E56.PRF | DATE 29-DEC-1989 |
| SURVEYED BY | DATE |
| DRAWN BY L. BULLOCK | DATE 3/89 |
| SQUAD LEADER J. PERKINS | |
| DESIGN FILE NO. ZG0450,63183B030.DGN | |
| PROJ. NAME SHOREHAM-BRIDPORT-ADDISON | |
| PROJ. NO. F 017-K(2) | |
| SHEET 195 OF 420 SHEETS | |