
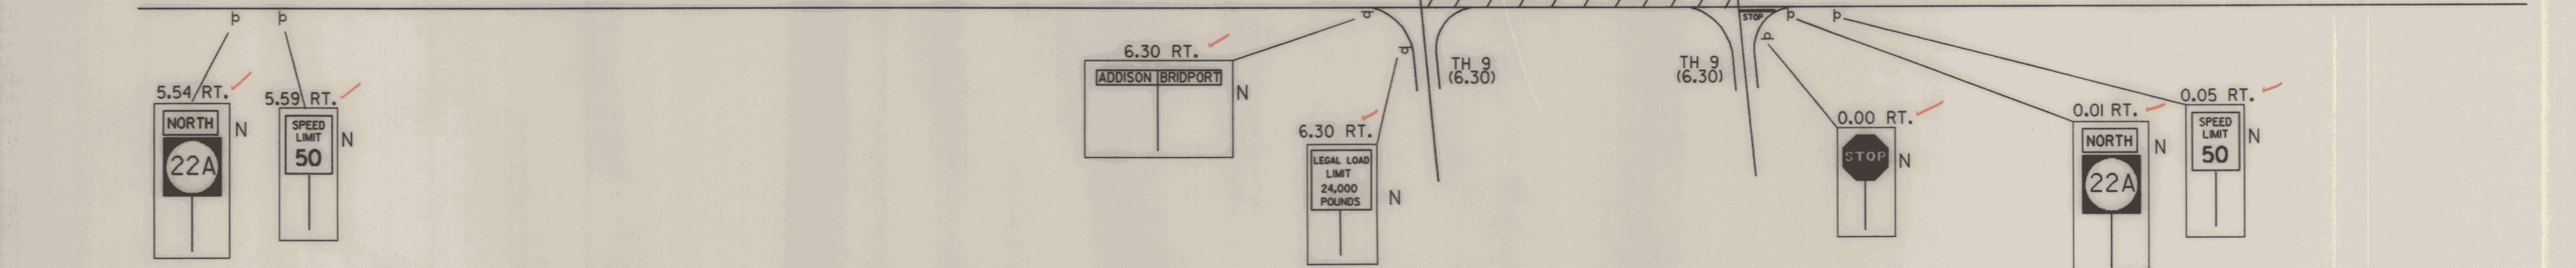


# BRIDPORT

# ADDISON

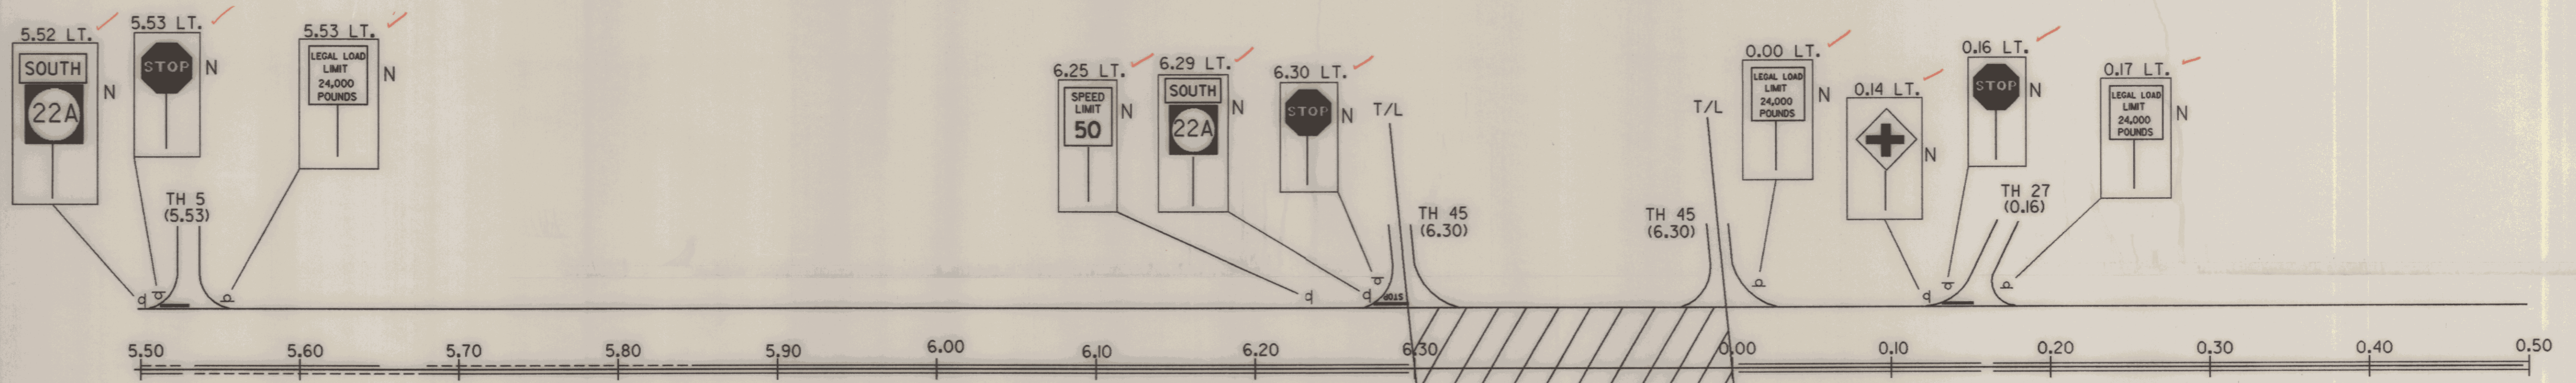

### TEMP. 4" YELLOW LINE

- MM 5.50 ~ 5.526 DASH LT., SOLID RT.
- 5.534 ~ 5.65 SOLID LT., DASH RT.
- 5.65 ~ 5.68 DASH
- 5.68 ~ 5.85 DASH LT., SOLID RT.
- 5.85 ~ 6.296 SOLID LT. & RT.
- 0.004 ~ 0.156 SOLID LT. & RT.
- 0.164 ~ 0.63 SOLID LT. & RT.
- 0.63 ~ 0.80 SOLID LT., DASH RT.
- 0.80 ~ 1.09 DASH
- 1.09 ~ 1.176 DASH LT., SOLID RT.
- 1.184 ~ 1.27 SOLID LT., DASH RT.
- 1.27 ~ 1.37 DASH
- 1.37 ~ 1.56 DASH LT., SOLID RT.
- 1.56 ~ 1.65 SOLID LT. & RT.
- 1.65 ~ 1.78 SOLID LT., DASH RT.
- 1.78 ~ 1.95 DASH
- 1.95 ~ 2.00 DASH LT., SOLID RT.

### TEMP. 4" WHITE LINE

- MM 5.50 ~ 5.52 LT.
- 5.54 ~ 6.29 LT. (T/L)
- 0.01 ~ 0.15 LT.
- 0.17 ~ 2.00 LT.
- 5.50 ~ 6.29 RT. (T/L)
- 0.01 ~ 1.17 RT.
- 0.19 ~ 2.00 RT.

### DURABLE 24" STOP BAR



- TH #5, MM 5.53 LT. ✓
- TH #45, MM 6.30 LT. (T/L) ✓
- TH #9, MM 6.30 RT. (T/L) ✓
- TH #27, MM 0.16 LT. ✓
- TH #21, MM 1.18 RT. ✓

### DURABLE LETTER IN WORD MARKING


- TH #45, MM 6.30 LT. "STOP" (T/L)
- TH #9, MM 6.30 RT. "STOP" (T/L)
- TH #5, MM 5.53 LT. "STOP"

### DURABLE 4" WHITE LINE (SEE DETAIL SH. #238)

- TH #5, MM 5.53 LT., RADII ✓
- TH #9, MM 6.30 RT., RADII ✓
- TH #45, MM 6.30 LT., RADII ✓
- TH #27, MM 0.16 LT., RADII ✓
- TH #21, MM 1.18 RT., RADII ✓

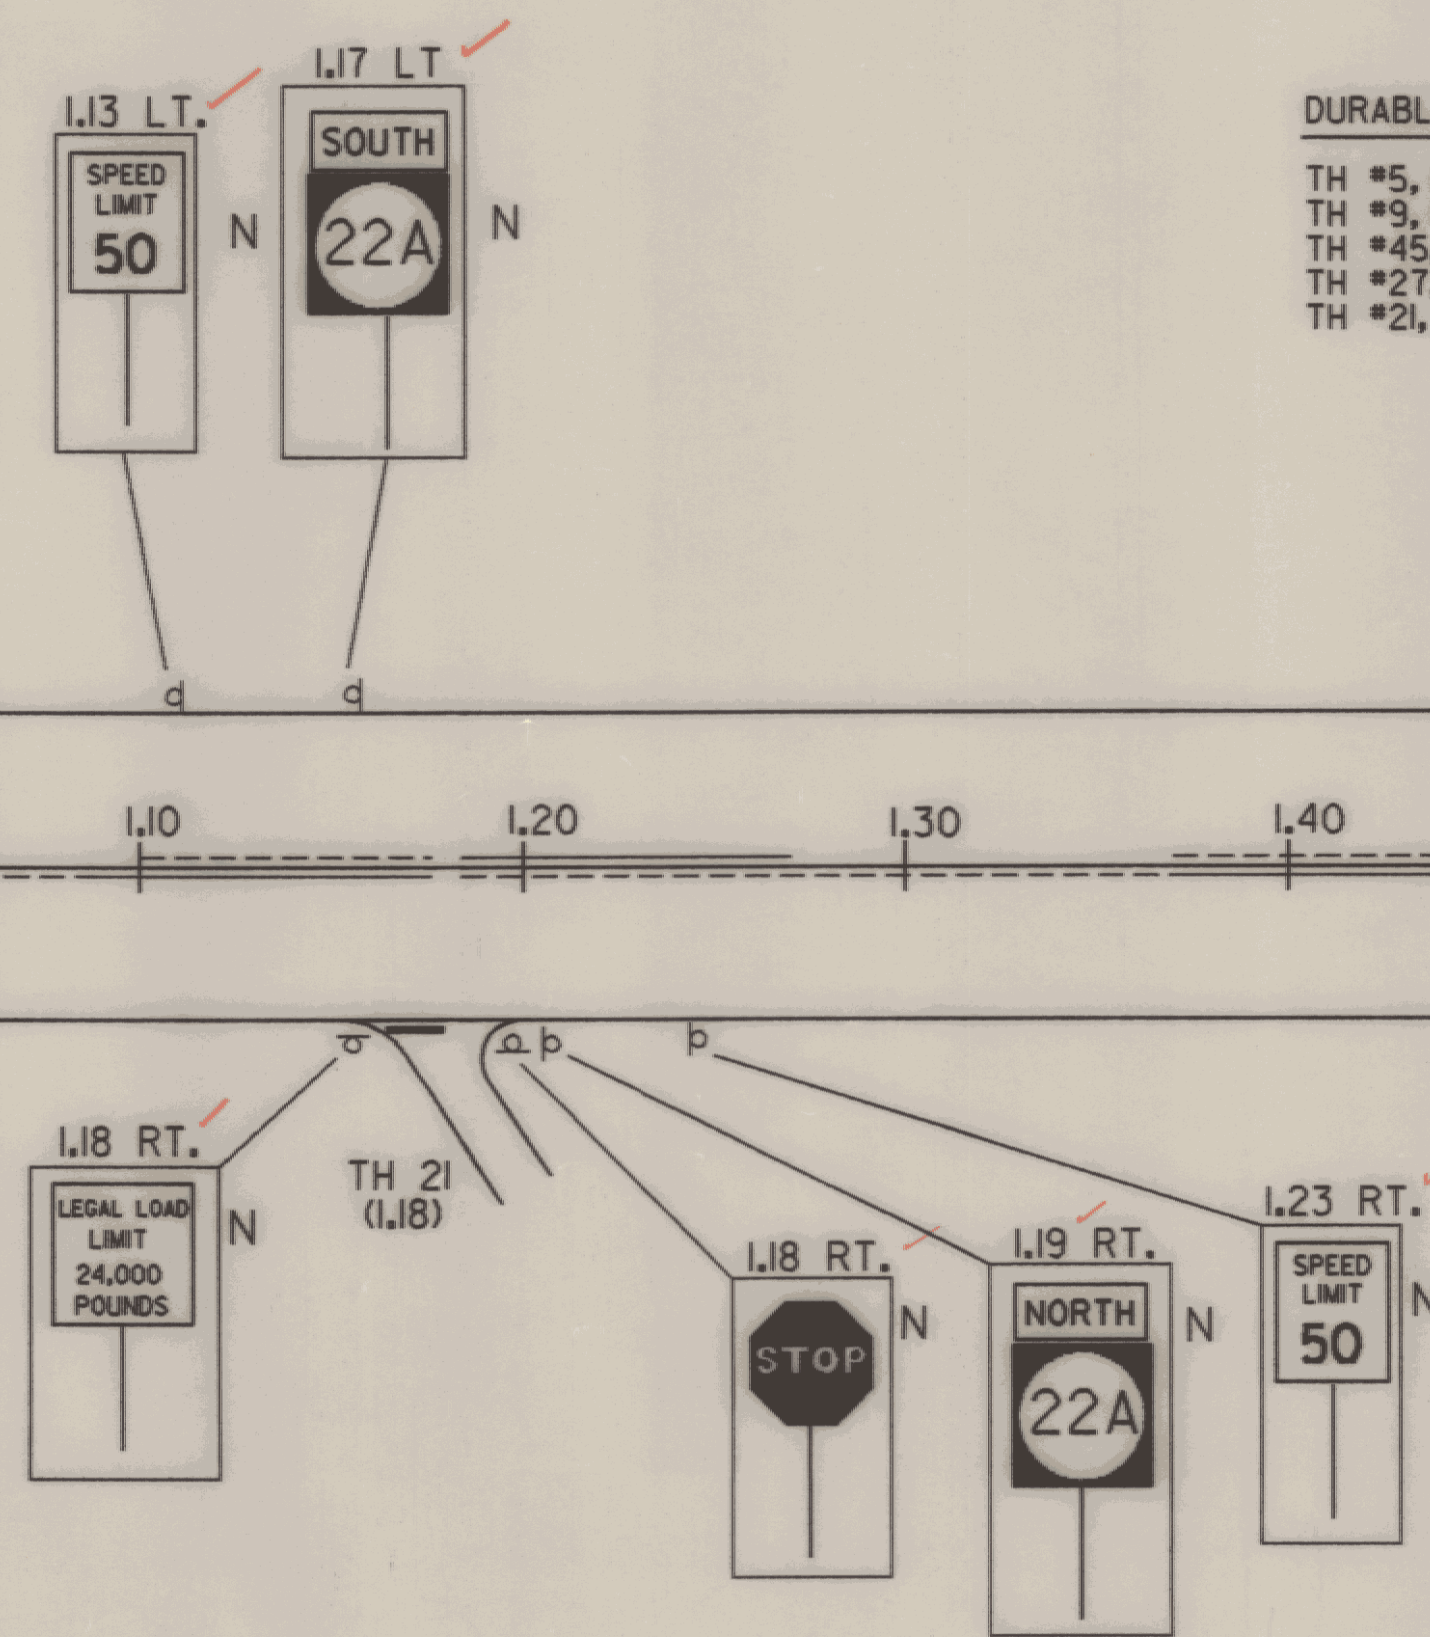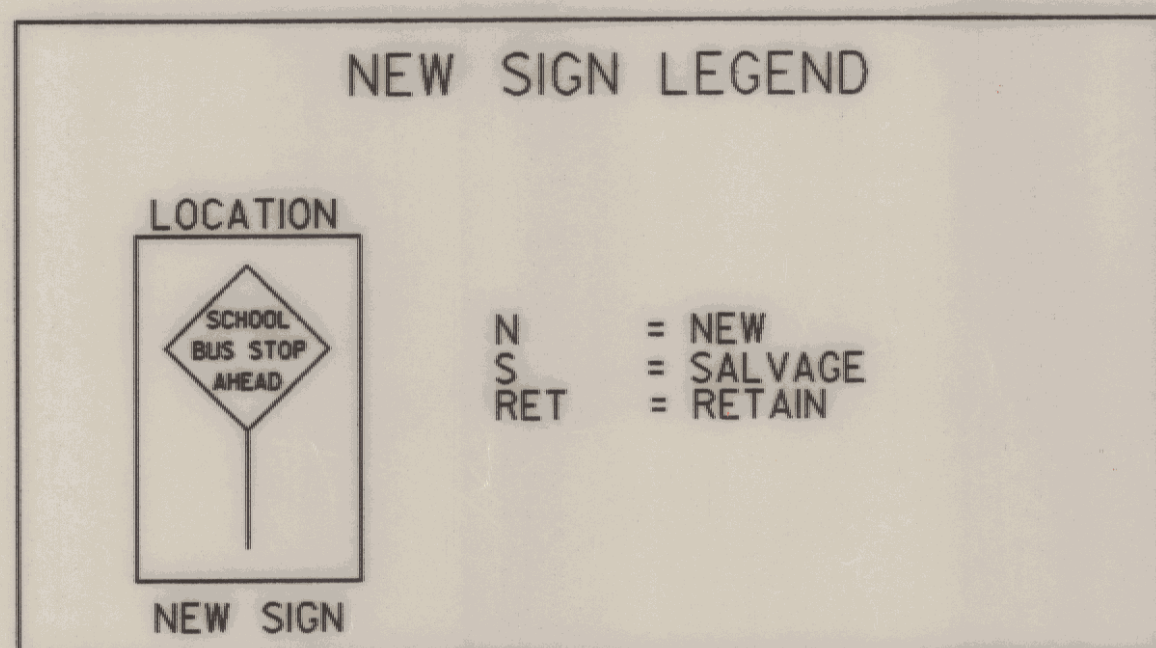

DATUM  
 VERTICAL NGVD 1929  
 HORIZONTAL N/A

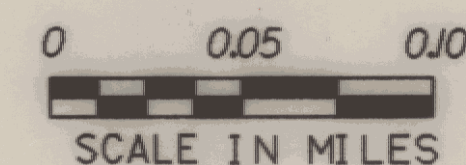

## BRIDPORT-ADDISON NEW SIGNS & PAVEMENT MARKINGS

83B030NS4.PRF DATE 29-DEC-1989  
 PLOTTED

SURVEYED BY \_\_\_\_\_ DATE \_\_\_\_\_  
 DRAWN BY L. BULLOCK DATE 3/89  
 SQUAD LEADER J. PERKINS  
 DESIGN FILE NO. ZG04E50,63J83B030.DGN  
 PROJ. NAME SHOREHAM-BRIDPORT-ADDISON  
 PROJ. NO. F 017-K2)  
 SHEET 201 OF 420 SHEETS