

DURABLE 4" WHITE LINE (SEE DETAIL SH. #238)

TH #4, MM 2.35 LT., RADII ✓
 TH #16, MM 3.25 LT., RADII ✓
 TH #17, MM 2.77 RT., RADII ✓

TEMP. 4" YELLOW LINE
 MM 2.00 ~ 2.14 DASH LT., SOLID RT.
 2.14 ~ 2.346 SOLID LT. & RT.
 2.354 ~ 2.46 SOLID LT., DASH RT.
 2.46 ~ 2.68 DASH
 2.68 ~ 2.766 DASH LT., SOLID RT.
 2.774 ~ 2.92 SOLID LT., DASH RT.
 2.92 ~ 3.16 DASH
 3.16 ~ 3.246 DASH LT., SOLID RT.
 3.254 ~ 3.34 SOLID LT., DASH RT.
 3.34 ~ 3.76 DASH
 3.76 ~ 3.79 SOLID LT., DASH RT.
 3.79 ~ 4.086 SOLID LT. & RT.
 4.094 ~ 4.07 SOLID LT. & RT.

DURABLE LETTER IN WORD MARKING
 TH #4, MM 2.35 LT. "STOP" ✓
 TH #17, MM 2.77 RT. "STOP" ✓


TEMP. 4" WHITE LINE
 MM 2.00 ~ 2.34, 12' LT.
 2.36 ~ 3.24, 12' LT.
 3.26 ~ 4.07, 12' LT.
 2.00 ~ 2.76, 12' RT.
 2.78 ~ 4.08, 12' RT.
 4.10 ~ 4.07, 12' RT.

DURABLE 24" STOP BAR
 TH #4 MM 2.35 LT. ✓
 TH #17 MM 2.77 RT. ✓
 TH #16 MM 3.25 LT. ✓

BEGIN ADDISON HES 017-(14)S PAVEMENT MARKINGS MM 4.07


BEGIN ADDISON HES 017-(14)S SIGNING

SEE ADDISON HES 017-(14)S PLANS

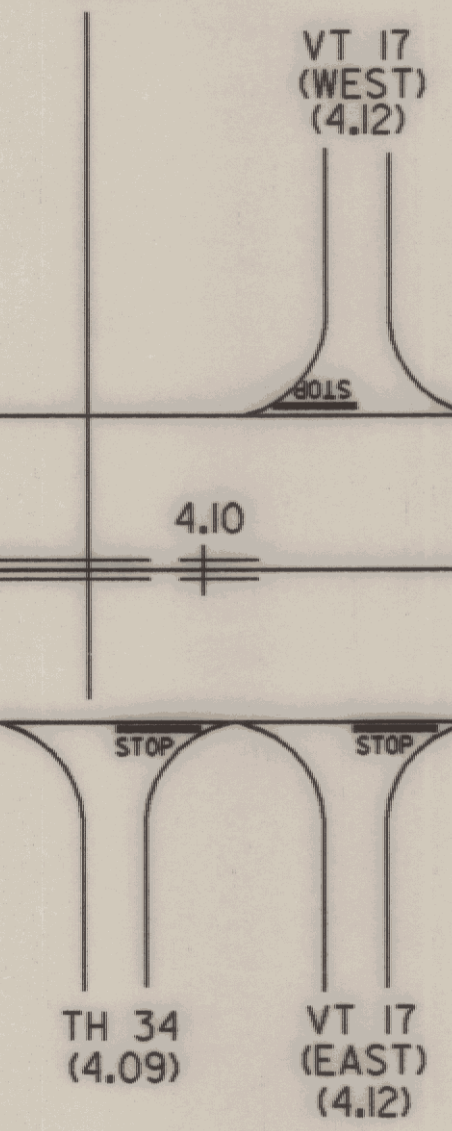

NEW SIGN LEGEND

LOCATION	
	NEW SIGN
N	= NEW
S	= SALVAGE
RET	= RETAIN

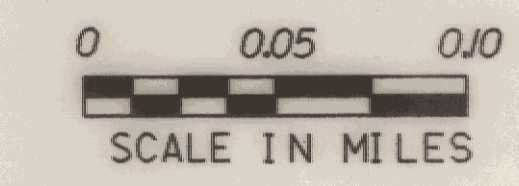

ADDISON NEW SIGNS & PAVEMENT MARKINGS

DATUM
 VERTICAL NGVD 1929
 HORIZONTAL N/A

83B030NS5.PRF DATE PLOTTED 29-DEC-1989

SURVEYED BY _____ DATE _____
 DRAWN BY L. BULLOCK DATE 3/89
 SQUAD LEADER J. PERKINS

DESIGN FILE NO. ZG0450,63J83B030.DGN
 PROJ. NAME SHOREHAM-BRIDPORT-ADDISON
 PROJ. NO. F 017-(12)
 SHEET 202 OF 420 SHEETS