
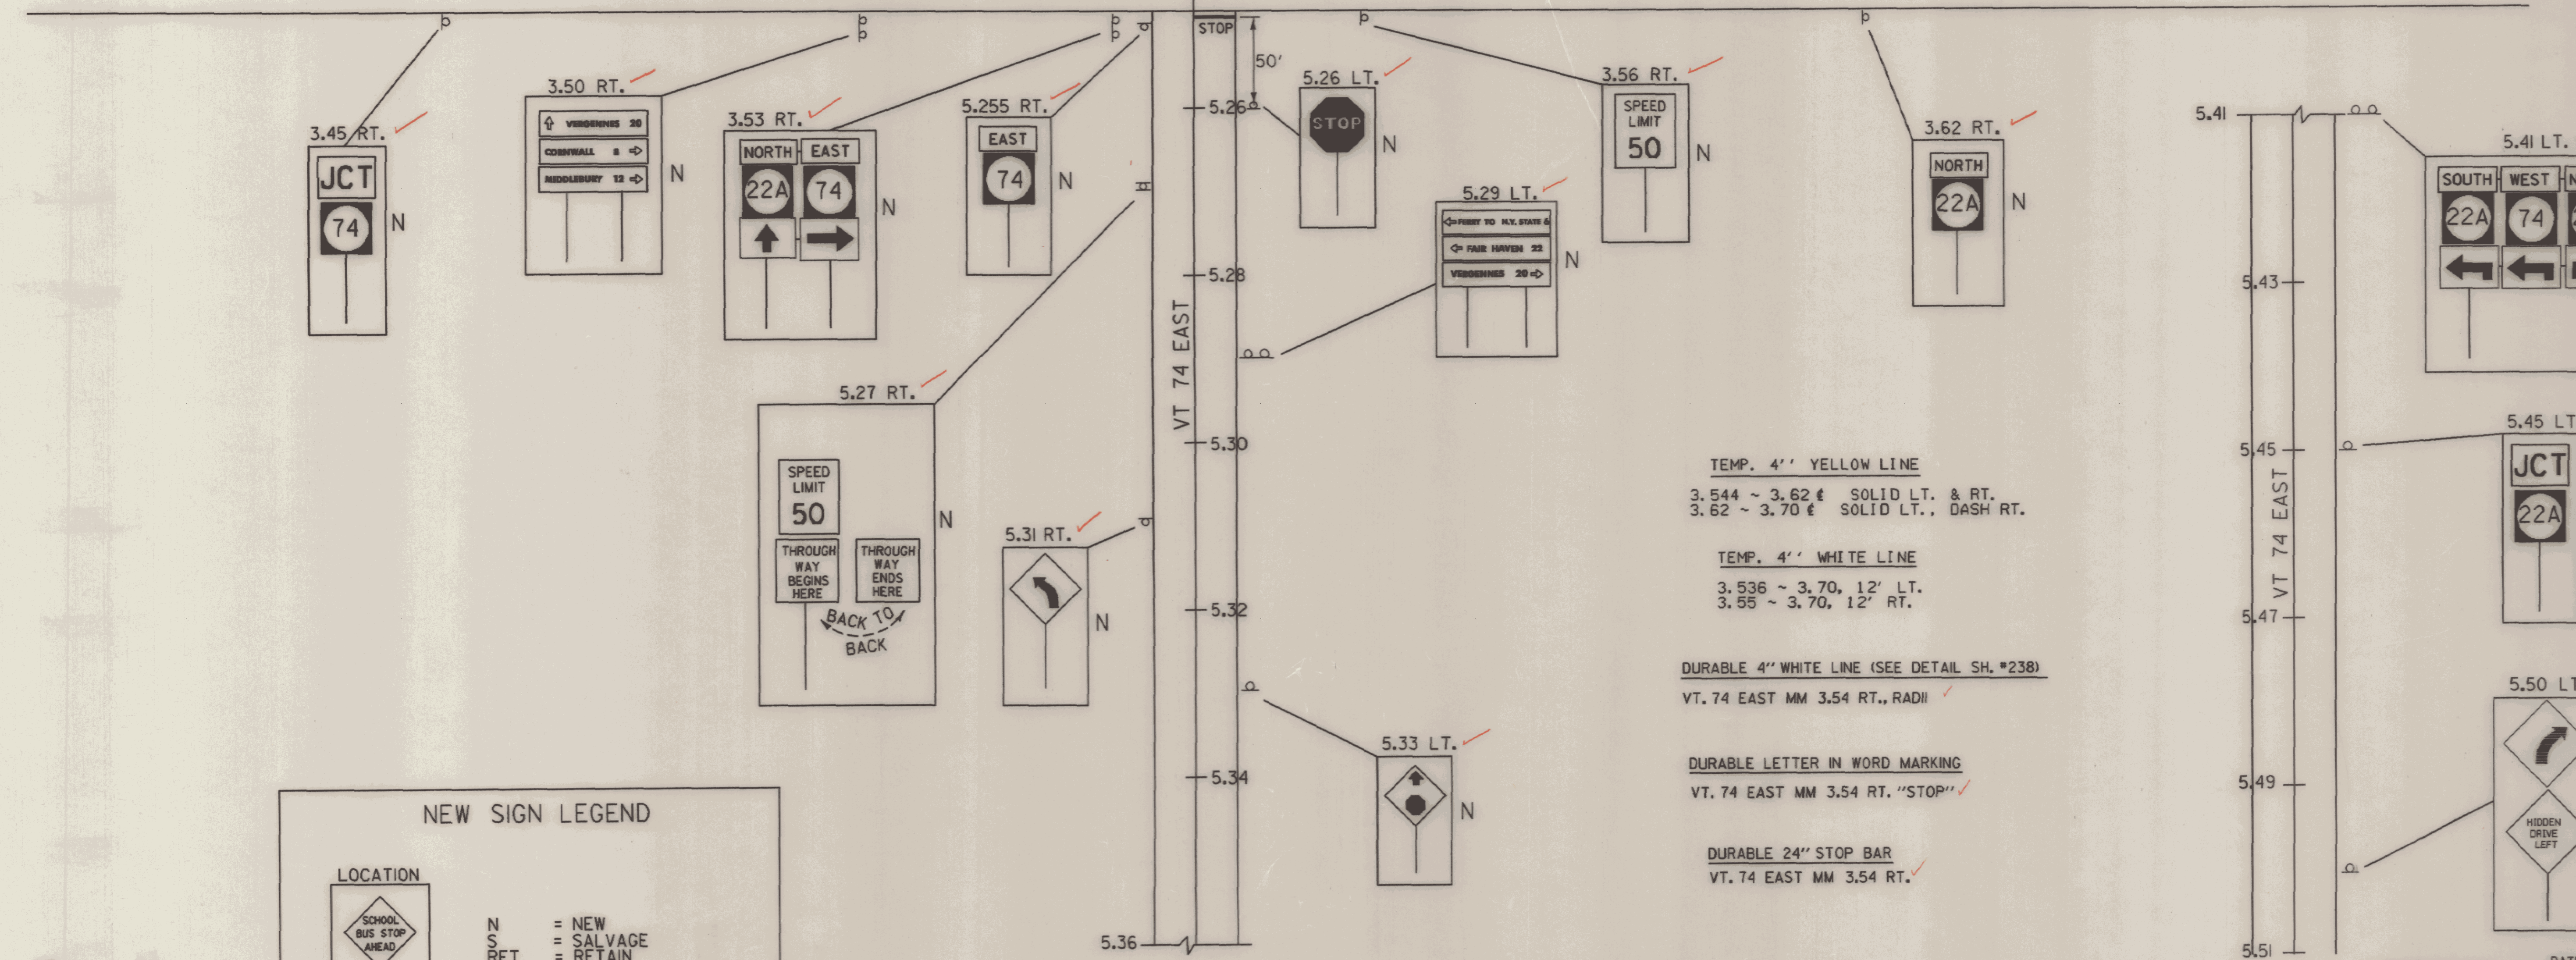


# DETAIL SHEET 4

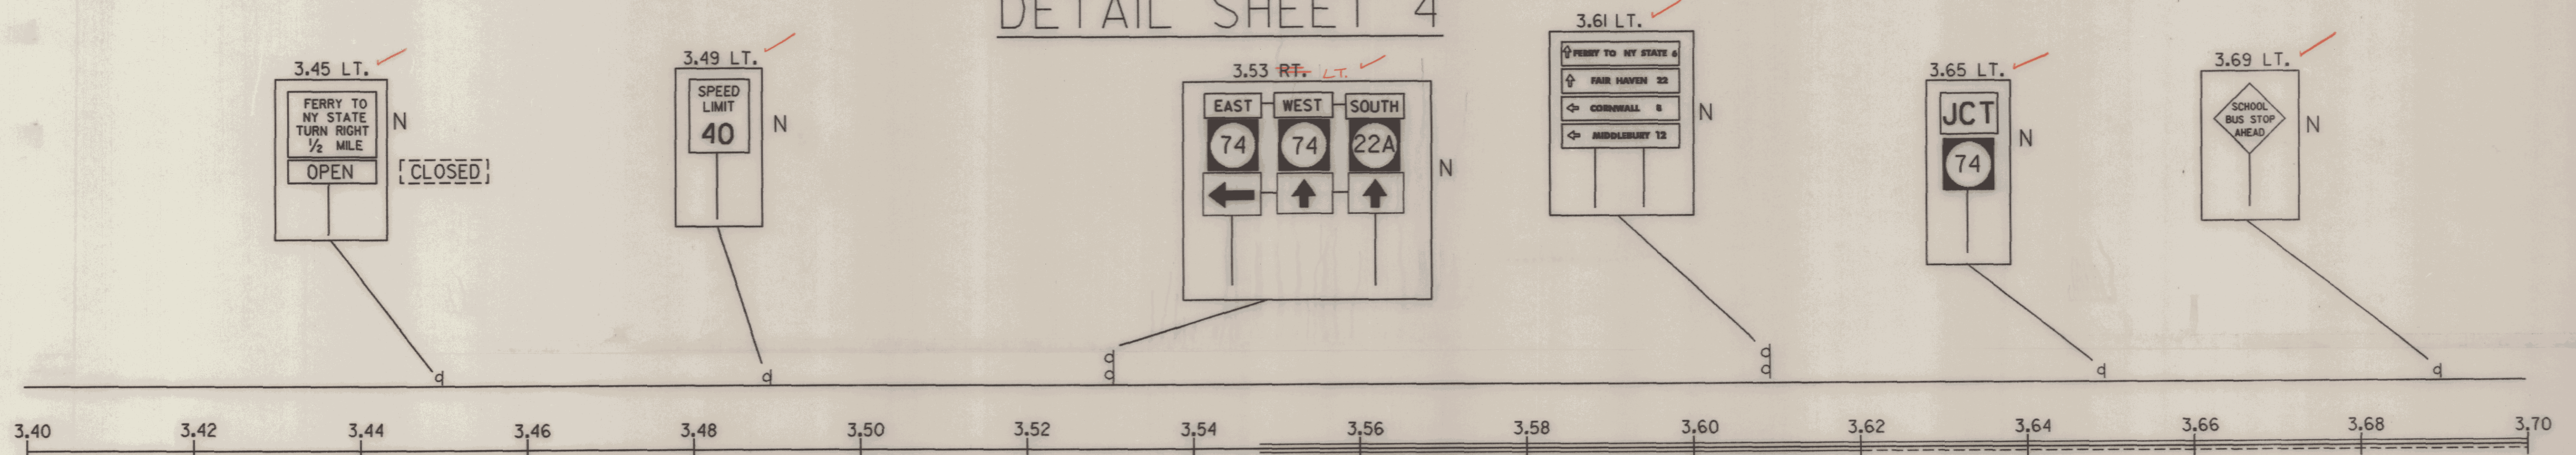

TEMP. 4" YELLOW LINE  
 3.544 ~ 3.62 € SOLID LT. & RT.  
 3.62 ~ 3.70 € SOLID LT., DASH RT.

TEMP. 4" WHITE LINE  
 3.536 ~ 3.70, 12' LT.  
 3.55 ~ 3.70, 12' RT.

DURABLE 4" WHITE LINE (SEE DETAIL SH. #238)  
 VT. 74 EAST MM 3.54 RT., RADII ✓

DURABLE LETTER IN WORD MARKING  
 VT. 74 EAST MM 3.54 RT. "STOP" ✓

DURABLE 24" STOP BAR  
 VT. 74 EAST MM 3.54 RT. ✓

**NEW SIGN LEGEND**

LOCATION		
	N	= NEW
	S	= SALVAGE
	RET	= RETAIN

NEW SIGN

SHOREHAM MM 3.40 ~ 3.70  
 INTERSECTION OF VT 22A AND VT 74 EAST

DATUM  
 VERTICAL NGVD 1929  
 HORIZONTAL N/A

0 0.10 0.20  
 SCALE IN MILES

SHOREHAM NEW SIGNS & PAVEMENT MARKINGS

83B030NS6.PRF DATE PLOTTED 29-DEC-1989

SURVEYED BY \_\_\_\_\_ DATE \_\_\_\_\_  
 DRAWN BY L. BULLOCK DATE 3/89  
 SQUAD LEADER J. PERKINS

DESIGN FILE NO. ZGO:[50,63]83B030.DGN  
 PROJ. NAME SHOREHAM-BRIDPORT-ADDISON  
 PROJ. NO. F 017-(K2)  
 SHEET 203 OF 420 SHEETS