




TEMPORARY DETOUR DETAILS

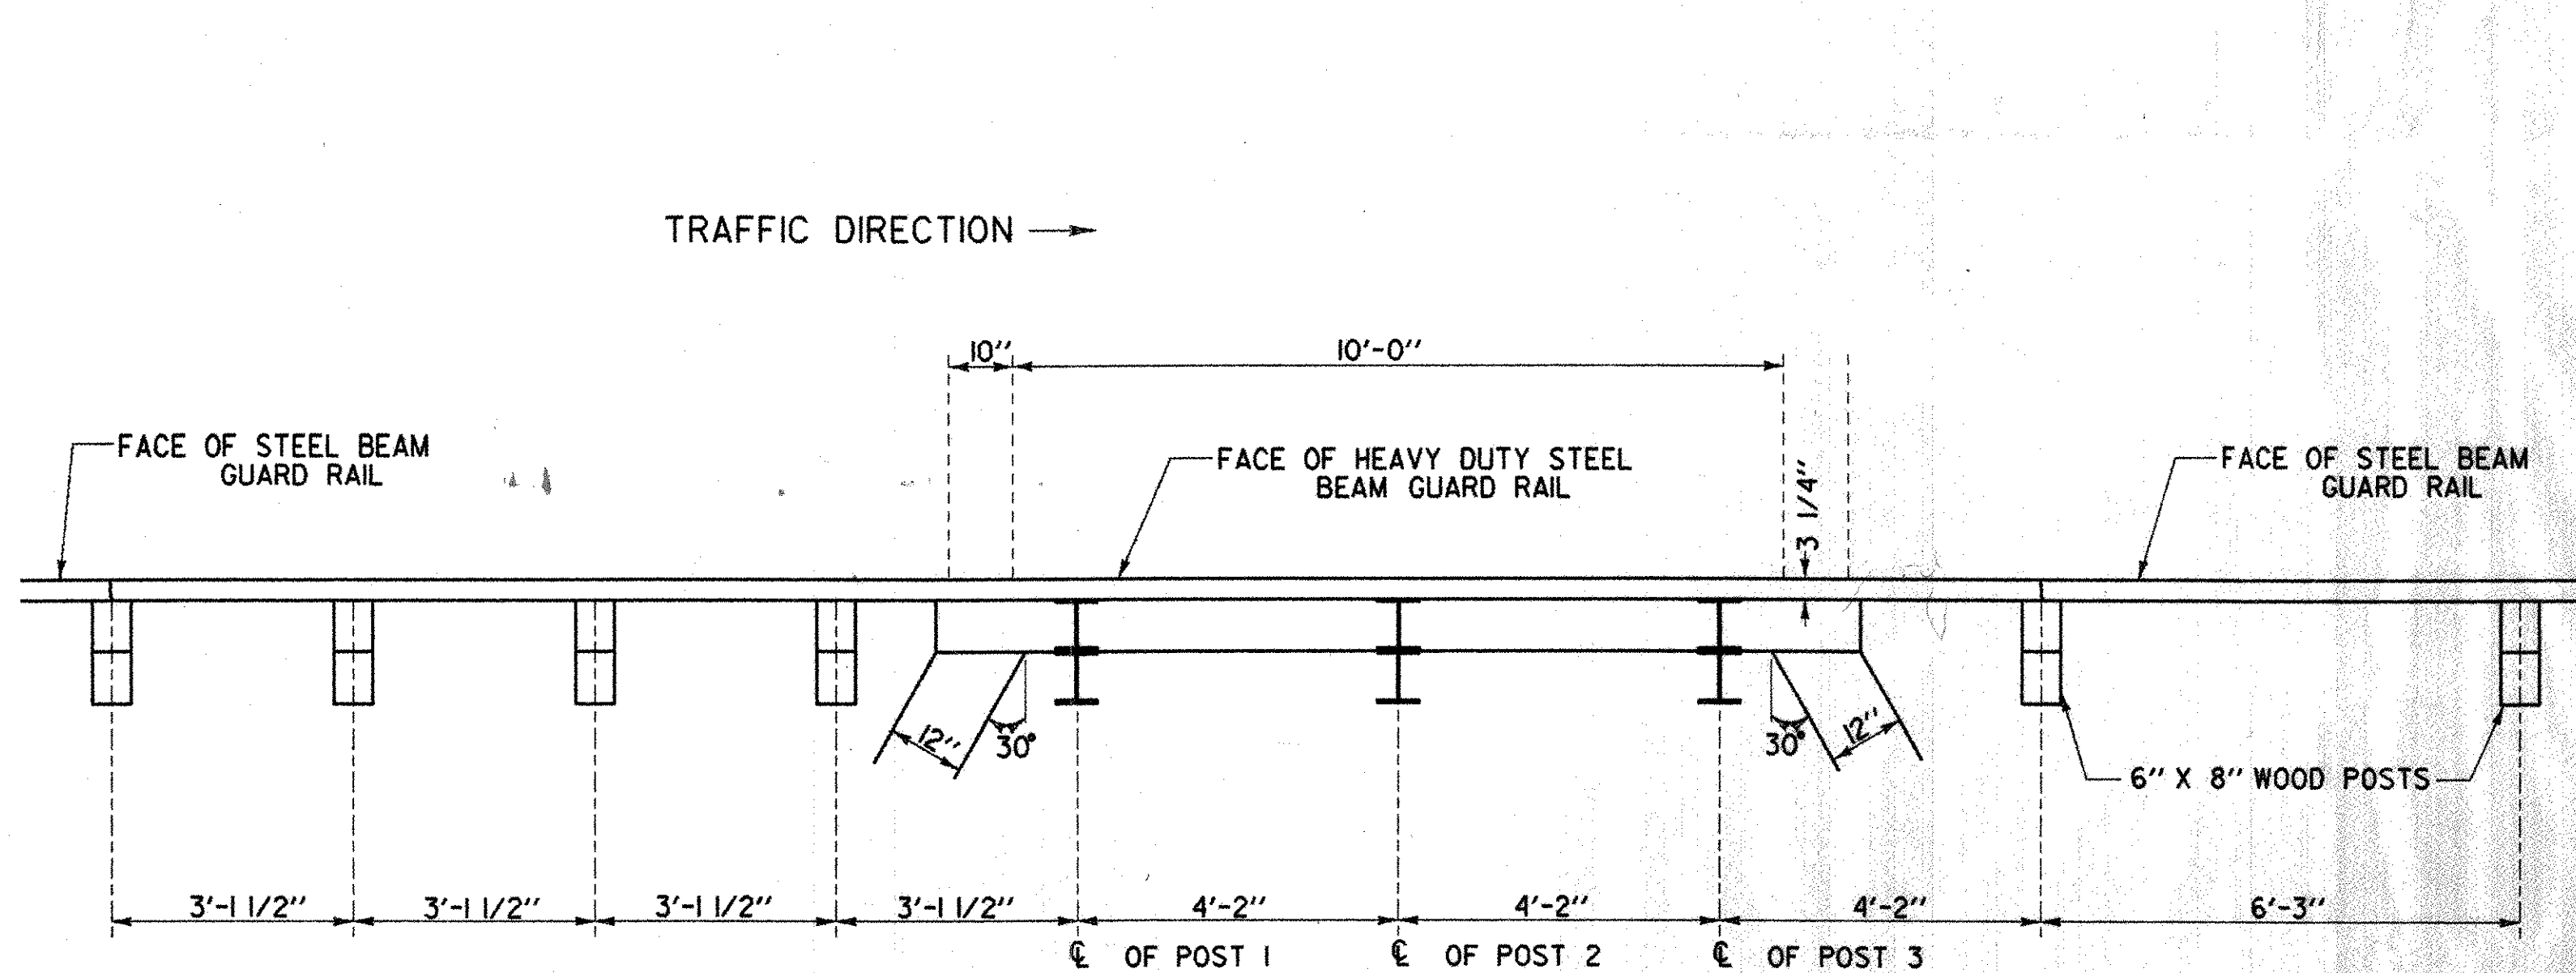

POST SPACING
SCALE: 1/2" = 1'-0"

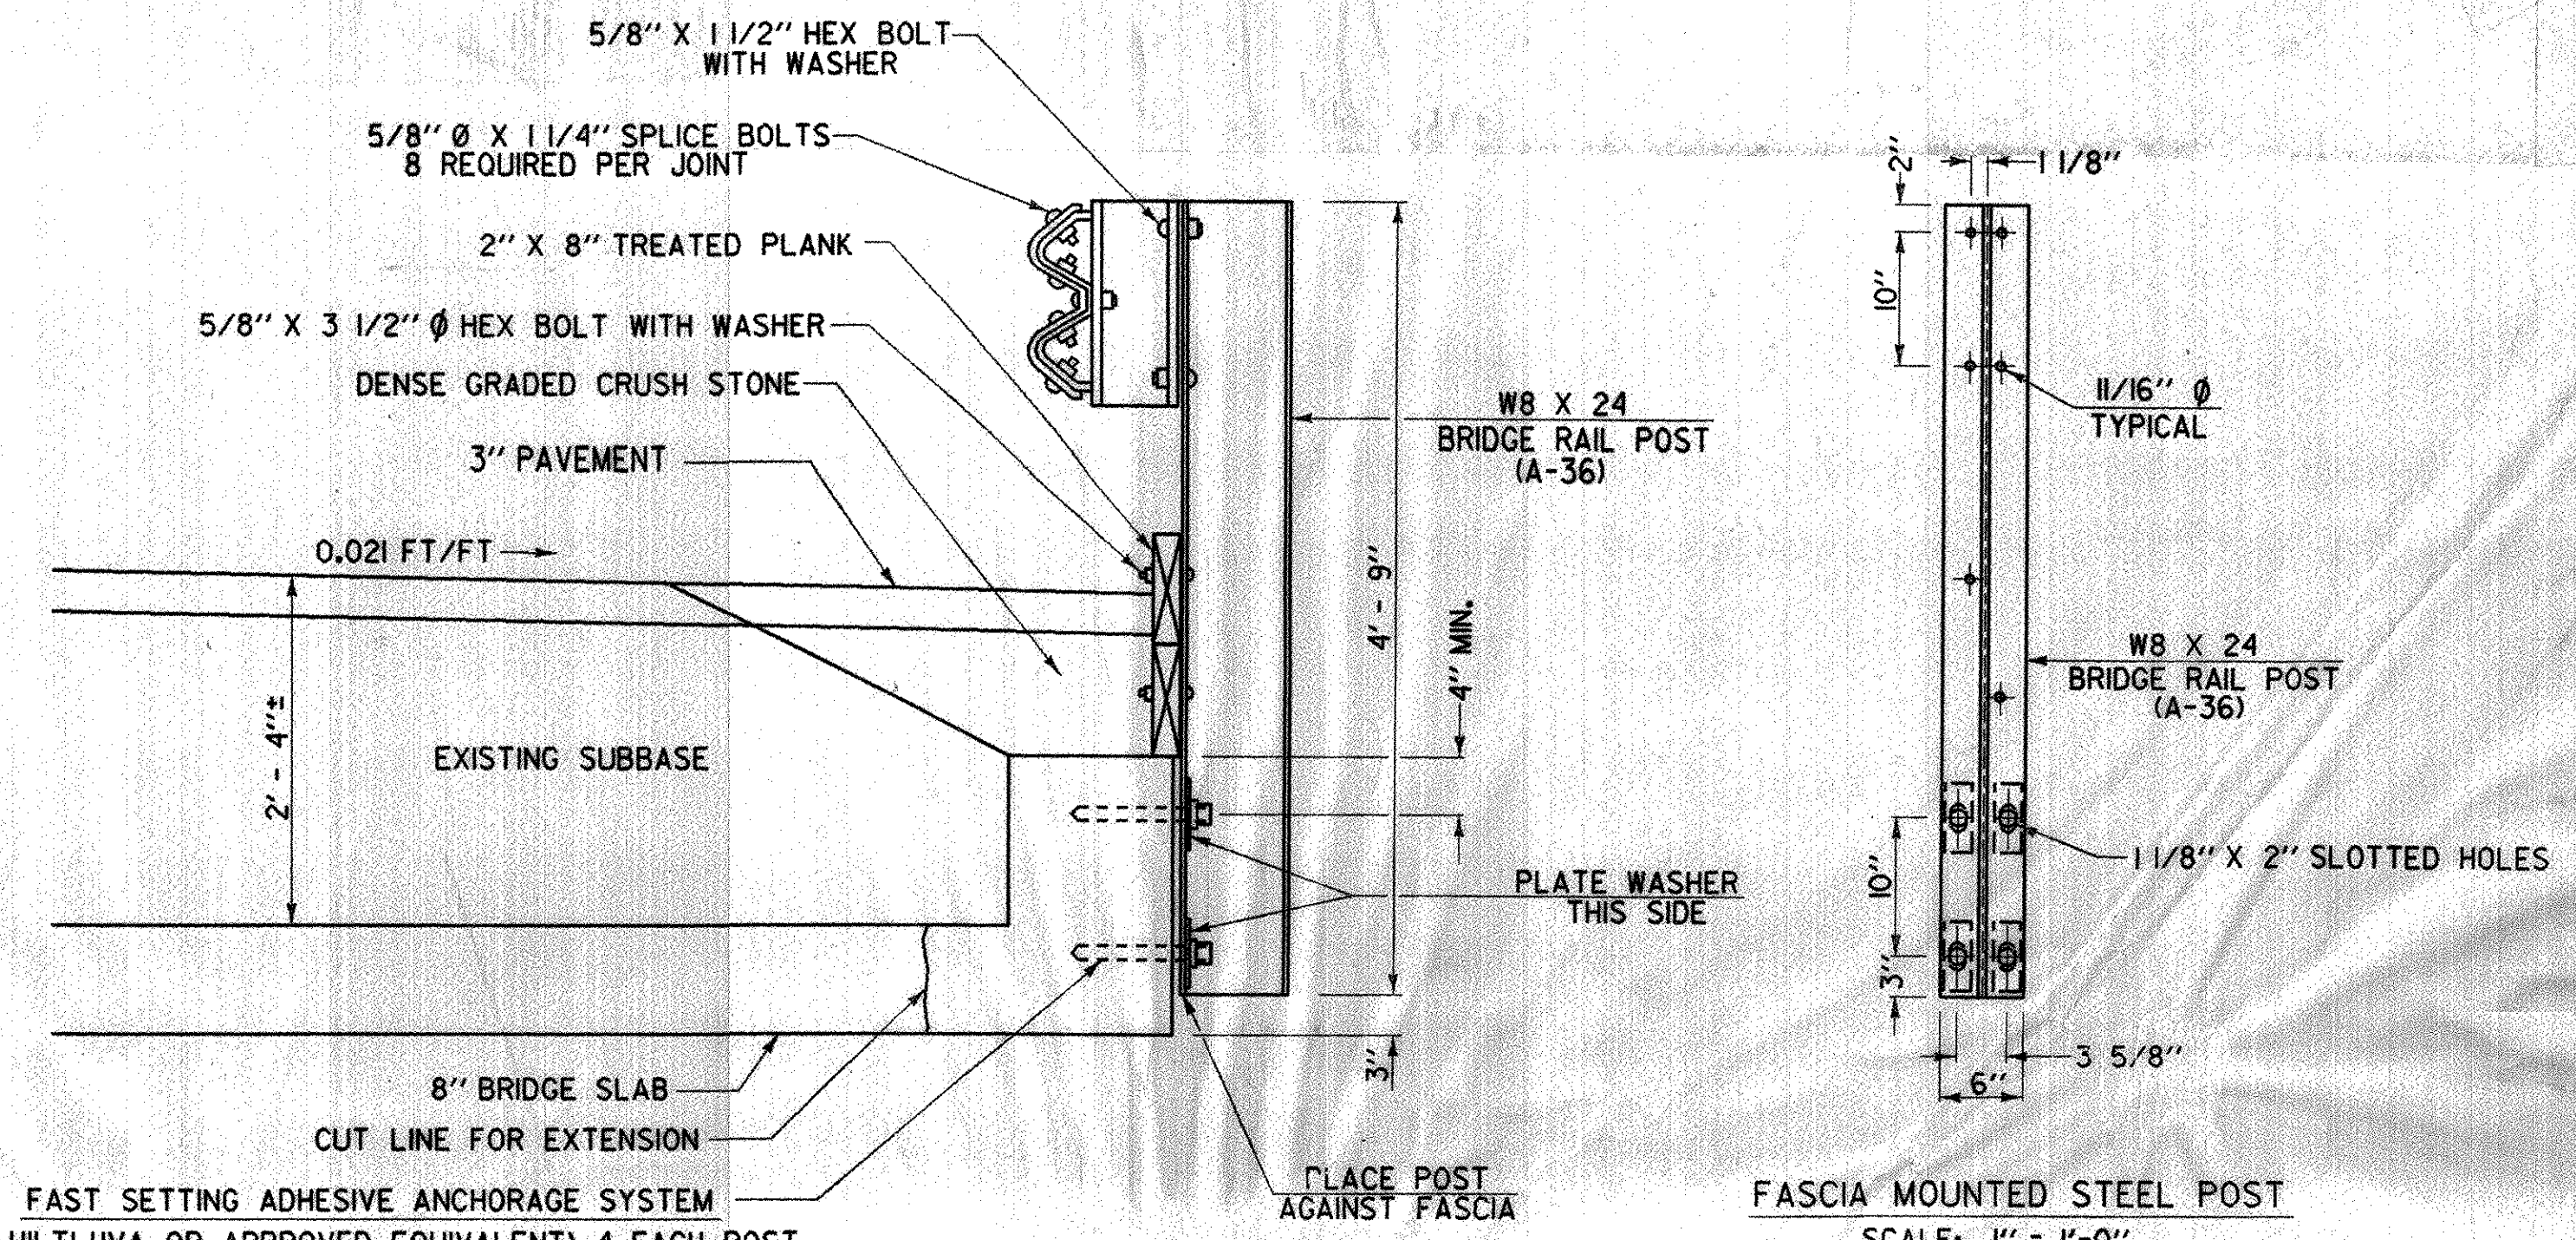

FASCIA MOUNTED STEEL POST
SCALE: 1" = 1'-0"

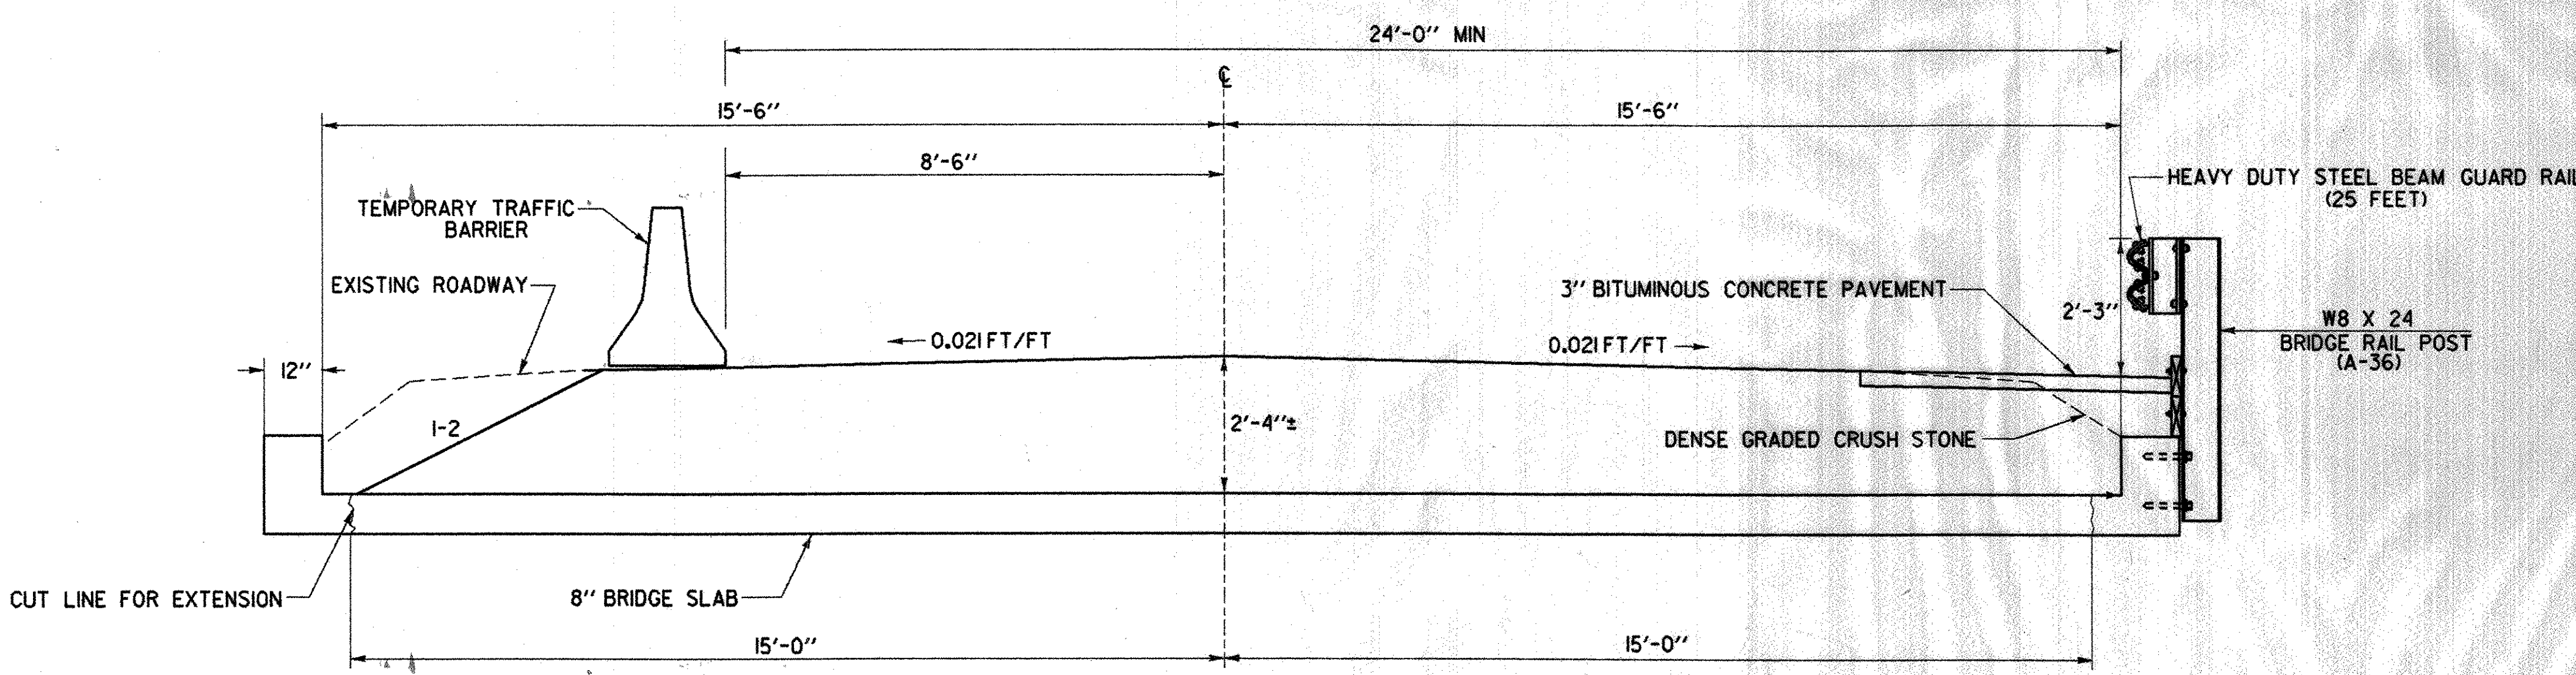

TEMPORARY BRIDGE DETOUR TYPICAL
SCALE: 1/2" = 1'-0"

SURVEYED BY	PERKINS	DATE	
DRAWN BY	PERKINS	DATE	
SQUAD LEADER	PERKINS		
DESIGN FILE NO.	ZG0450,70183B030TY.DGN		
PRF FILE	83B030BR	DATE PLOTTED	14-NOV-1989
PROJ. NAME	SHOREHAM-ADDISON-BRIDPORT		
PROJ. NO.	F017-1(2)		
SHEET	248	OF	420 SHEETS