
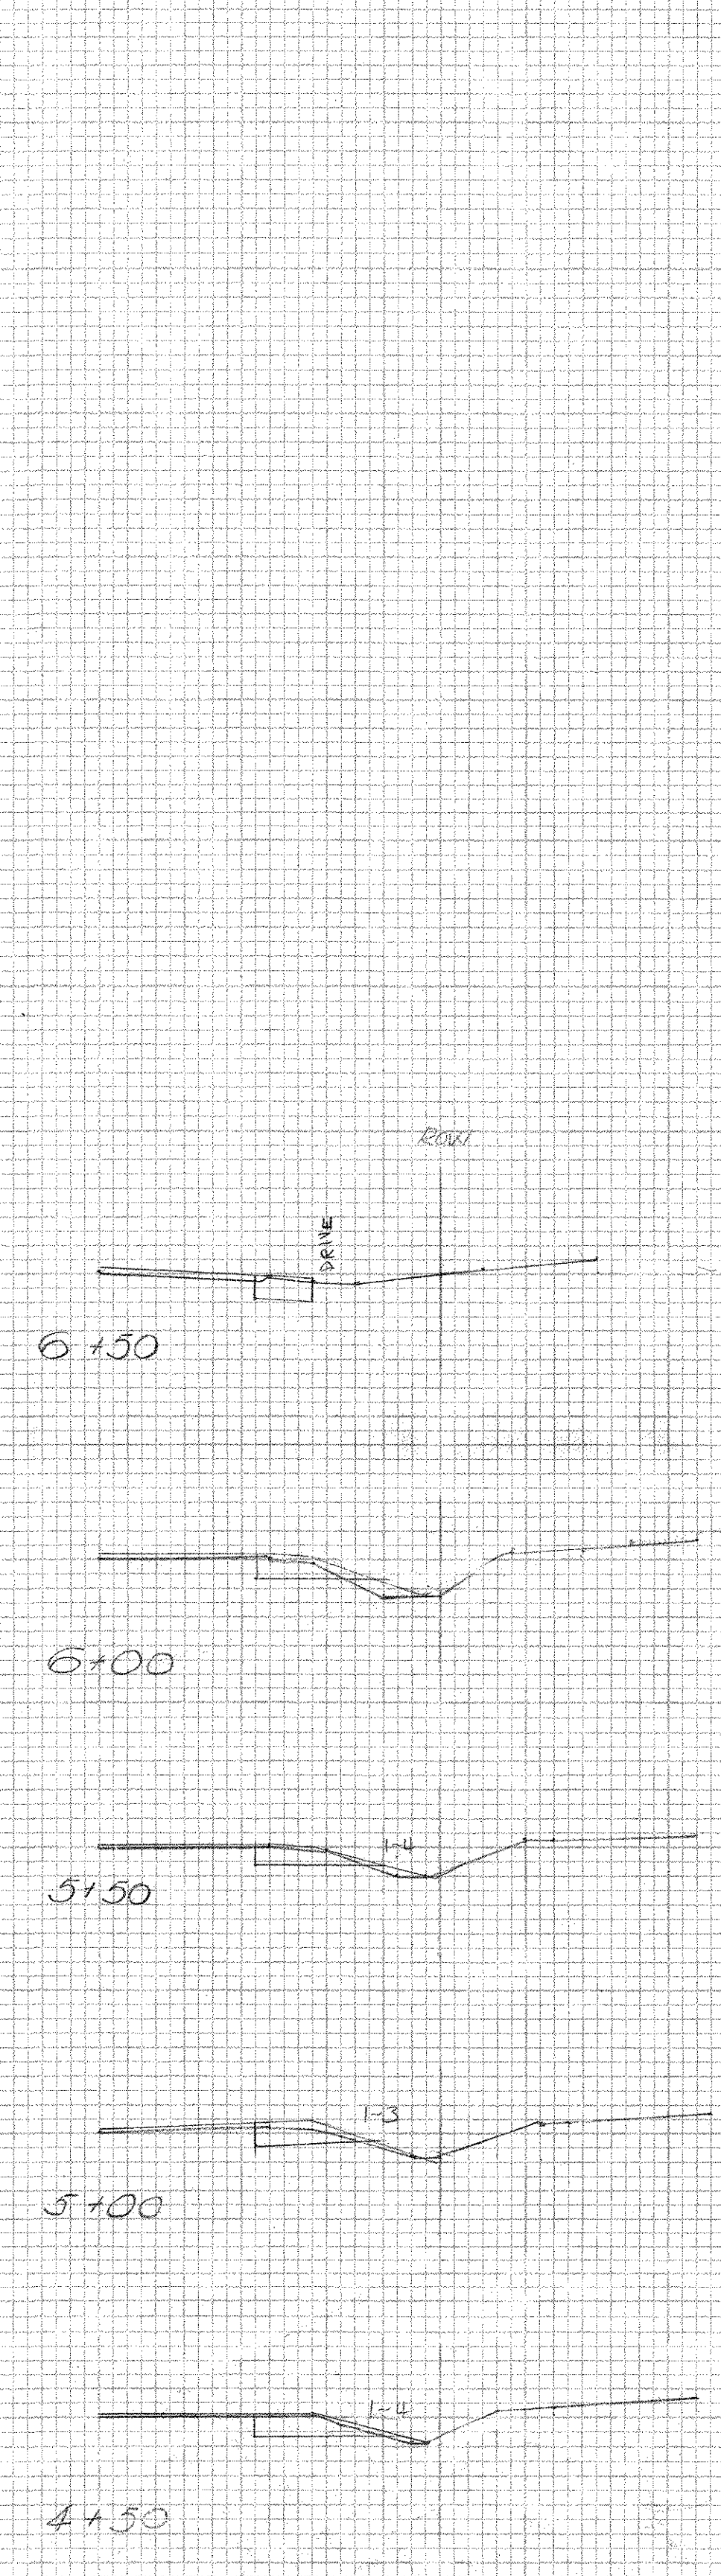


DATE _____
 BY _____
 SURVEYED _____
 PLOTTED _____
 FINAL SURVEY NOTE BOOK NO. _____
 AREA CHECKED _____

DATE _____
 BY _____
 SURVEYED _____
 PLOTTED _____
 ORIGINAL SURVEY NOTE BOOK NO. _____
 AREA CHECKED _____

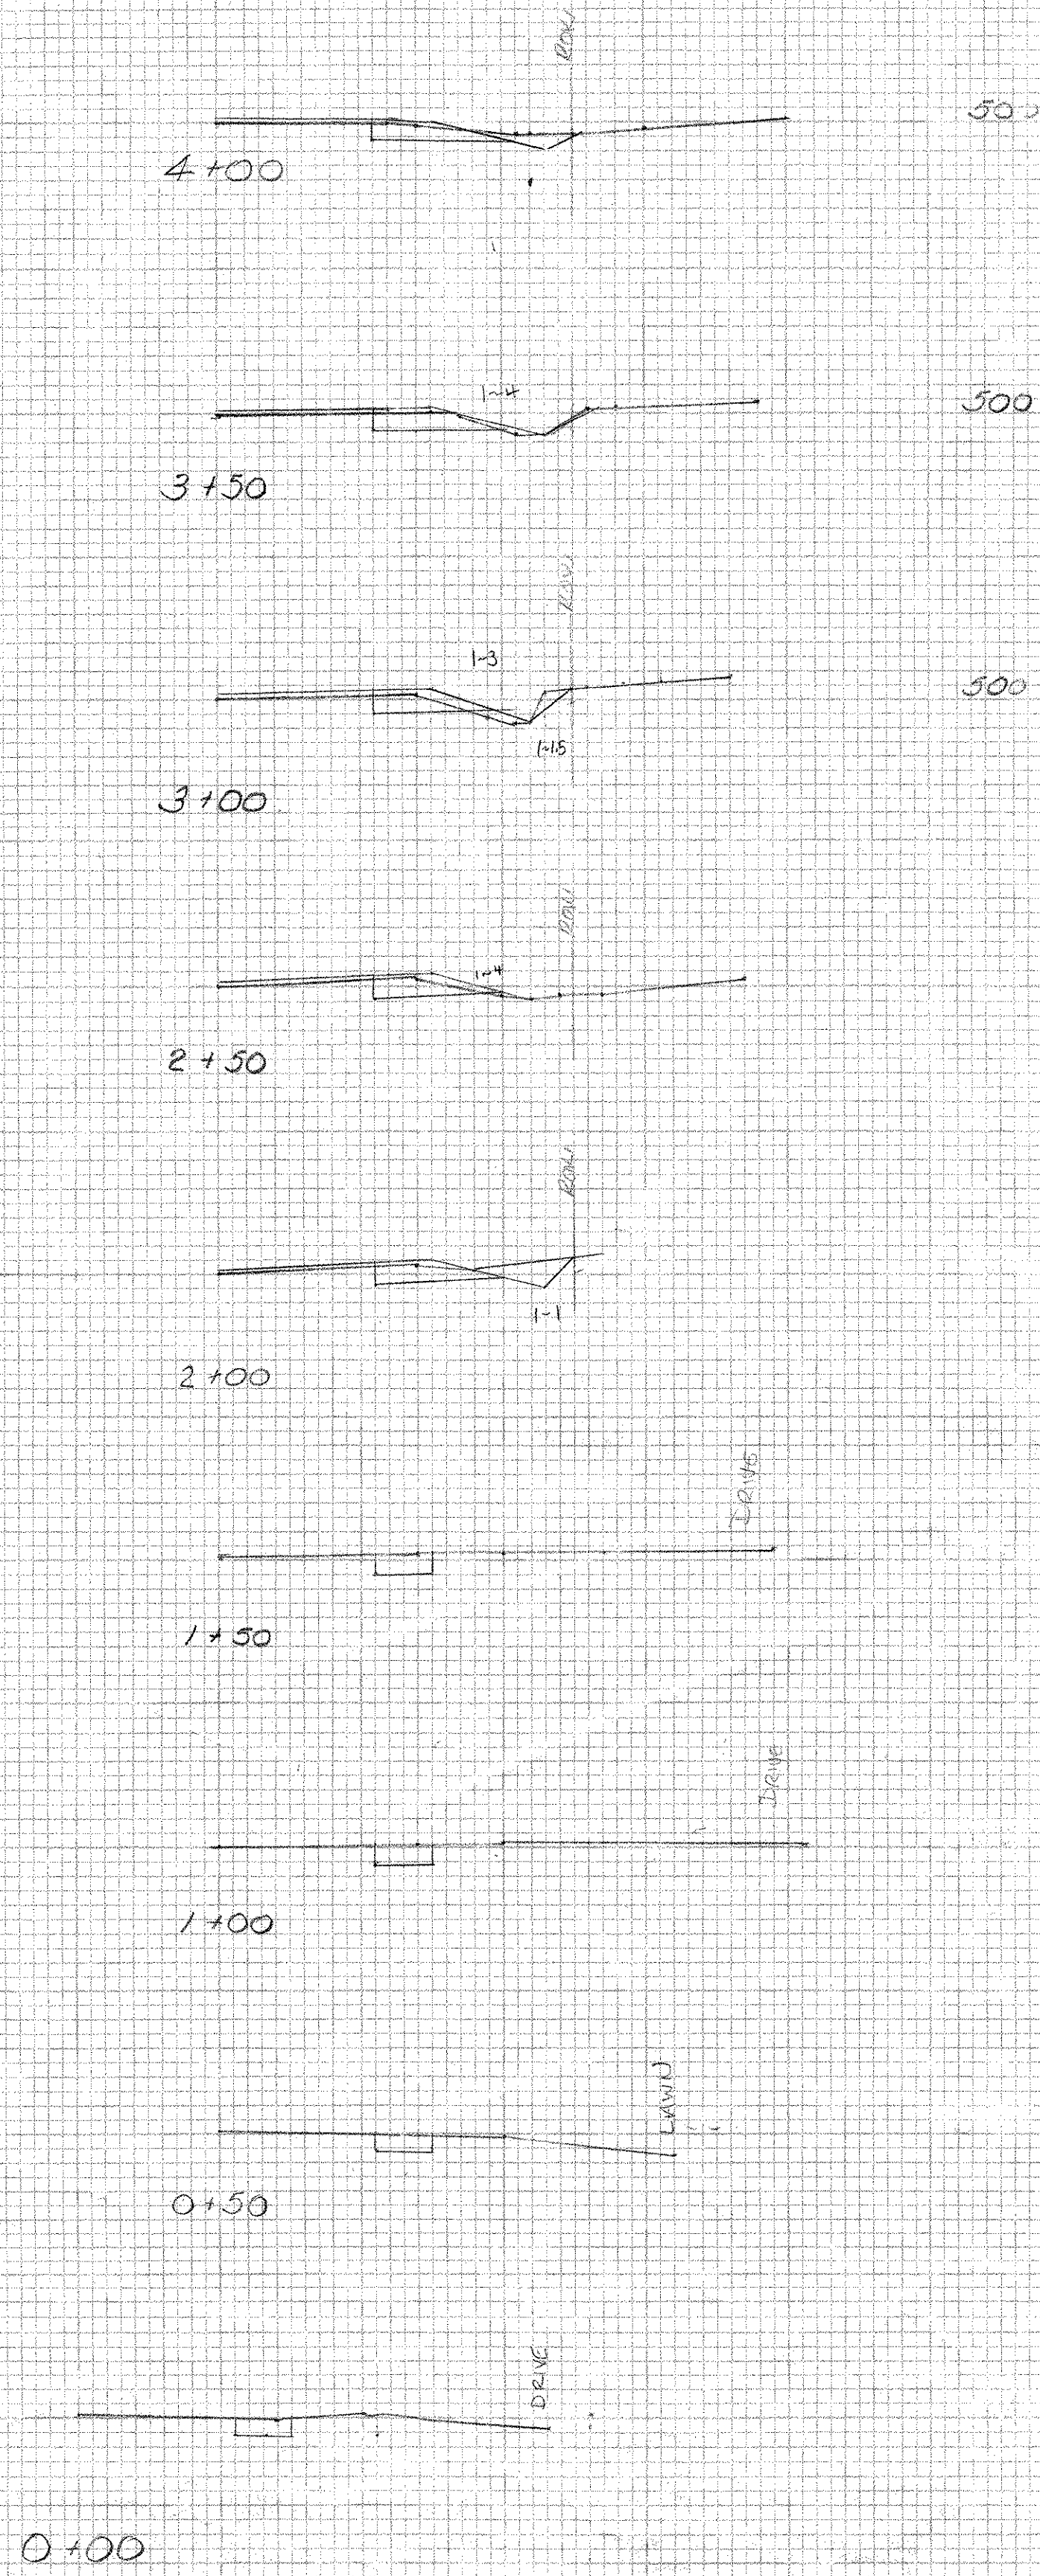

CHANGE ELEVATION OF D.I. TO MEET DITCH

SHOREHAM BRIDPORT ADDITION
F 017-1(2)

0+00 - 6+50 RT

Original Sections