



10+10 Lt.
Begin Removal and Disposal
of Guard Rail

11+40 Lt
END Removing & Resetting Fence
Temporary Barbed Wire Fence (4-strand)

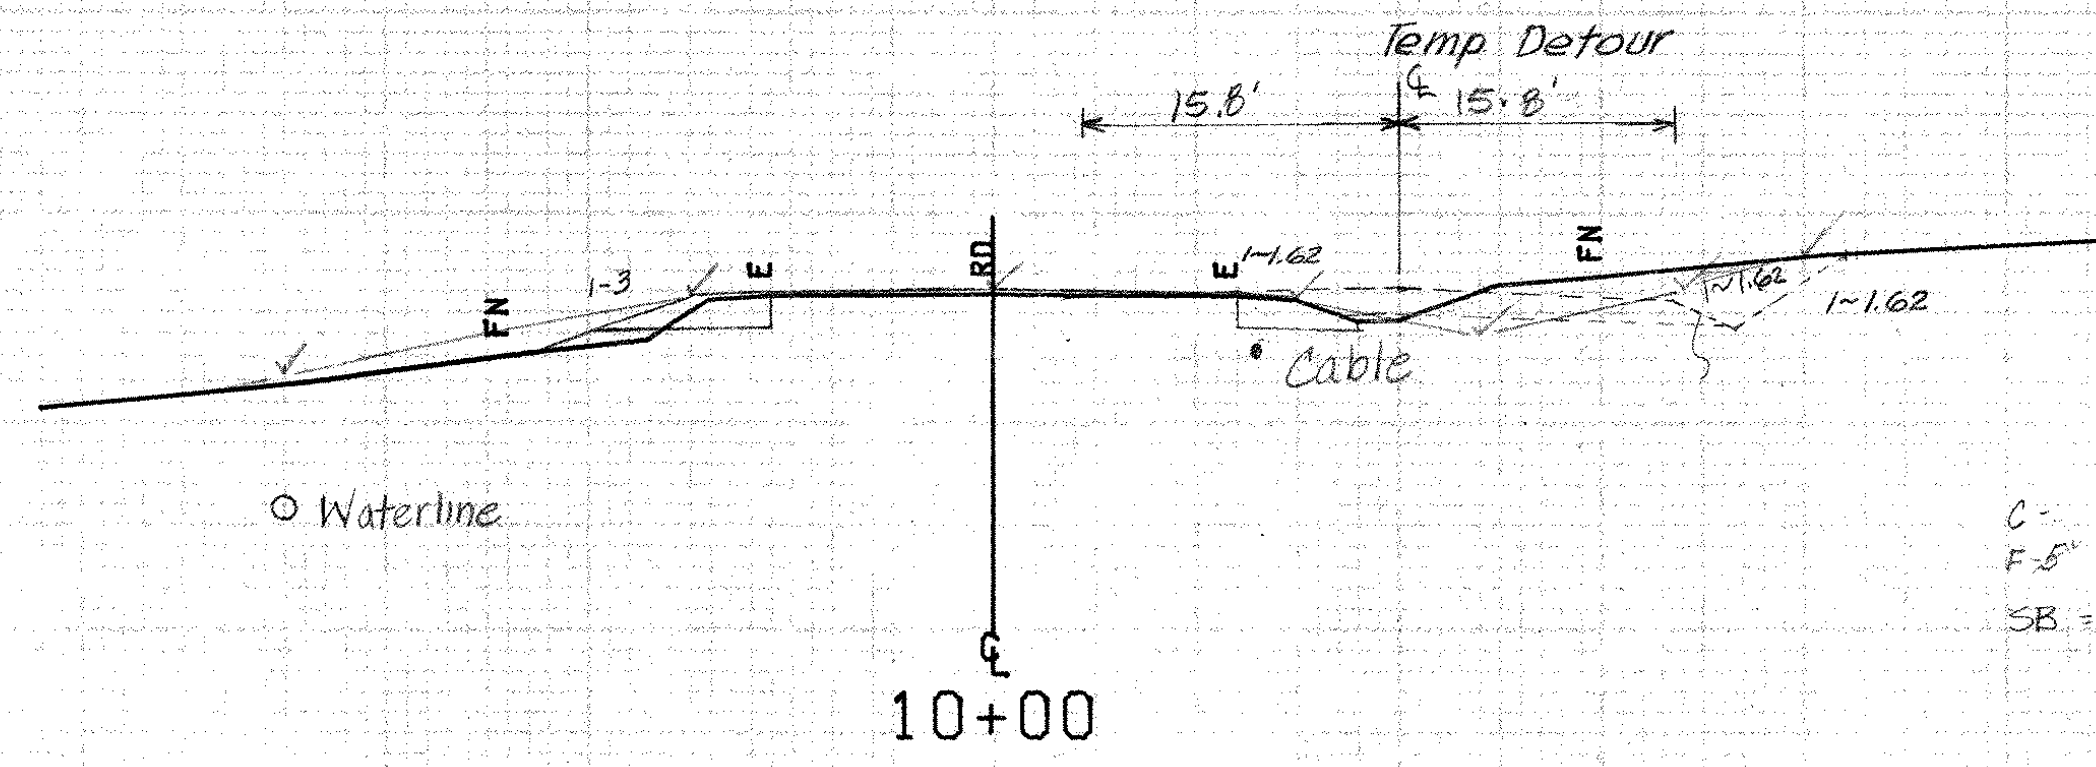


DETOUR	T.S.G.	17.02	20.0	484.7
C-39			24.0	484.0
F-1			34.0	486.3
SB-25			40.0	487.8
			25.0	486.4
			20.0	484.7

C-# 7 14
F-# 3
SB-14

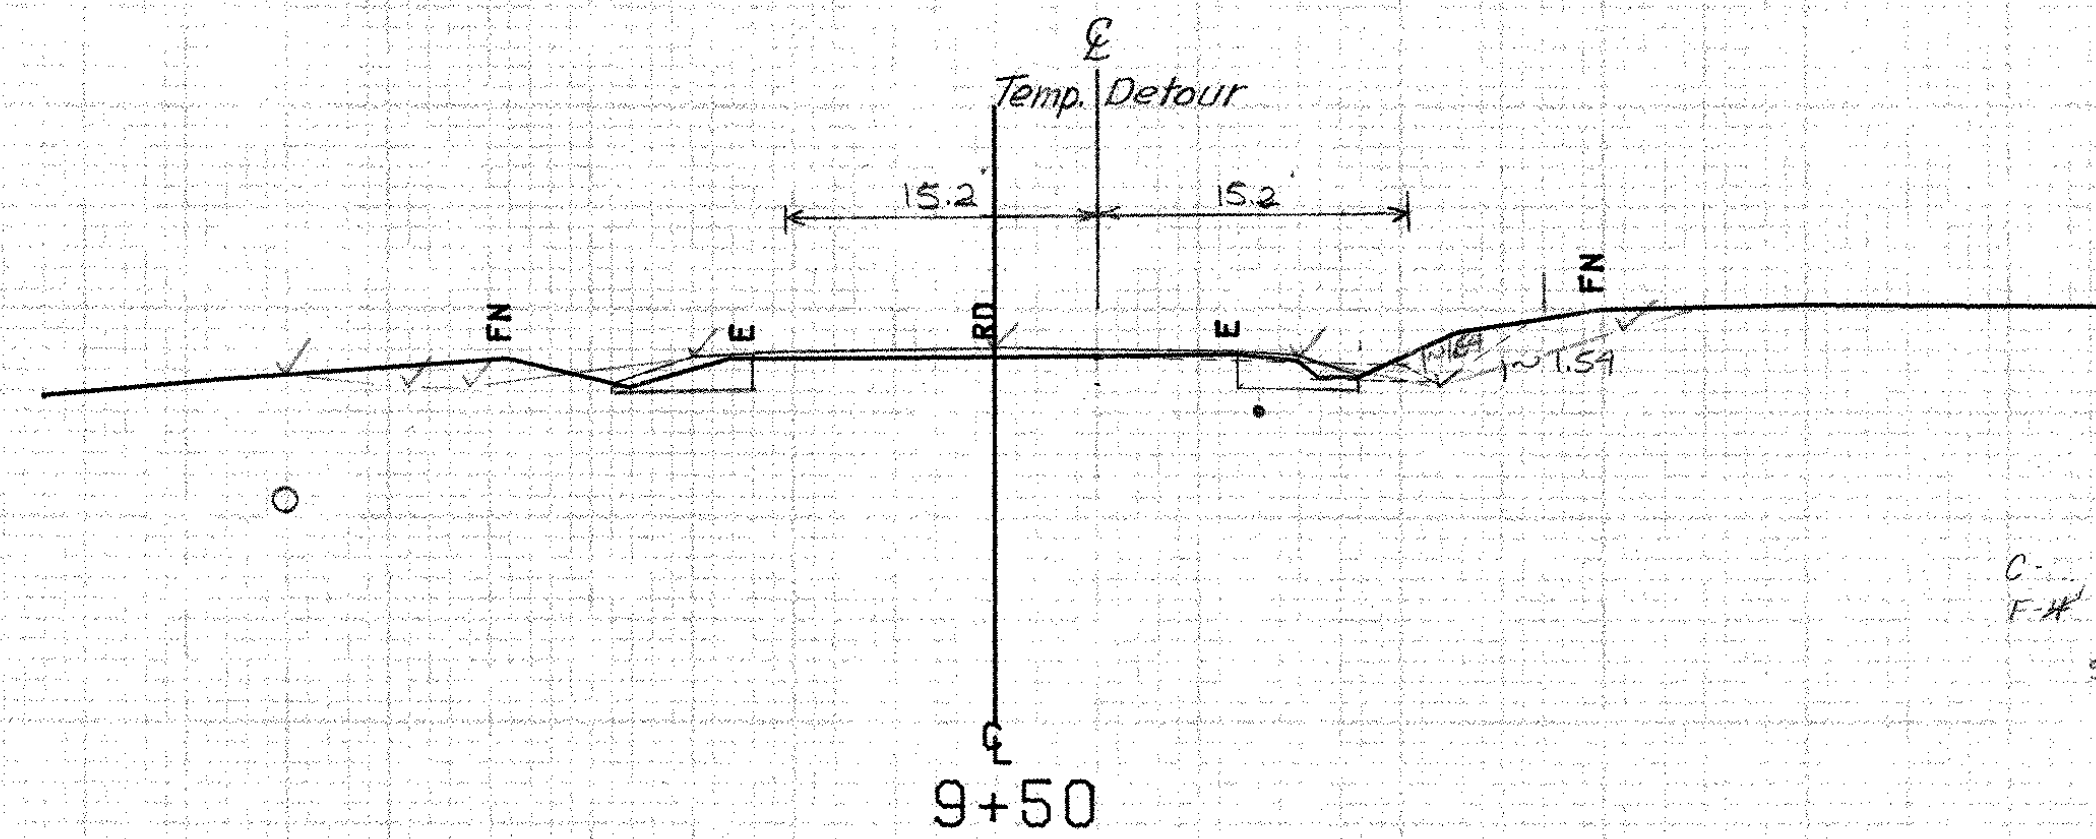


DETOUR	T.S.G.	17.02	16.0	486.5
C-8			22.0	486.2
F-0			31.0	489.0
SB-7			35.0	490.0
			18.0	486.5

C-# 12
F-# 0
SB-12

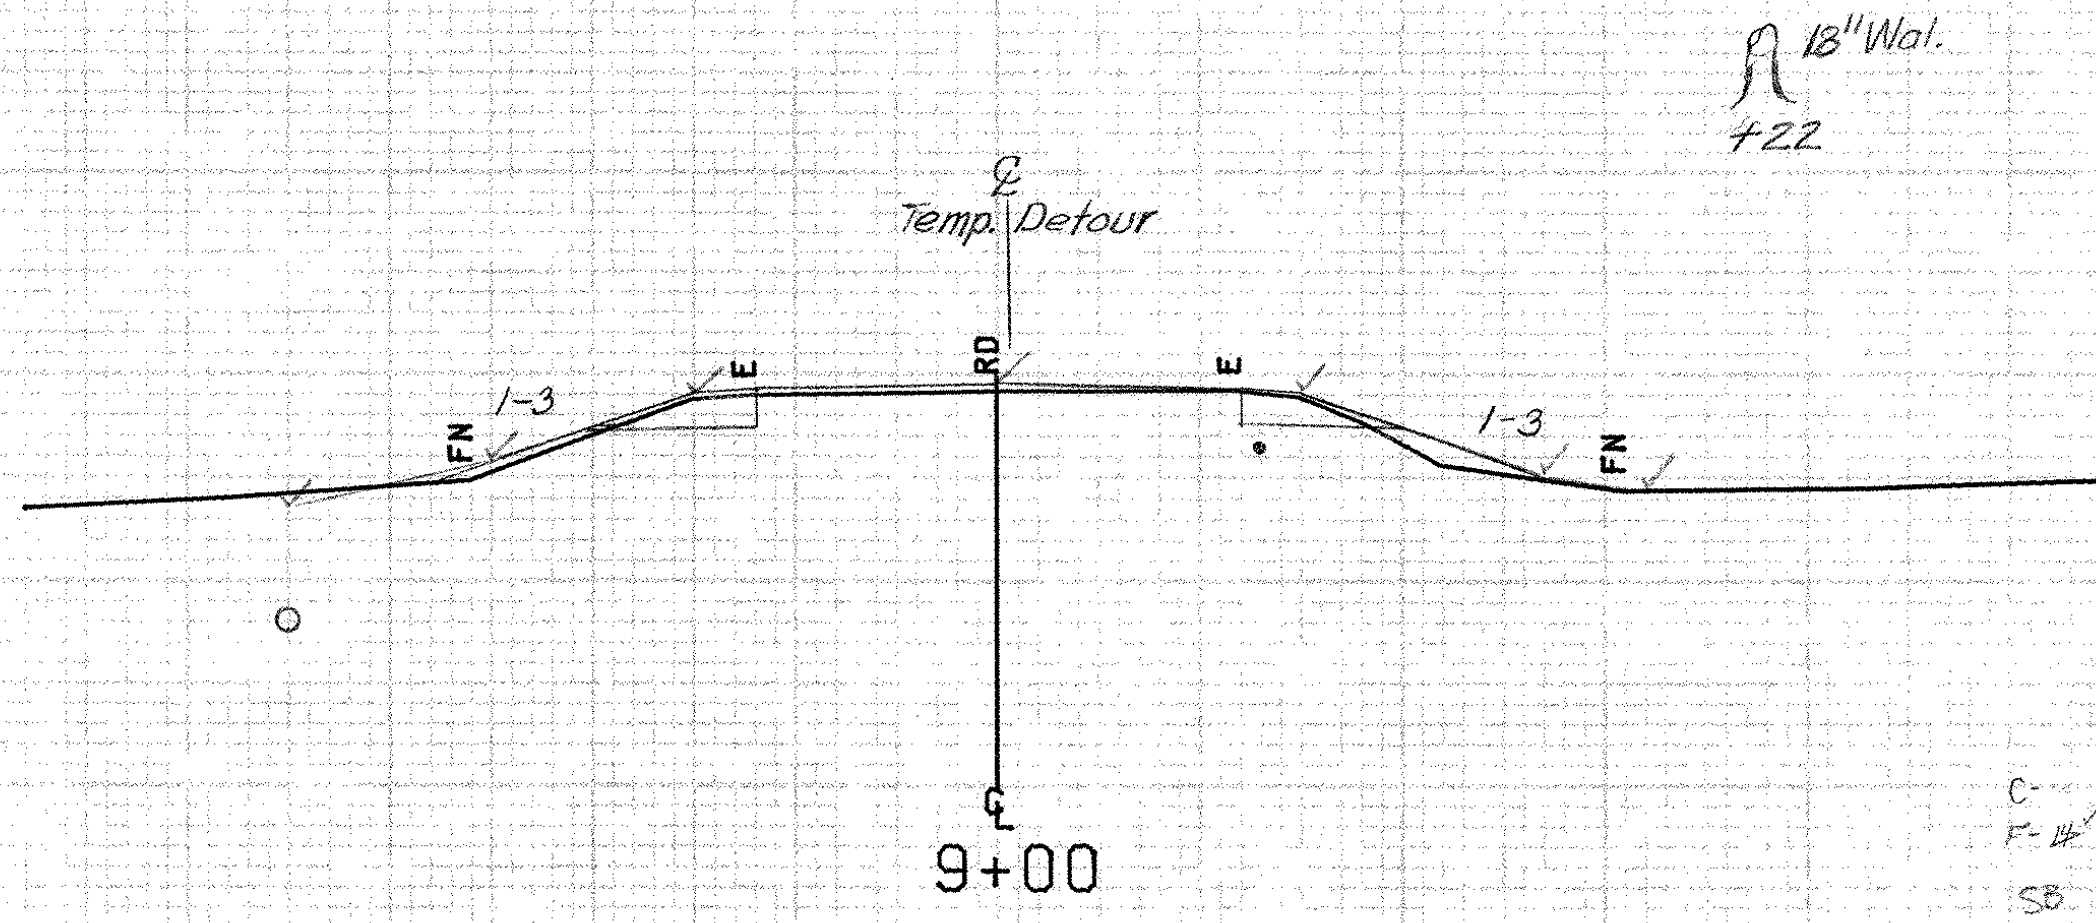

C-# 10 14
F-# 75 8
SB-13.5

8+80 Rt.
Begin Construction of
Temporary Detour

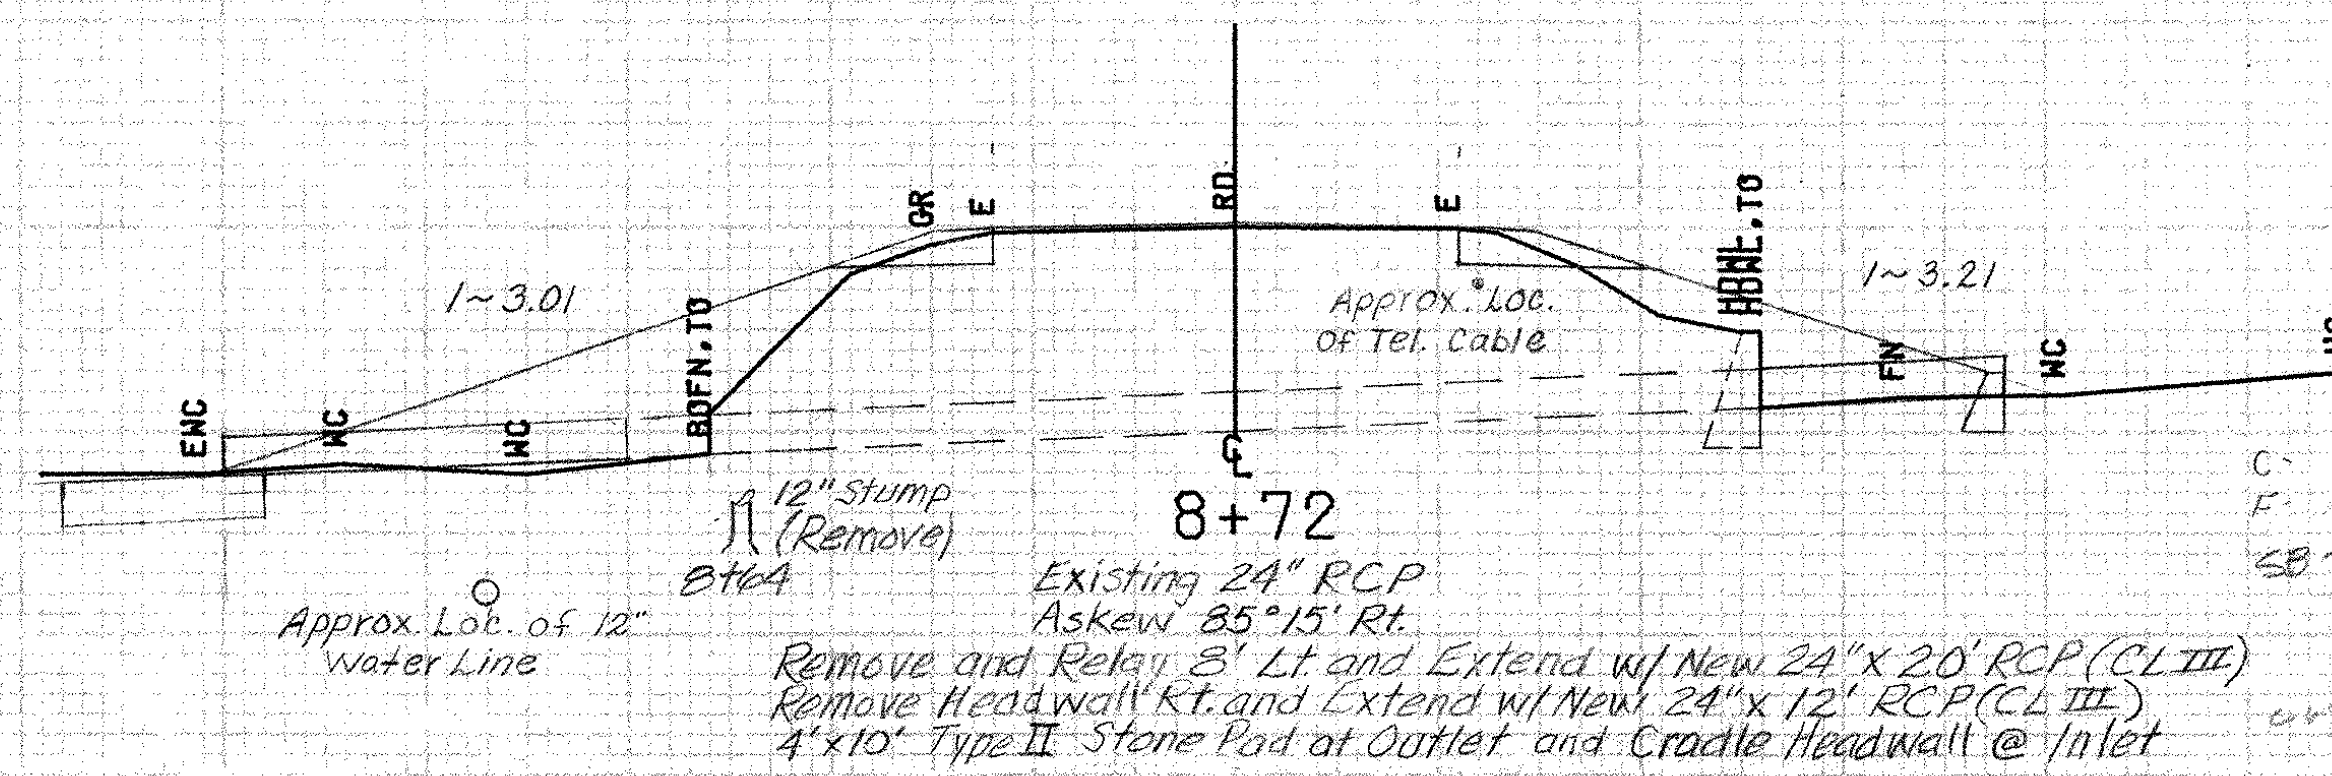

C-# 12 14
F-# 161 164
SB-15

SHOREHAM MM 3.73 ~ MM 3.88

FROM STA.	8+72	TO STA.	10+00
PROJECT NAME	SHOREHAM-BRIDPORT-ADDISON		
NO.	F017-1(2)	PLOTTED	03/13/84
SURVEYED BY	FANTONI	MARCH 84	
SHEET	253	OF 420 SHEETS	SHEET 253 OF 477

SCALE 10 FEET