


13+30 Rt.
End Construction of
Temporary Detour

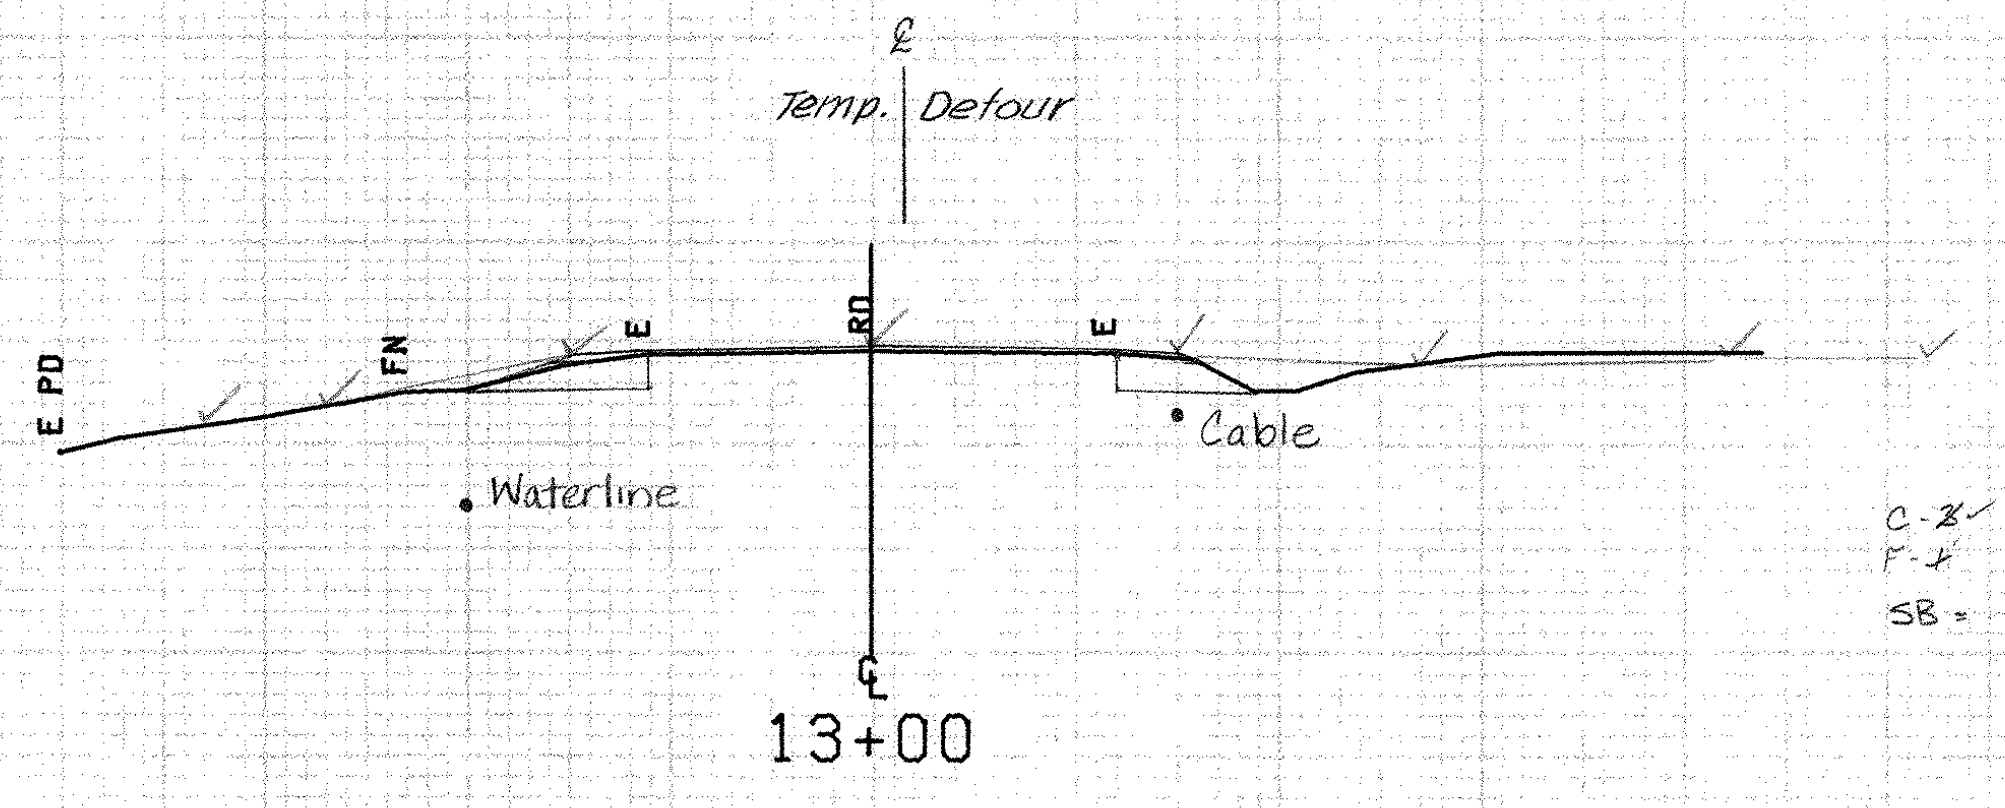


480

C-2 = 16
F-4 = 0
SB = 14

DETOUR	REMOVAL
38	482
29	482.6
20	483.3
37	483.3
38	482

Temp. Detour

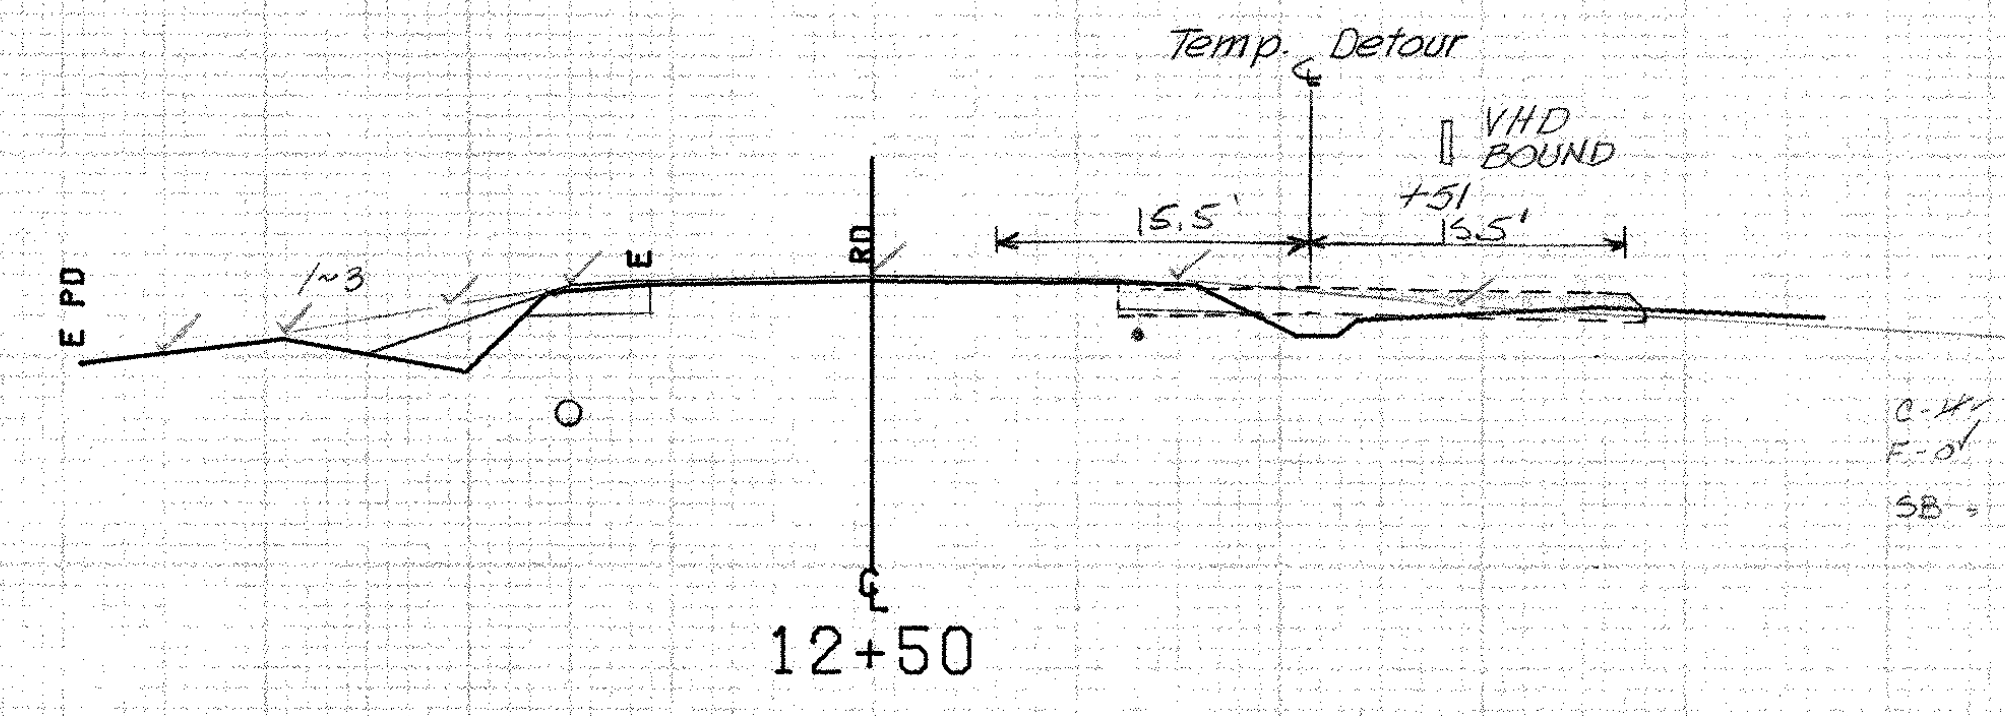


480

C-14 = 14
F-0 = 0
SB = 11.5

DETOUR
C = 5
F = 4
SB = 25


12+18 Rt.
End Removal and Disposal
of Guard Rail

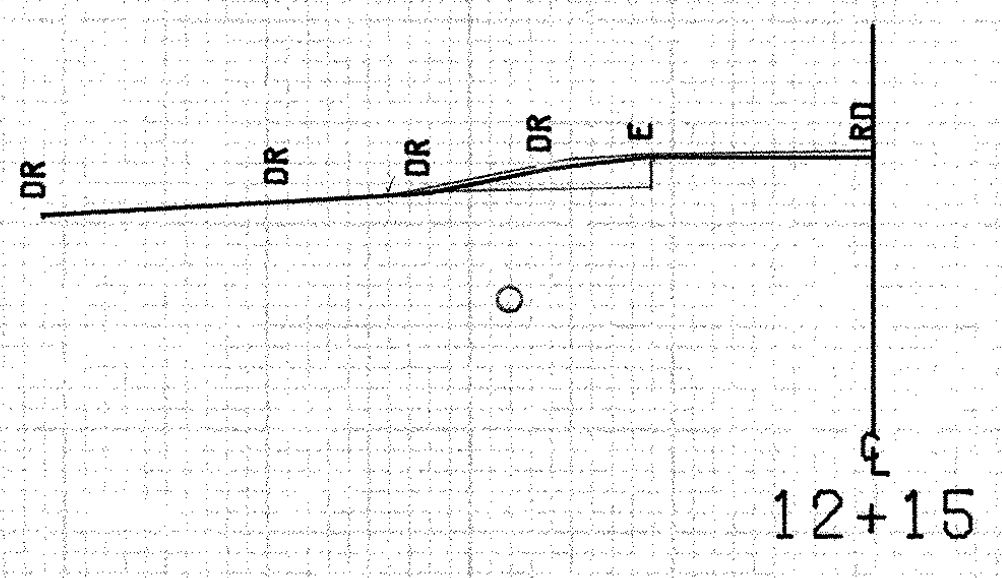

480

DETOUR	REMOVAL
44	478
24	486
22	481.7
39	481.4
44	478

Temp. Detour

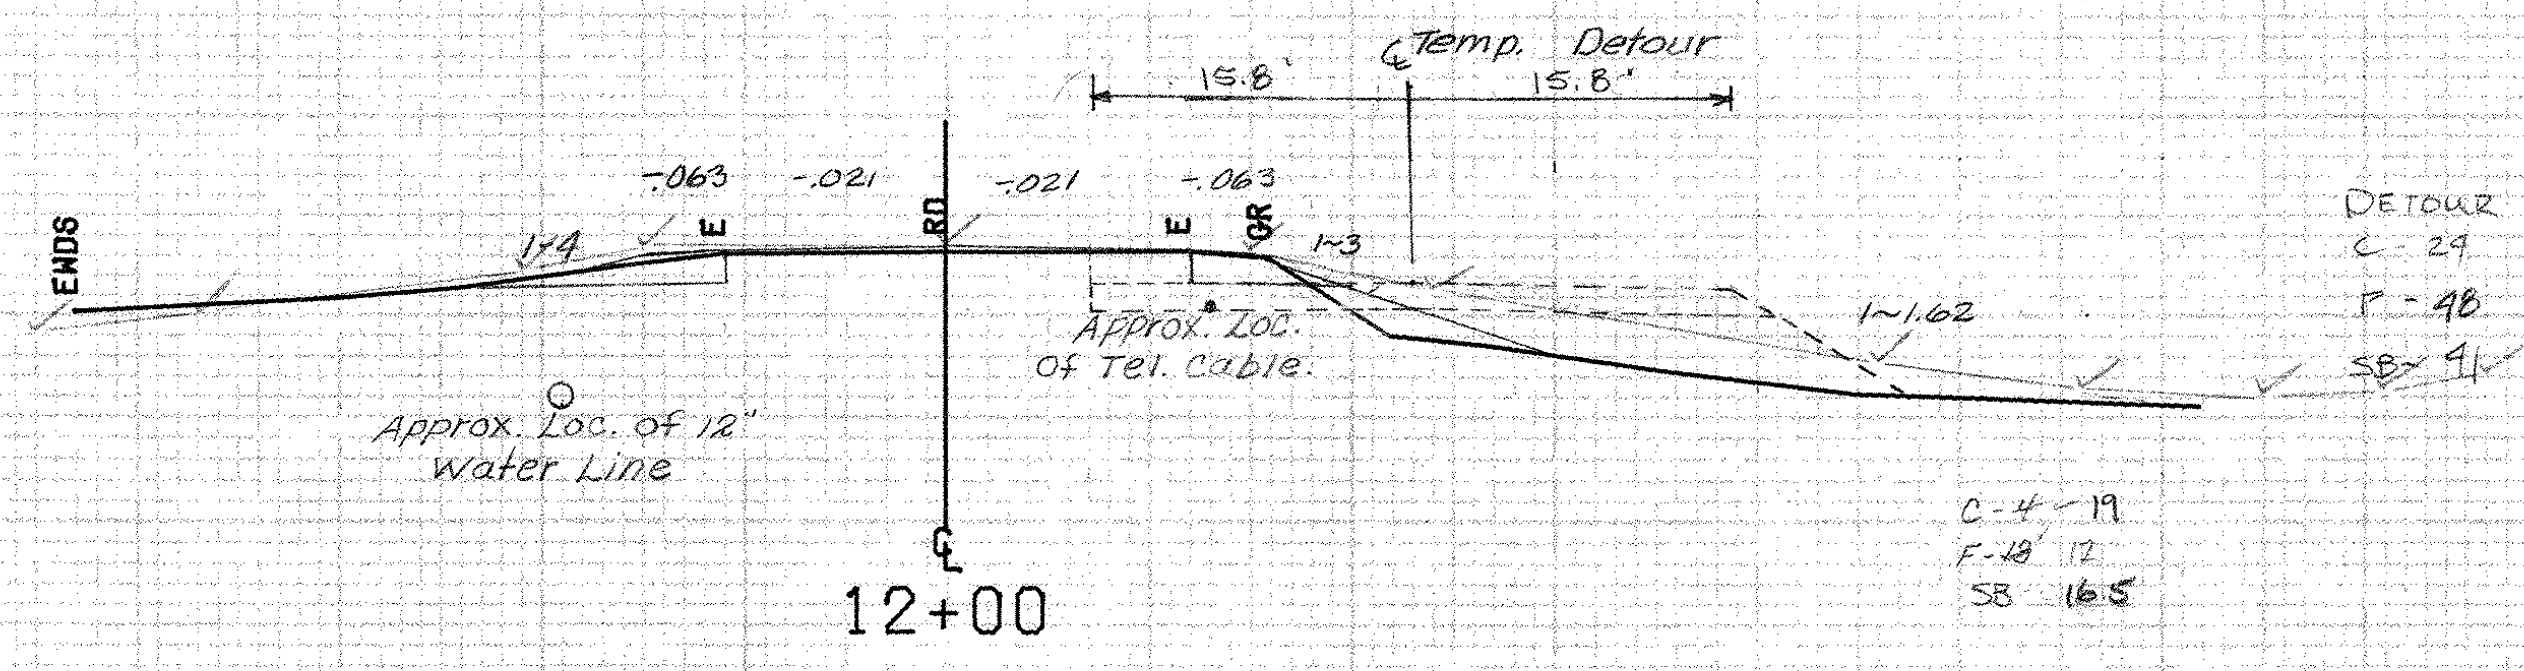

480

C-4 = 14
F-18 = 12
SB = 16.5

DETOUR
C = 29
F = 48
SB = 41

11+92 Lt.
End Removal and Disposal
of Guard Rail

SHOREHAM MM 3.73 - MM 3.88

FROM STA. 12+00	TO STA. 13+00
PROJECT NAME	SHOREHAM-BRIDPORT-ADDISON
NO.	F017-1(2)
SURVEYED BY	FANTONI
SHEET 255 OF 420 SHEETS	PLOTTED 03/13/84
	MARCH 84
	SHEET 255 OF 477

SCALE 1" = 10 FEET