

DATE _____ BY _____
 SURVEYED _____ PLOTTED _____
 ORIGINAL SURVEY _____
 NOTE BOOK _____
 NO. _____

DATE _____ BY _____
 SURVEYED _____ PLOTTED _____
 ORIGINAL SURVEY _____
 NOTE BOOK _____
 NO. _____

RT

22.0	498.6
23.0	498.3
24.0	498.9
25.0	502.3
27.0	503.5
29.0	502.5
30.0	502.7
22.0	498.6

RT











21.0	498.6
23.0	498.6
25.0	499.7
27.0	500.7
28.0	505.0
32.0	505.6
22.0	498.6
21.0	498.6

RT

20.27	498.5
23.0	498.2
30.0	505.7
33.0	505.1
29.0	502.0
28.0	498.7
20.27	498.5

RT

20.27	498.9
27.0	497.1
33.0	498.2
40.0	501.1
36.0	501.1
29.0	499.0
25.0	498.2
20.27	498.9

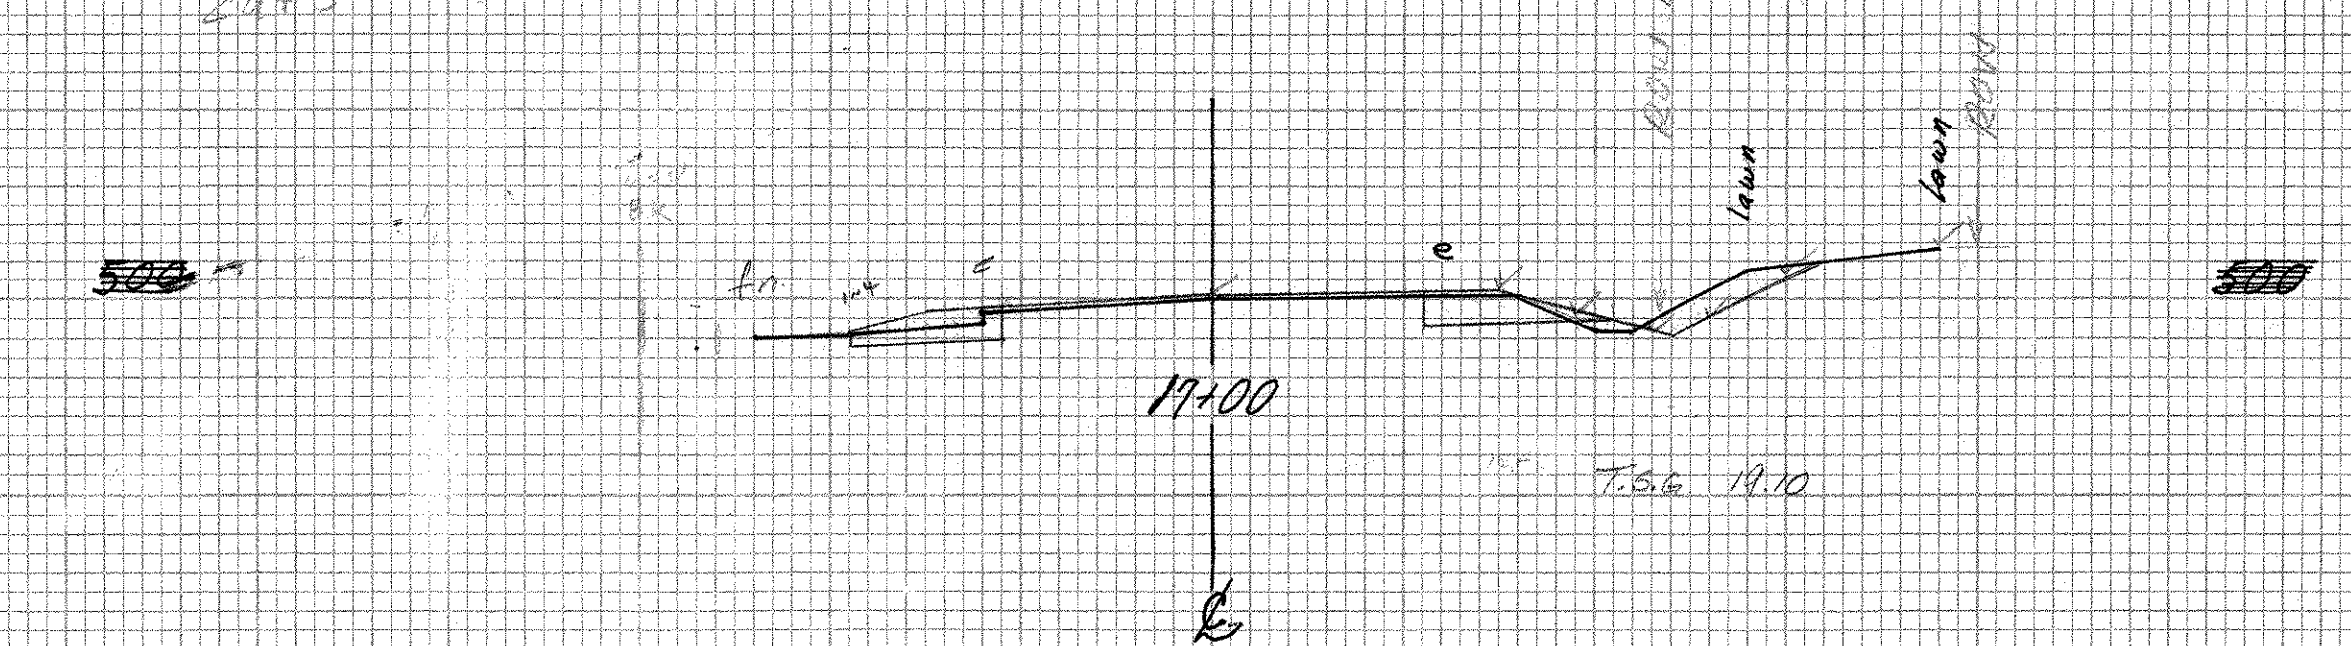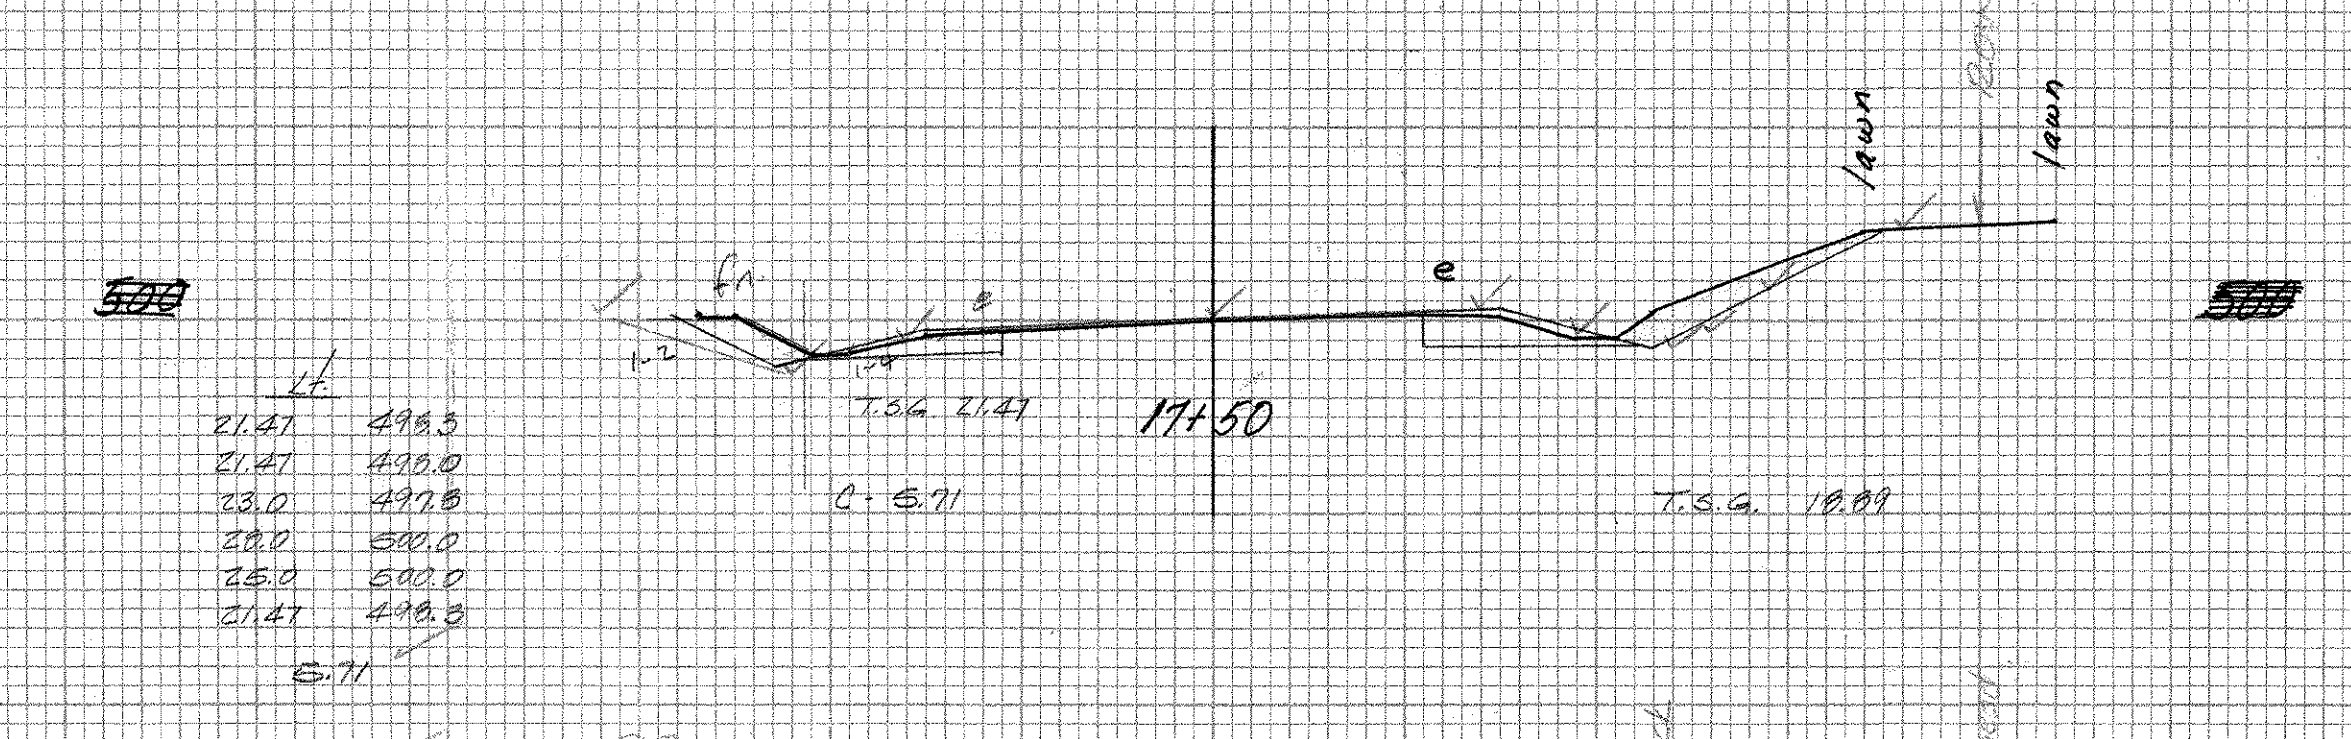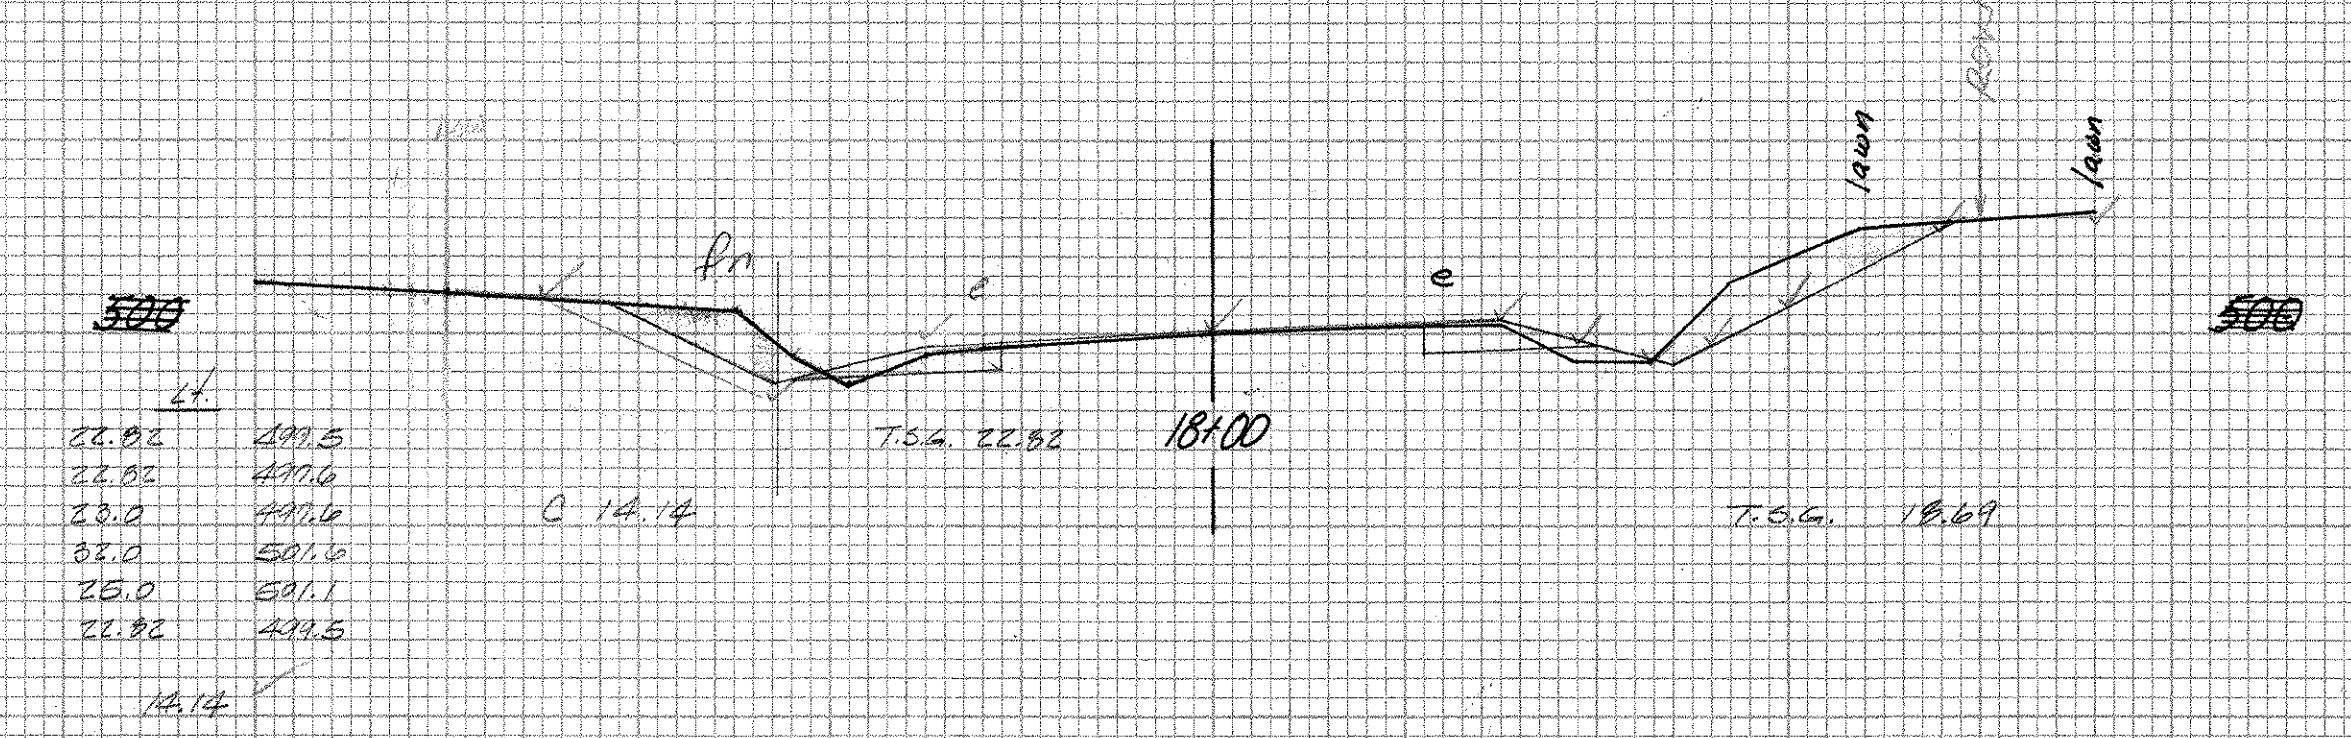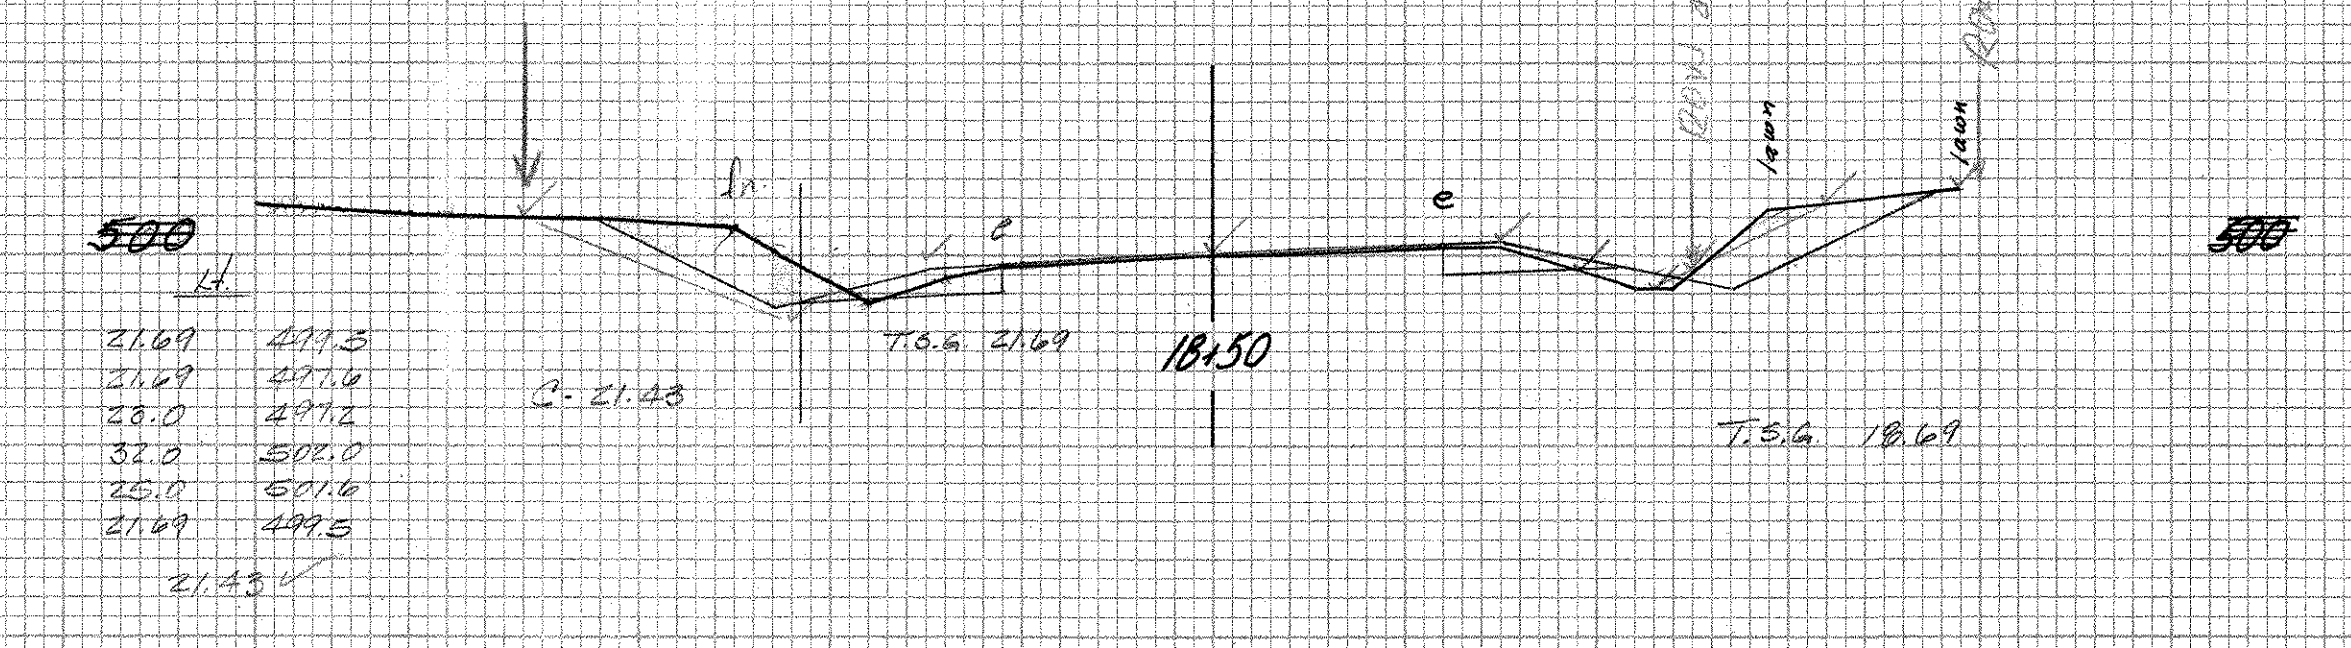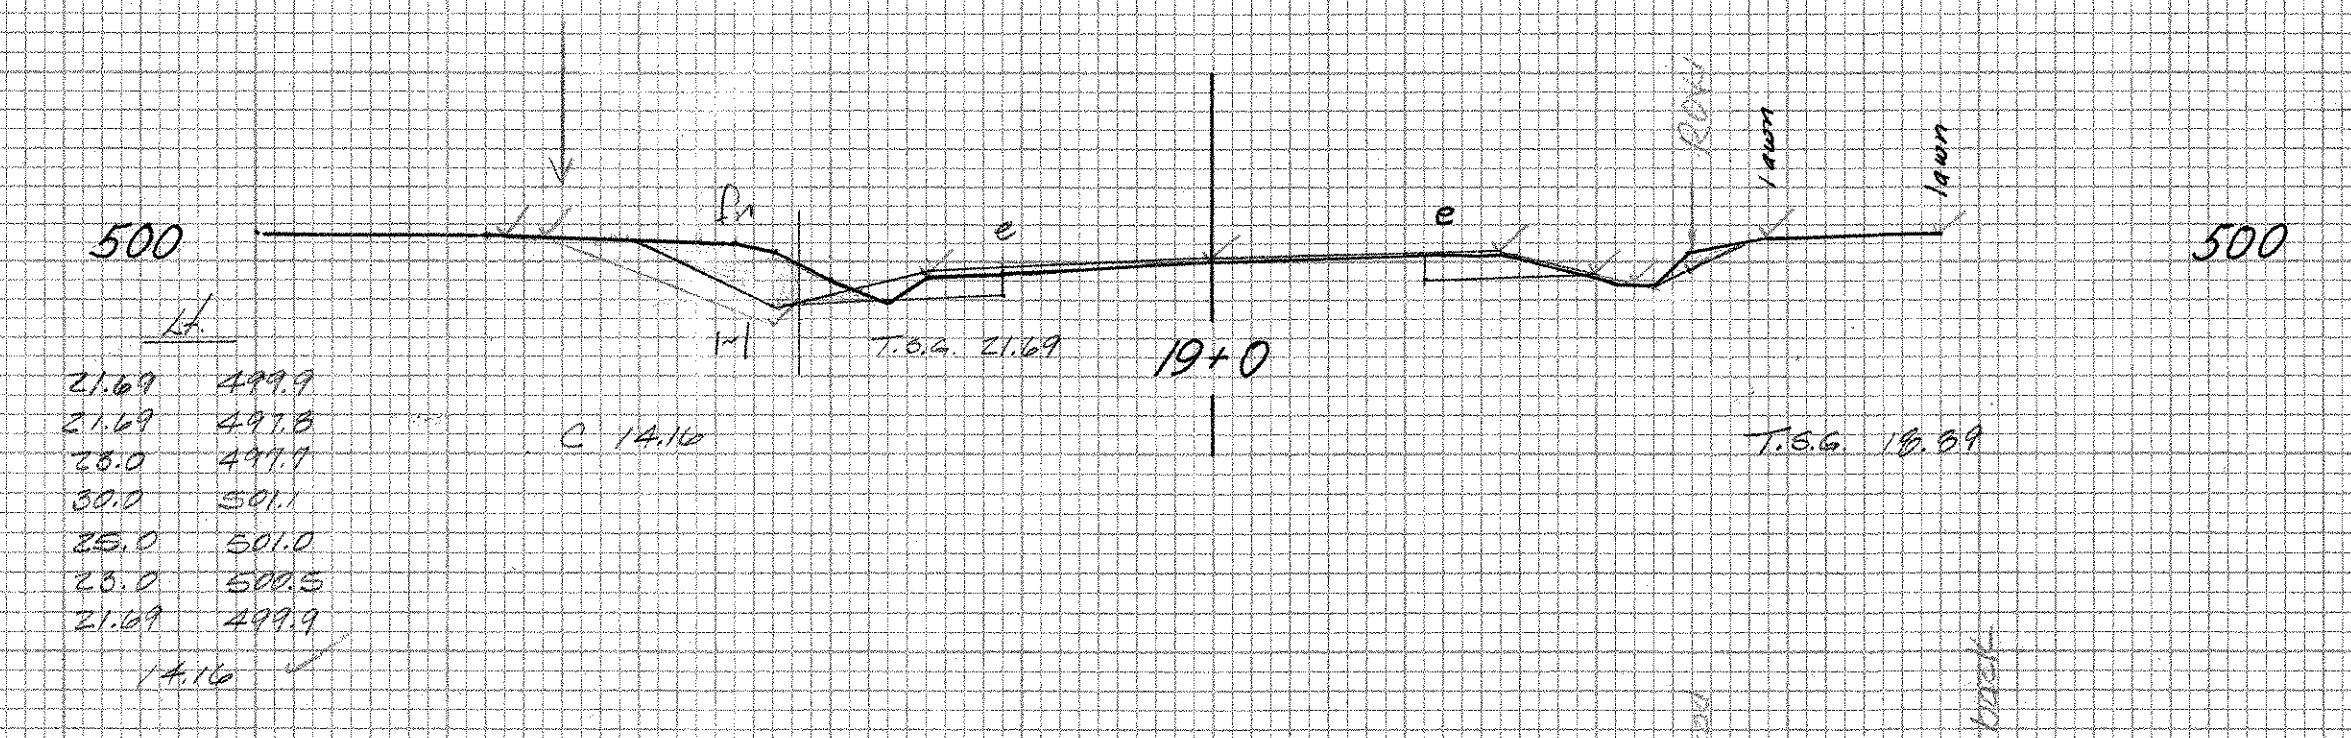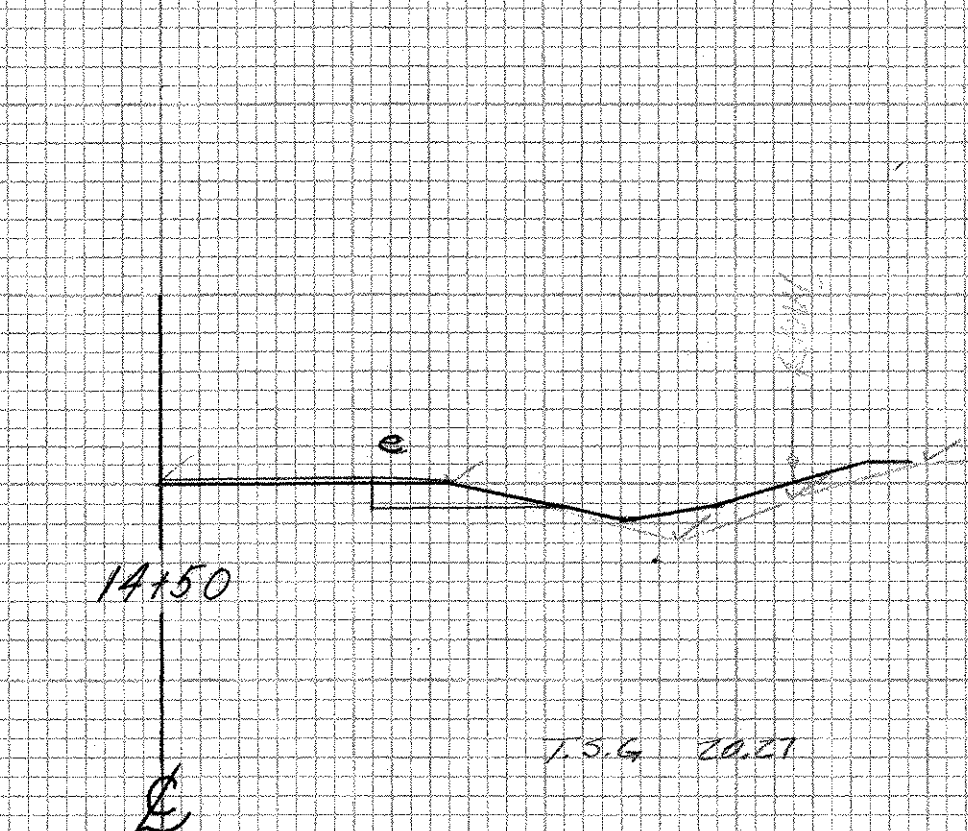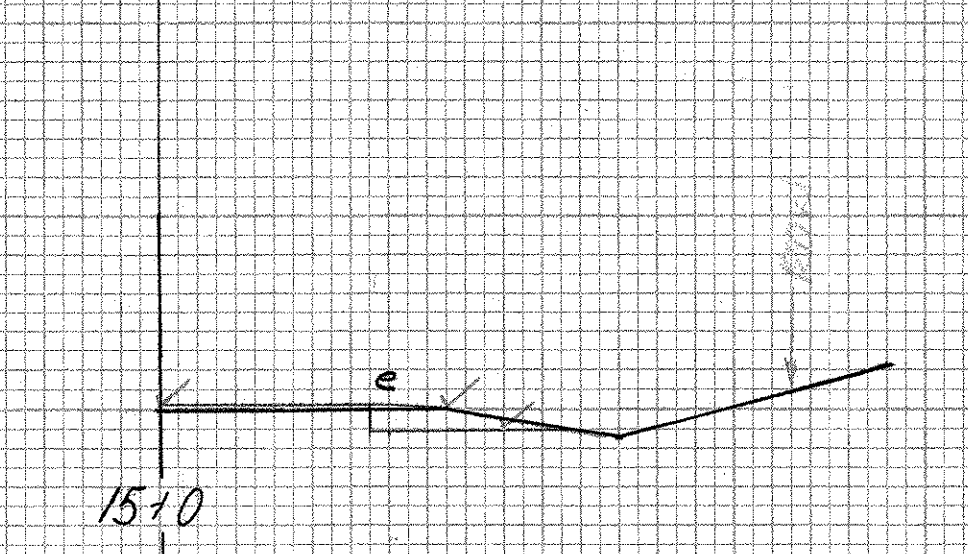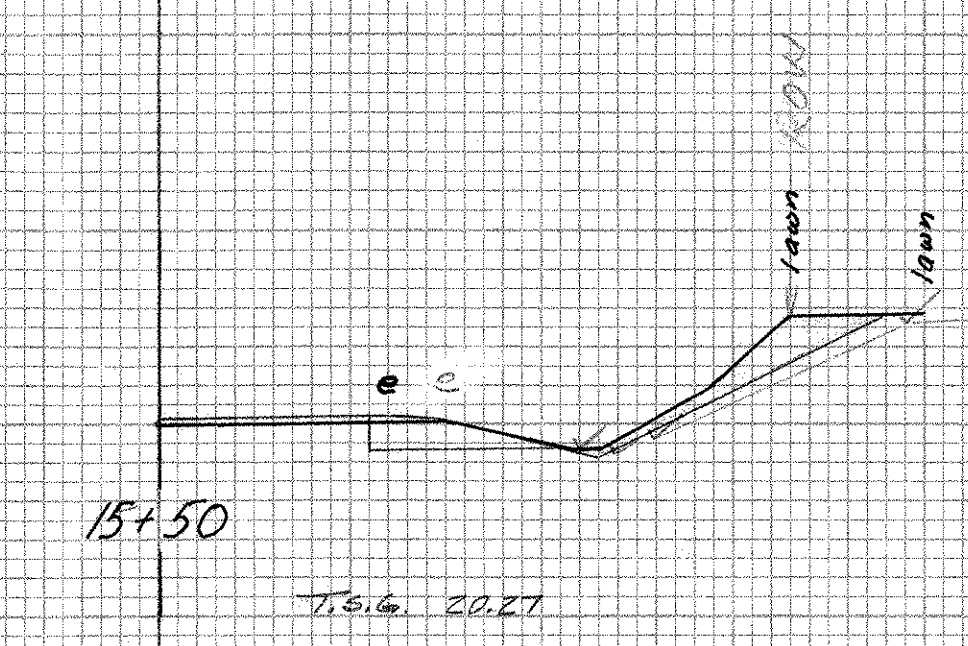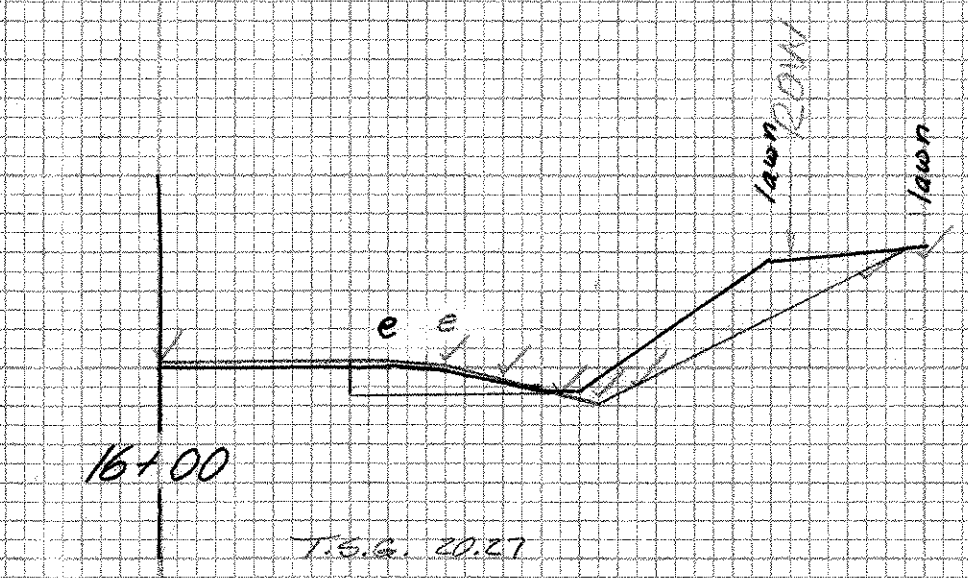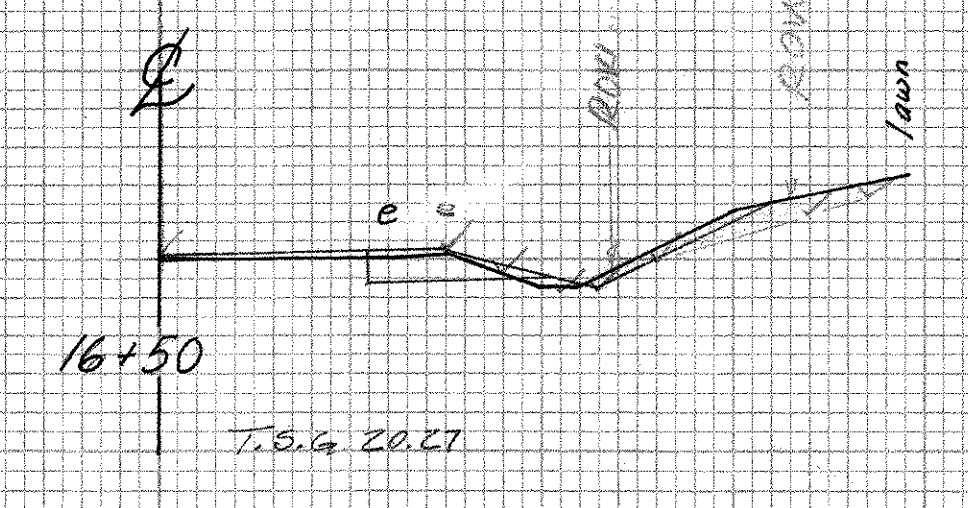

RT

23.0	498.6
29.0	501.0
25.0	500.5
23.0	498.6

RT

26.0	500.0
32.0	502.7
27.0	502.4
26.0	500.0

RT

23.0	498.6
24.0	498.4
26.0	499.2
30.0	501.3
35.0	505.1
31.0	505.0
36.0	505.4
27.0	502.7
23.0	498.6

RT

27.0	499.0
23.0	495.7
29.0	501.7
30.0	504.0
22.0	500.5
21.0	498.0

RT

27.5	498.5
23.0	498.2
26.0	498.1
30.0	501.5
37.0	501.0
29.0	501.0
27.5	498.5