
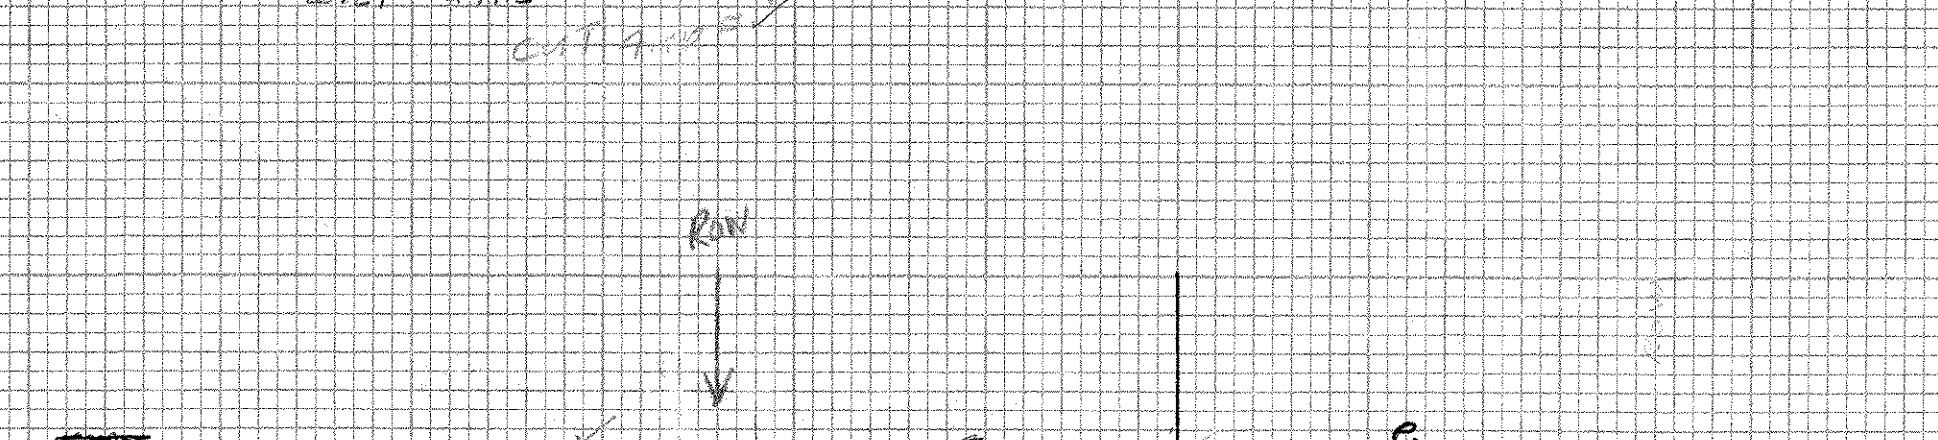
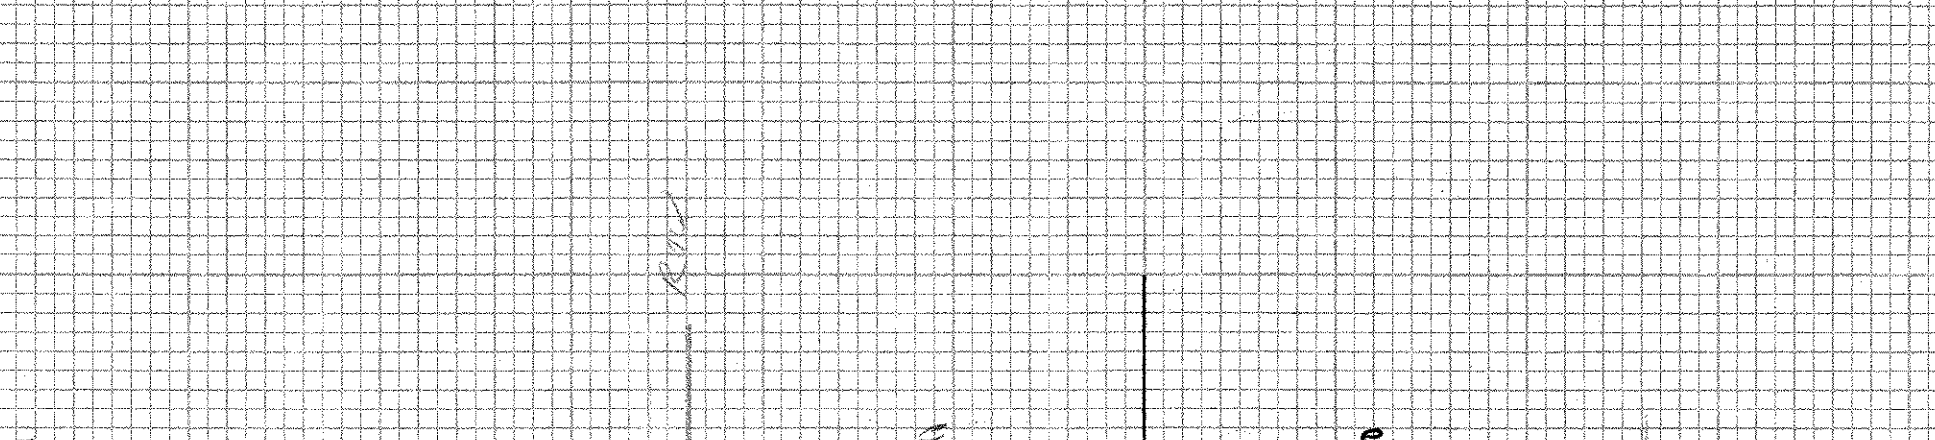
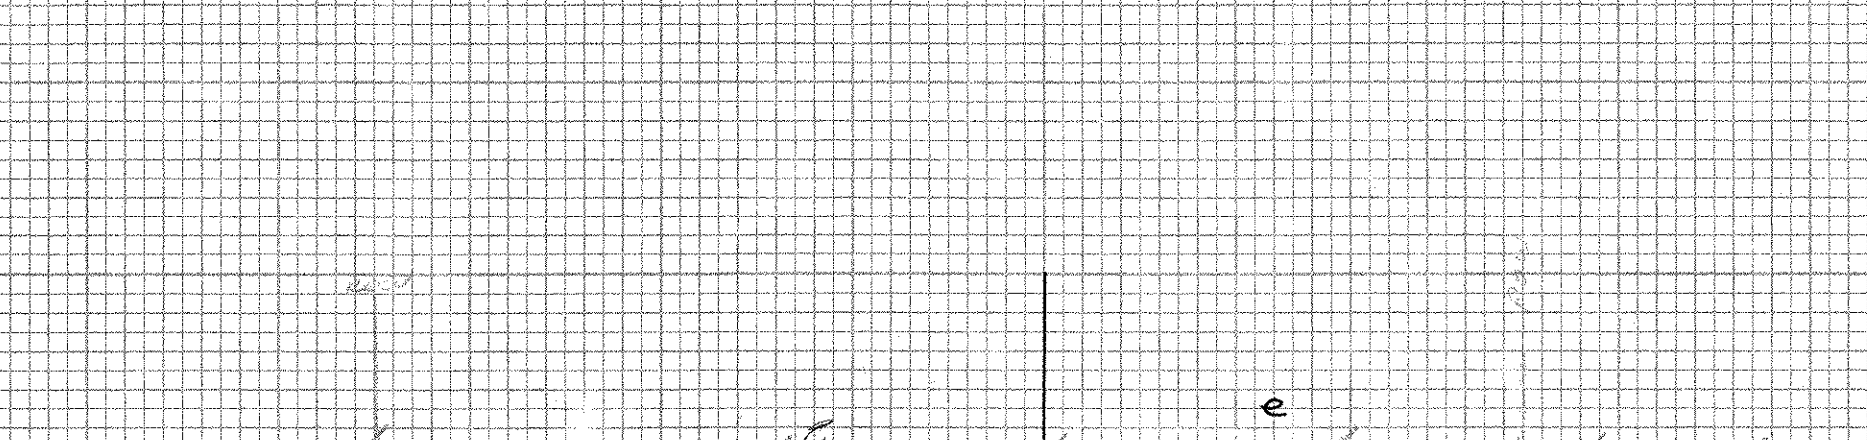
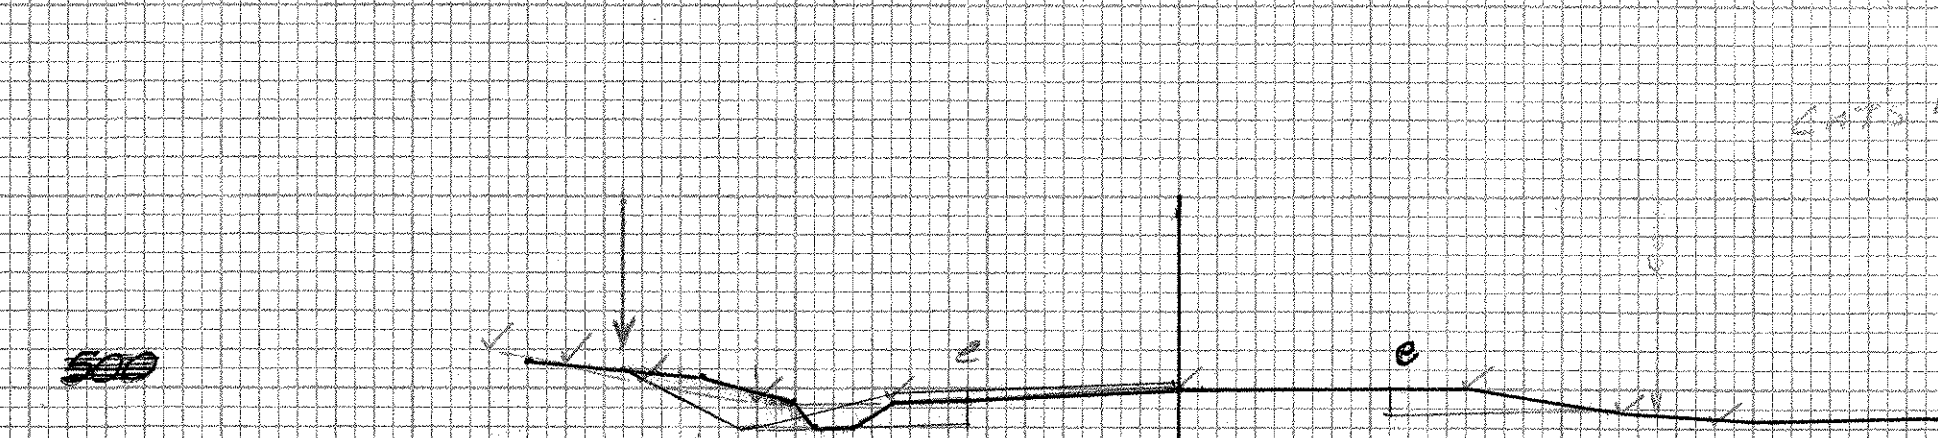
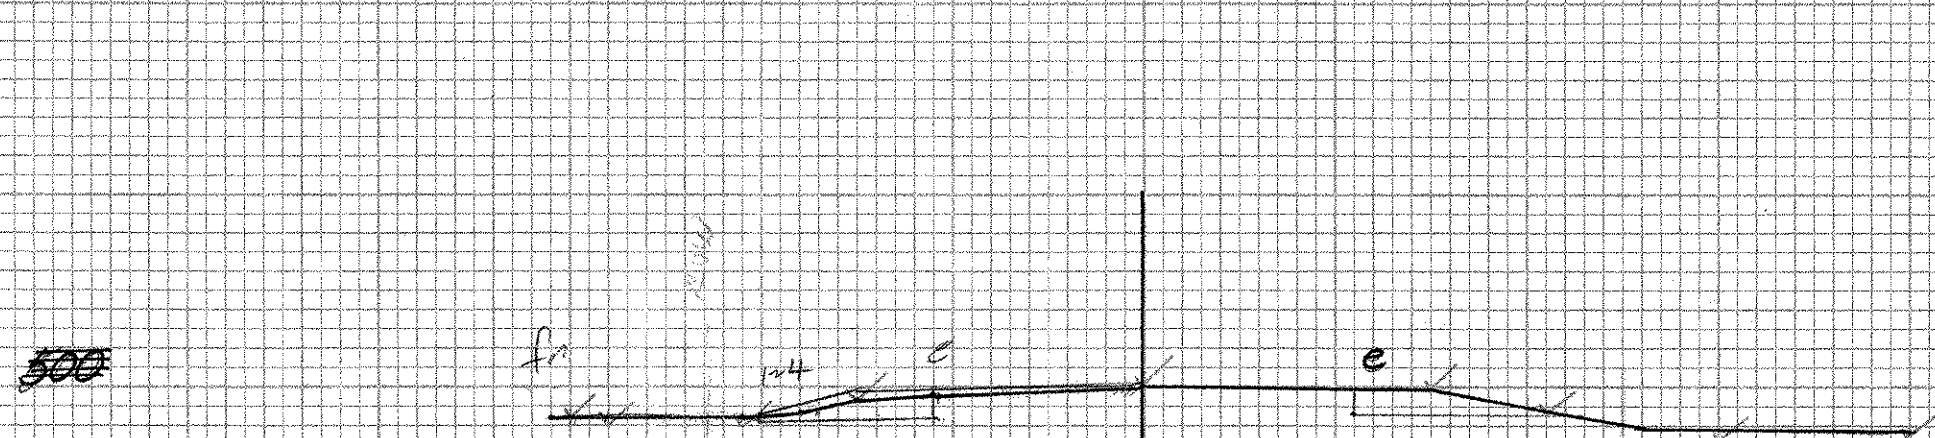
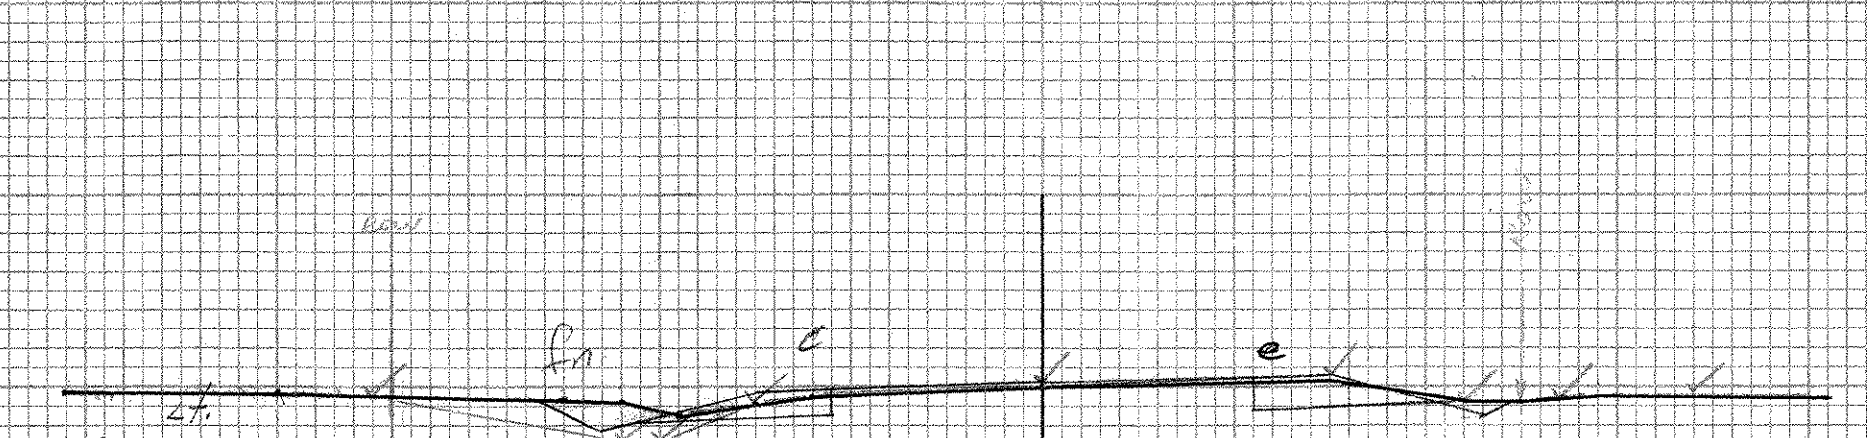
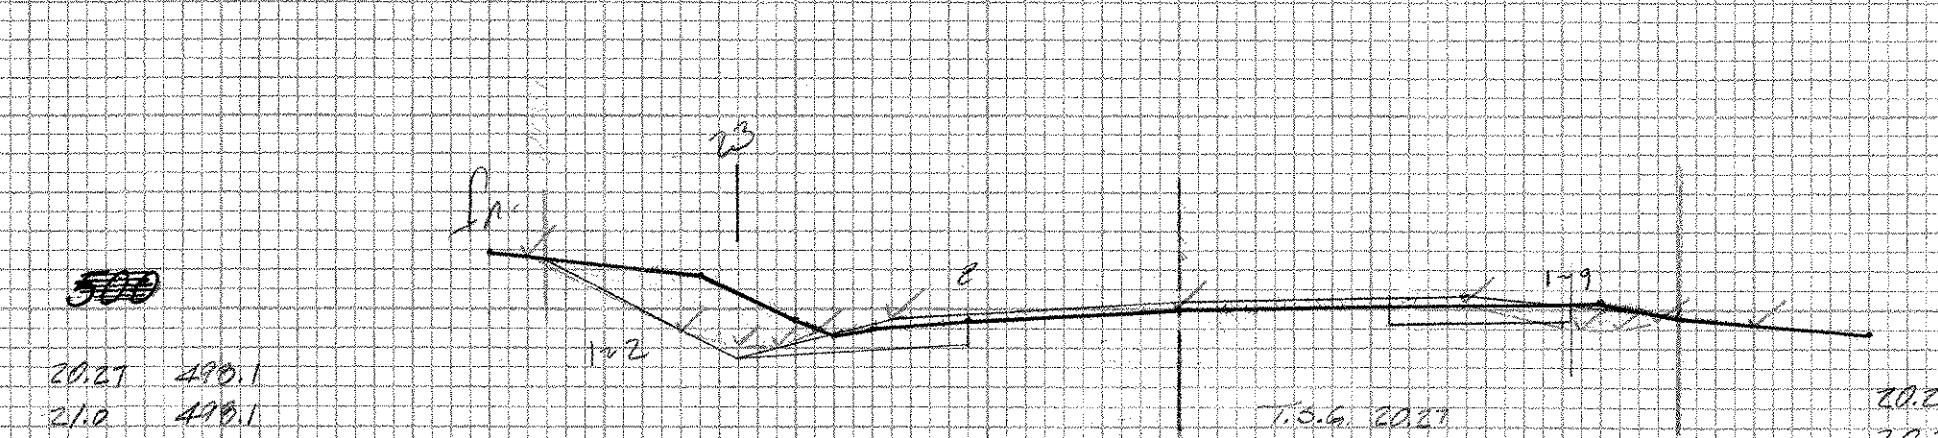
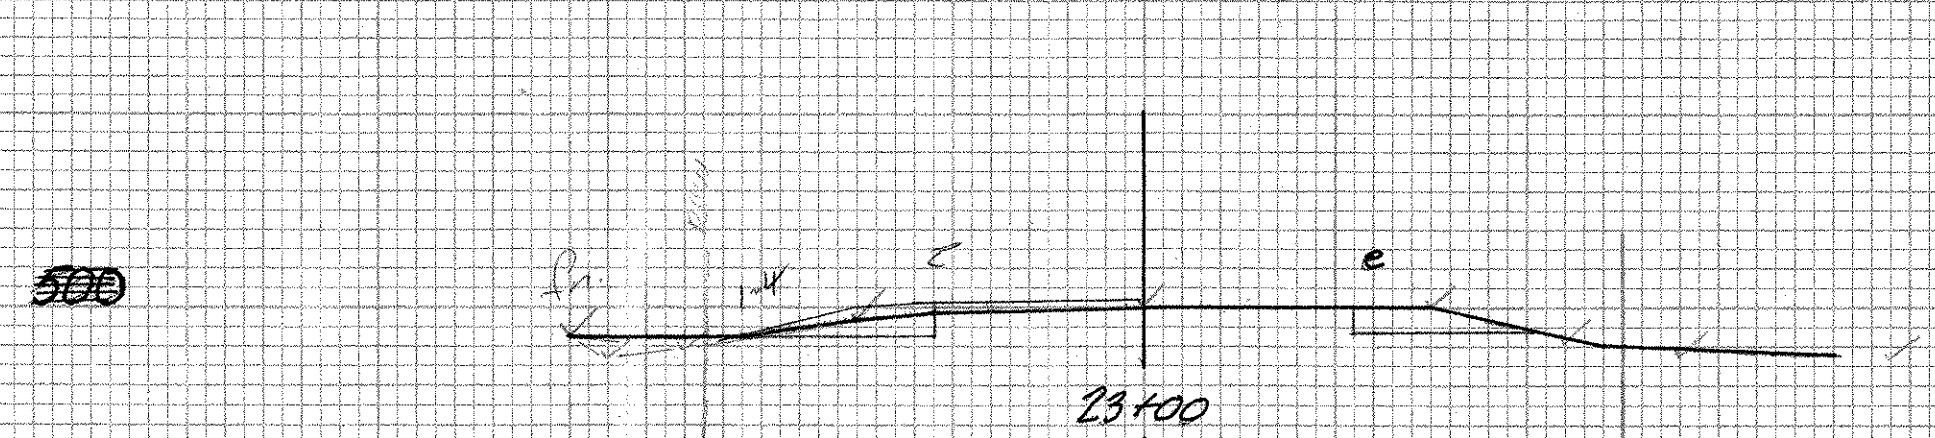
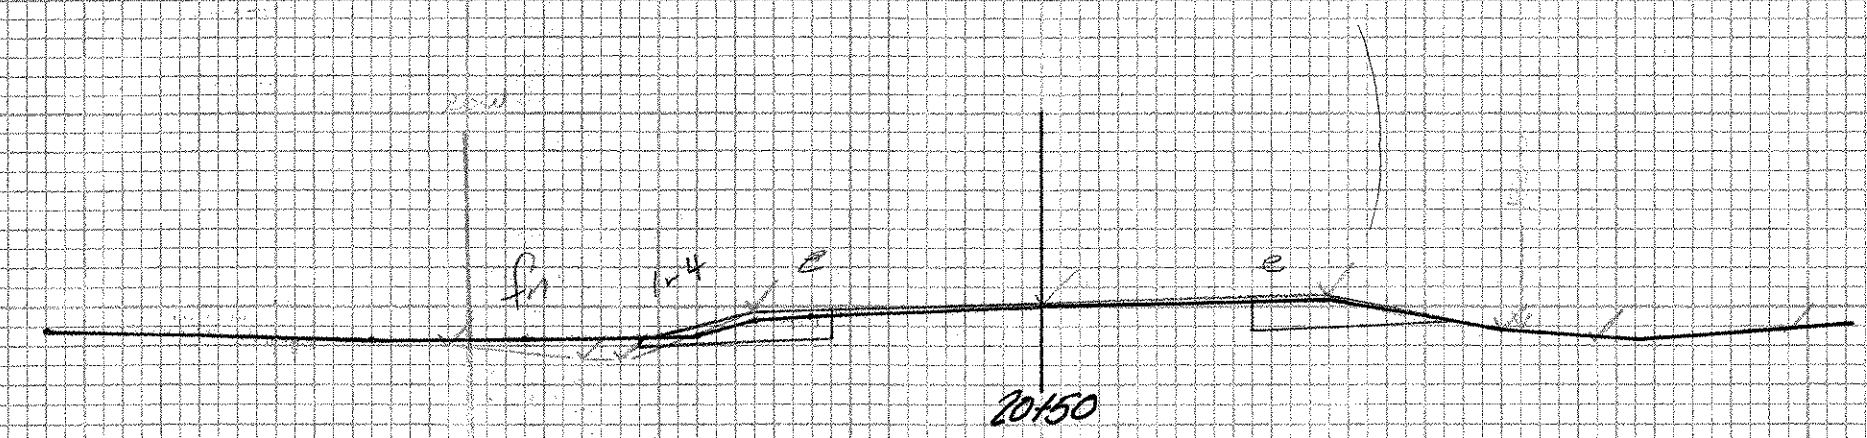
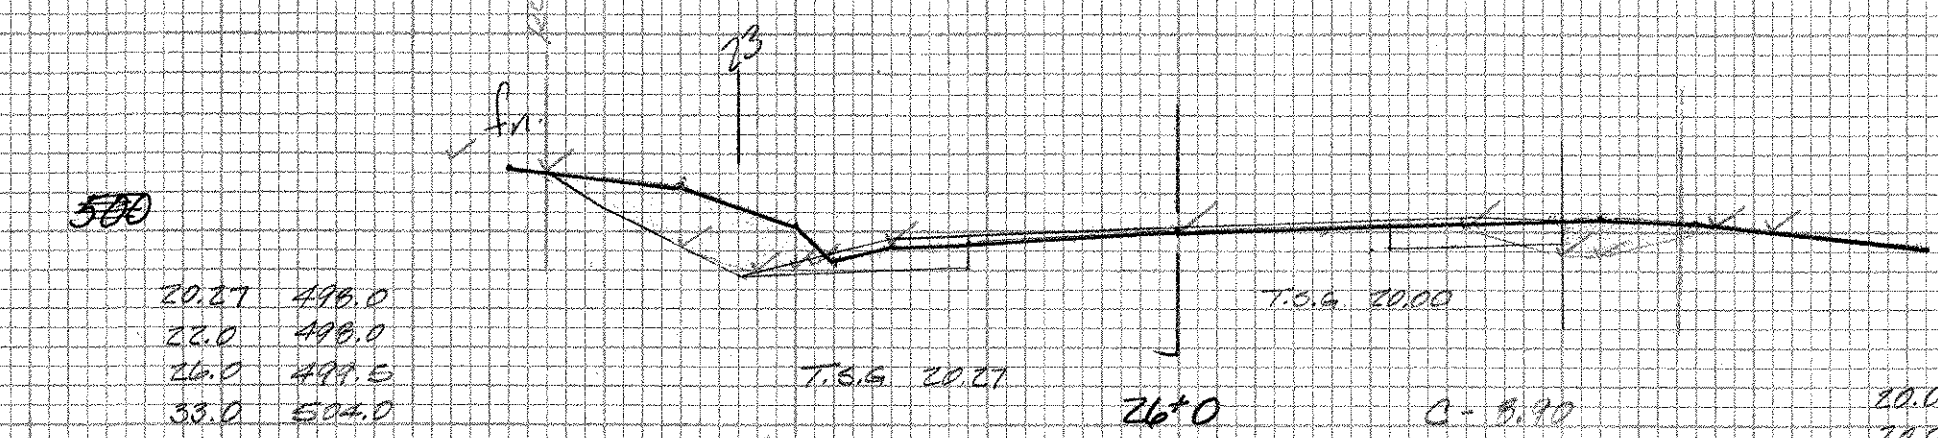
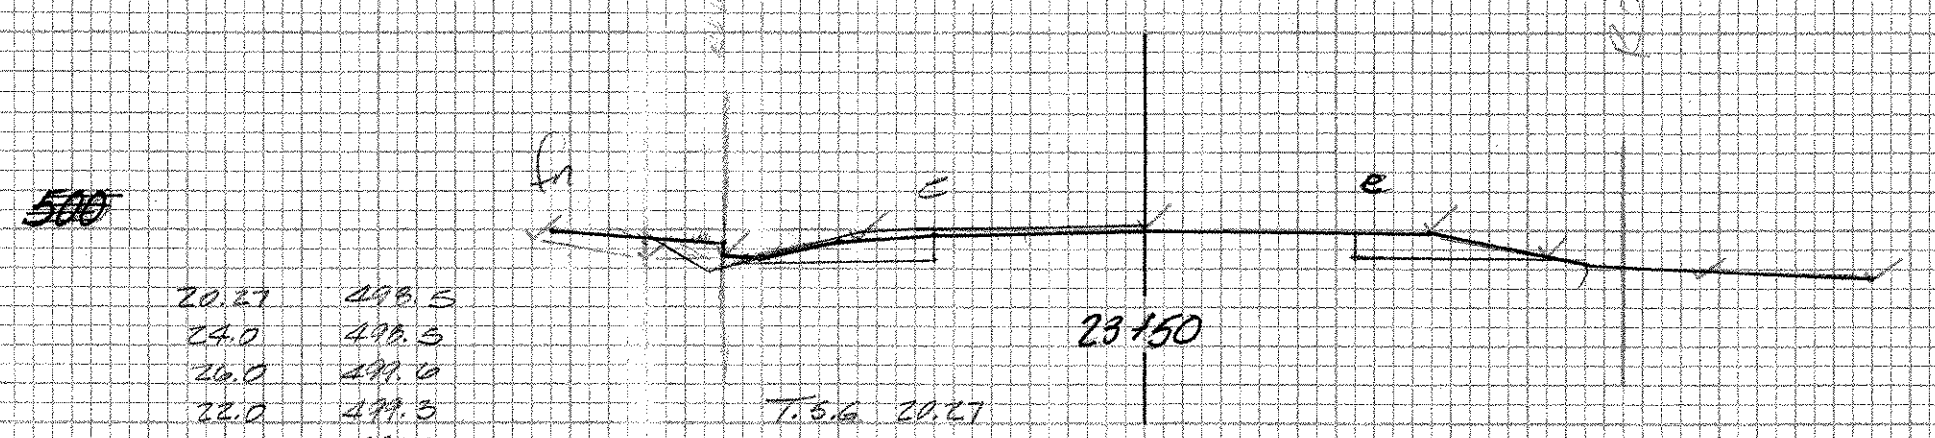
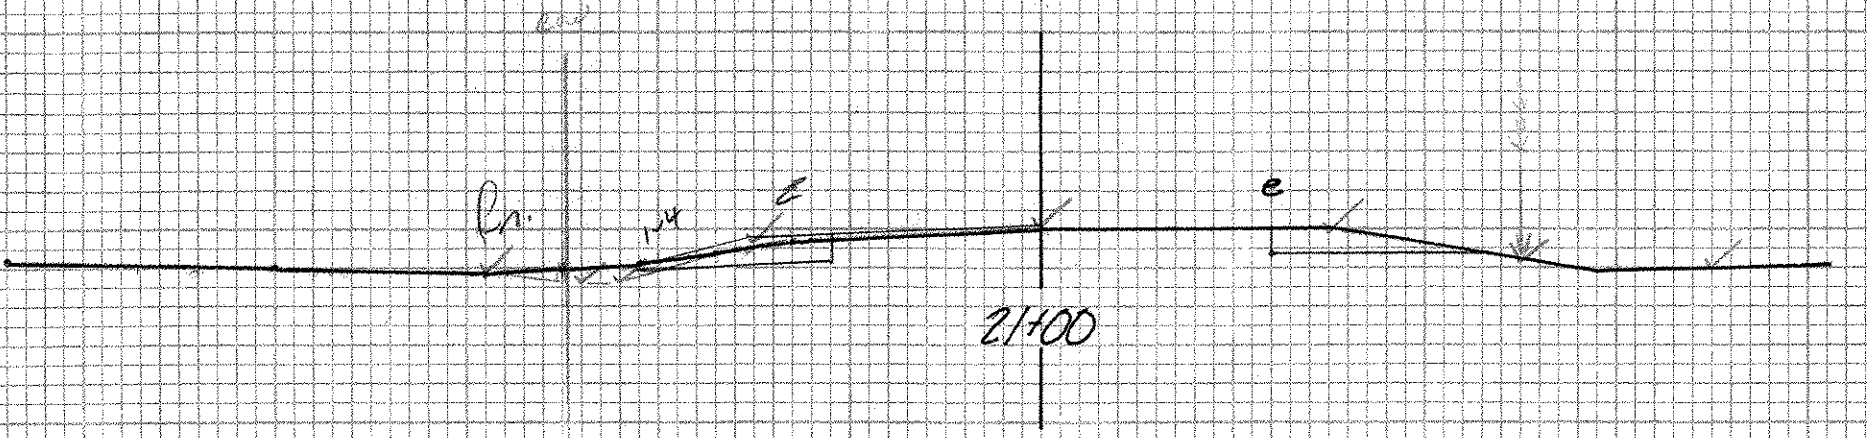
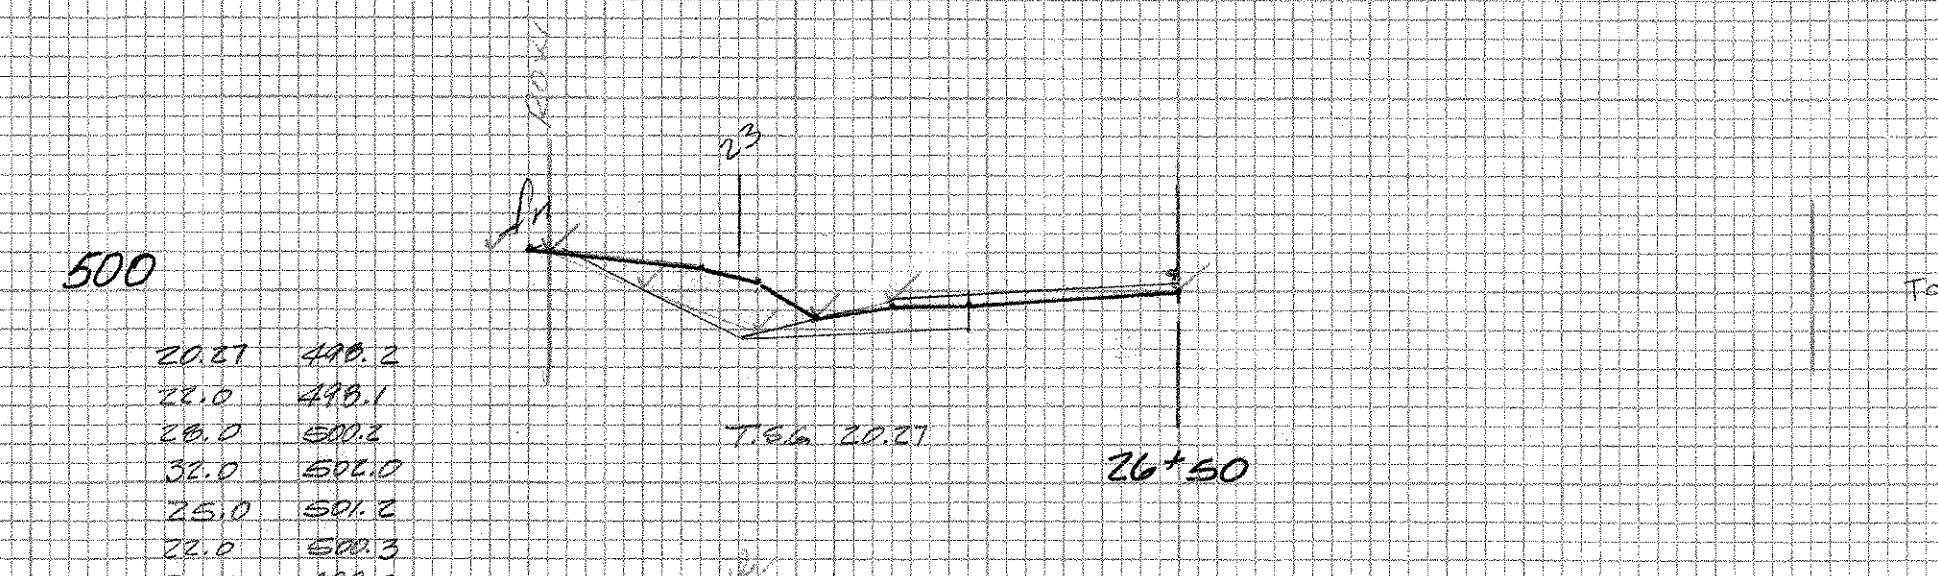
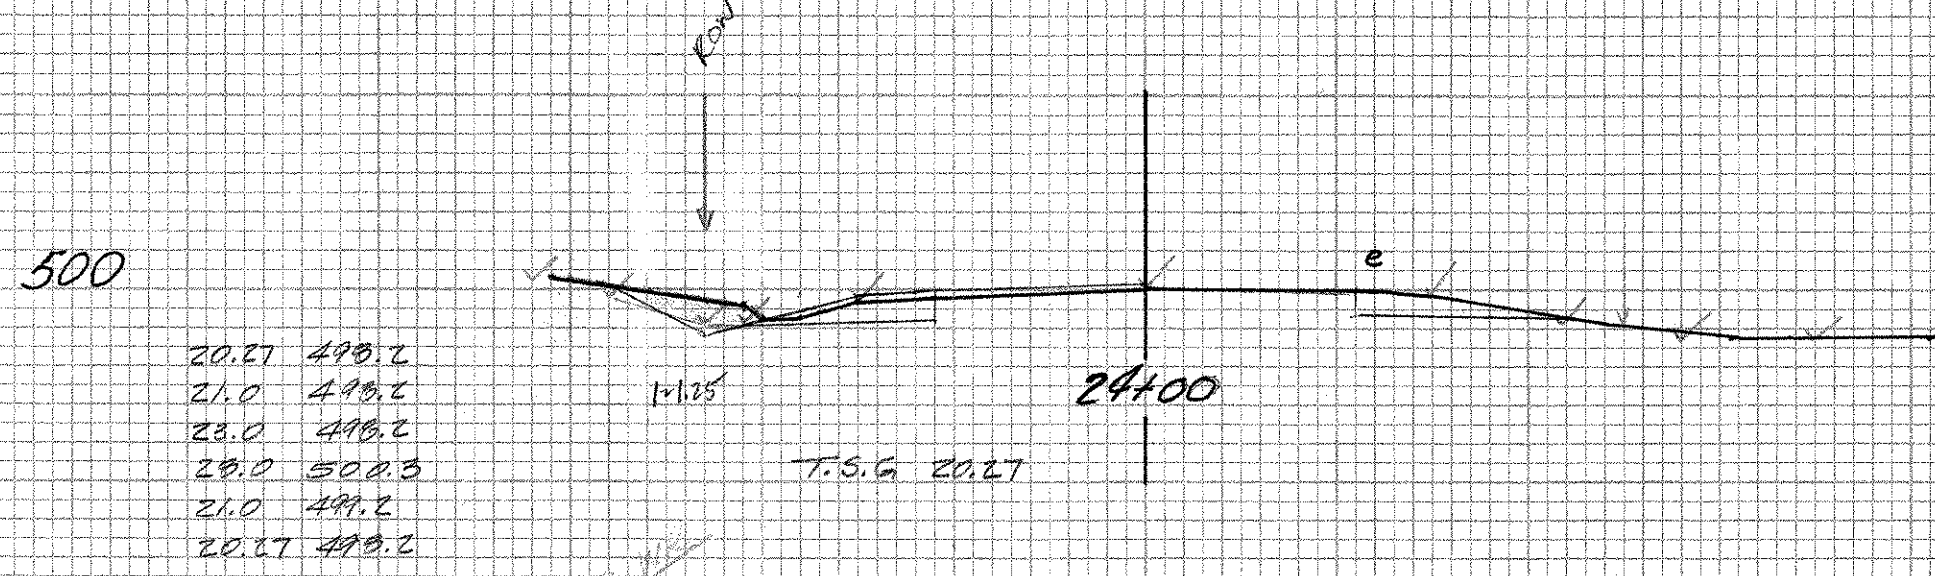


DATE	
BY	
FINAL SURVEY	
NOTED	
TEMPERATURE	
WIND	
AREAS CHECKED	
NO.	

DATE	
BY	
ORIGINAL SURVEY	
NOTED	
TEMPERATURE	
WIND	
AREAS CHECKED	
NO.	

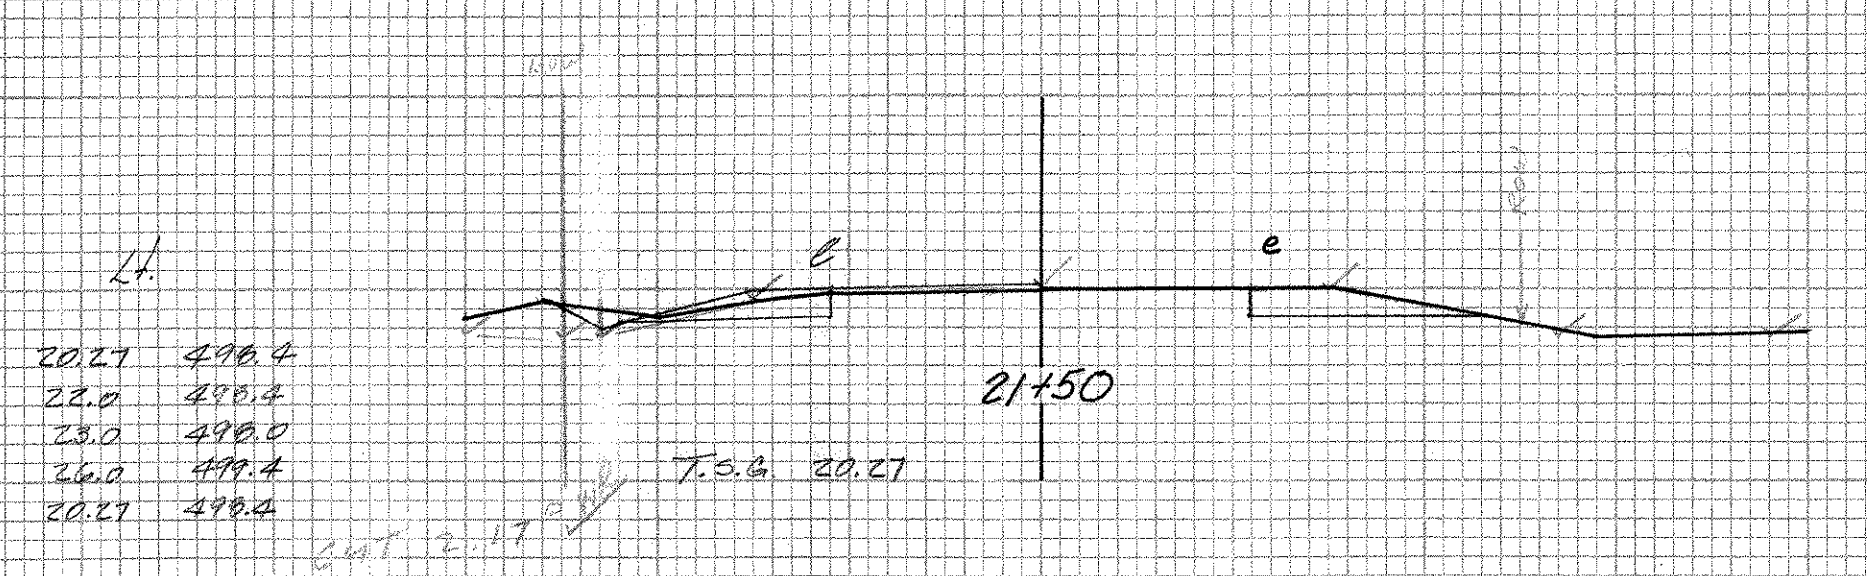

Shoram-Bridport-Addison  
FO17-1(2)  
19+50 ~ 26+50  
Sheet 25 of 47