
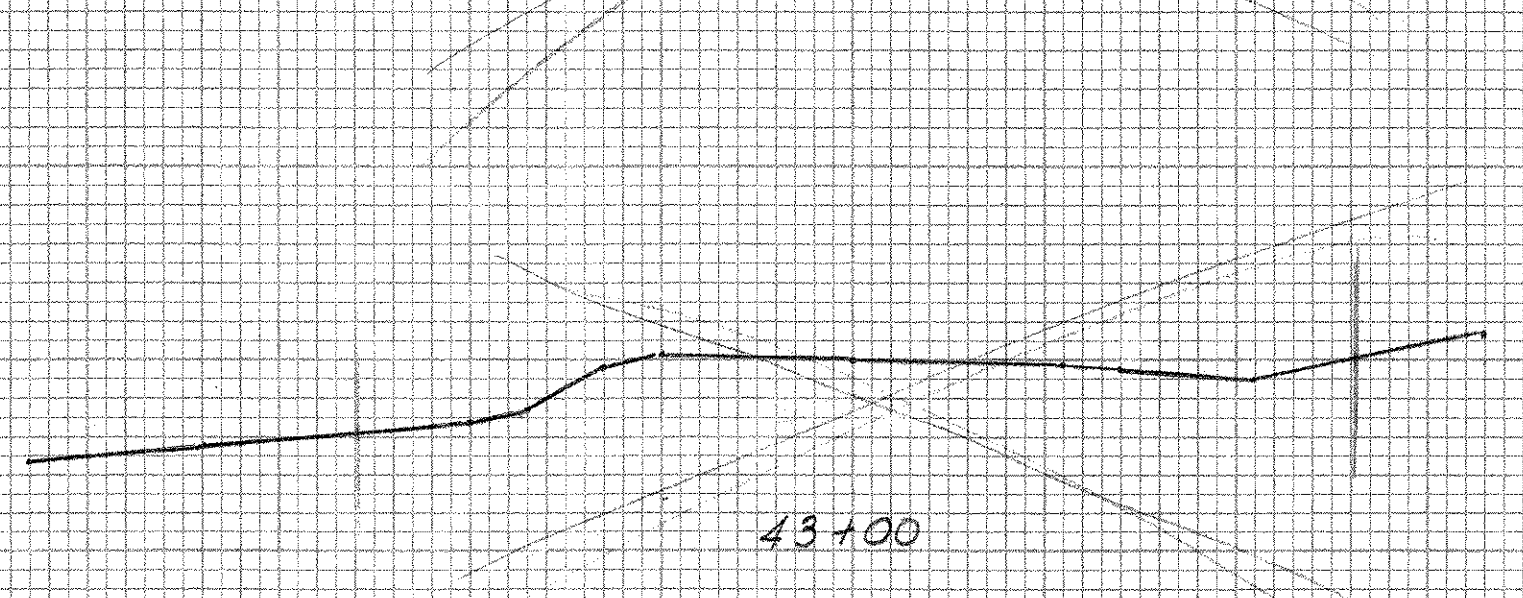
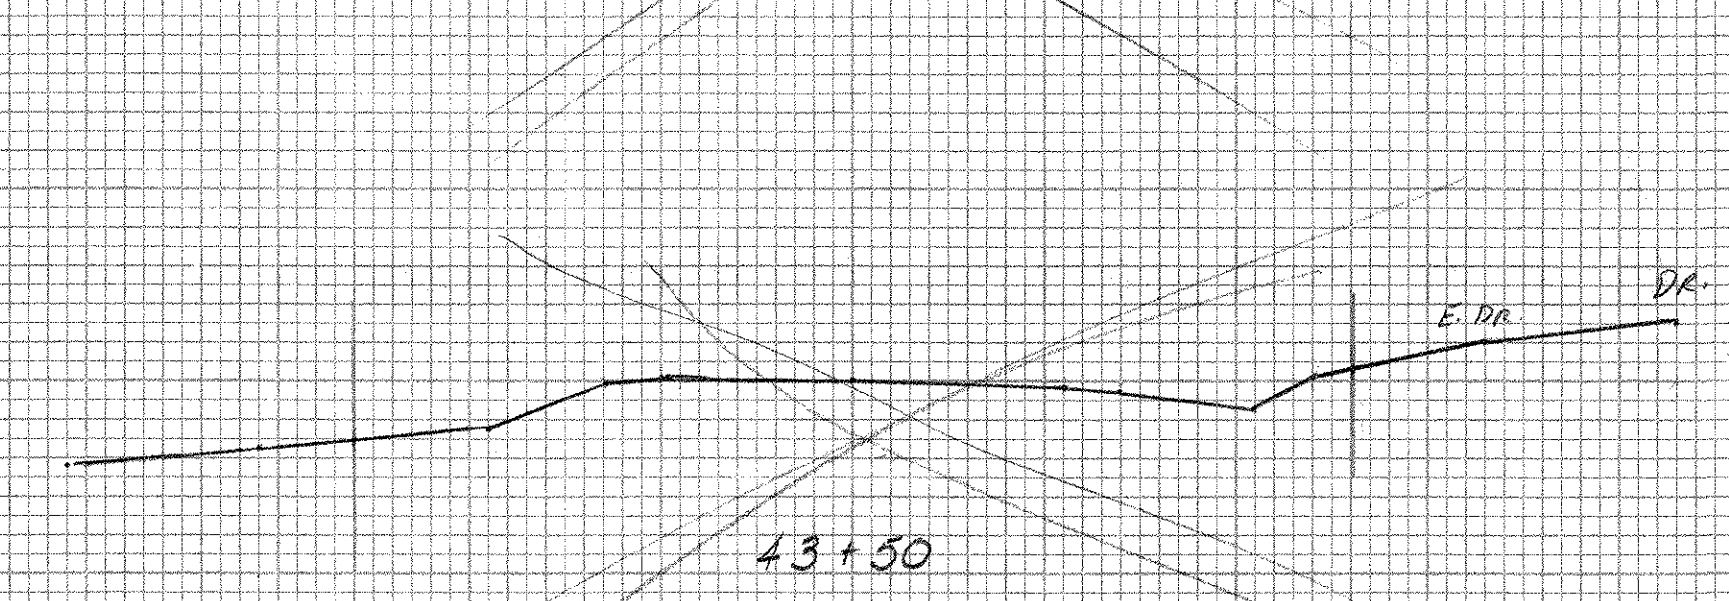
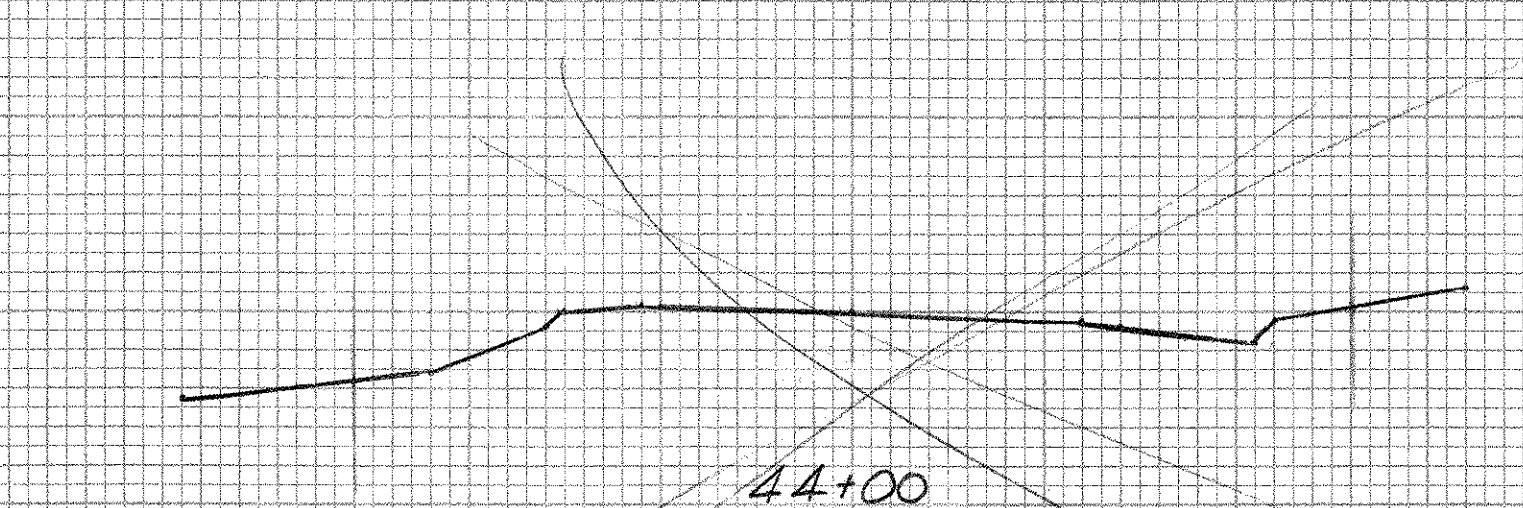
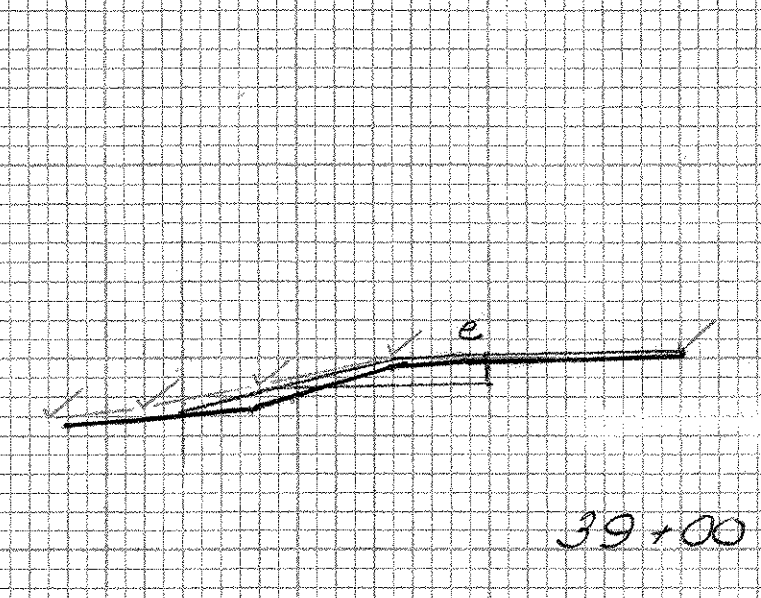
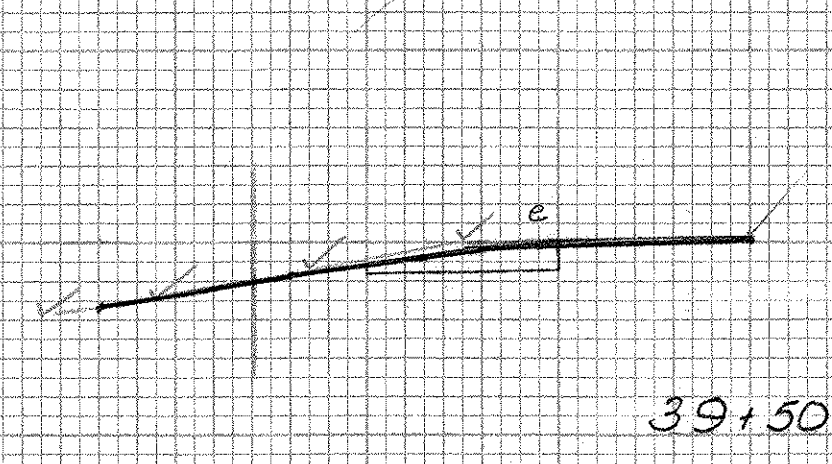
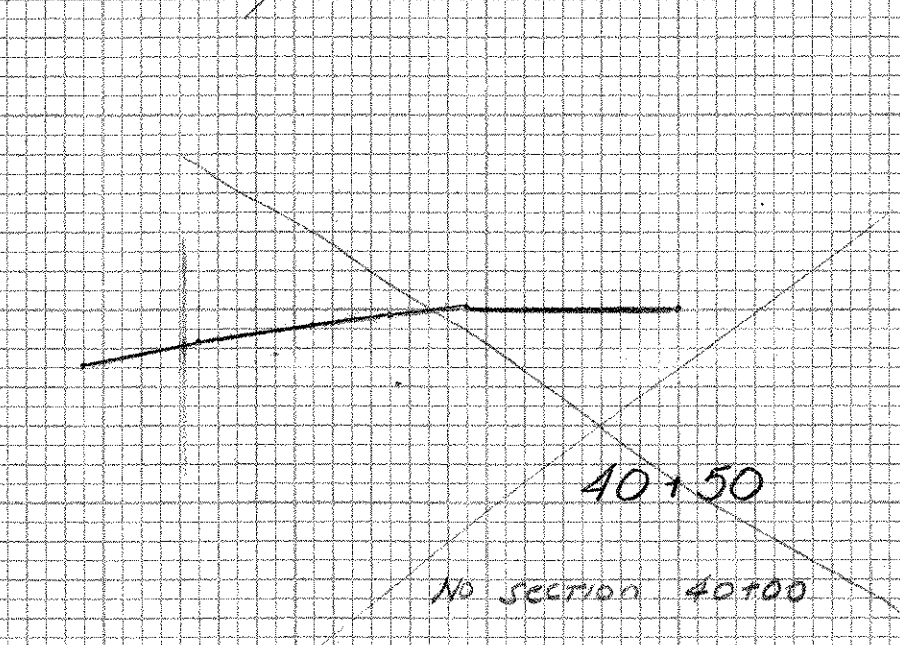
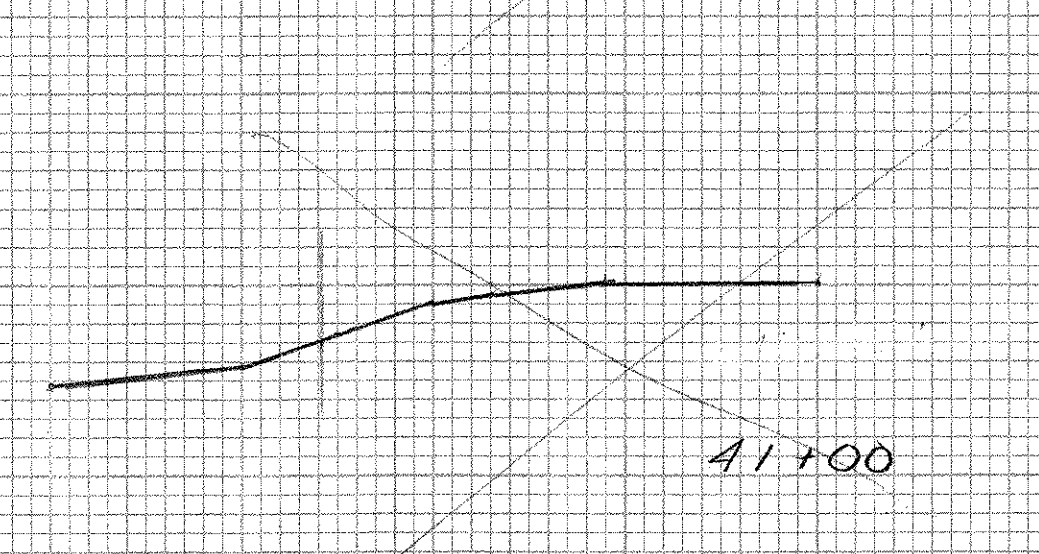
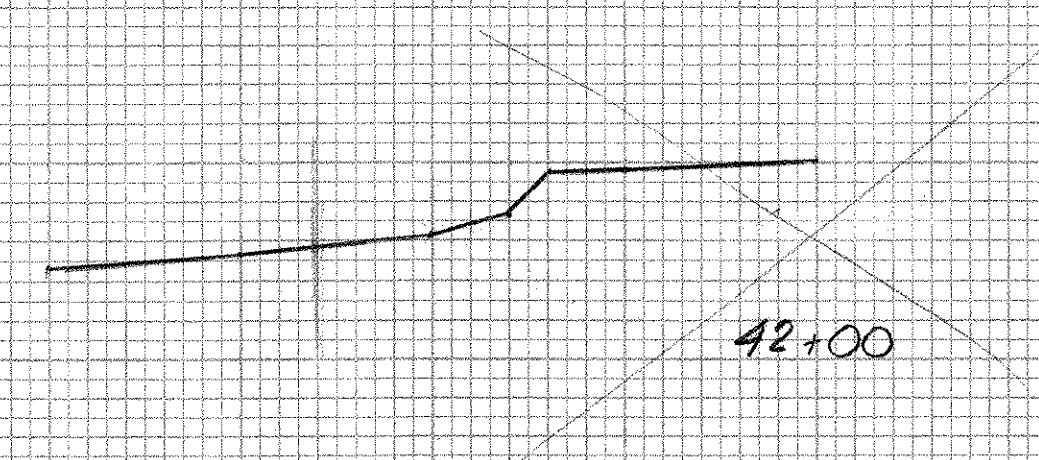


| | |
|---------------|--|
| DATE | |
| BY | |
| SURVEYED | |
| PLOTTED | |
| TEMPLATE | |
| AREAS CHECKED | |
| NO. | |

| | |
|---------------|--|
| DATE | |
| BY | |
| SURVEYED | |
| PLOTTED | |
| TEMPLATE | |
| AREAS CHECKED | |
| NO. | |

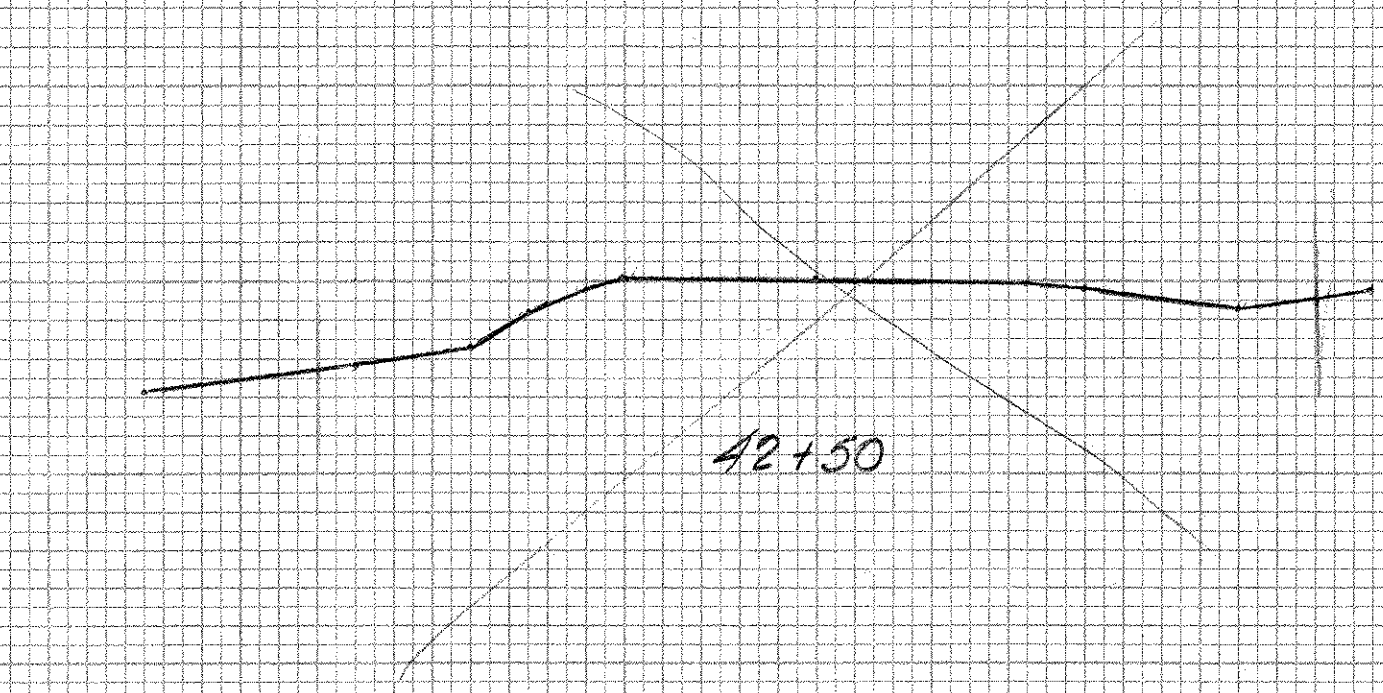

SHOREHAM-BRIDPORT-ADDISON
 F 017-1(2)
 39+00-39+50 LT
 Original Sections

Rel. Suppl. by 10-15-50 12-23-50