
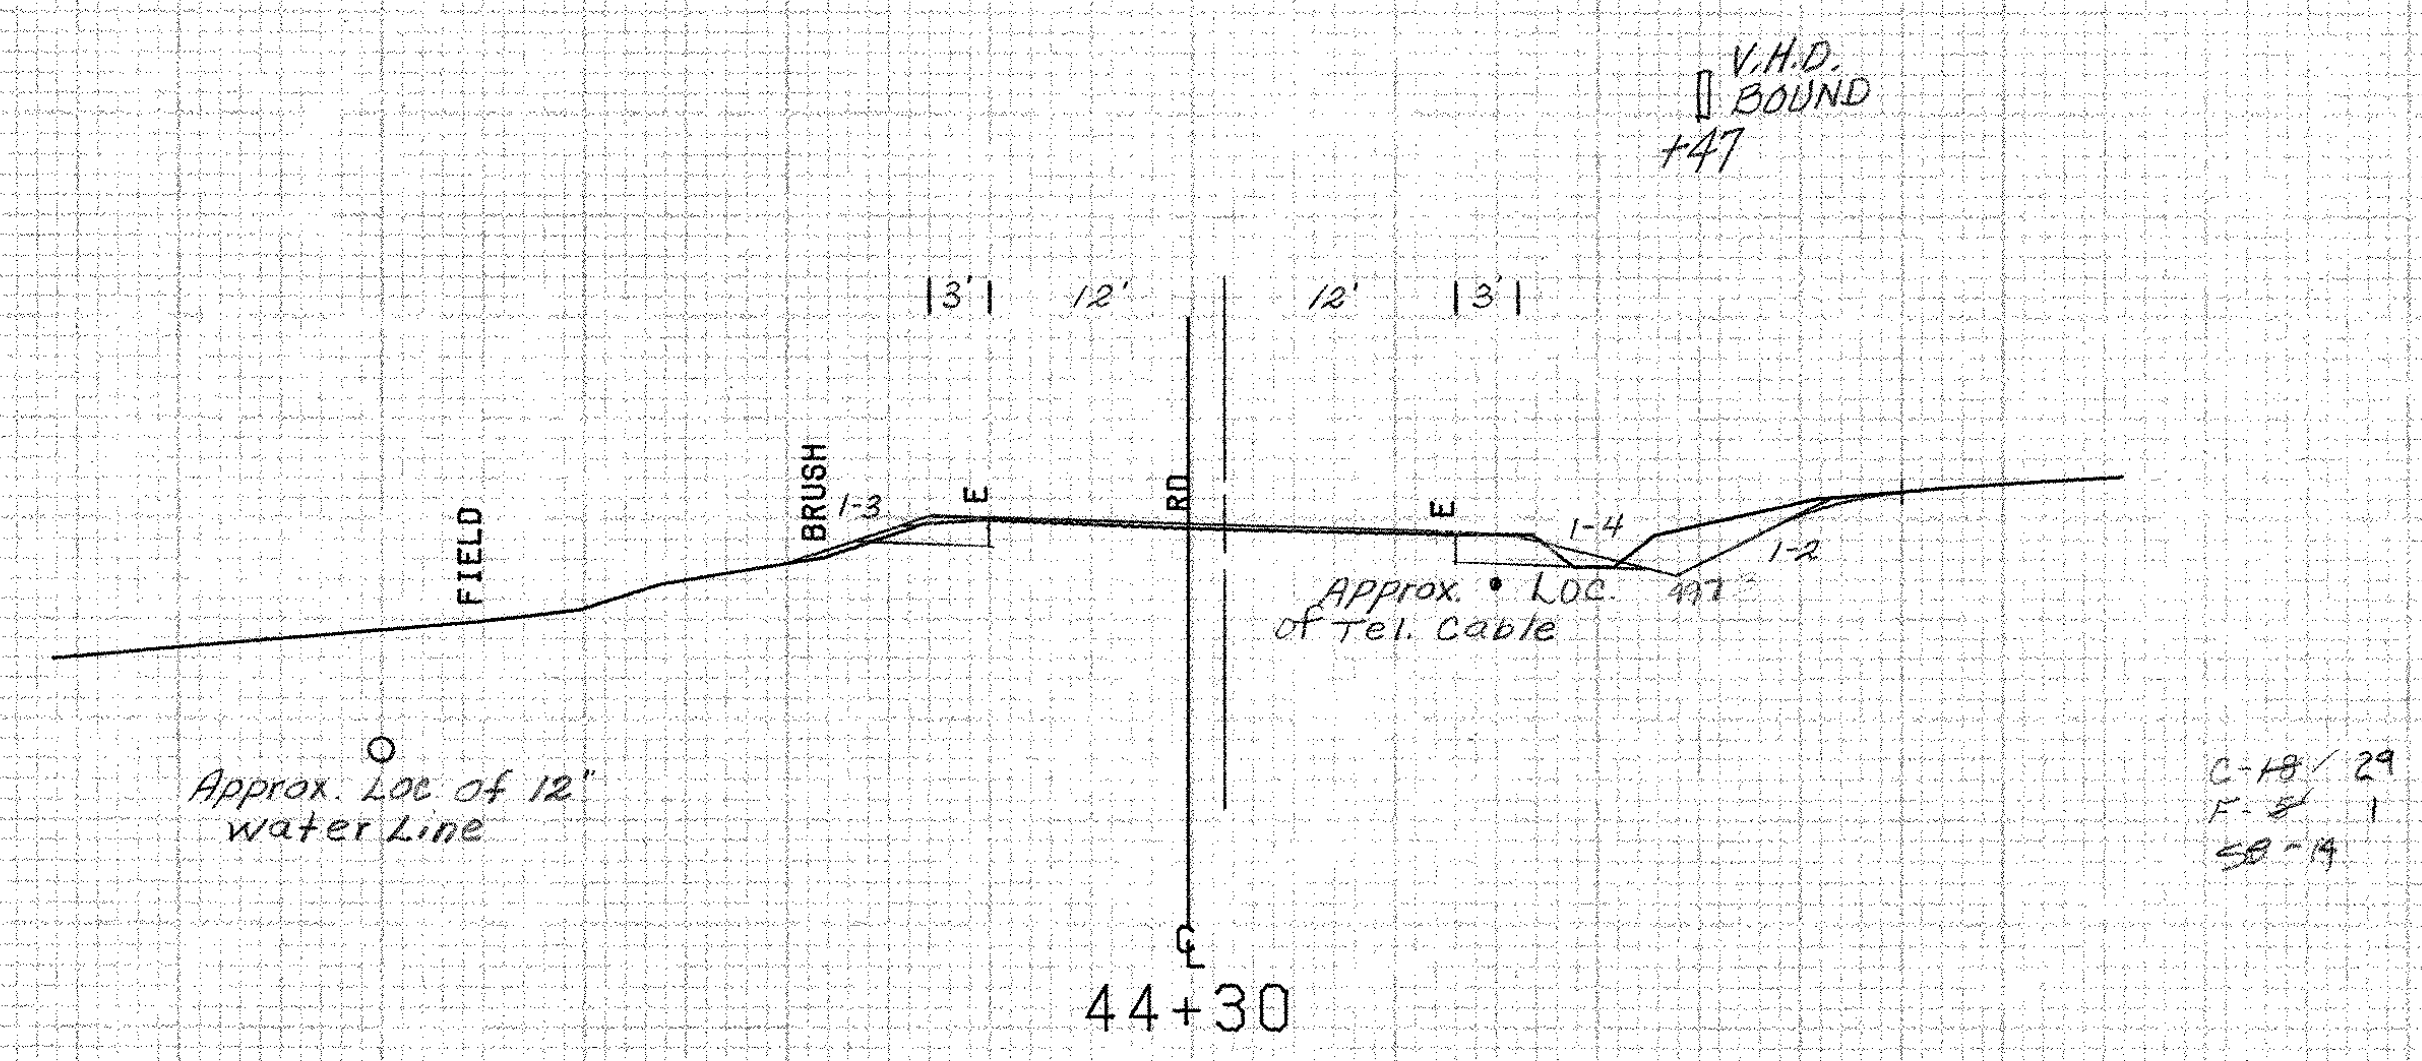
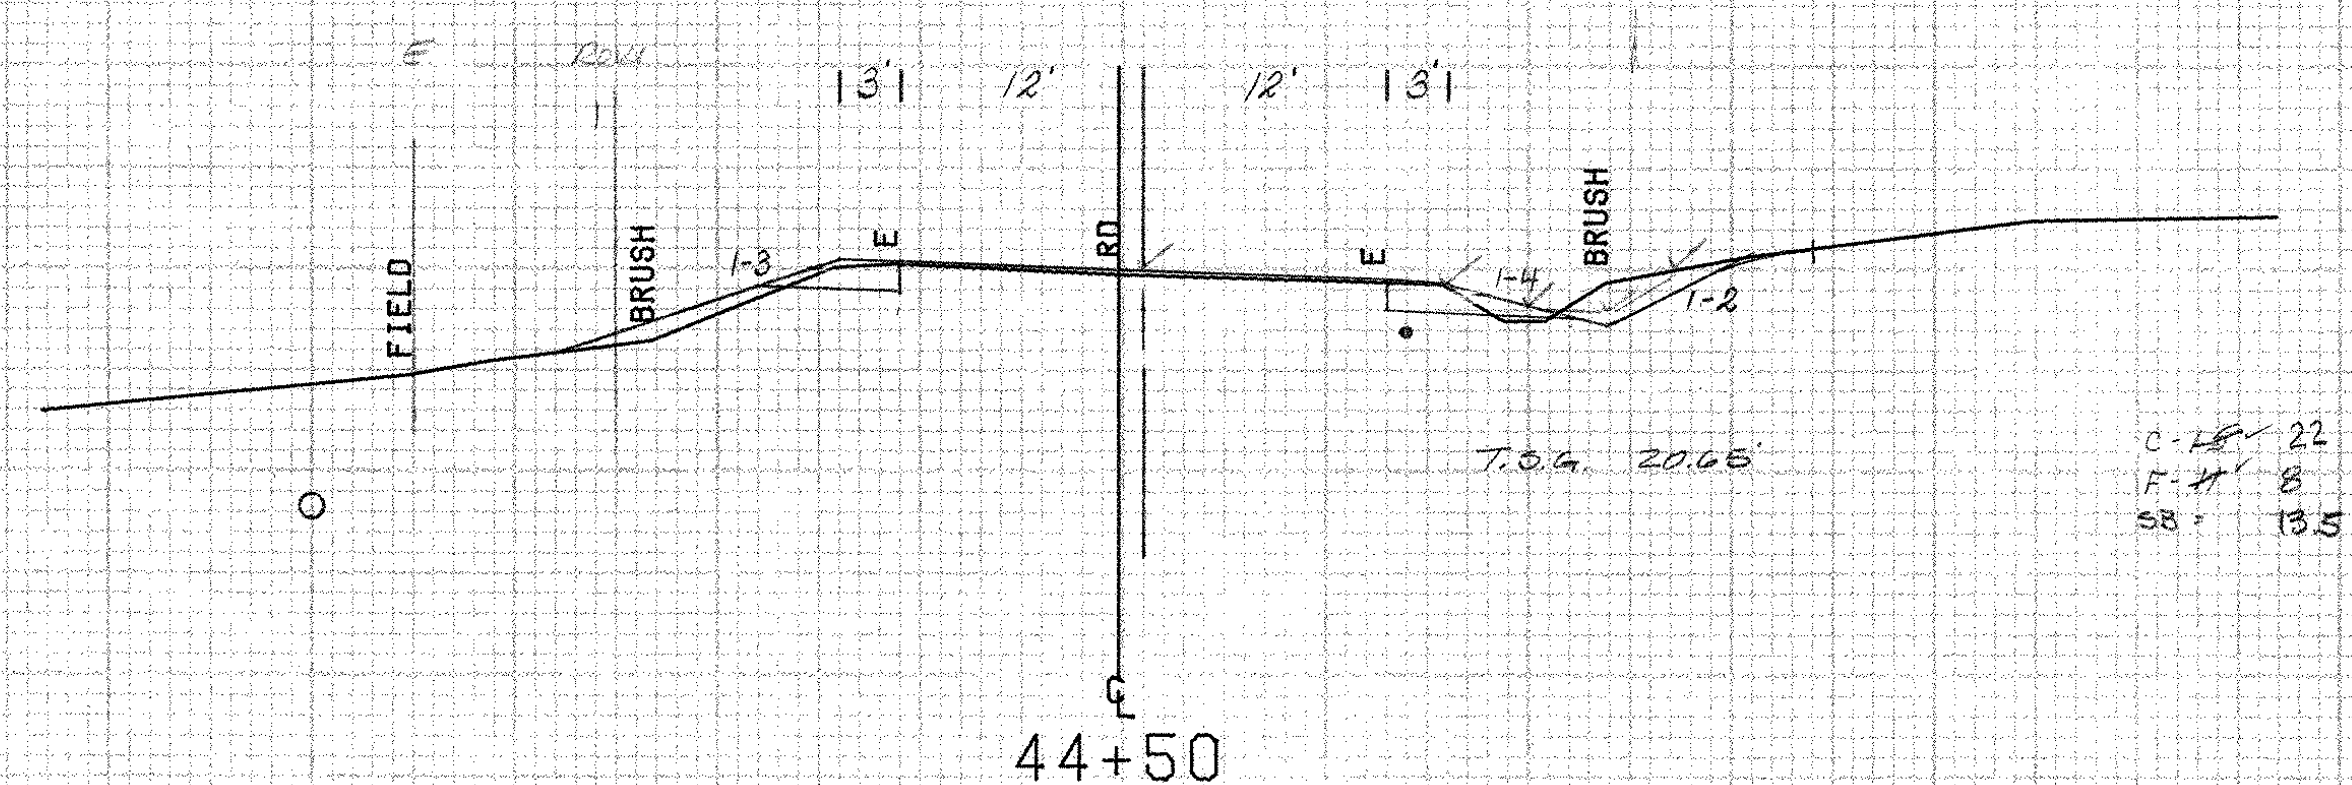


NOTE: The 15" Basswood at 45+135 is marking a Property Line corner. The tree shall be tied in before removal and replaced by a Boundary Marker.

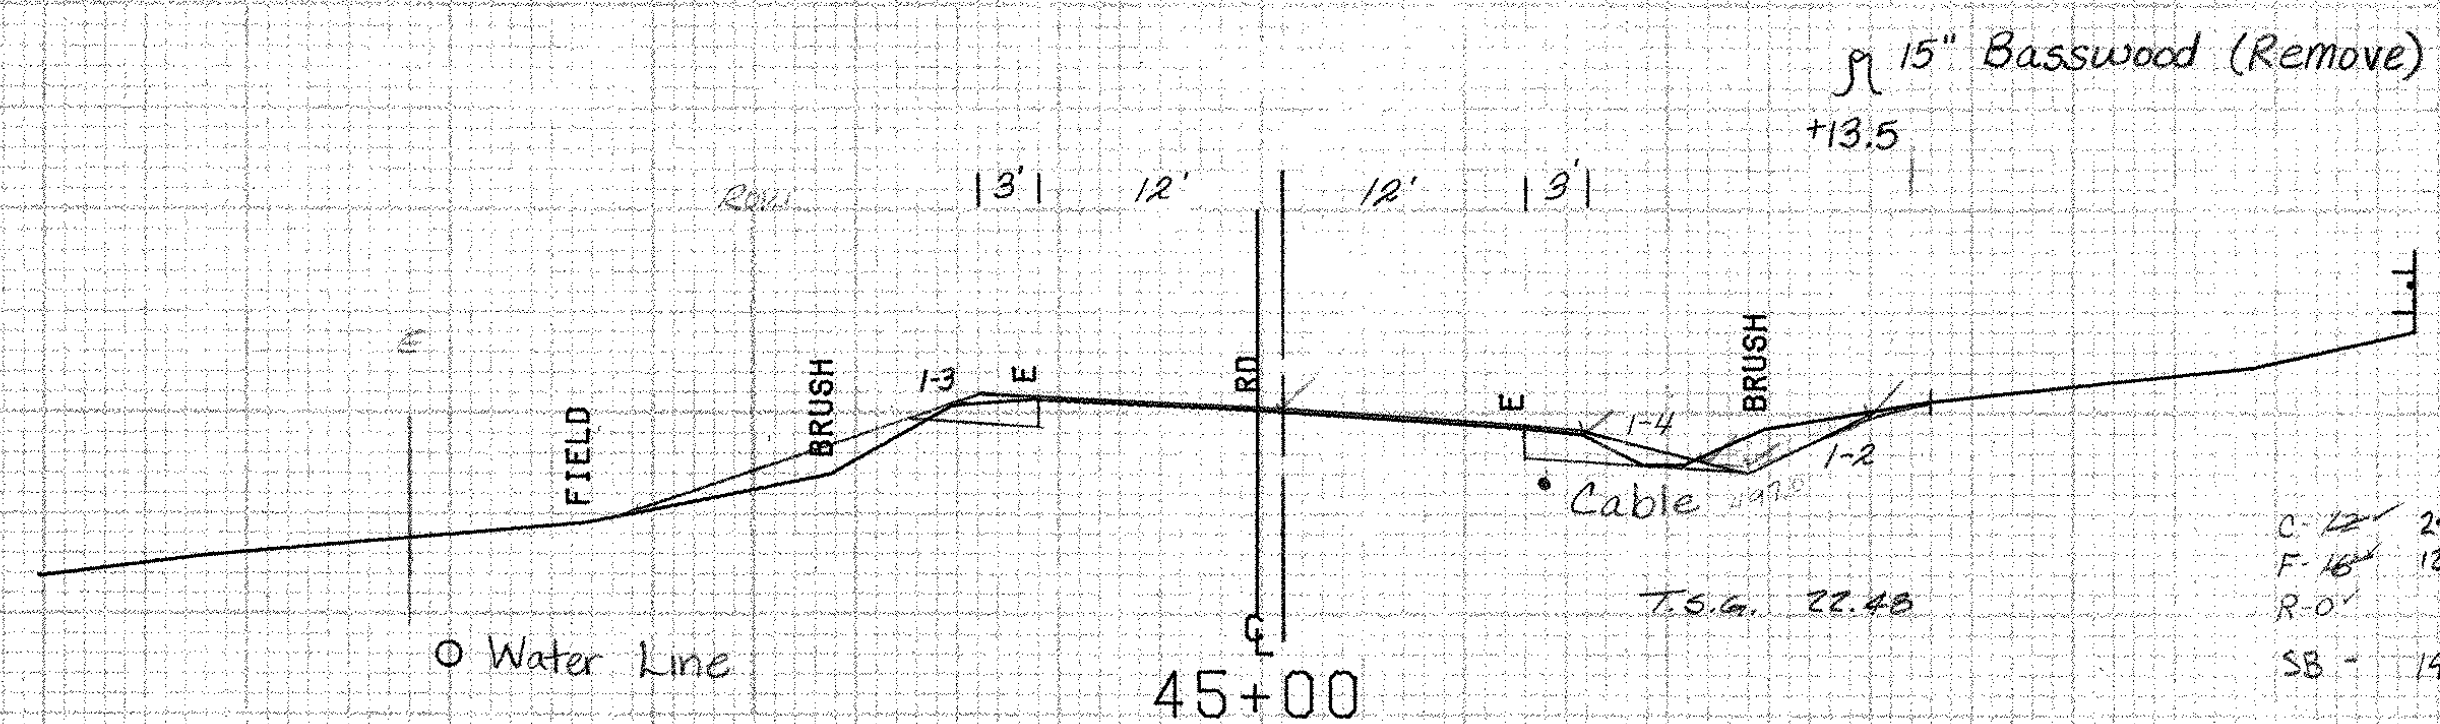

SHOREHAM MM 4.39 ~ MM 4.52

FROM STA.	44+30	TO STA.	45+00
PROJECT NAME	SHOREHAM-BRIDPORT-ADDISON		
NO.	F017-1(2)	PLOTTED	03/29/84
SURVEYED BY	FANTONI		
SHEET	261 OF 420 SHEETS	SHEET	201 OF 477

SCALE 1" = 10 FEET

CUT 2-5-92 WJG