


45+78 Rt 500
 Exist. Spring w/ 5'x5' Concrete Cover
 Remove to Elev. 496.0 and Backfill
 w/ Stone Fill, Type I


45+49 Rt. ~ 45+70 Rt.
 Existing 12" CMP REMOVE

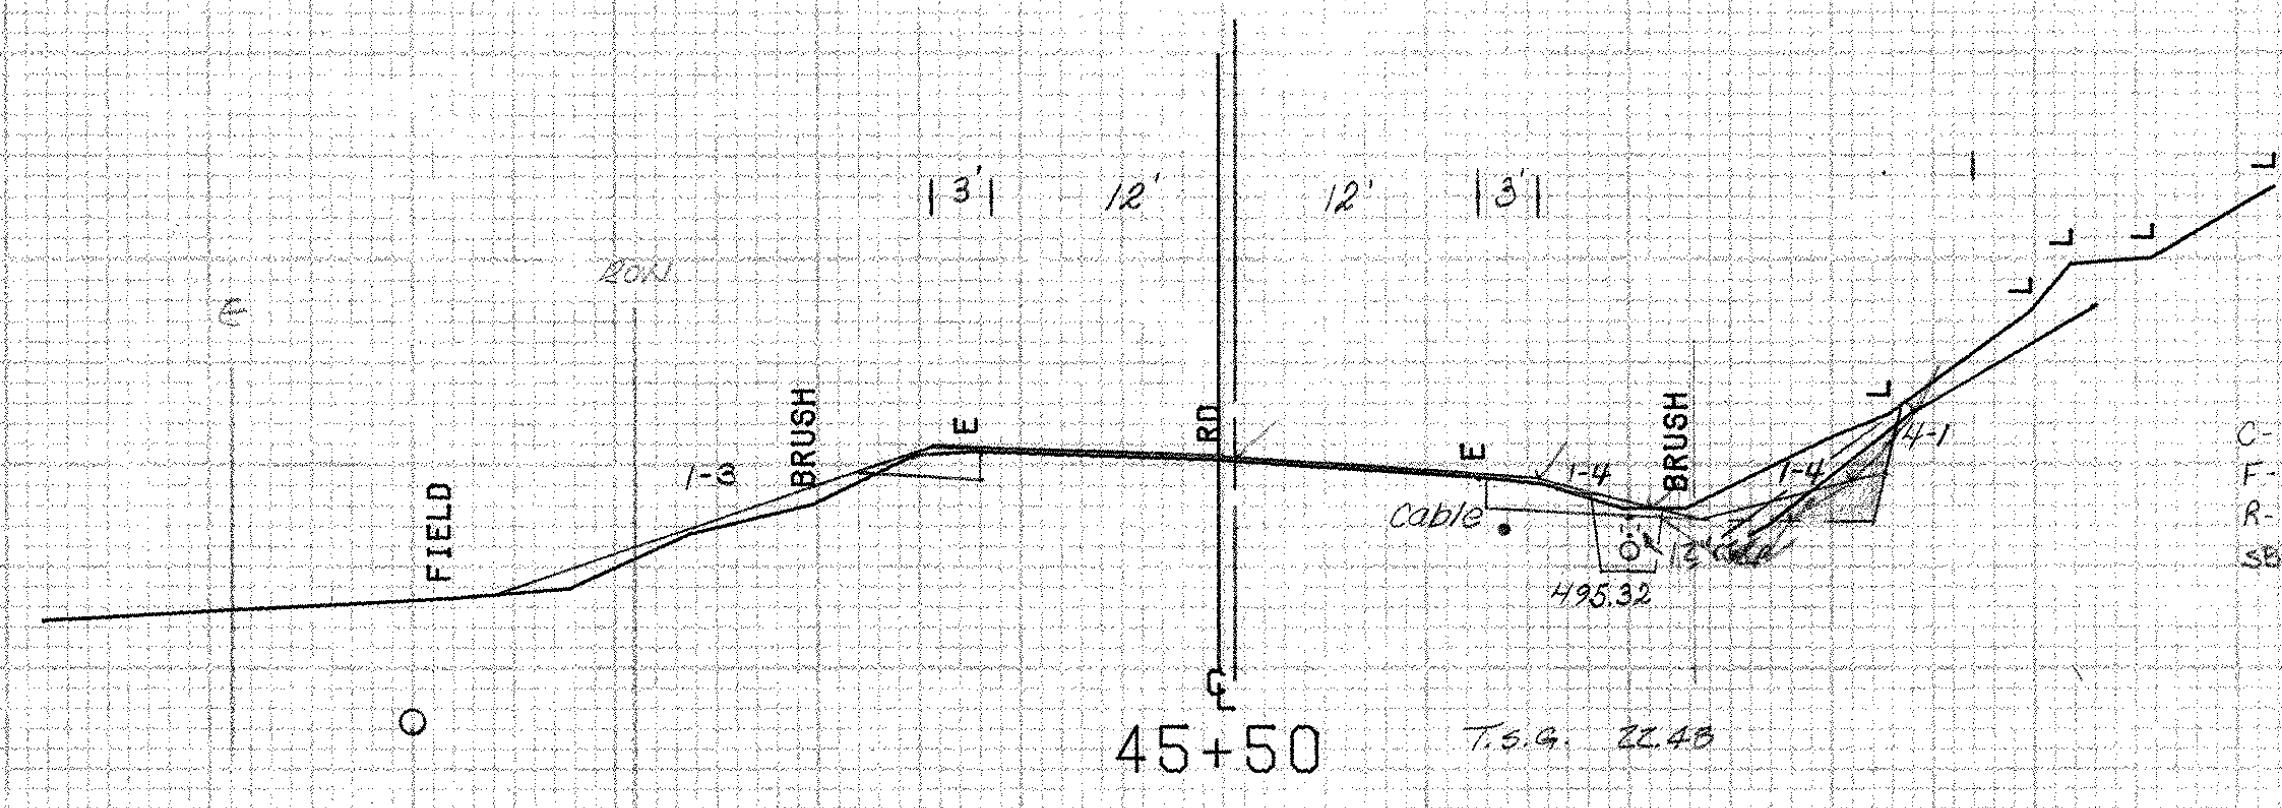

C-35 45
 F-25
 R-17
 SB-125

Rock		EARTH	
23.5	495.7	22.45	496.2
24.0	495.8	23.5	495.7
26.0	495.8	30.0	501.4
27.0	497.3	30.0	501.4
32.0	497.3	22.45	496.0
33.0	502.0	22.45	496.2
23.5	495.7		

45+46 Rt.
 Begin 6" x 54" Underdrain

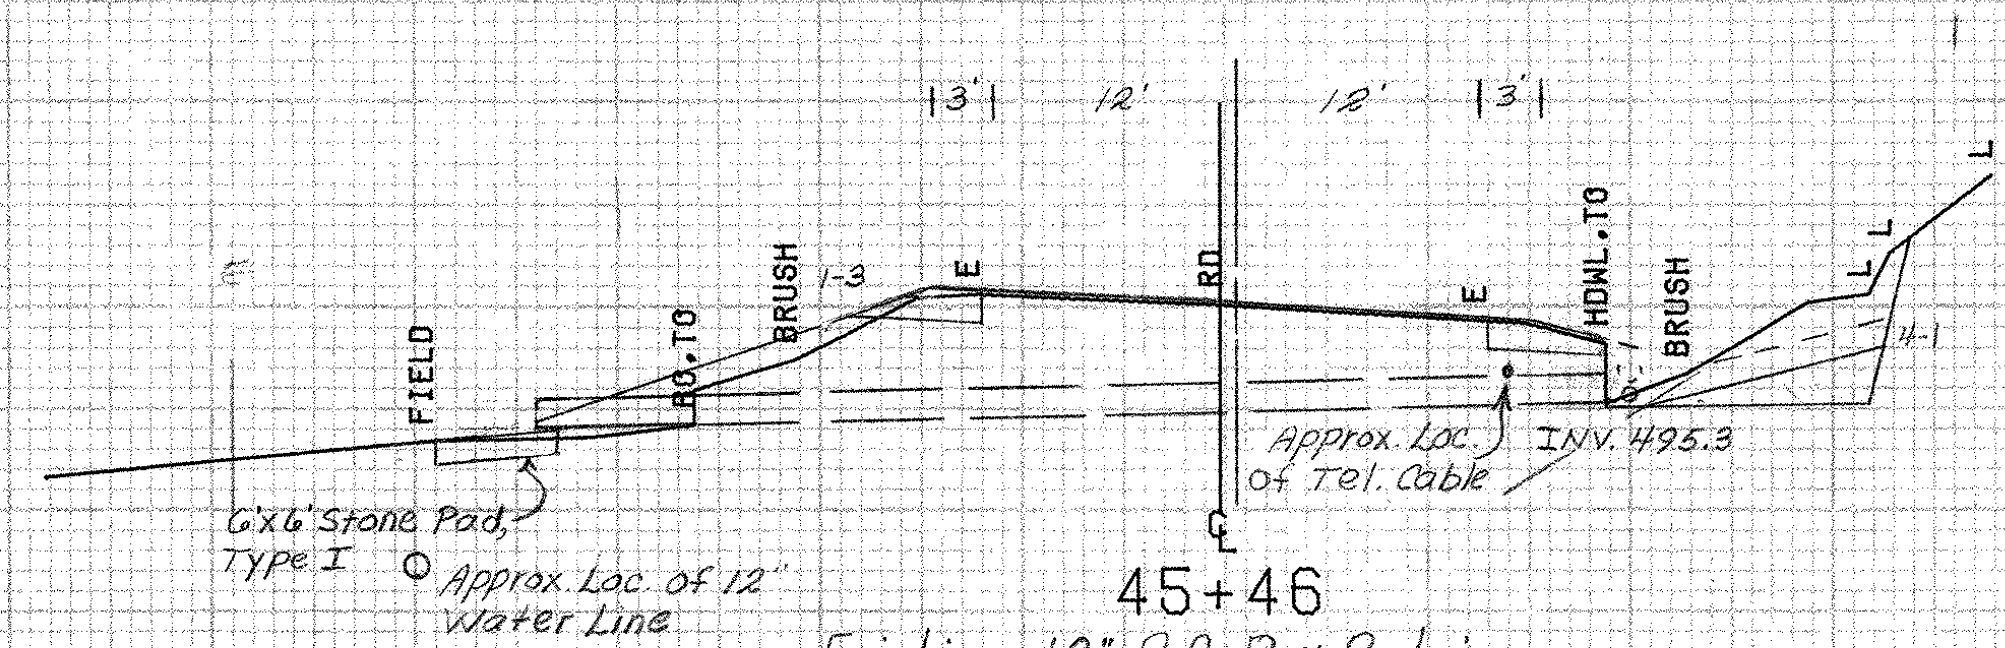

C-48 56
 F-42
 R-42 45
 SB-14

45+46
 Existing 18" R.C.P. ~ Retain
 Extend w/ New 18" x 8" RCP CL III w/
 6'x6' Stone Fill Pad @ Outlet
 REMOVE L PORTION OF INLET HEADWALL

SHOREHAM MM 4.39-MM 4.52

FROM STA.	45+46	TO STA.	45+78
PROJECT NAME	SHOREHAM-BRIDPORT-ADDISON		
NO.	F017-1(2)	PLOTTED	03/29/84
SURVEYED BY	FANTONI		03/84
SHEET	262 OF 420 SHEETS	SHEET	262 OF 477

SCALE 1" = 10 FEET