


18" Elm.
(Remove)
+94

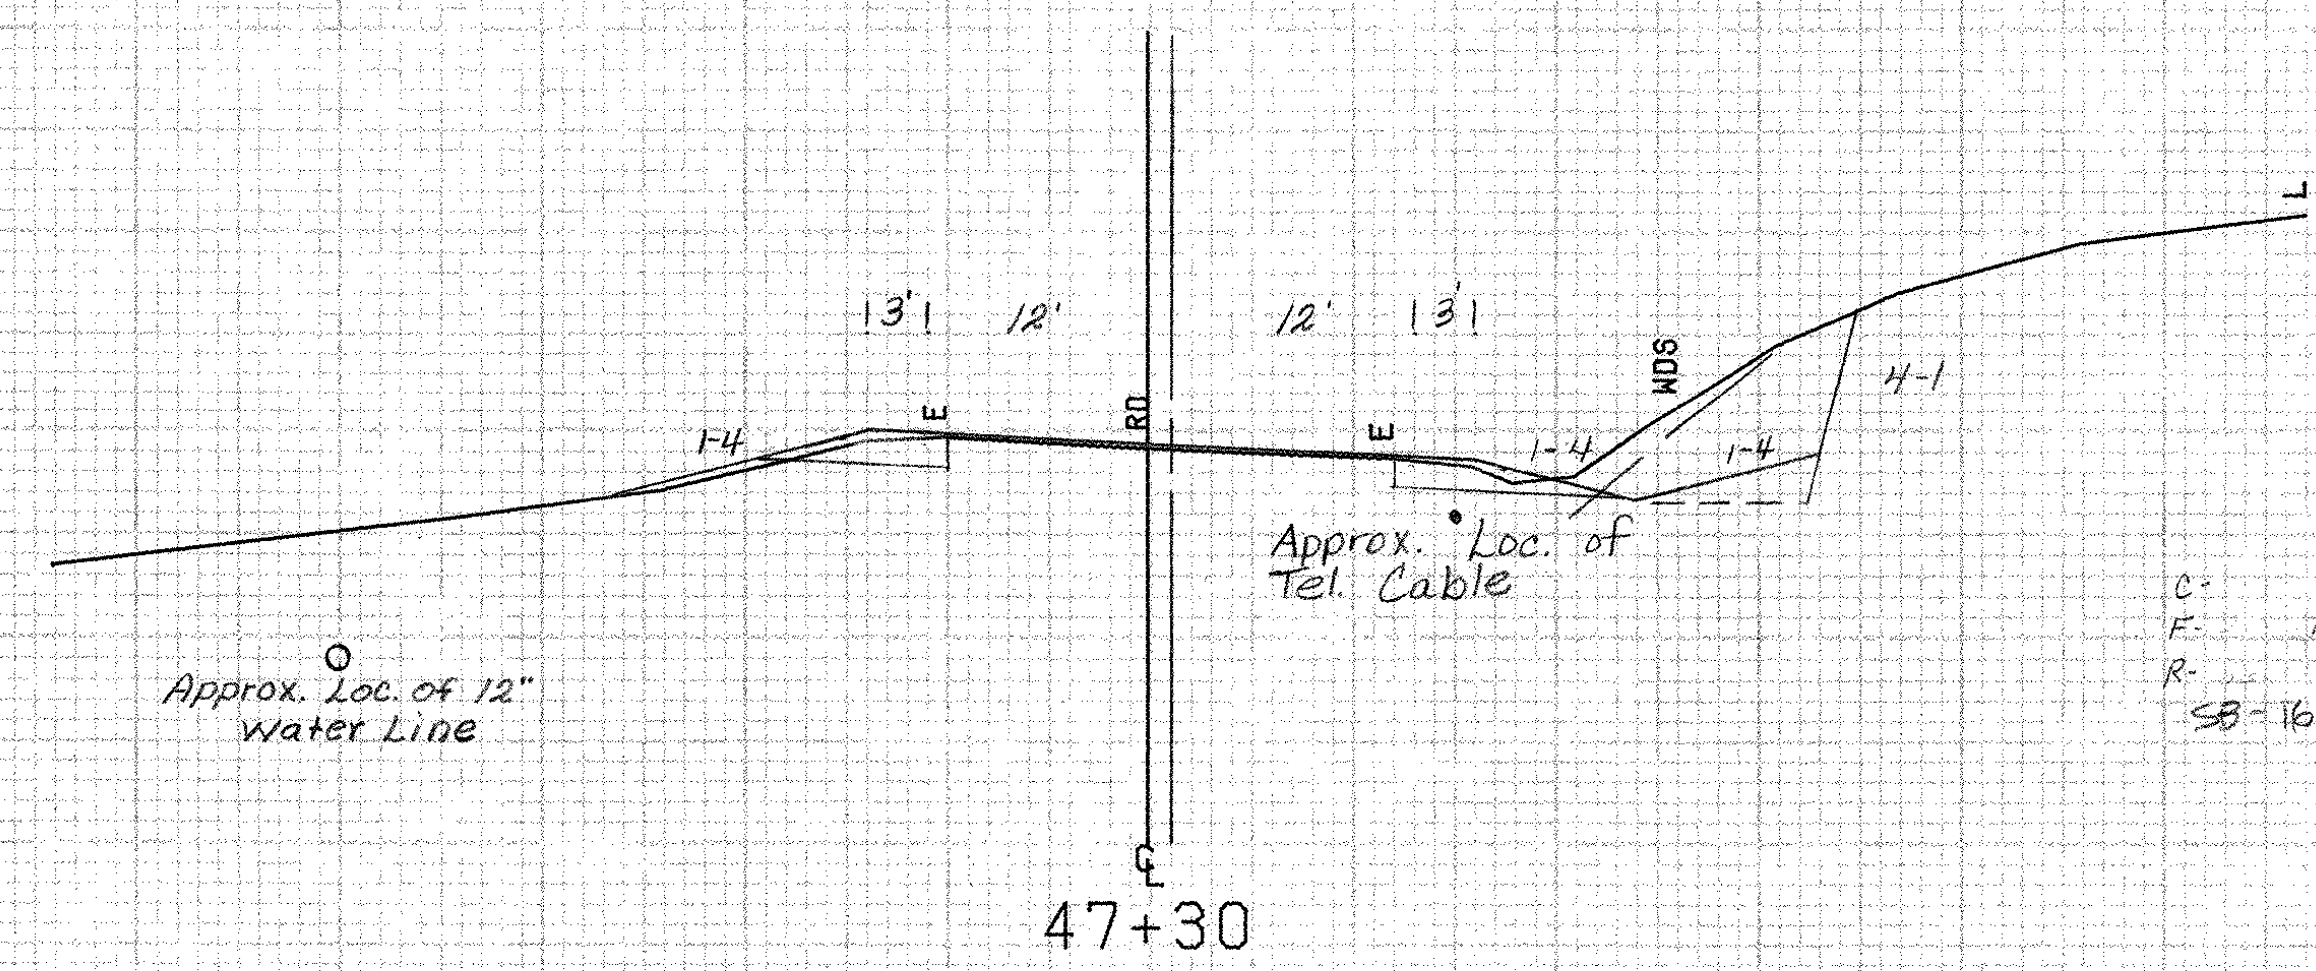

C- 80
E- 13
R- 58
SB-16

490

SHOREHAM MM 4.39 ~ MM 4.52

FROM STA.	47+30	TO STA.	47+30
PROJECT NAME	SHOREHAM-BRIDPORT-ADDISON		
NO.	F017-1(2)	PLOTTED	03/29/84
SURVEYED BY	FANTONI		03/84
SHEET 264	OF 480 SHEETS	SHEET 264	OF 477

SCALE 1" = 10 FEET