


EARTH

19.00	496.1
22.0	496.0
26.0	495.8
32.0	497.5
42.0	501.0
47.0	504.4
55.0	503.7
23.0	495.8
19.00	497.0
19.00	496.1


490

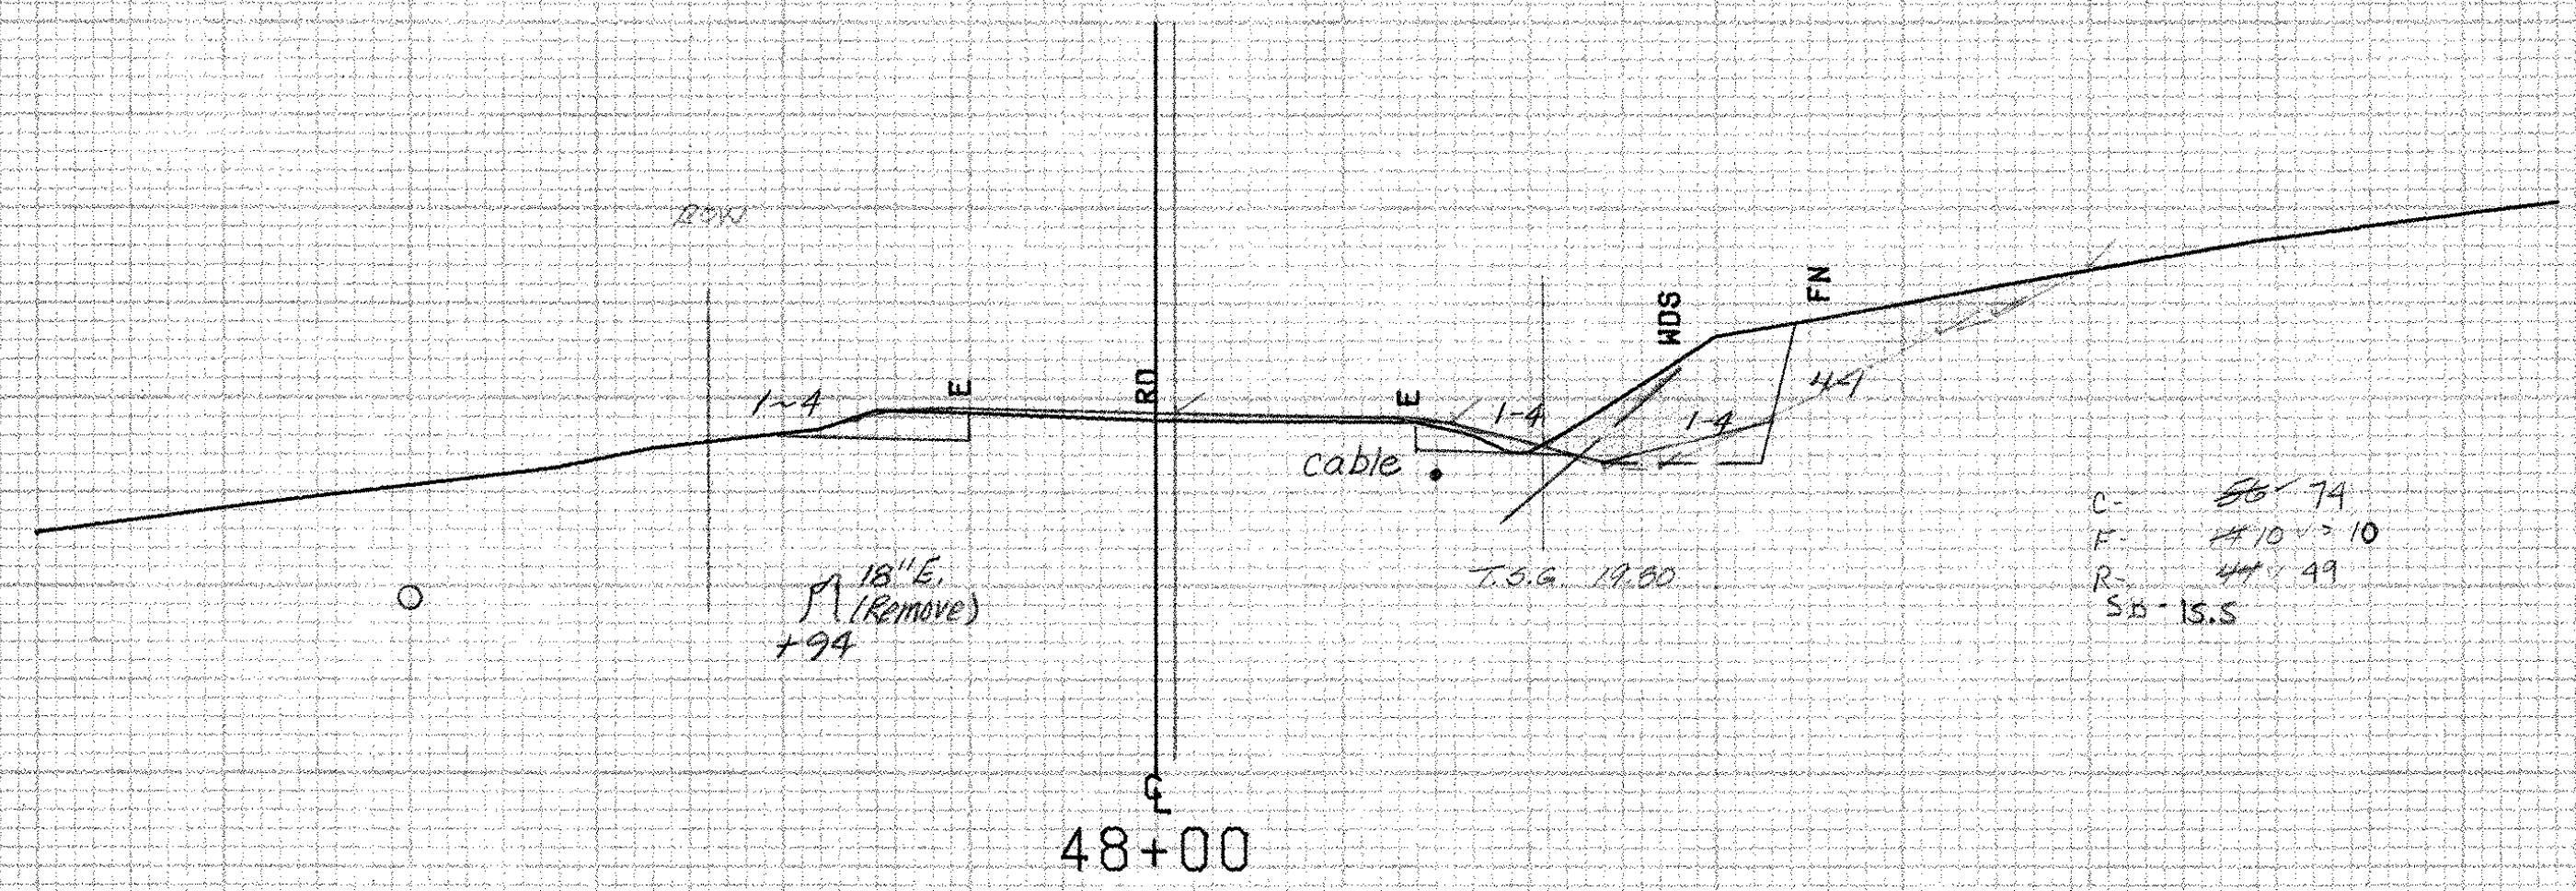

EARTH

18.00	494.2
23.0	494.2
25.0	496.5
35.0	500.6
41.0	503.4
44.0	504.4
49.0	506.3
27.0	503.2
19.00	497.5
18.00	494.2

490

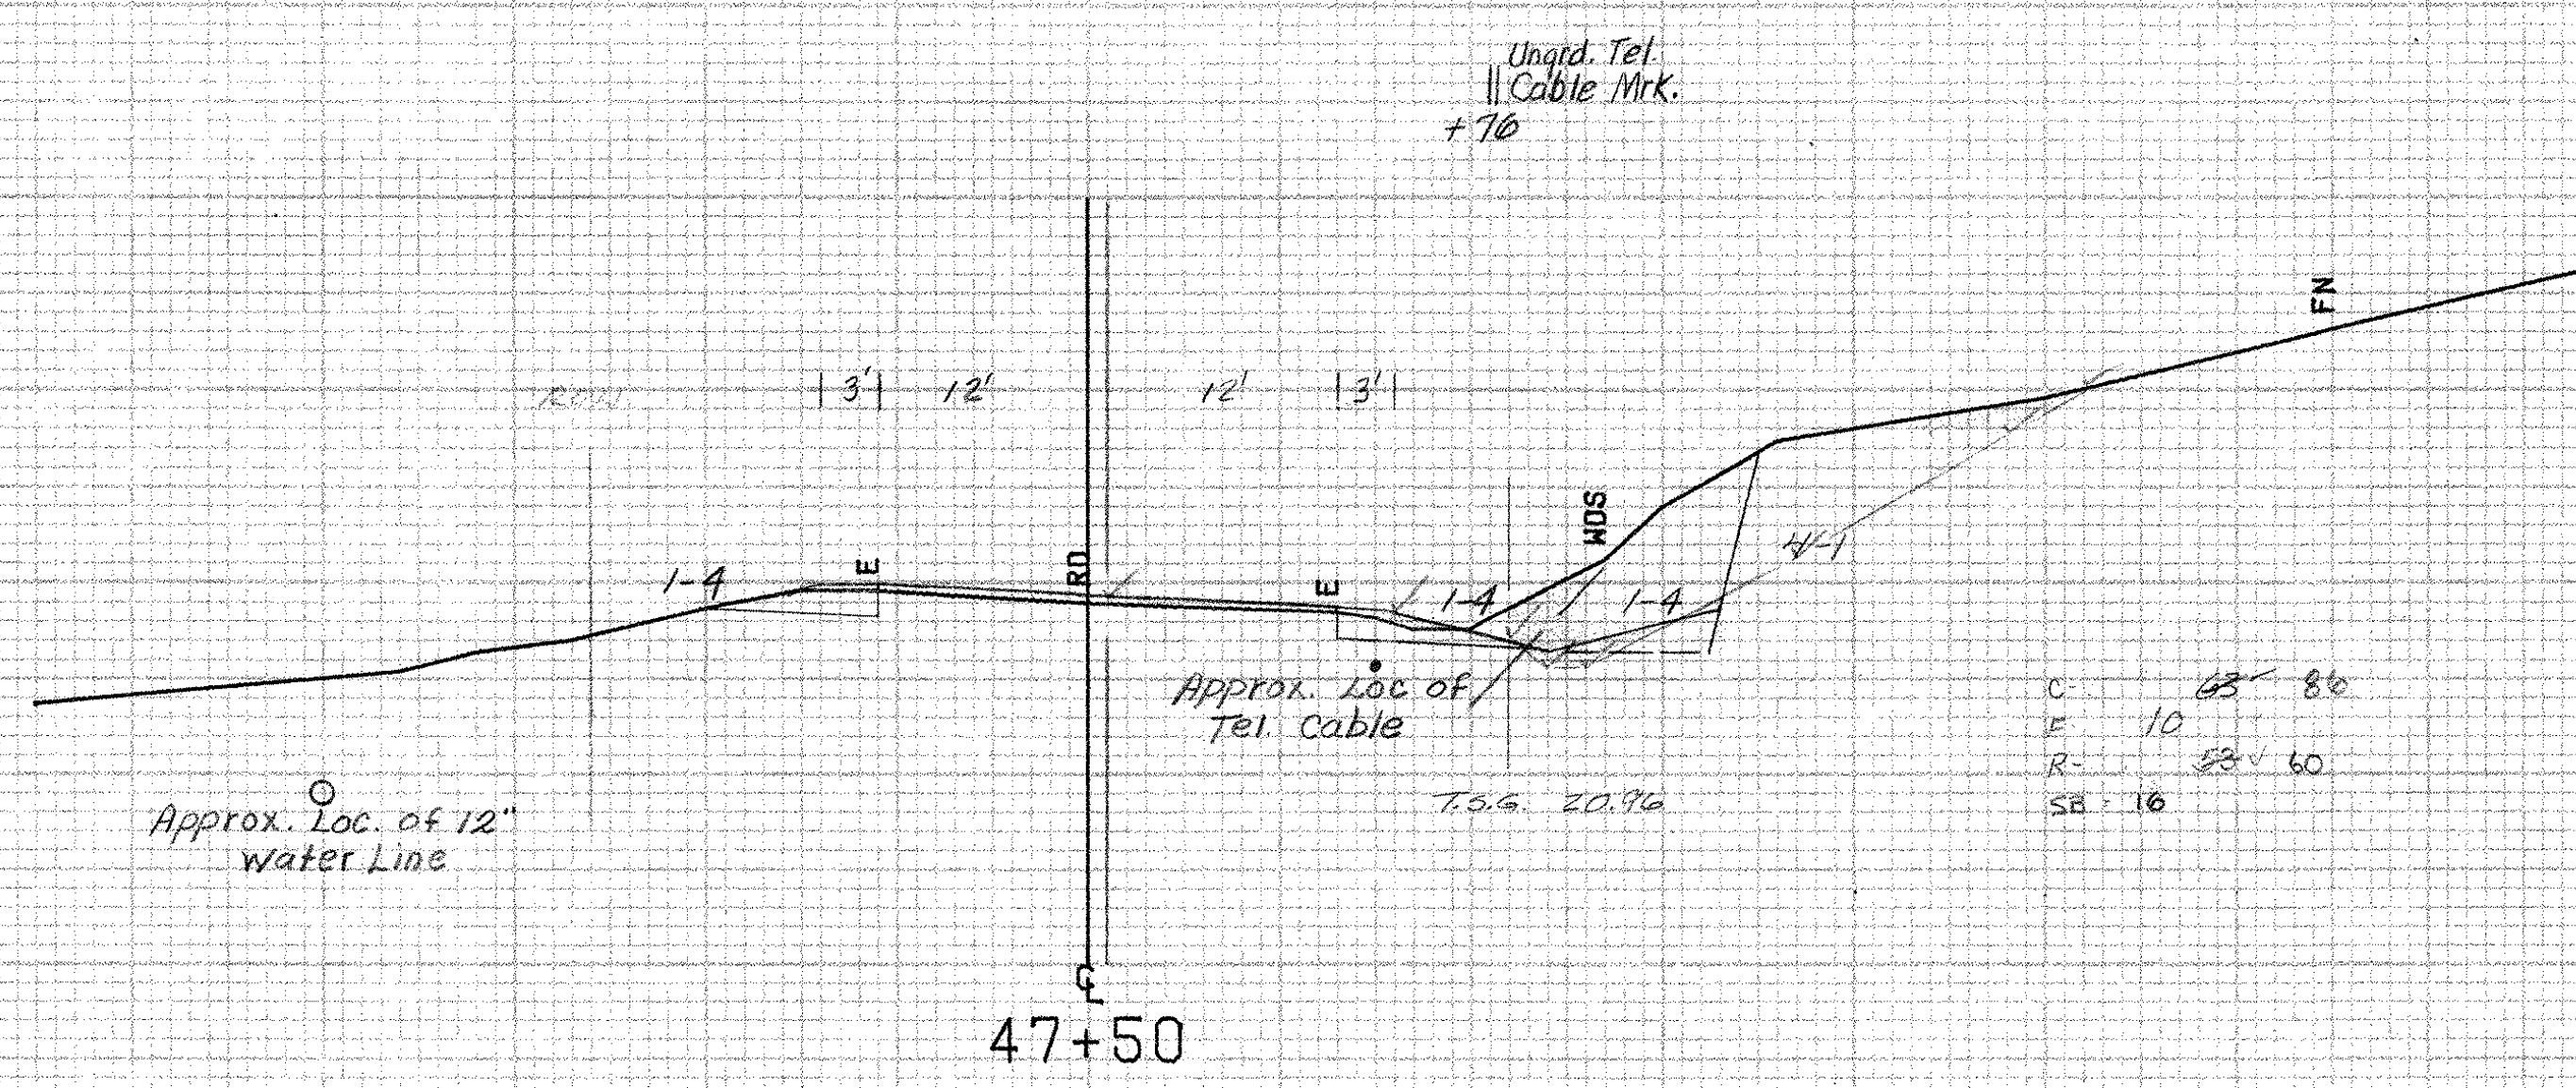

EARTH

20.76	499.1
23.0	495.6
25.0	496.9
36.0	501.1
47.0	507.4
51.0	508.0
55.0	507.4
29.0	505.0
26.0	501.0
20.76	498.7
20.76	499.1

490

SHOREHAM M.M. 4.39 - M.M. 4.52

FROM STA.	47+50	TO STA.	48+50
PROJECT NAME	SHOREHAM-ADDISON MAINS		
NO.	F017-1(2)	PLOTTED	01/09/85
SURVEYED BY	FANTONI	DEC	1984
SHEET	265	OF	420 SHEETS
		SHEET	265
		OF	477

SCALE 1" = 10 FEET

CUT 6-8-93 WJG