


490

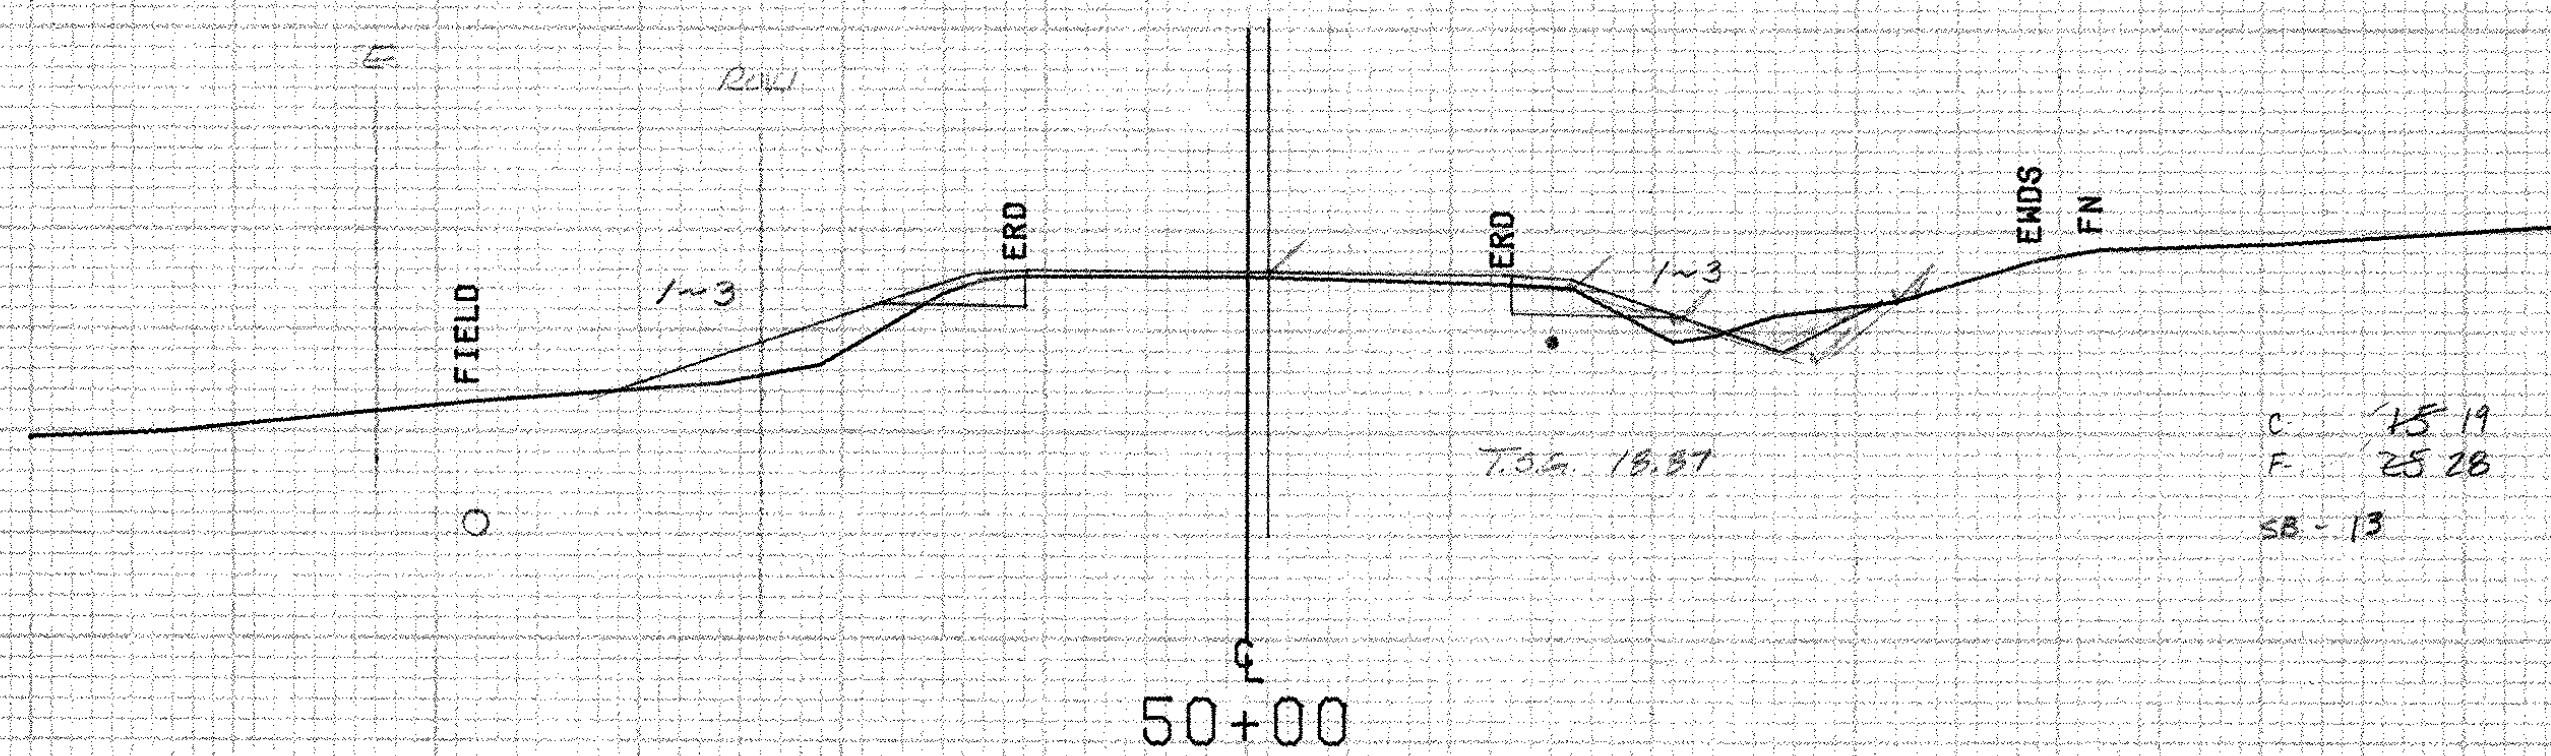


490

EARTH

22.50	495.0
25.0	494.0
31.0	494.5
25.0	495.1
22.50	495.0

Cut 8.00

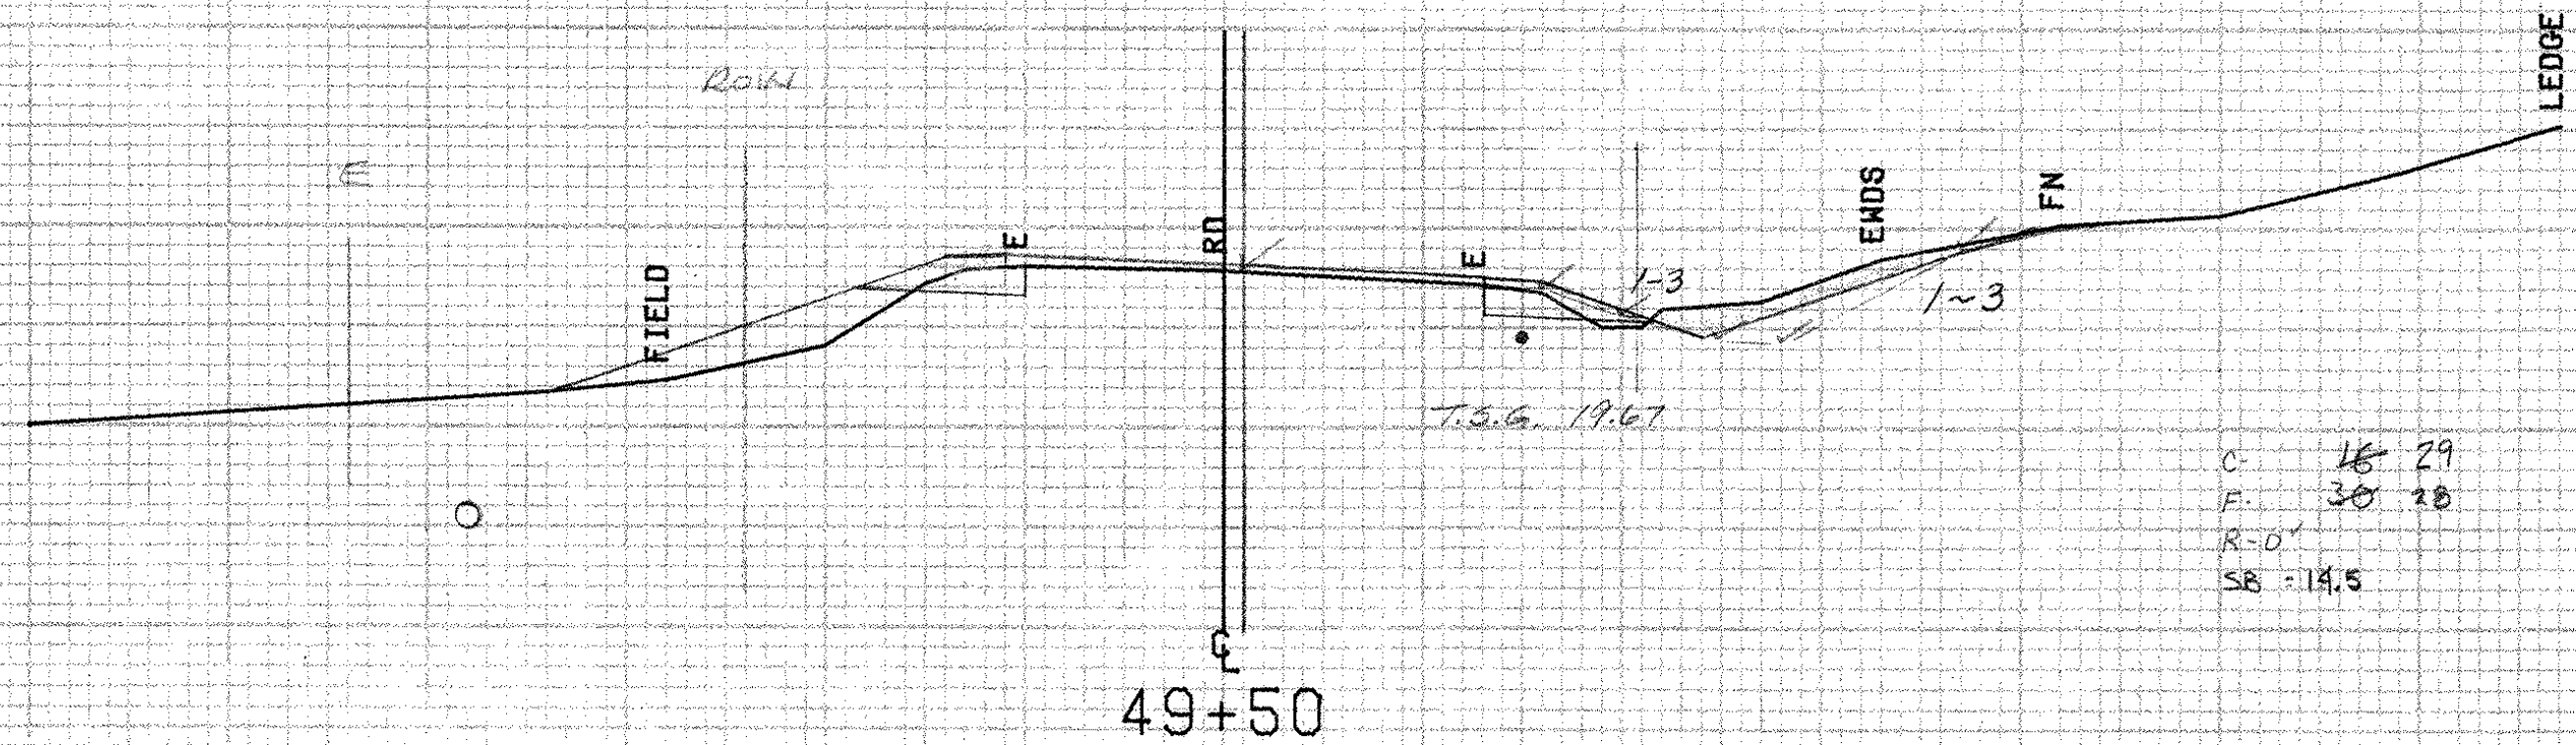


490

EARTH

19.67	495.3
24.0	494.5
36.0	495.7
32.0	495.6
20.0	496.4
21.0	496.0
20.3	495.4
19.67	495.7
19.67	495.3

Cut 17.17

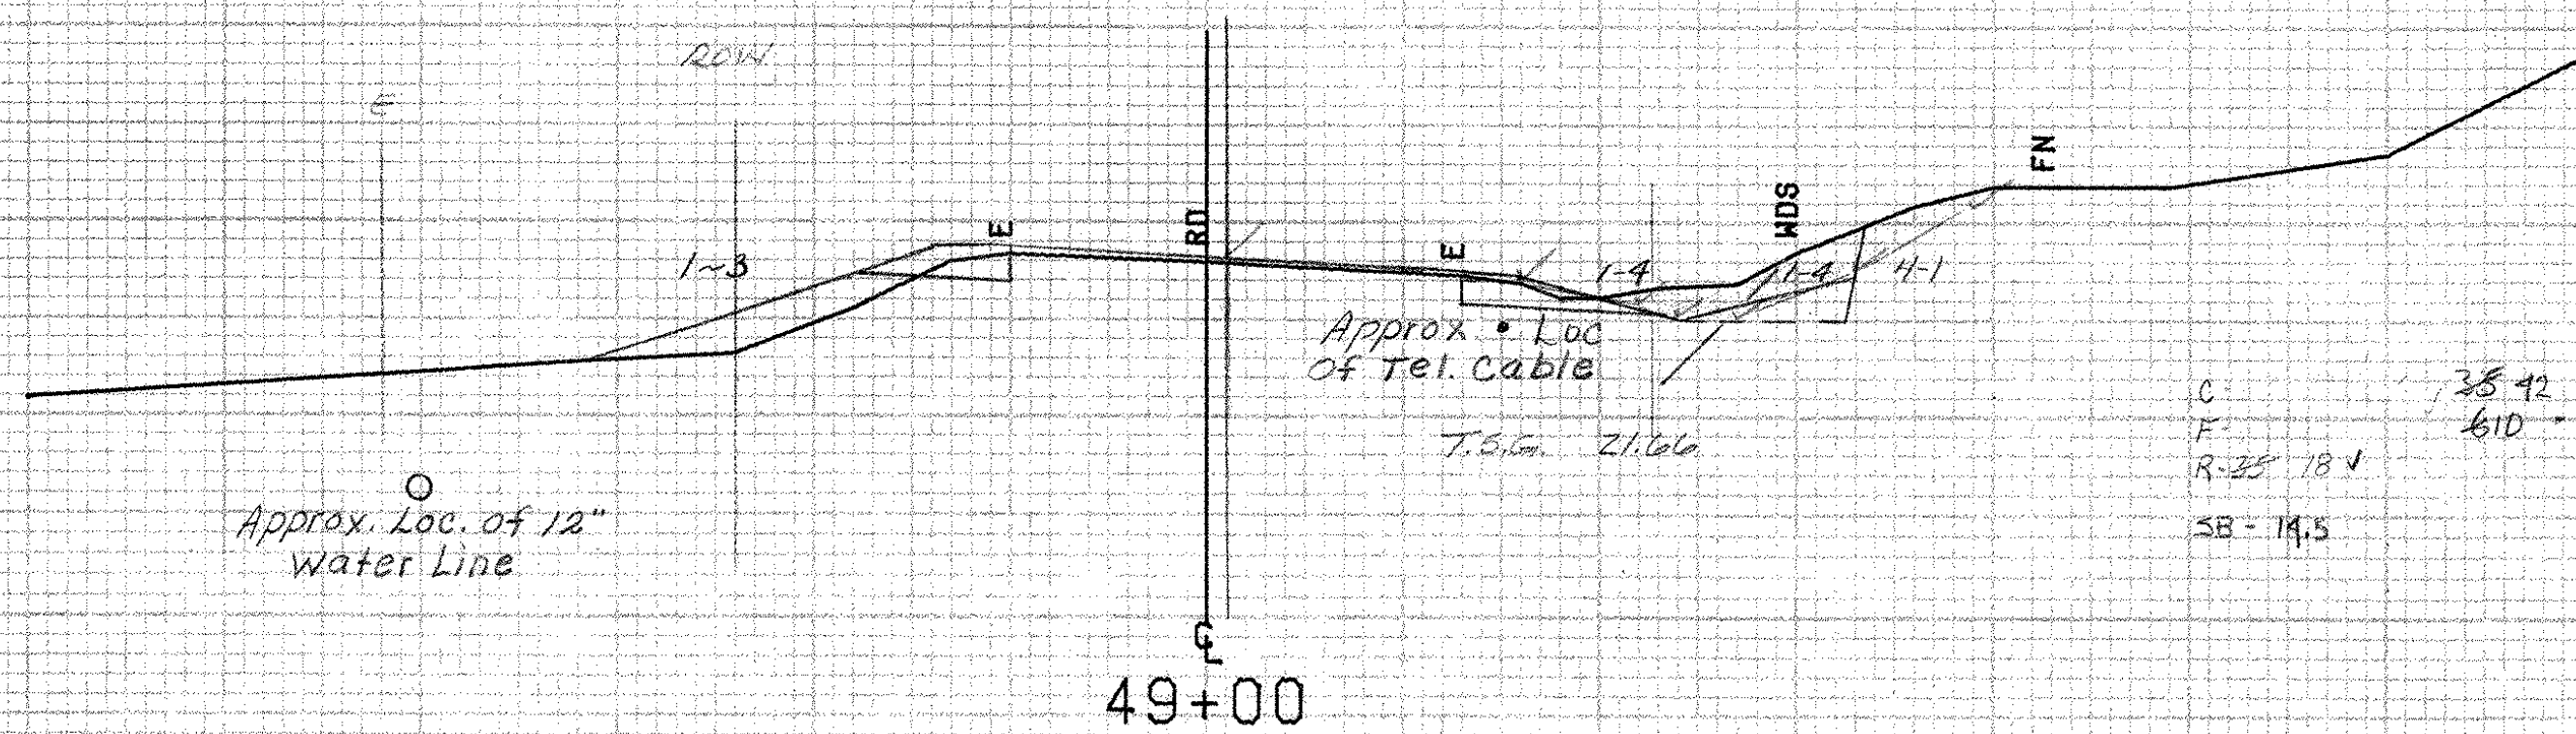

490

EARTH

21.66	495.3
23.0	495.1
26.0	495.3
32.0	497.4
39.0	500.0
40.0	500.0
35.0	501.0
29.0	498.3
26.0	497.0
21.66	495.3
21.66	495.3

Cut 31.14

SHOREHAM MM 4.39 - MM 4.52

FROM STA.	49+00	TO STA.	50+46
PROJECT NAME	SHOREHAM-ADDISON MAINS		
NO.	F017-1(2)		
SURVEYED BY	FANTONI	DEC 1984	PLOTTED 01/09/85
SHEET 266	OF 420 SHEETS	SHEET 266	OF 477

SCALE 10 FEET