



DATE _____ BY _____
 SUBMITTED _____
 ORIGINAL SURVEY _____
 NOTE BOOK _____
 NO. _____

DATE _____ BY _____
 SUBMITTED _____
 ORIGINAL SURVEY _____
 NOTE BOOK _____
 NO. _____

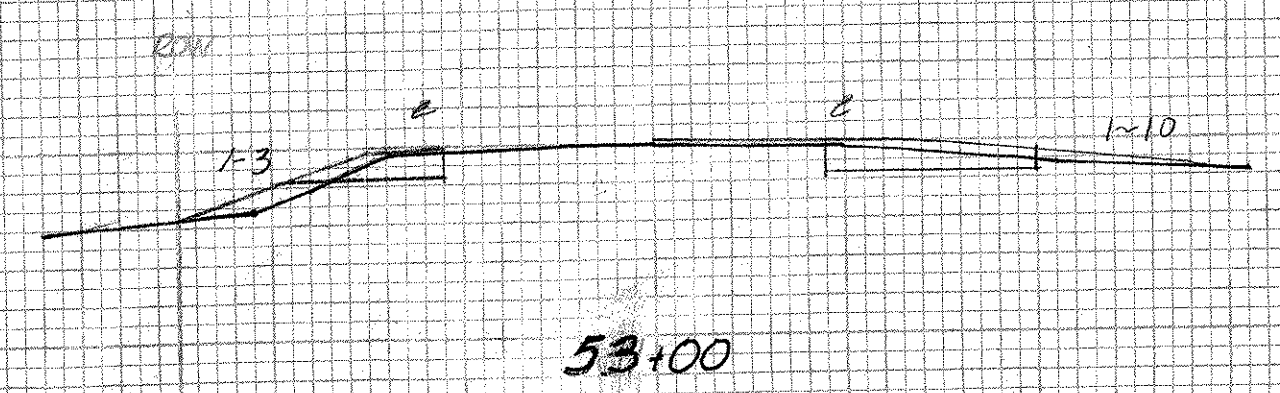

53+00

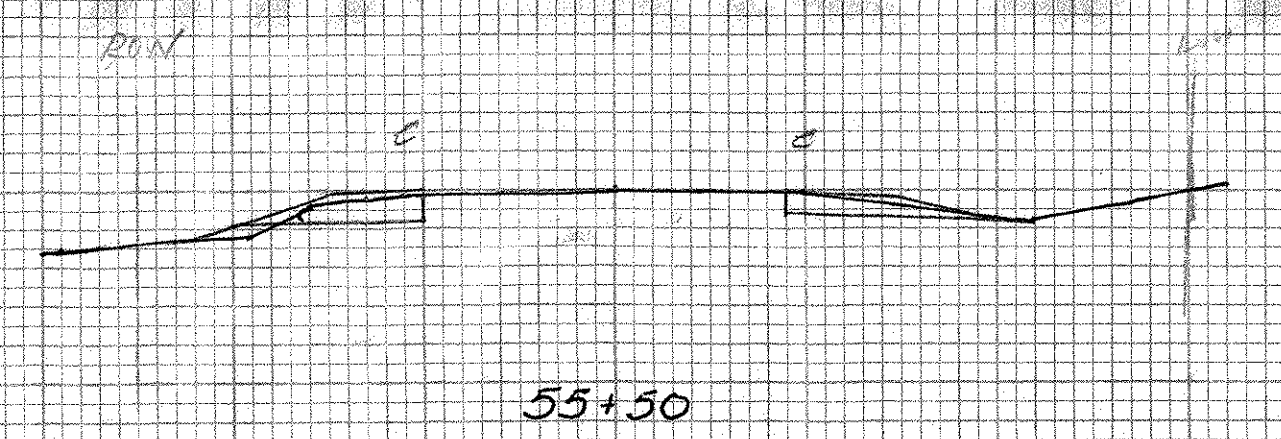


55+50




52+50




55+00

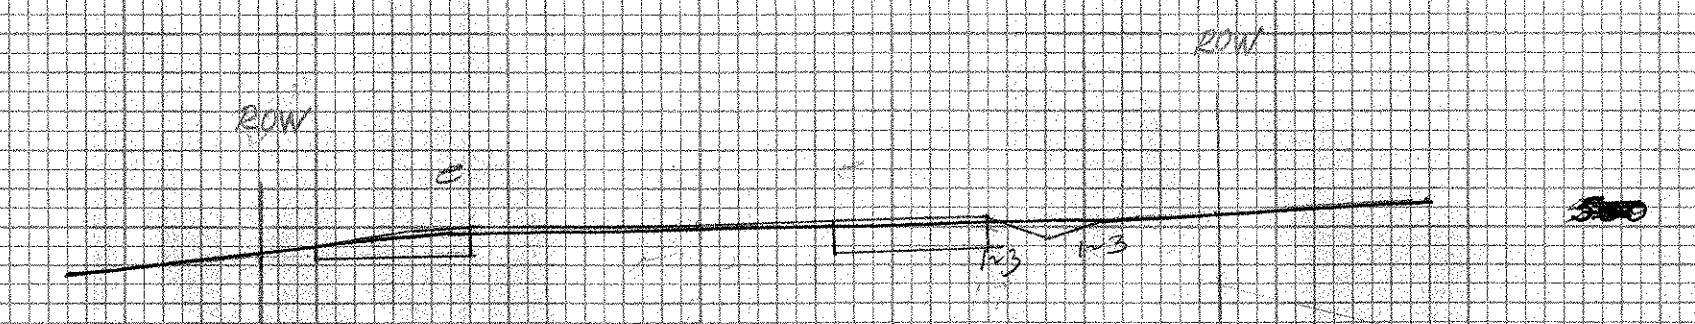


57+00

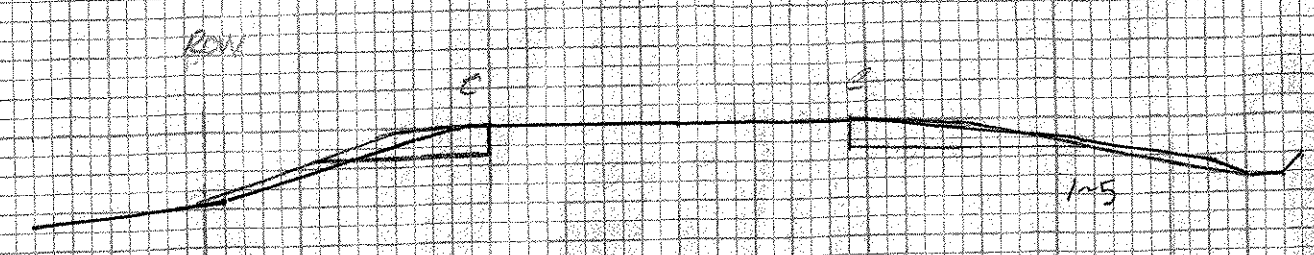

52+00

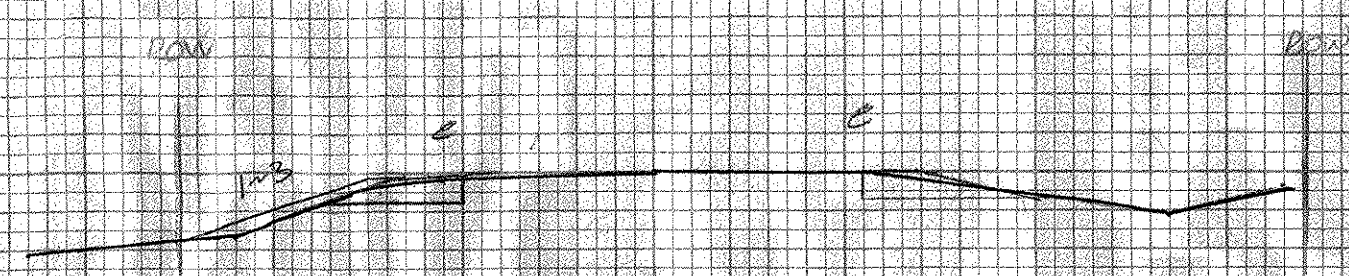


54+50

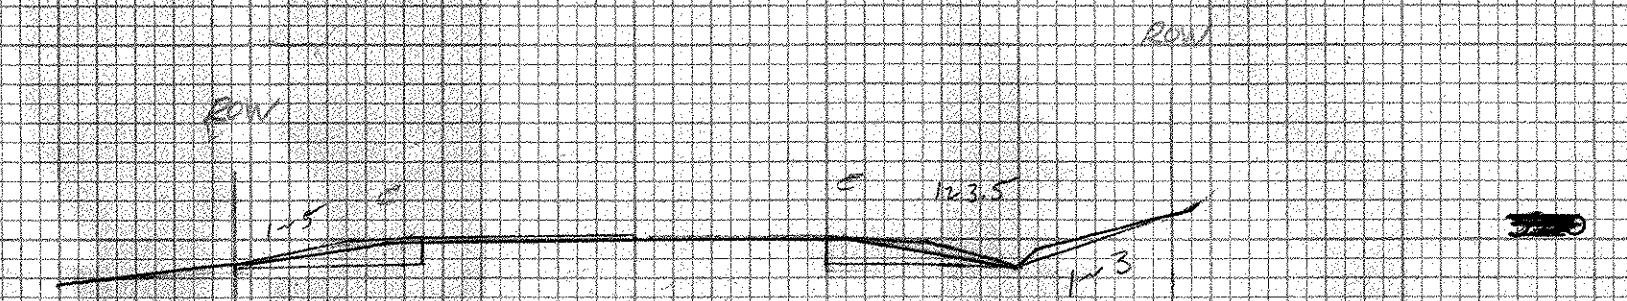


56+50




52+00

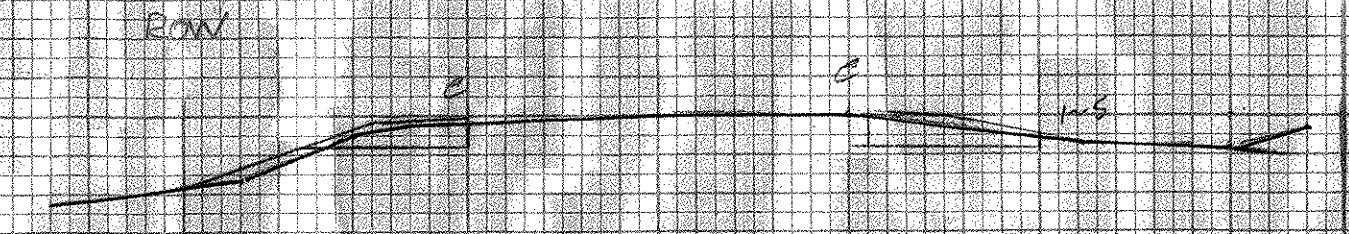


54+00

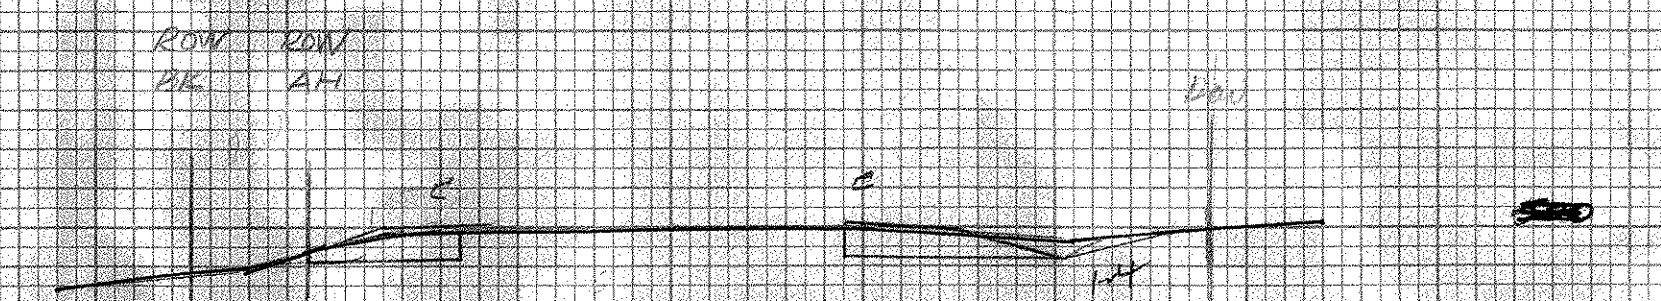

56+00

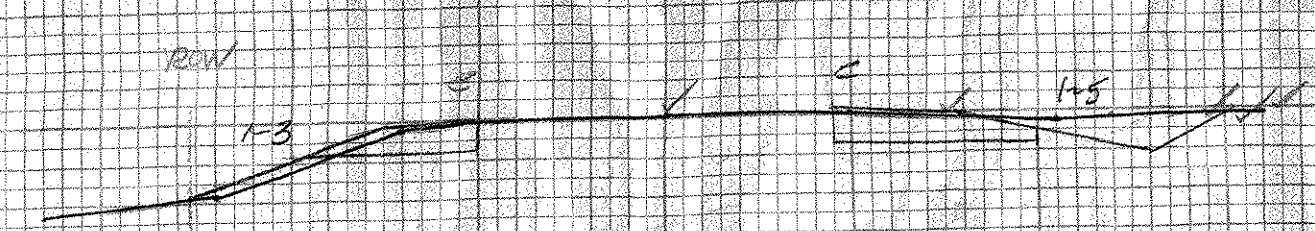

51+50

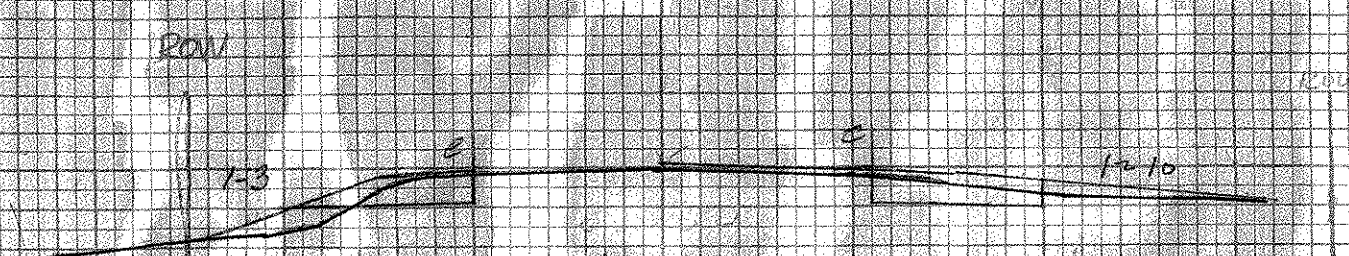

53+50

SHOREHAM-BRIDPORT-ADDISON
 F 017-1 (2)
 51+50 - 57+00

Original Sections
 11/23/41, 1/5/42, 1-2-41