



22
16
46

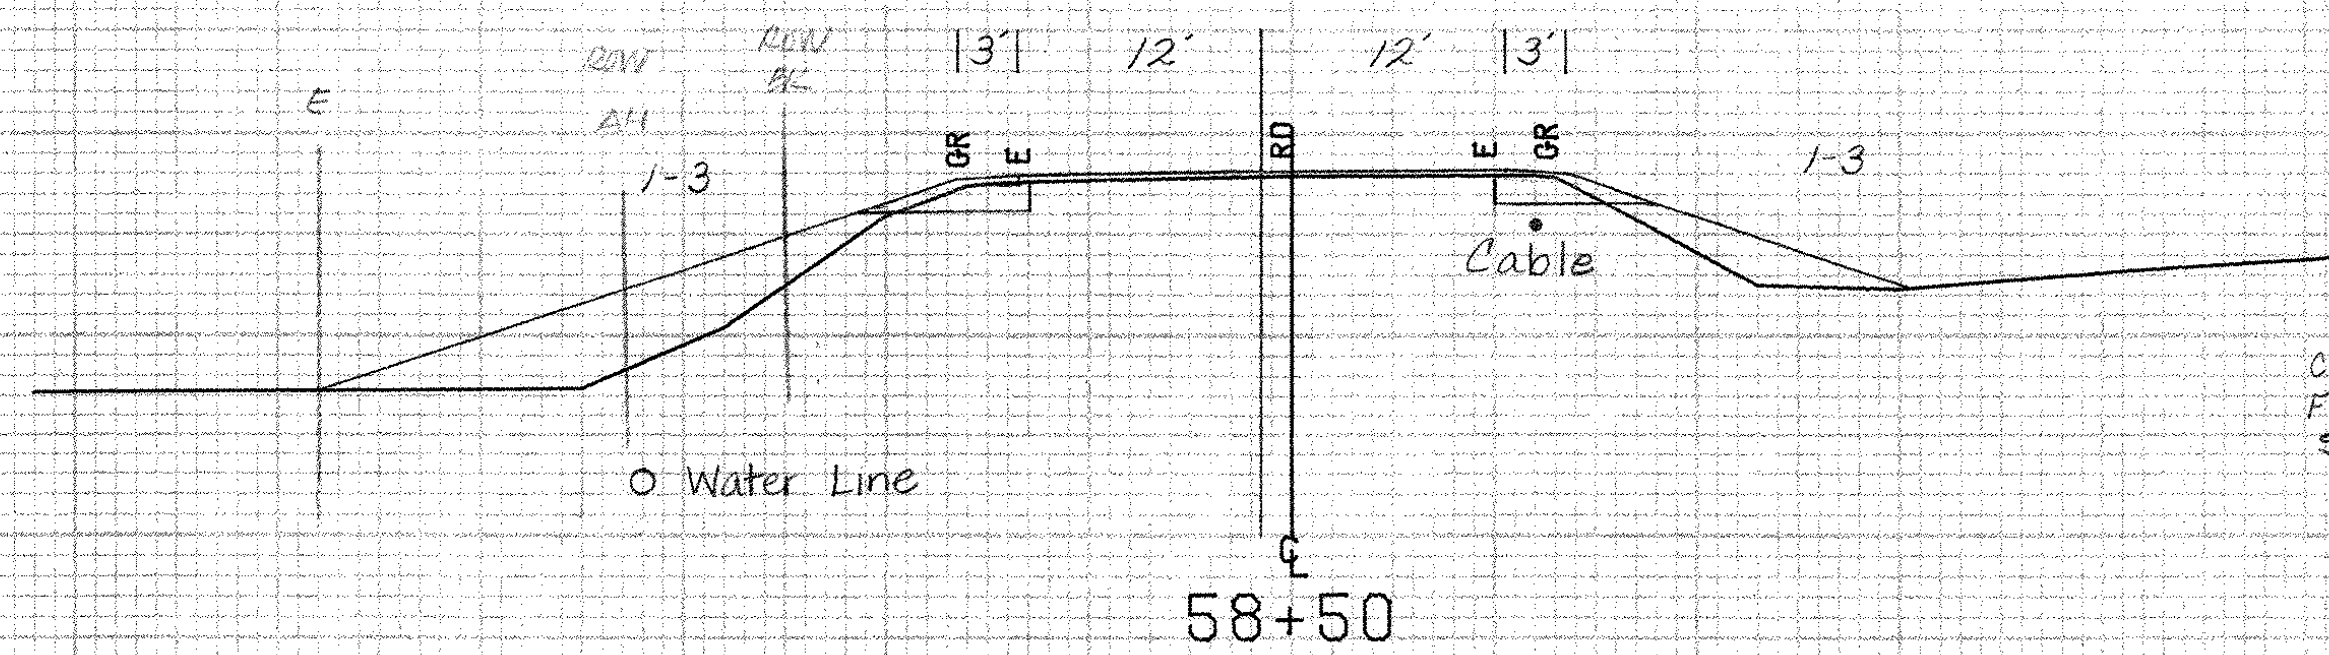

C. 513
F. 92-99
SB-135


500

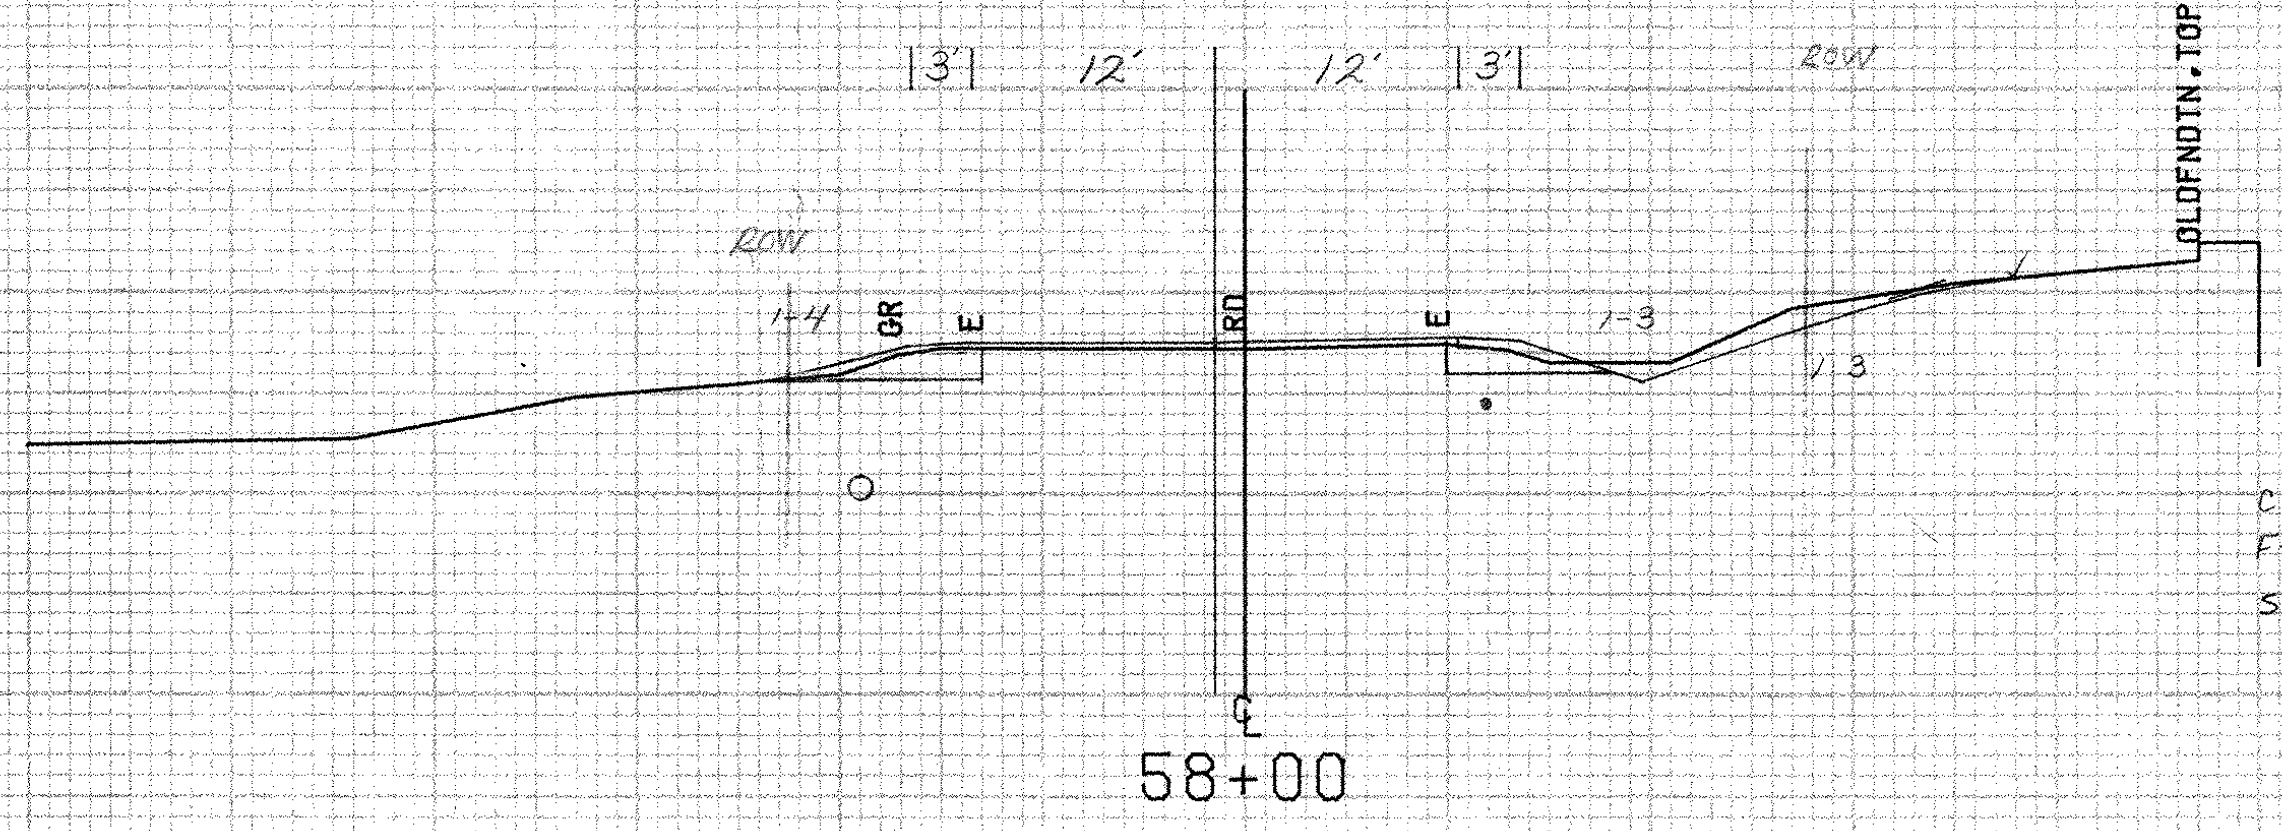

C. 21 32
F. 70
SB-15


500

+97
Pole #17

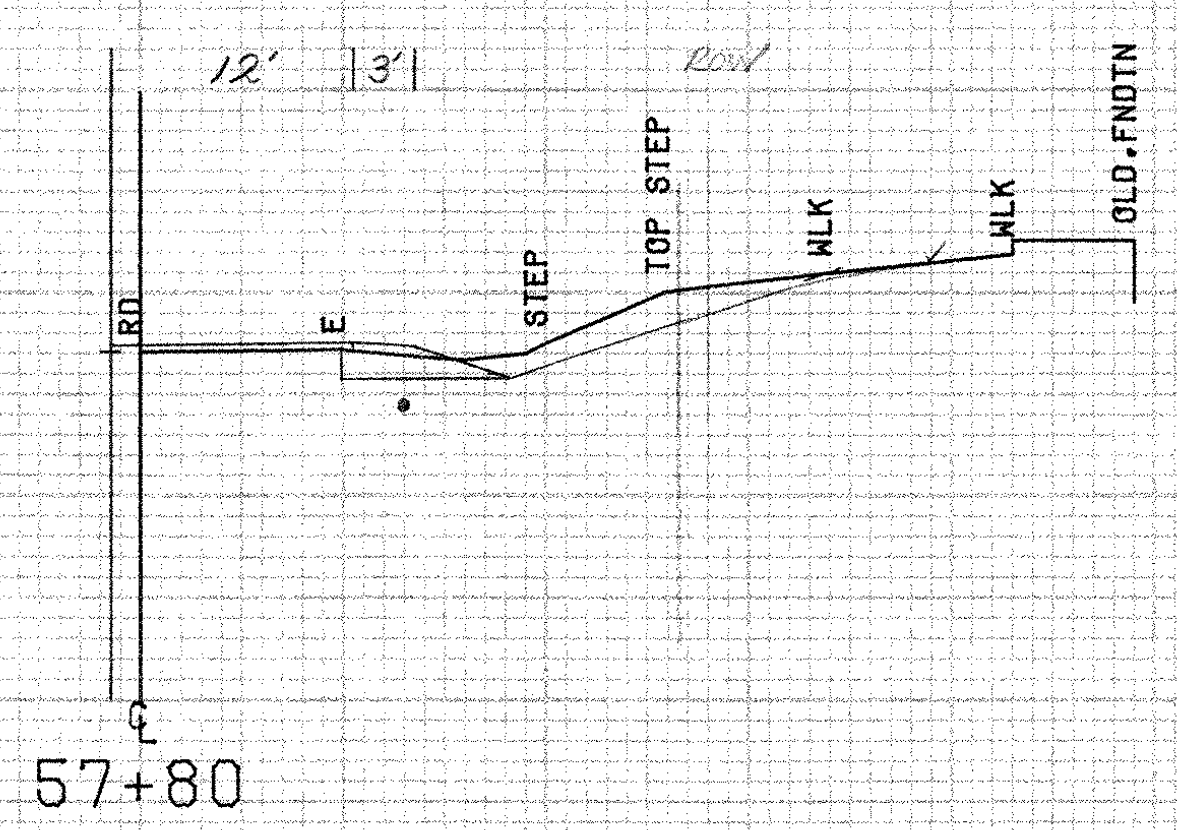

500

57+74 Lt.
Begin Removal And Disposal Of Guard Rail

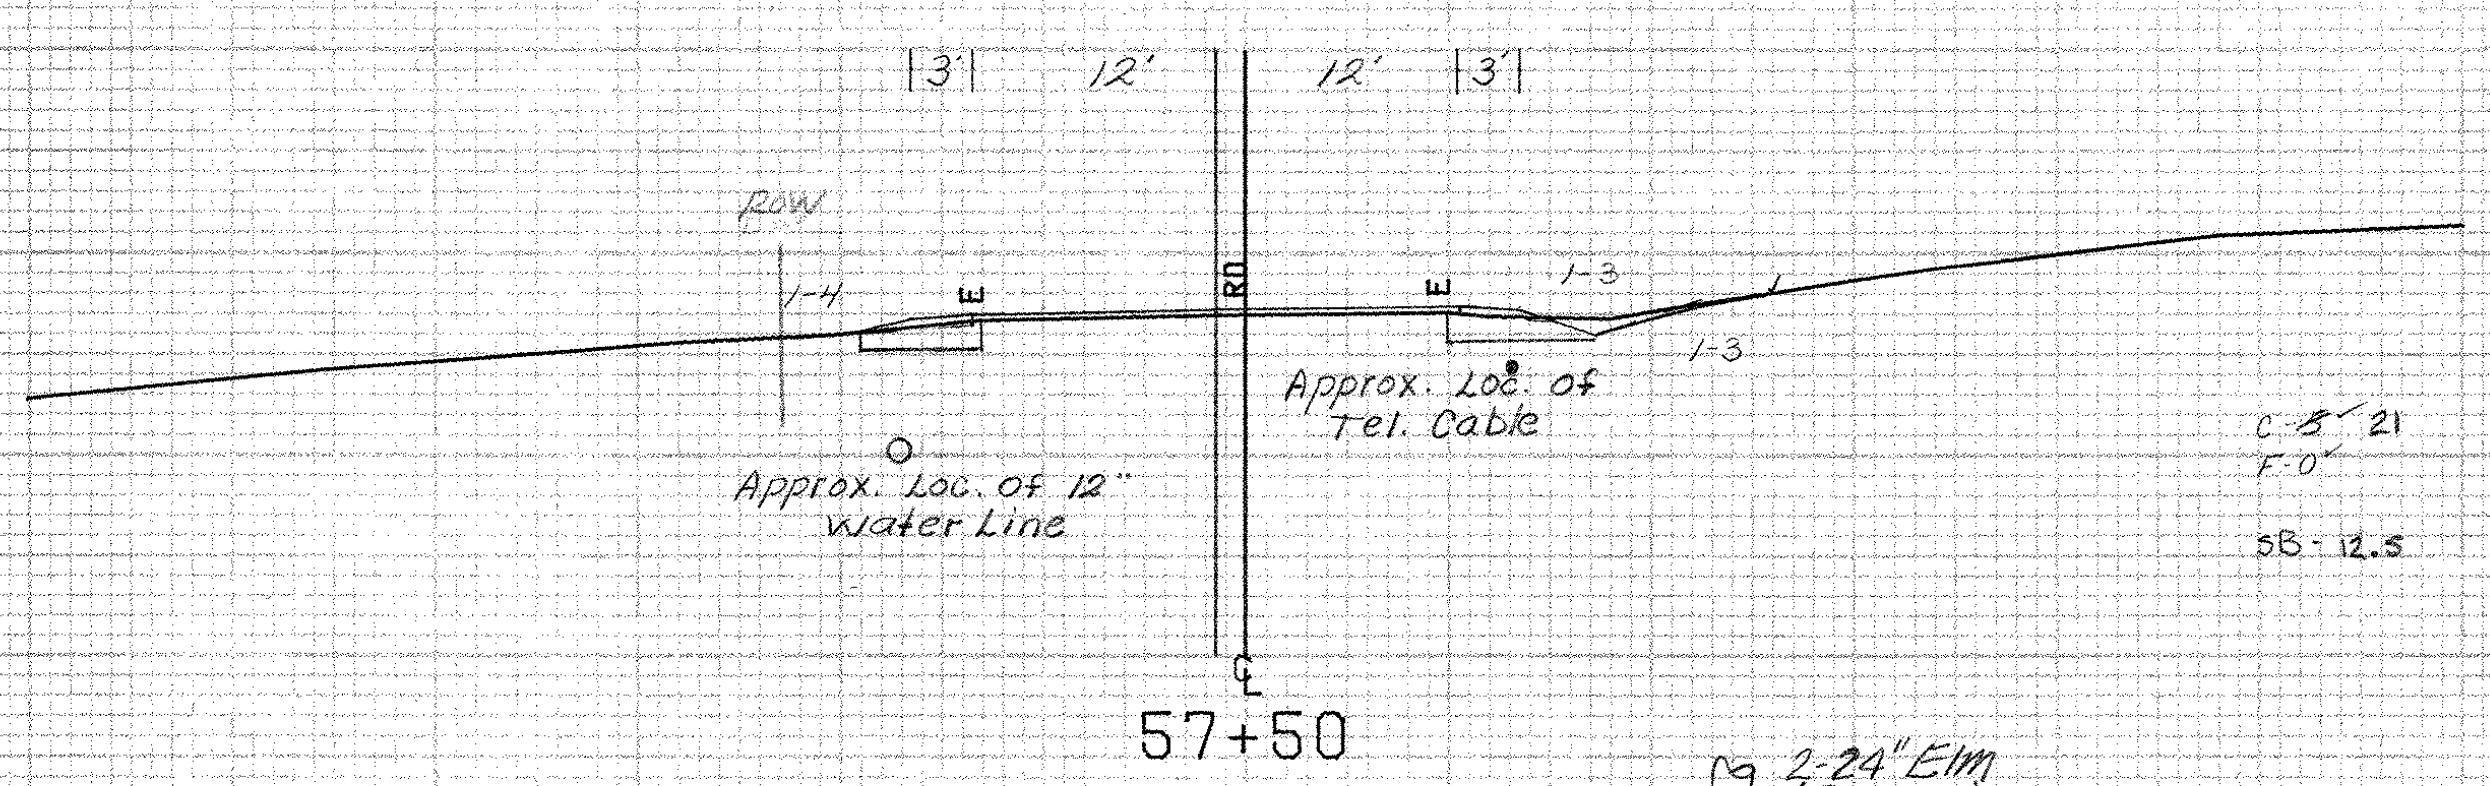

C. 3 21
F. 0
SB-12.5

500

2-24" Elm
(Remove)
+11

SHOREHAM MM 4.61 - MM 4.74

FROM STA.	57+50	TO STA.	58+50
PROJECT NAME	SHOREHAM-BRIDPORT-ADDISON		
NO.	F017-1(2)	PLOTTED	01/16/85
SURVEYED BY	FANTONI	DEC	1984
SHEET	268	OF 420 SHEETS	SHEET 268 OF 477

SCALE 1" = 10 FEET