
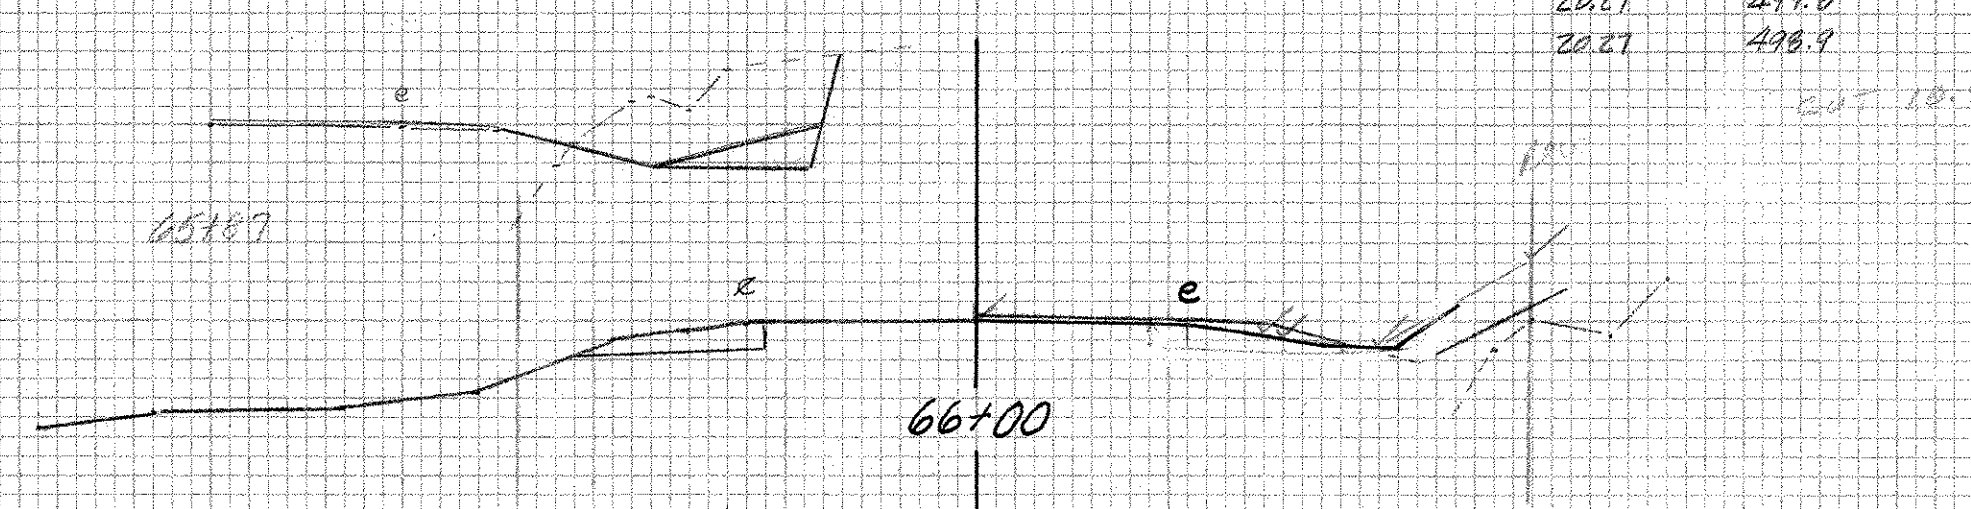
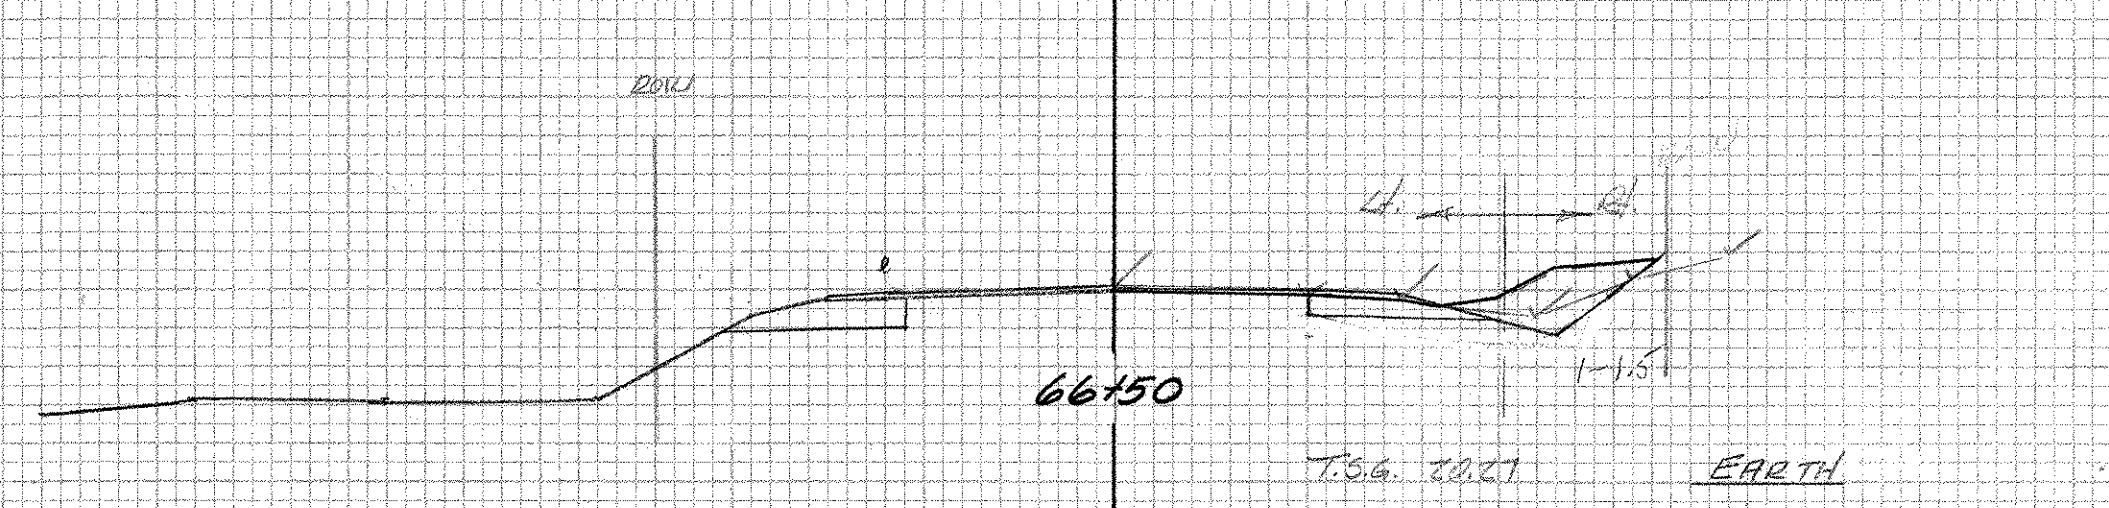
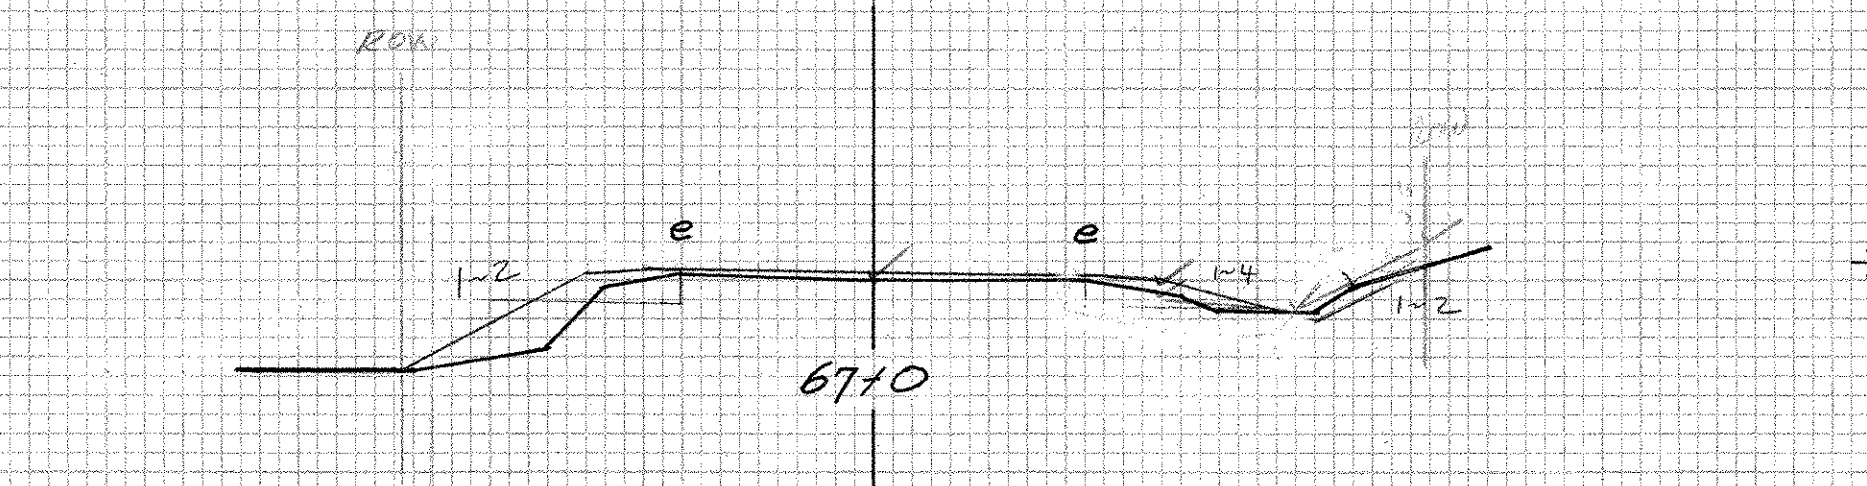
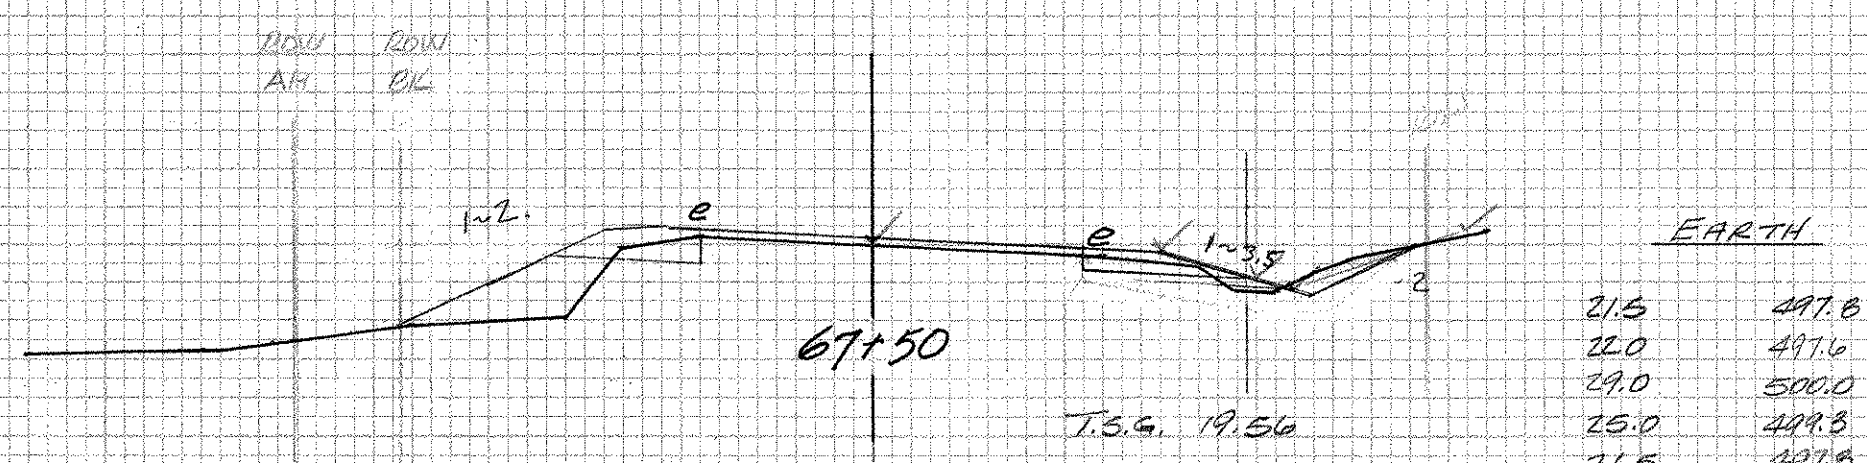
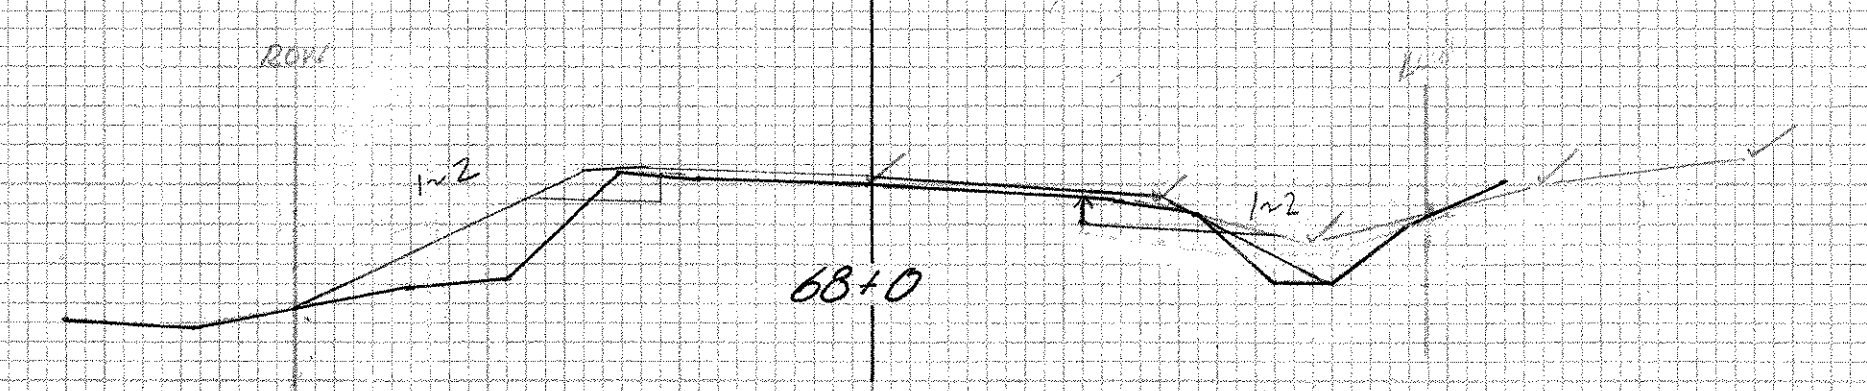
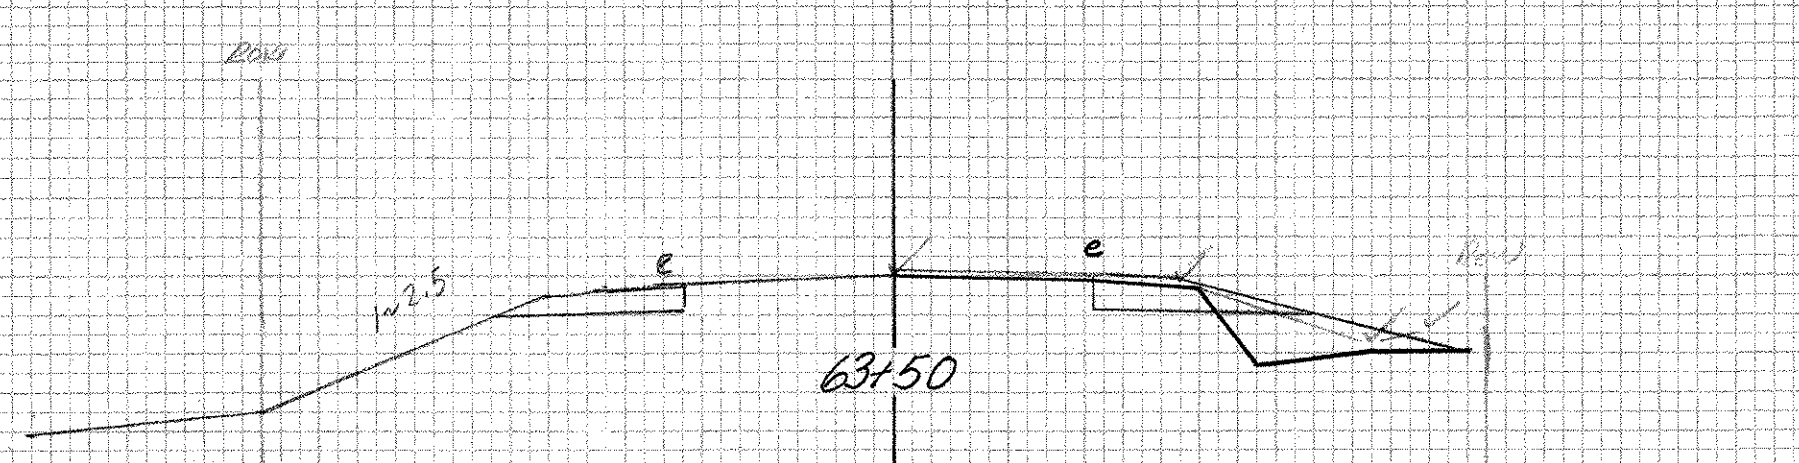
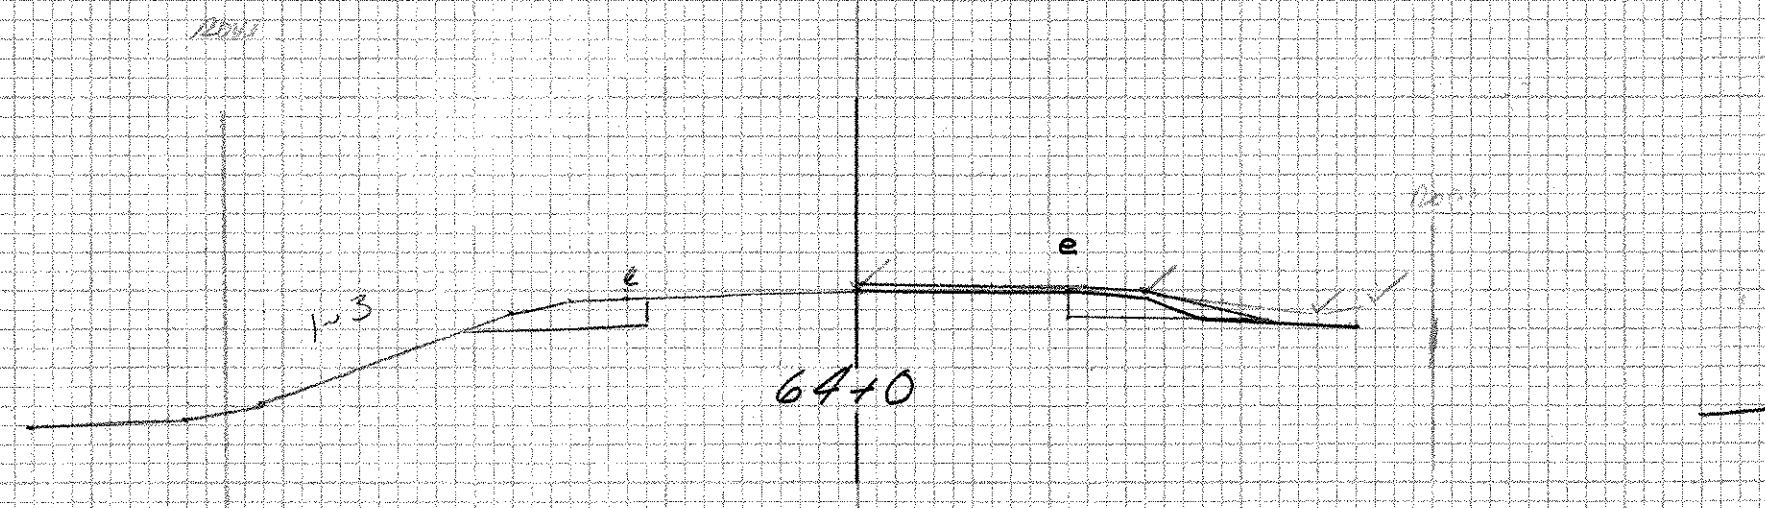
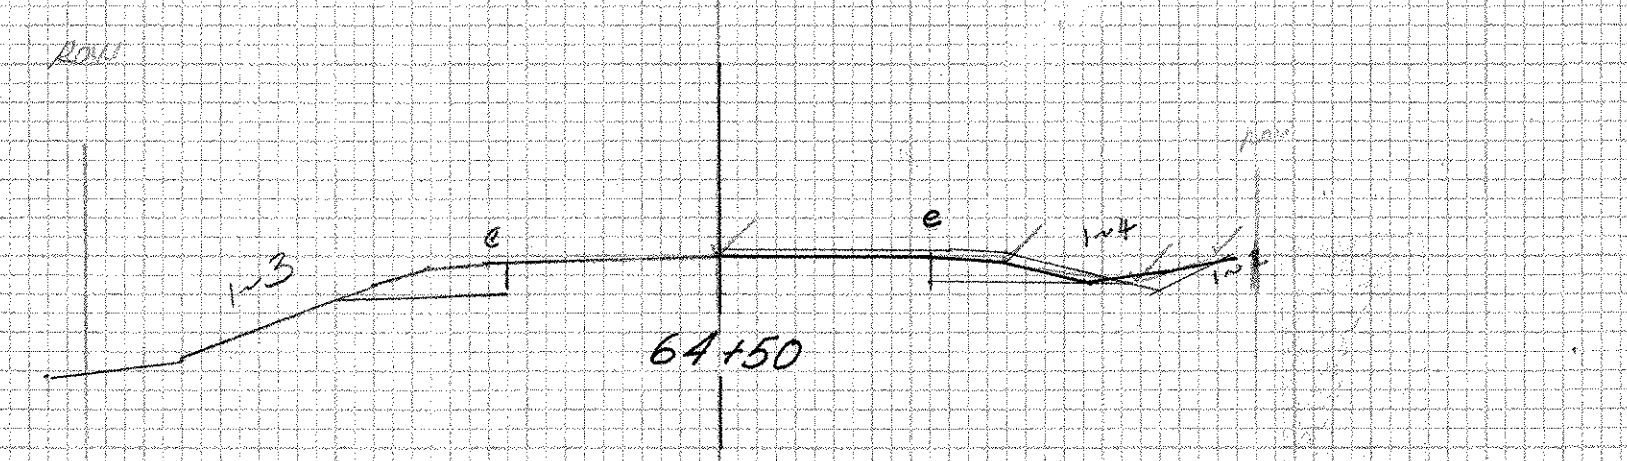
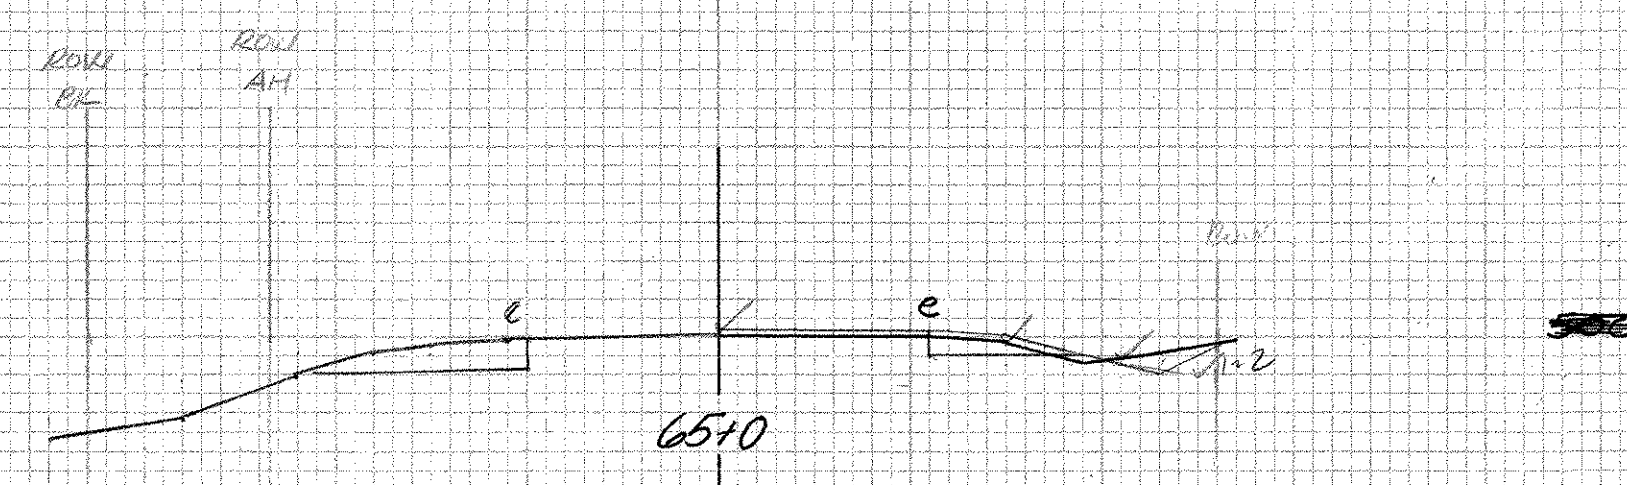
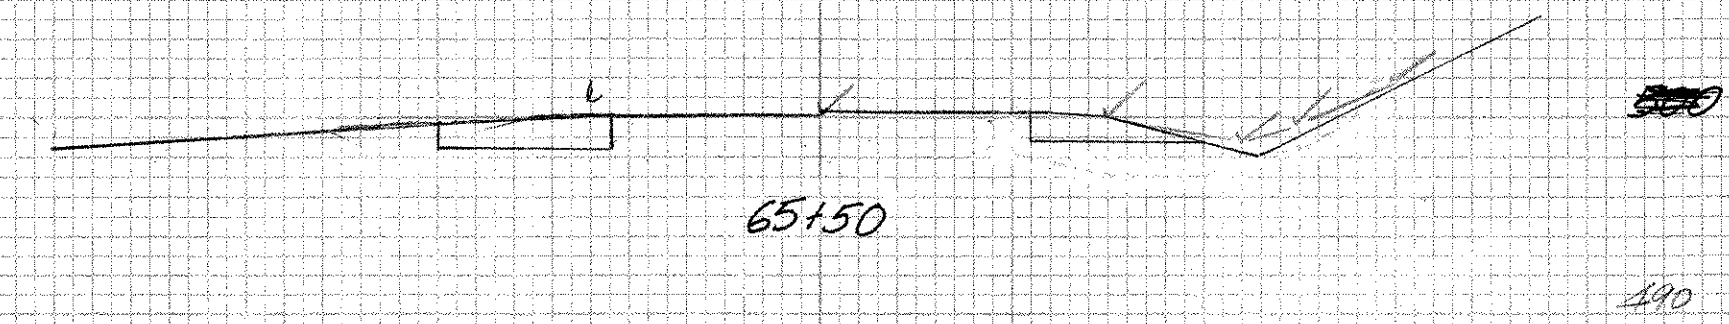
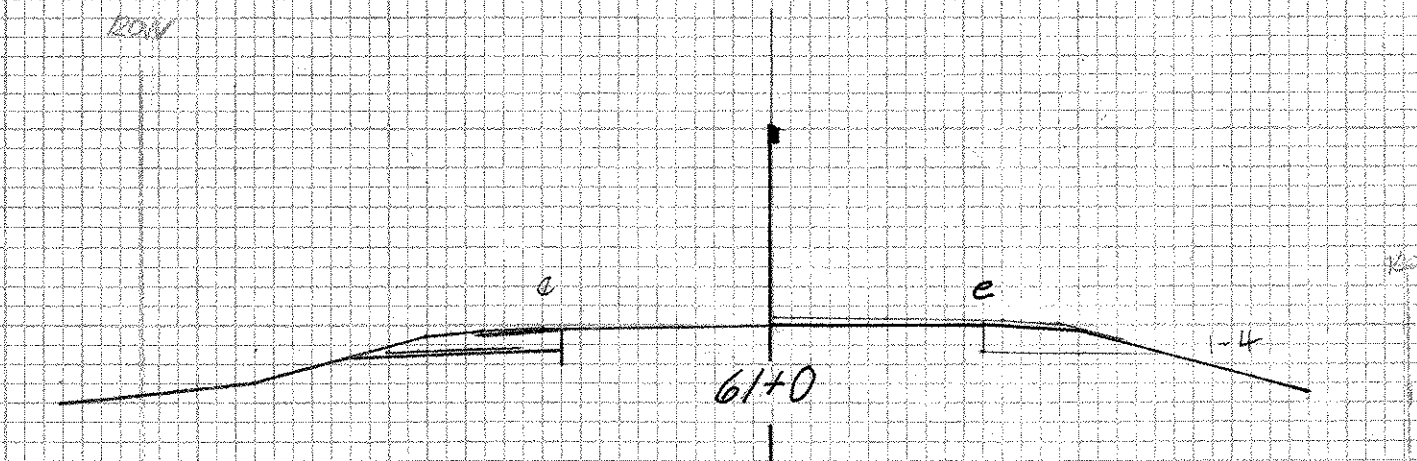
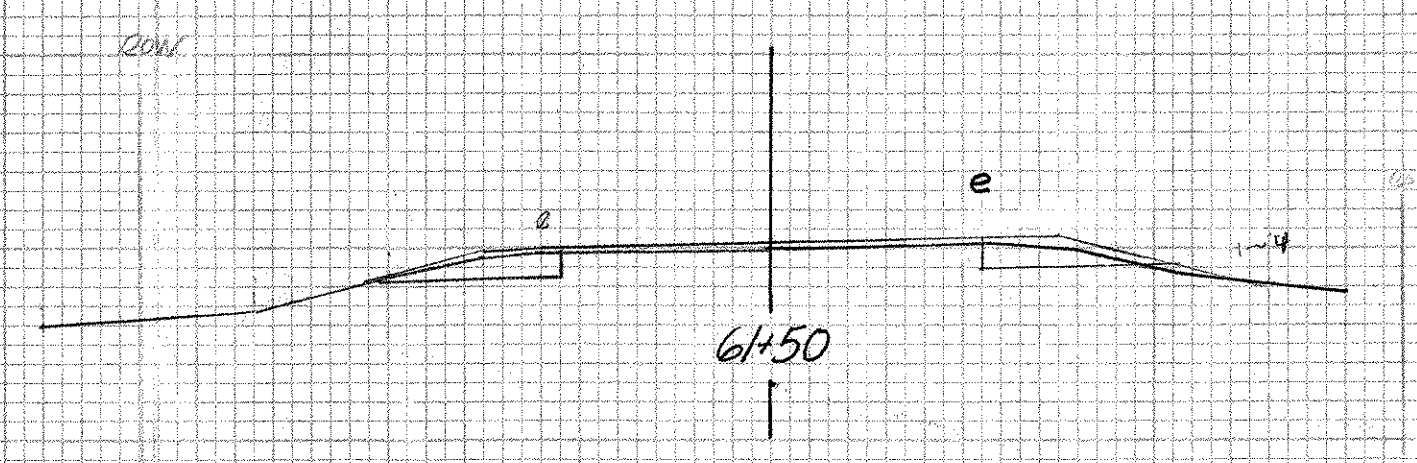
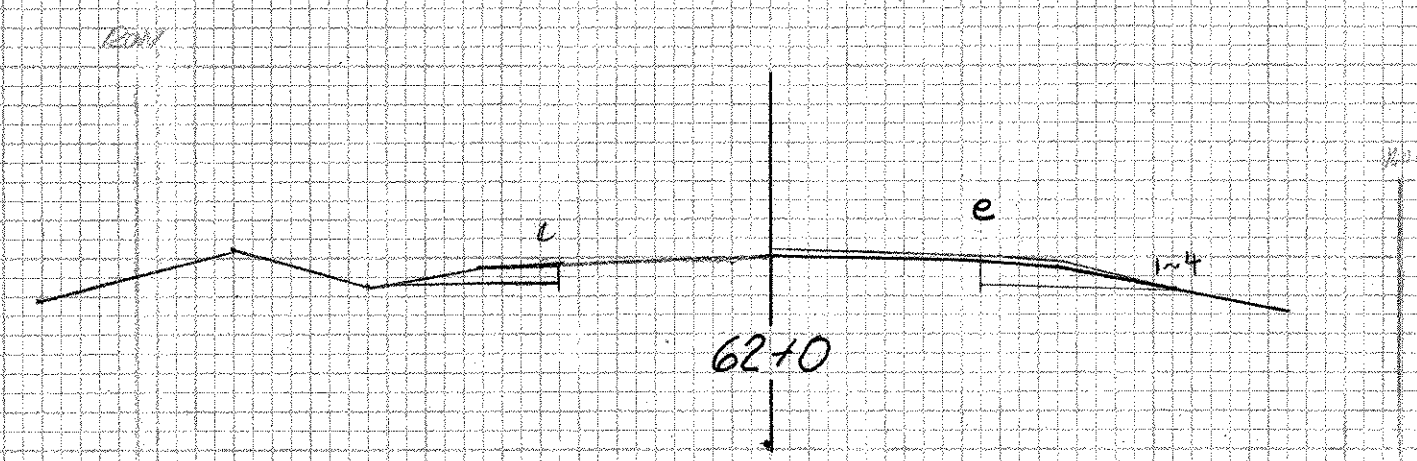
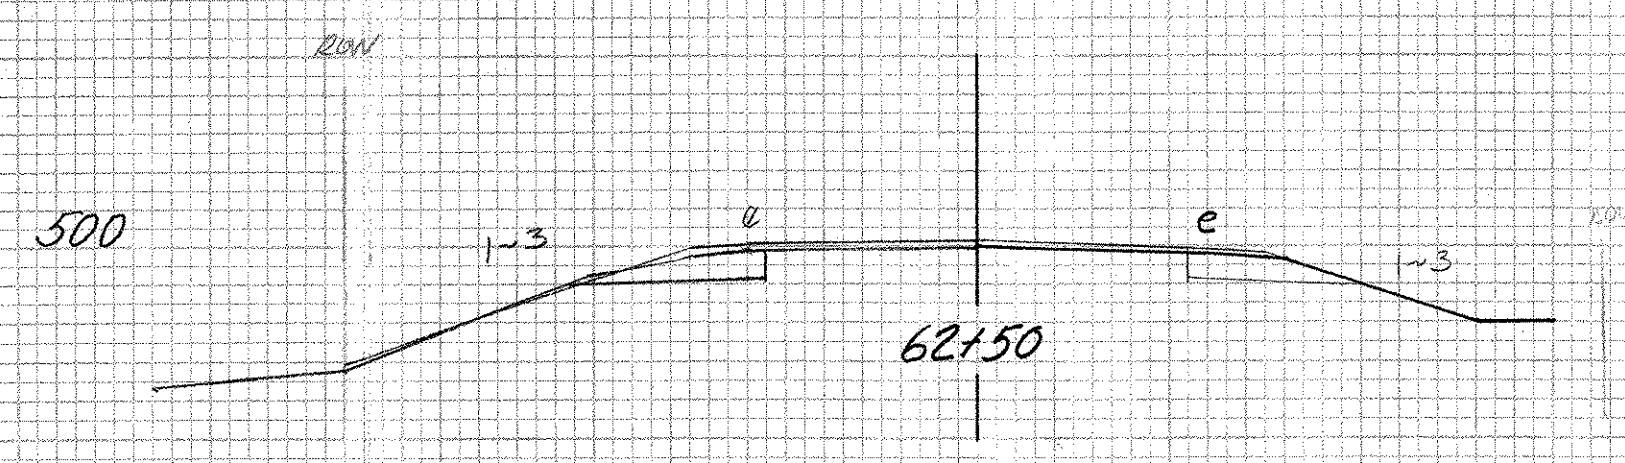


FINAL SURVEY	SURVEYED	DATE
	PLOTTED	BY
	TEMPLATE	
	NOTE BOOK	
No.		

ORIGINAL SURVEY	SURVEYED	DATE
	PLOTTED	BY
	TEMPLATE	
	NOTE BOOK	
No.		

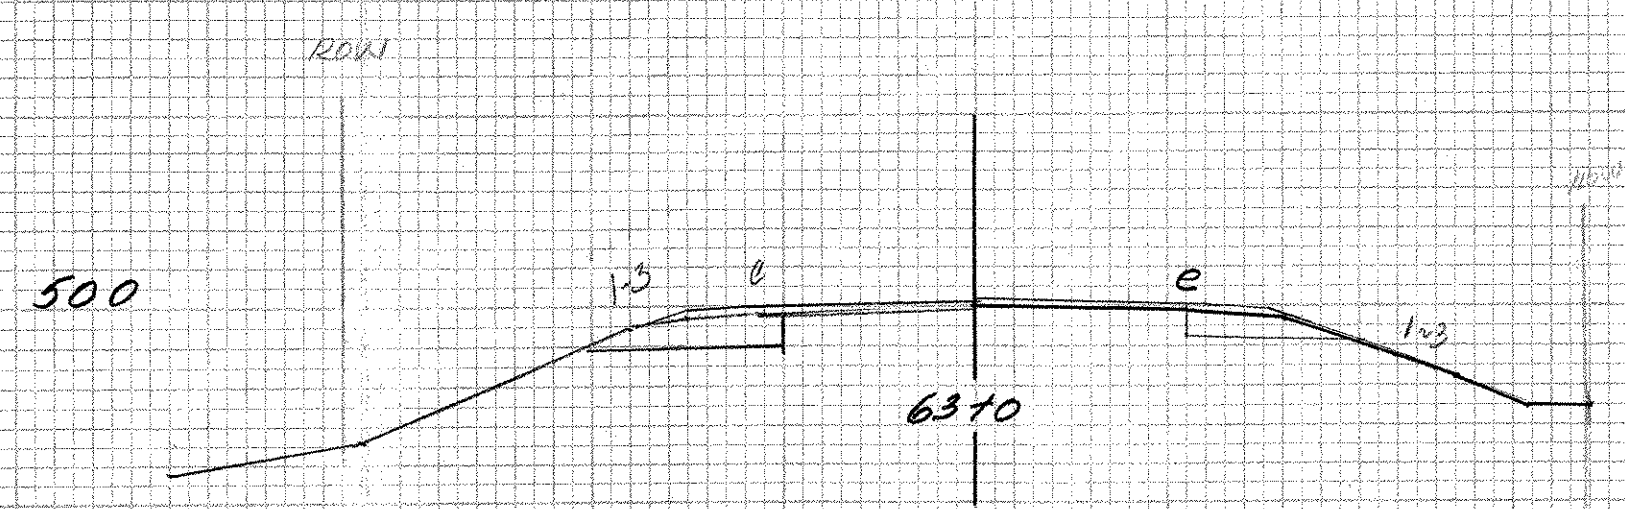

EARTH

21.5	497.6
22.0	497.6
23.0	500.0
25.0	499.3
21.5	497.6
3.08	

EARTH

22.27	498.9
22.0	498.6
27.0	500.6
23.0	501.7
23.0	501.1
22.27	498.6
22.27	498.9
CUT 12.5	

SHOREHAM BRIDGE ROAD
FOIT 1(2)
61+0 = 68+0