

STA 75+00

C = 5 + 1 = 12  
F = 0  
SB = 11.5



EARTH	
20.86	502.4
23.0	502.4
31.0	504.0
22.0	504.4
20.86	503.7
20.86	502.4

CUT 18.86

500

Note: All Ledge To Be Paid For As Solid Rock Excavation


74+00 ~ 73+15 RT  
Ditch Cleaning - (All Purpose Excavator Rental)

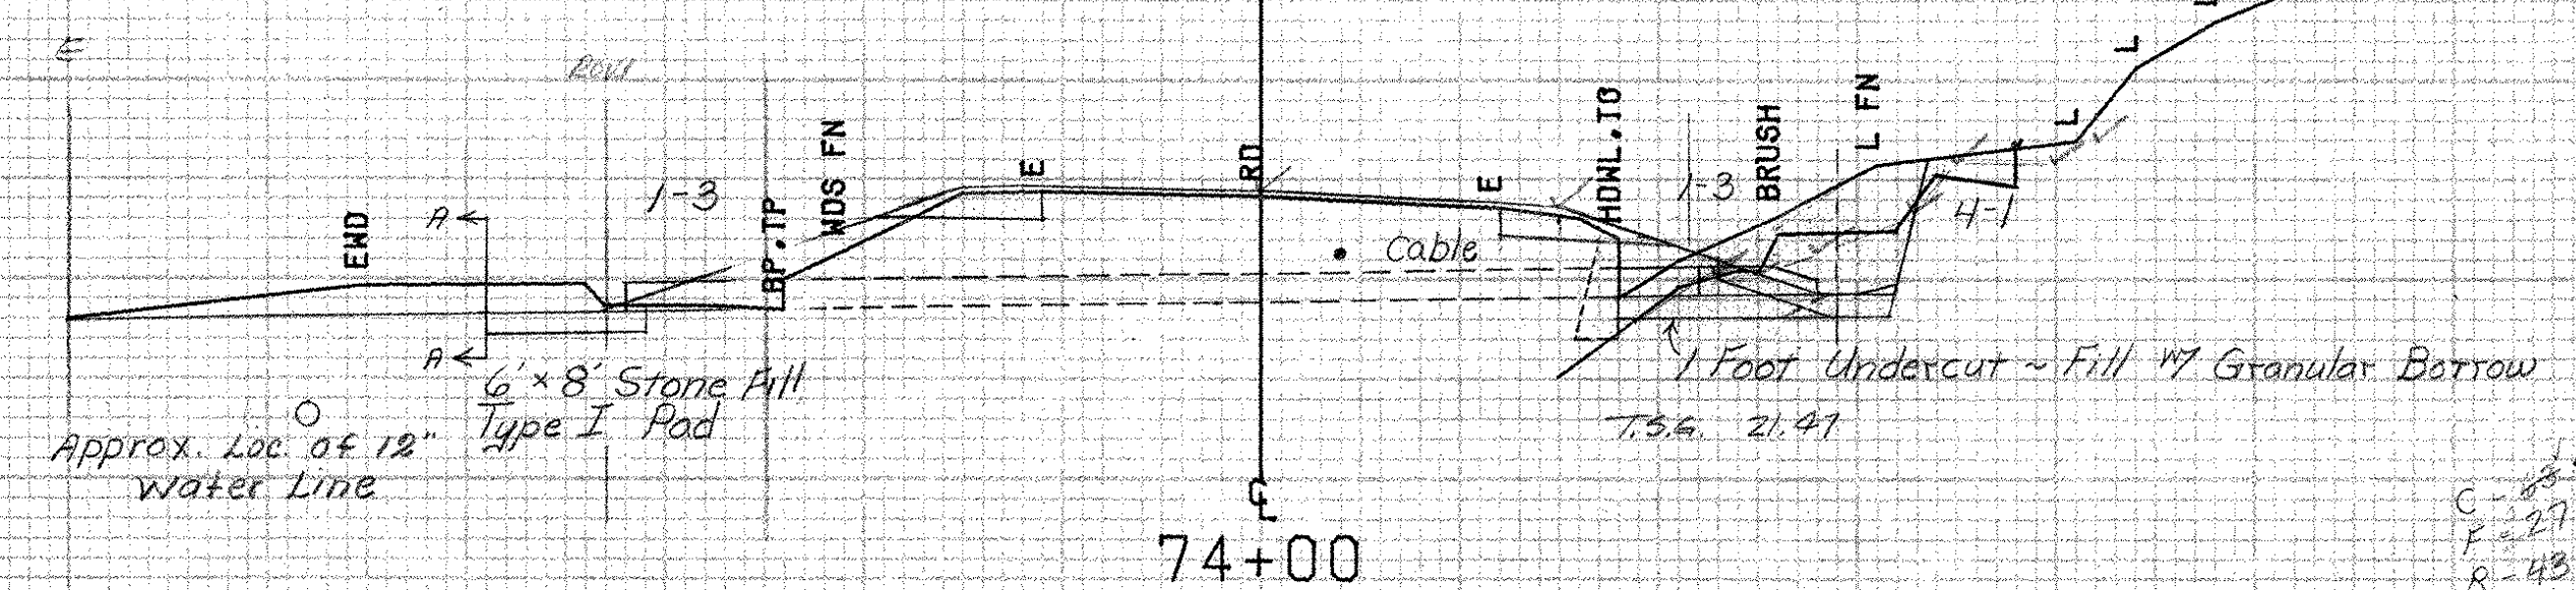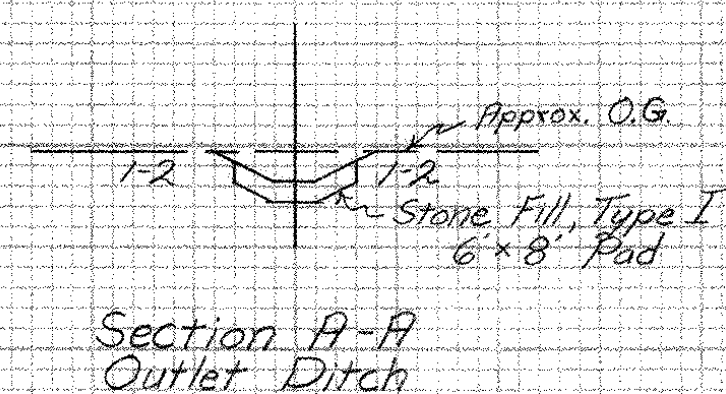

500

Existing 18" RCP ~ Retain & Remove Headwall at Inlet.  
Extend Inlet w/ New 18" x 4" RCP, Class III & New 18" RCP 2nd Section, Cl. III.  
Extend Outlet w/ New 18" x 8" RCP, Class III & Construct Outlet Ditch.

ROCK		EARTH	
20.6	442.1	21.47	444.1
36.7	442.2	24.0	501.5
33.3	504.0	26.0	501.6
32.0	502.3	26.0	502.3
26.0	502.3	33.5	504.0
25.0	501.5	31.0	503.8
23.0	501.5	21.47	501.6
21.0	489.5	21.47	501.6
20.6	489.5	21.47	501.6

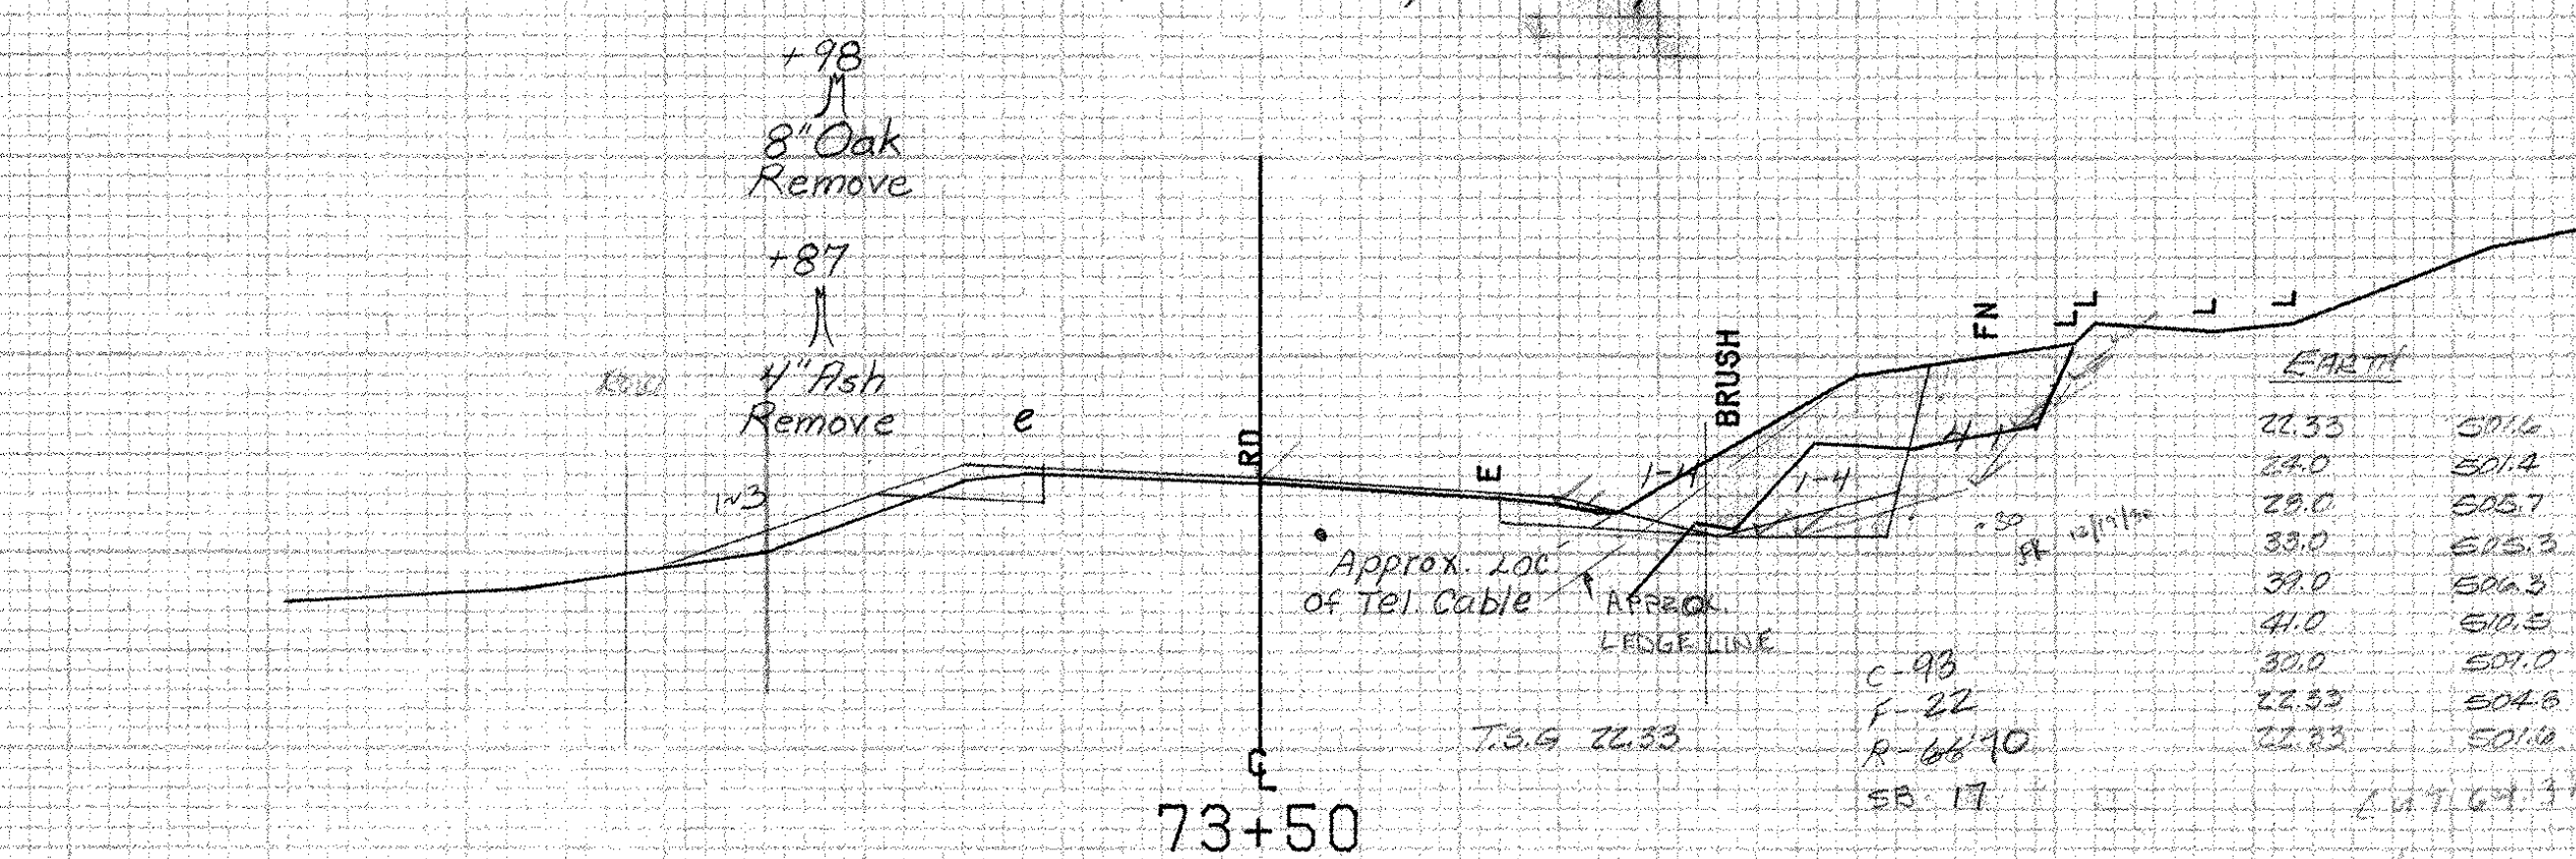

ROCK	
22.33	501.6
24.0	501.4
28.0	505.7
33.0	505.3
37.0	506.3
41.0	501.3
30.0	501.0
22.33	504.6
22.33	501.9

500

73+75

LT PLOTTED 12/14/90

Plotted 12/13/90  
DECE

SCALE 1" = 10 FEET

SHOREHAM MAIN 4.91 ~ MAIN 5.00

FROM STA. 73+50	TO STA. 74+50
PROJECT NAME SHOREHAM-ADDISON MAIN4	
NO. F017-1(2)	PLOTTED 01/09/85
SURVEYED BY FANTONI	DEC 1984
SHEET 272 OF 420 SHEETS	SHEET 276 OF 471