

FINAL SURVEY NOTE BOOK No. _____

DATE _____

BY _____

REVIEWED _____

PLOTTED _____

TEMPERATURE _____

AREAS CHECKED _____

ORIGINAL SURVEY NOTE BOOK No. _____

DATE _____


BY _____

REVIEWED _____

PLOTTED _____


TEMPERATURE _____

AREAS CHECKED _____

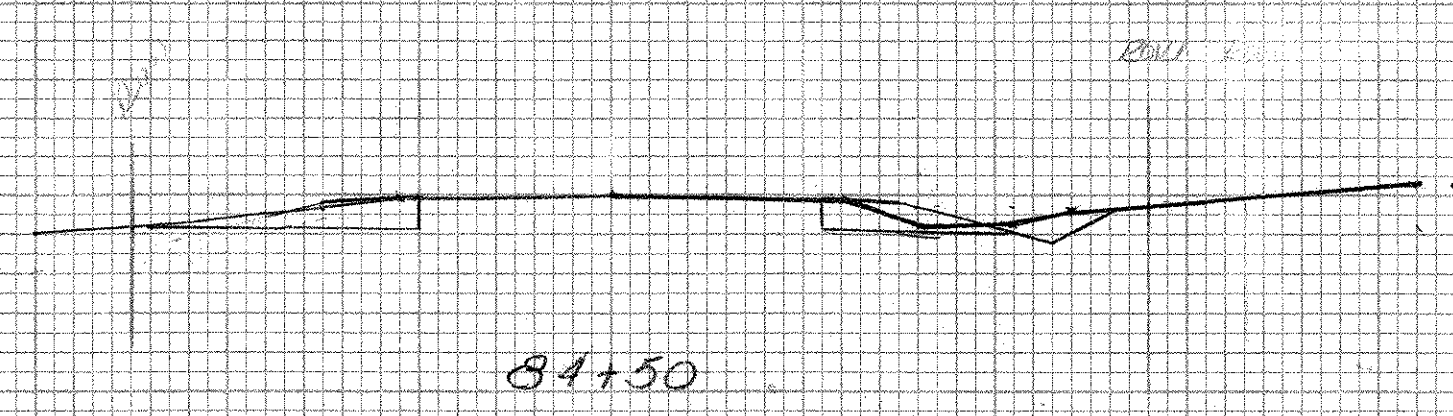


EARTH

21.0	499.0
22.0	496.7
24.0	494.0
30.0	500.5
33.0	494.4
21.0	499.0

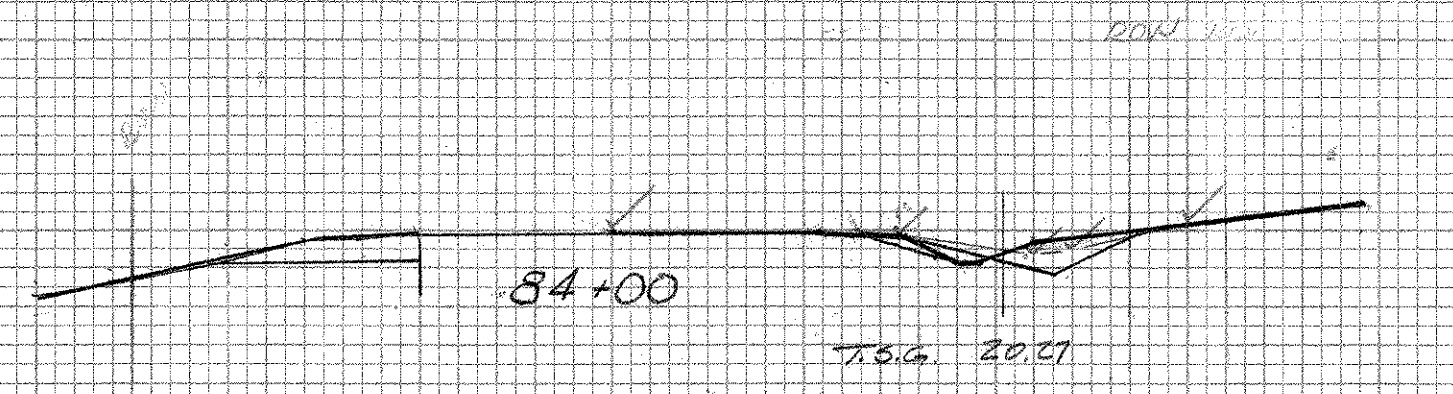


EARTH

20.27	496.0
25.0	496.7
30.0	500.5
20.0	500.0
20.27	496.0

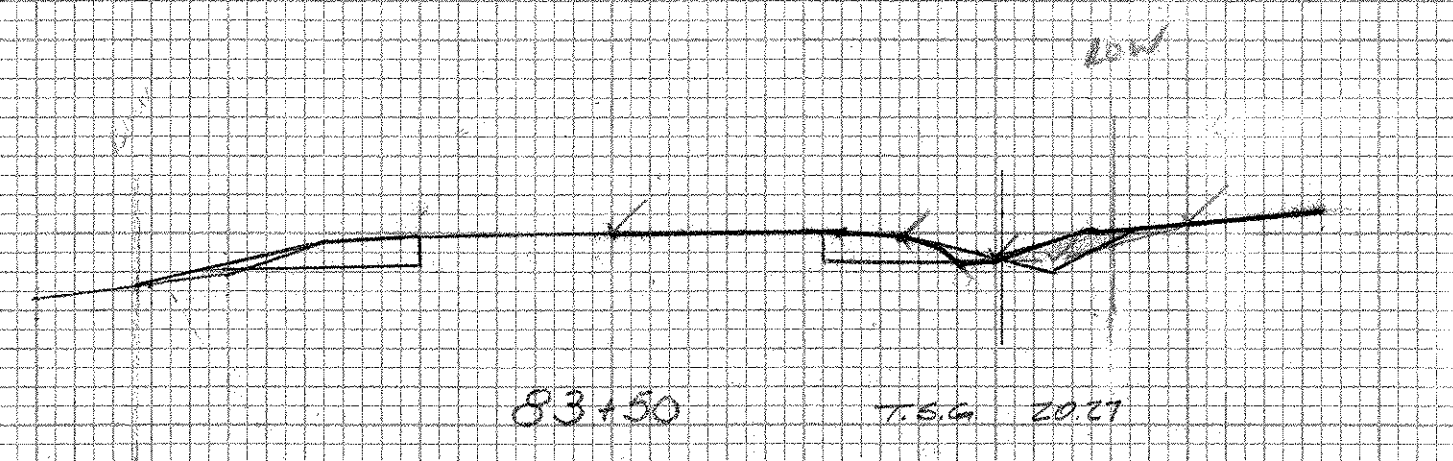

EARTH

20.27	494.0
23.0	499.0
24.0	500.0
35.0	502.5
27.0	500.0
20.27	494.0
20.27	499.0

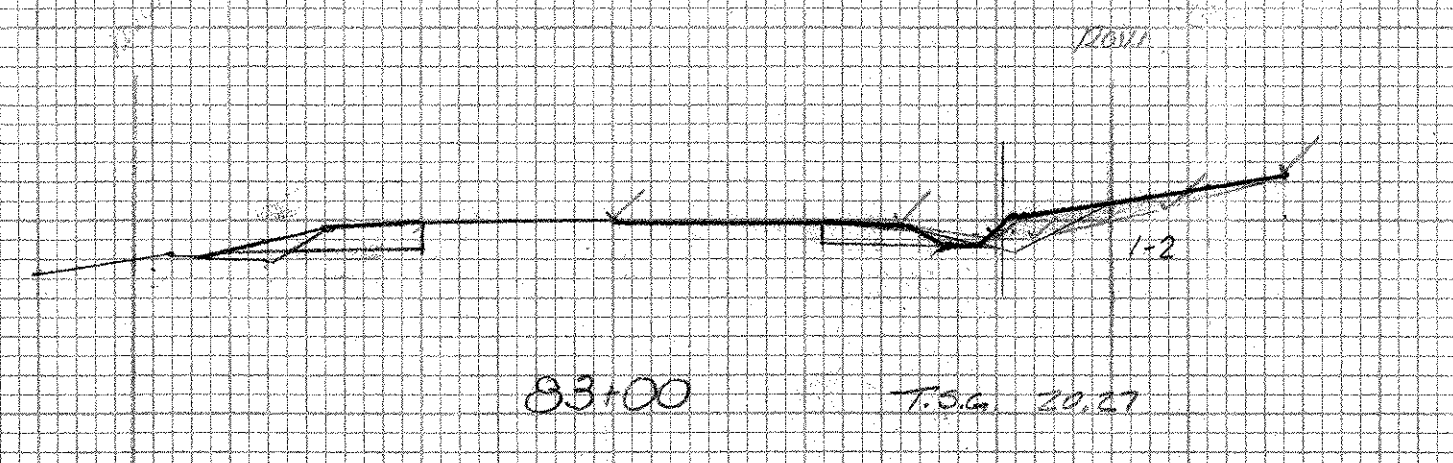

EARTH

20.27	496.6
24.0	498.0
29.0	501.6
26.0	500.0
28.27	497.5
20.27	496.6

