
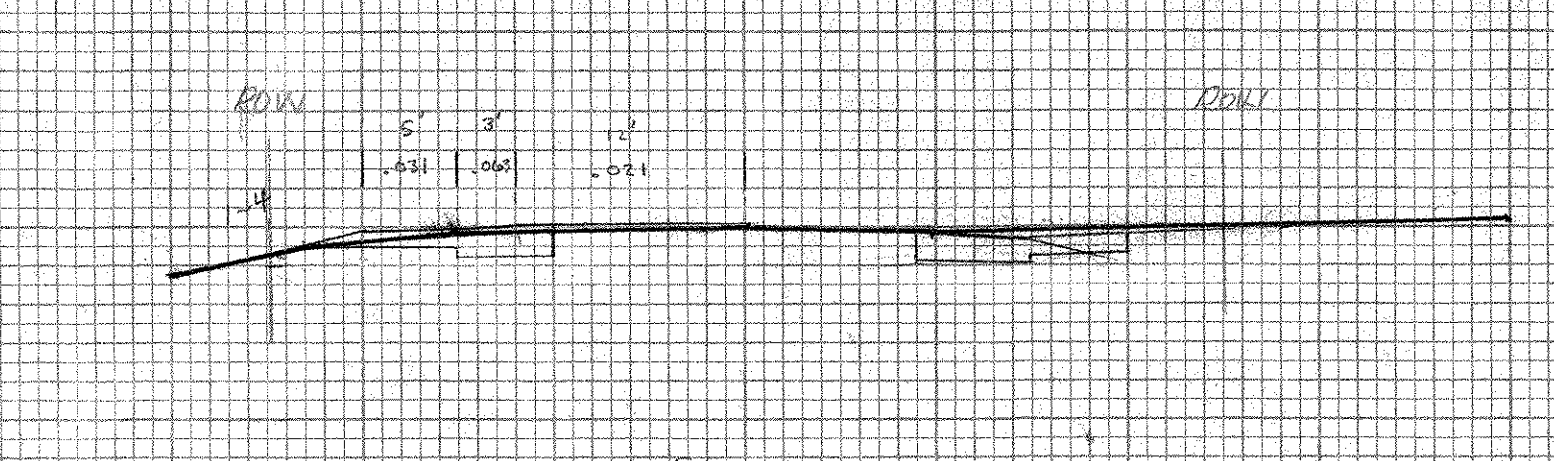
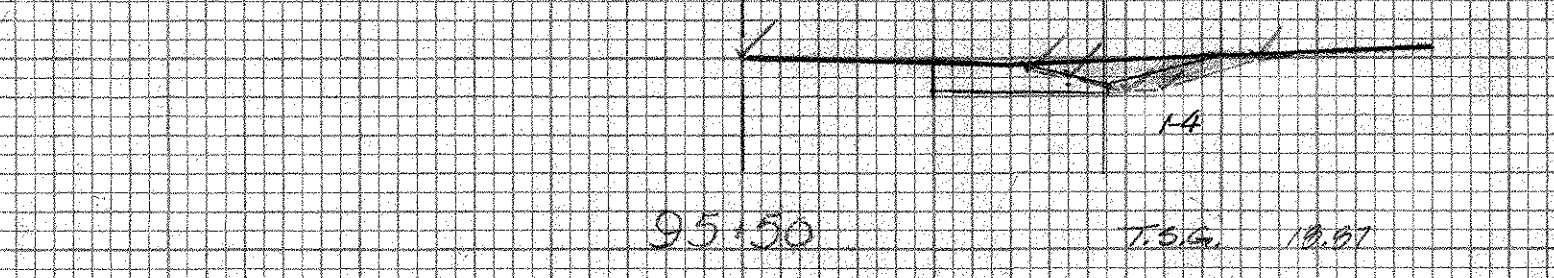
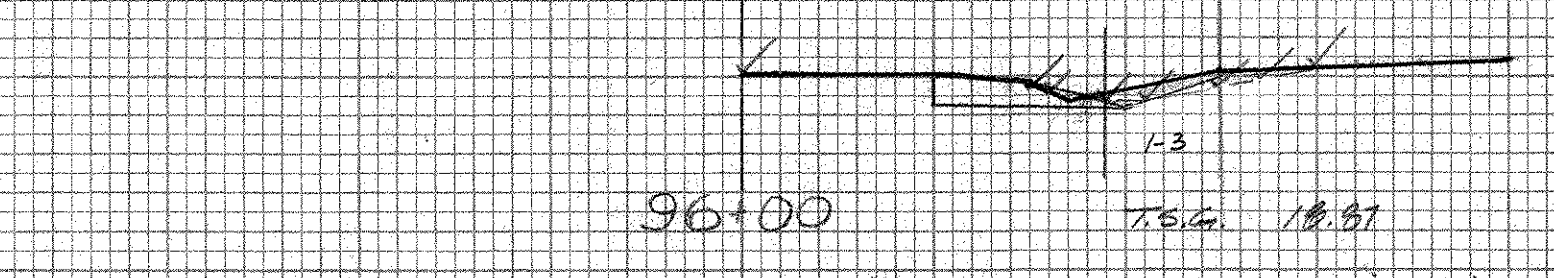
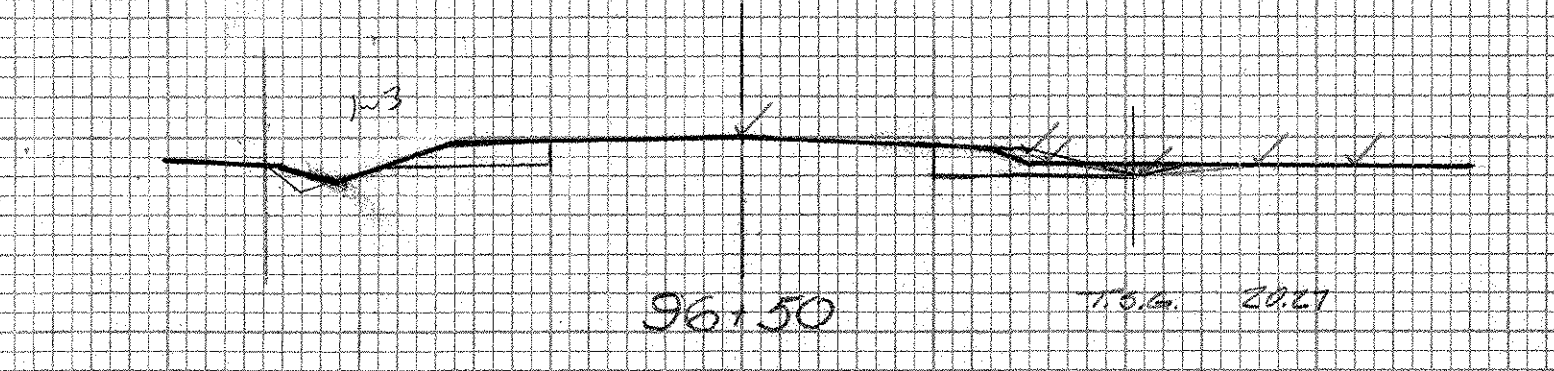
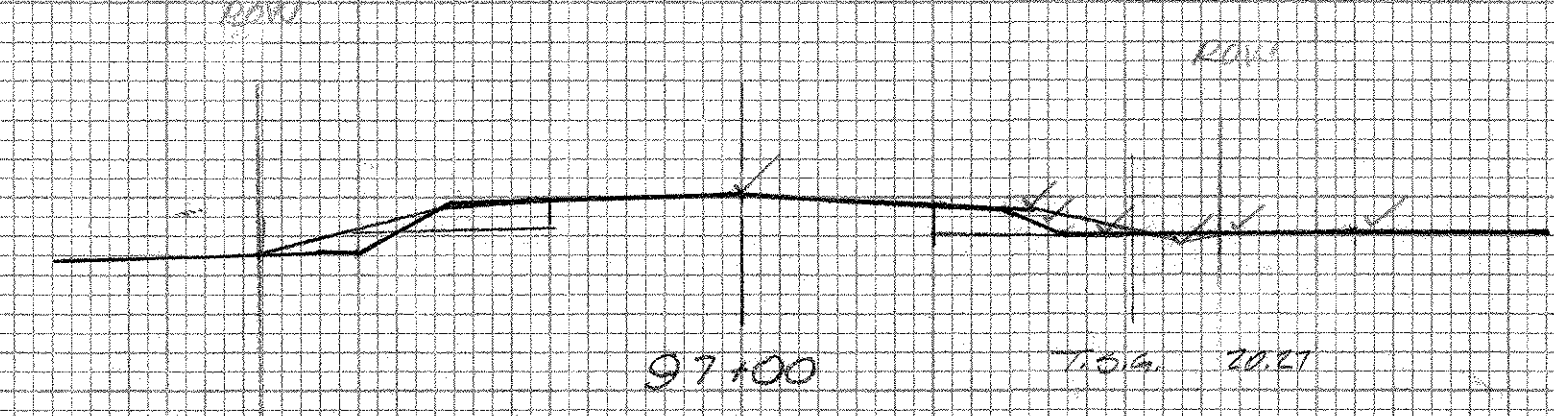
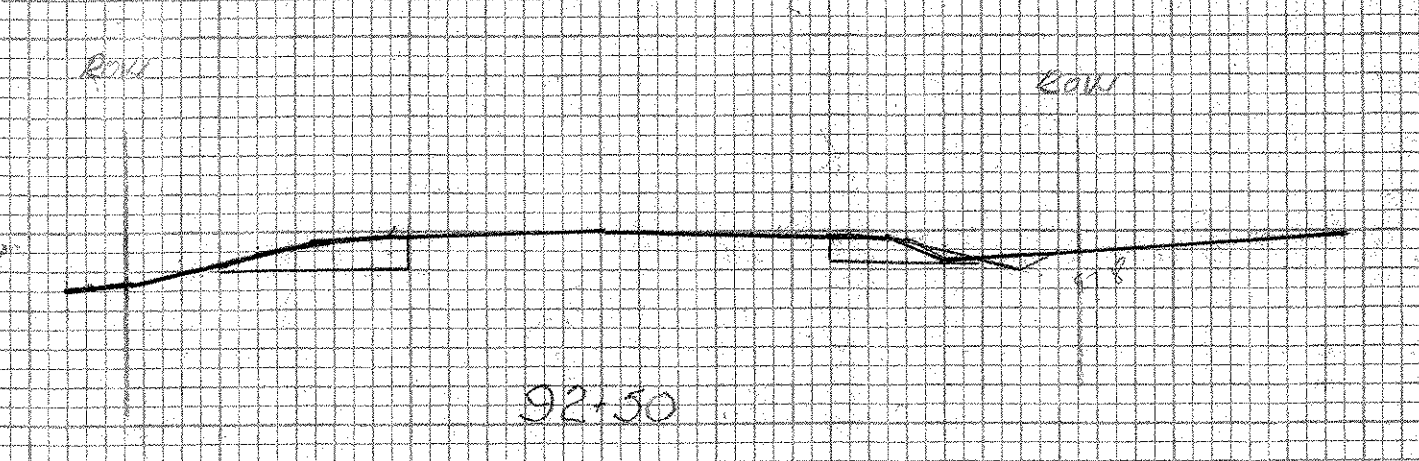
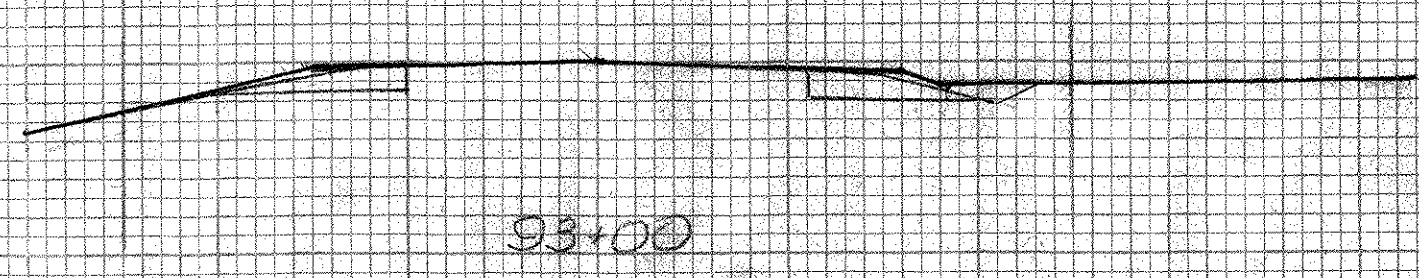
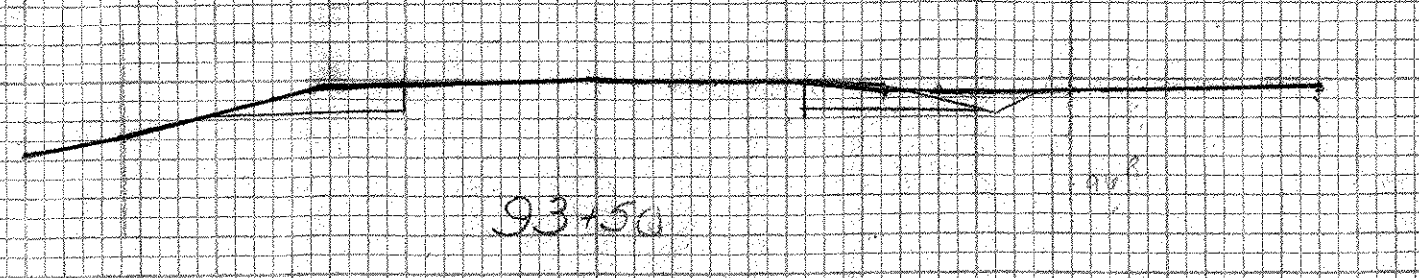
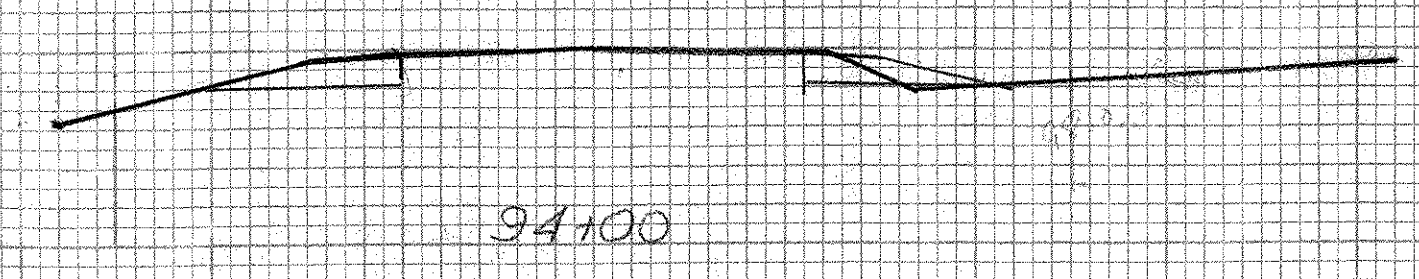


FINAL SURVEY NOTE BOOK No. \_\_\_\_\_  
 SURVEYED BY \_\_\_\_\_  
 DATE \_\_\_\_\_

ORIGINAL SURVEY NOTE BOOK No. \_\_\_\_\_  
 SURVEYED BY \_\_\_\_\_  
 DATE \_\_\_\_\_

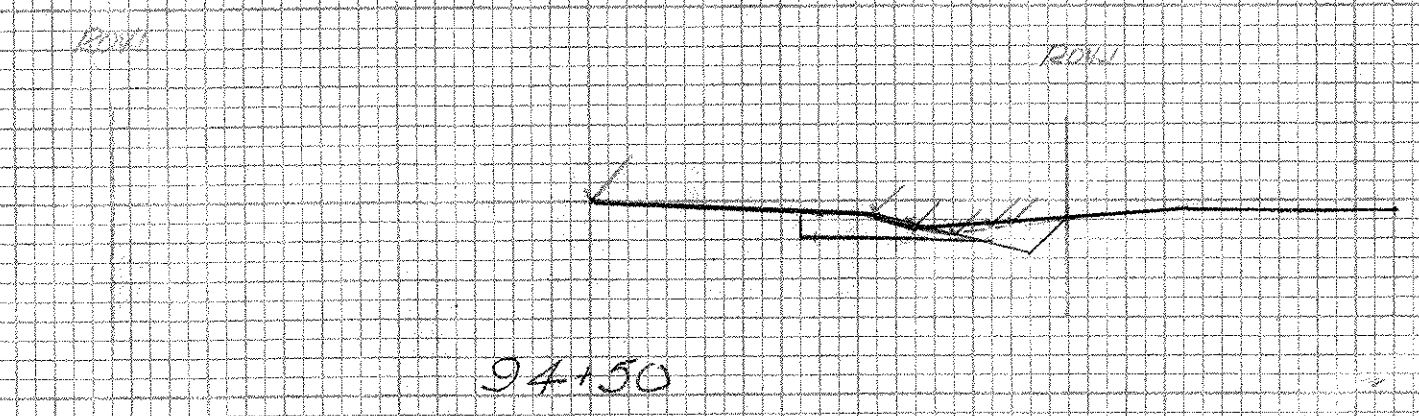

EARTH

21.5	418.0
23.0	419.0
24.5	420.0

EARTH

20.0	416.1
21.0	417.4
22.0	418.4
23.0	418.1



EARTH

18.87	415.3
21.0	416.5
23.0	417.5
27.0	417.3
30.0	417.5
45.0	417.5
18.87	417.3
18.87	418.3

EARTH

18.87	417.1
22.0	418.0
27.0	418.4
27.0	418.3
18.87	417.7
18.87	417.1

MAIL BOX TURN OUT (N.T.S.)

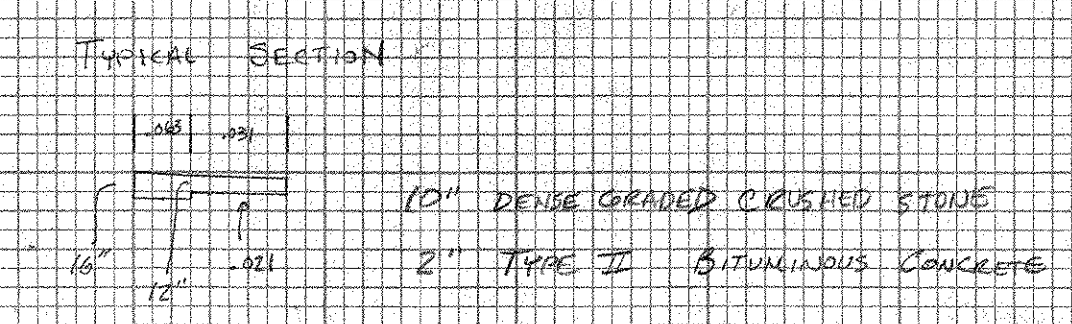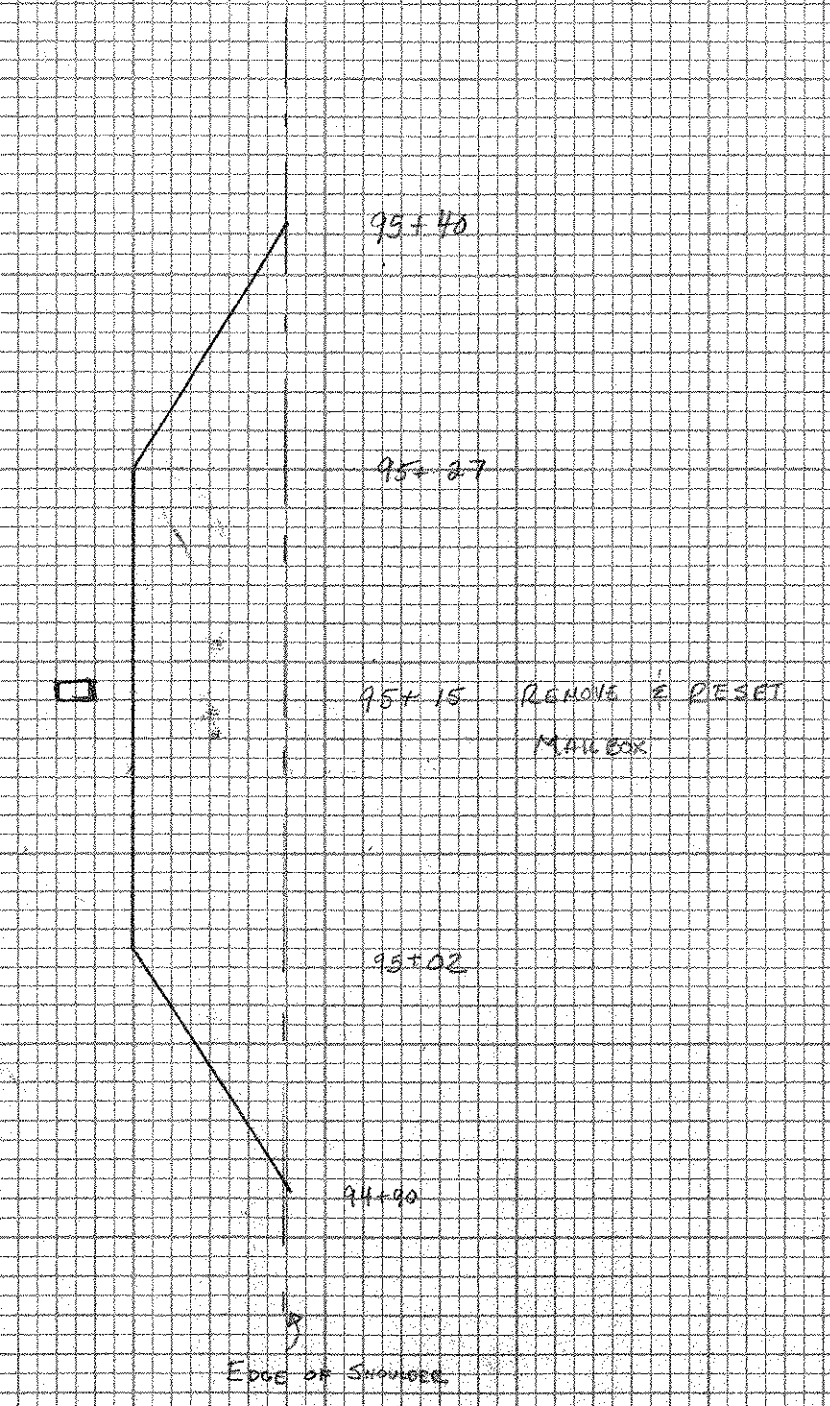

94+95 ~ 95+40  
CONCRETE TURNOUT LEFT  
SEE DETAIL ON RIGHT

SHOREHAM-BRIDPORT-ADDISON

FOIT-112  
92+50 ~ 97+00  
Original Sections