


201

FINAL SURVEY NOTE BOOK No. _____	BY _____	DATE _____
EMPLOYED _____	PLOTTED _____	DATE _____
AREA CHECKED _____	AREA CHECKED _____	AREA CHECKED _____

ORIGINAL SURVEY NOTE BOOK No. _____	BY _____	DATE _____
EMPLOYED _____	PLOTTED _____	DATE _____
AREA CHECKED _____	AREA CHECKED _____	AREA CHECKED _____

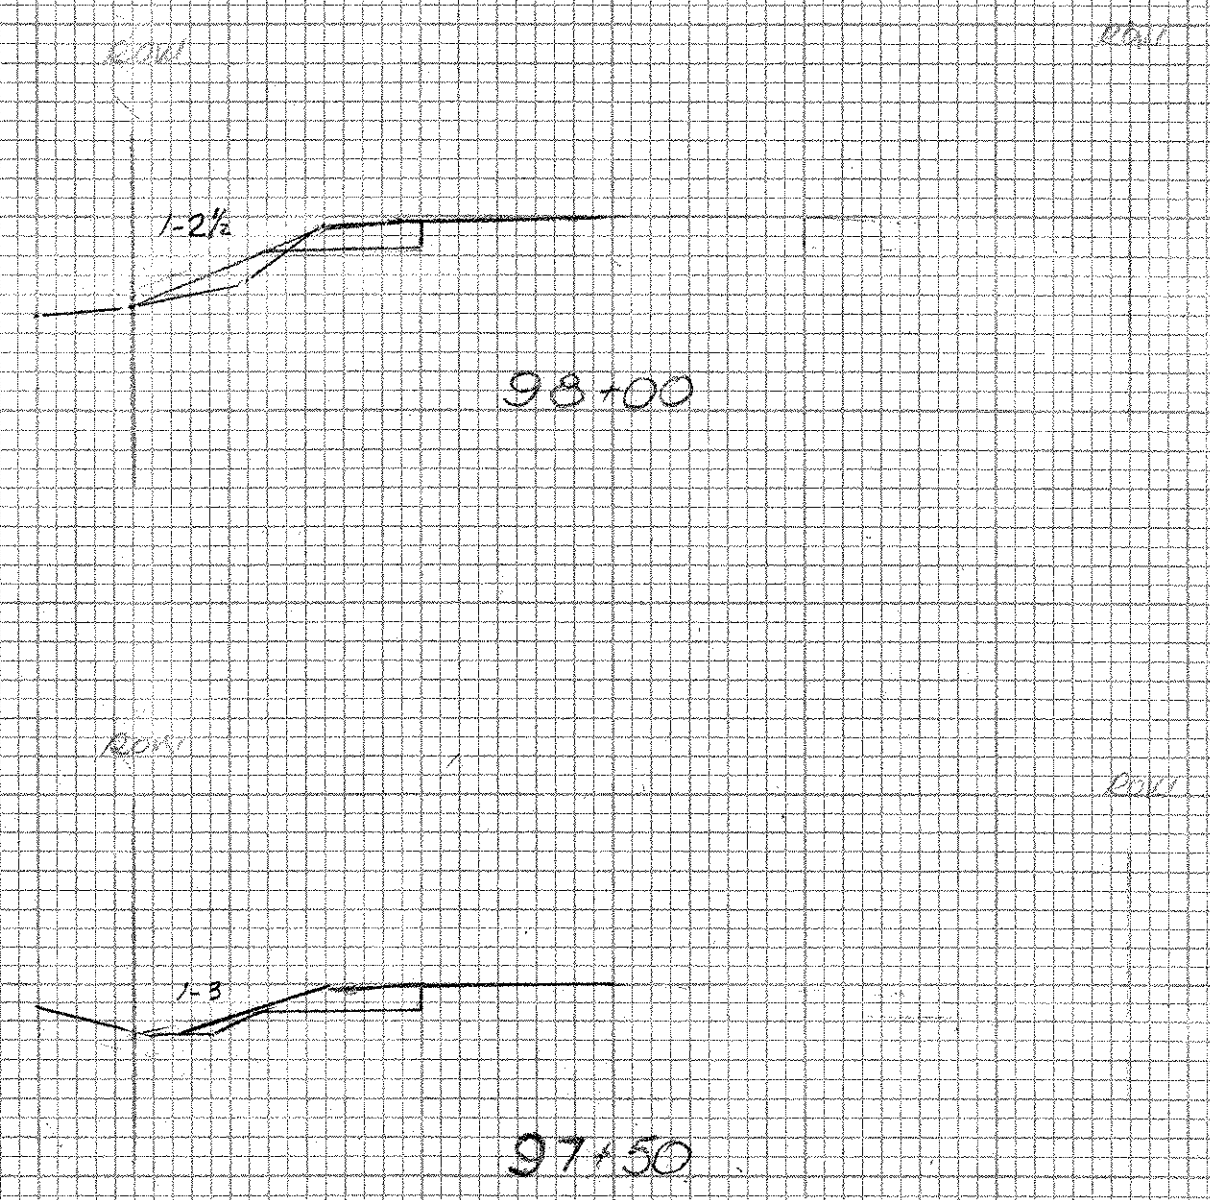

SHOREHAM-BRIDPORT-ADDISON
 F 017-1 (2)
 97+50 - 98+00
 Original Sections

2/12/50 J.M.M. R.E.S. 11

201