


NO.	DATE
BY	
CHECKED	
APPROVED	
SCALE	
PROJECT	
DATE	

NO.	DATE
BY	
CHECKED	
APPROVED	
SCALE	
PROJECT	
DATE	

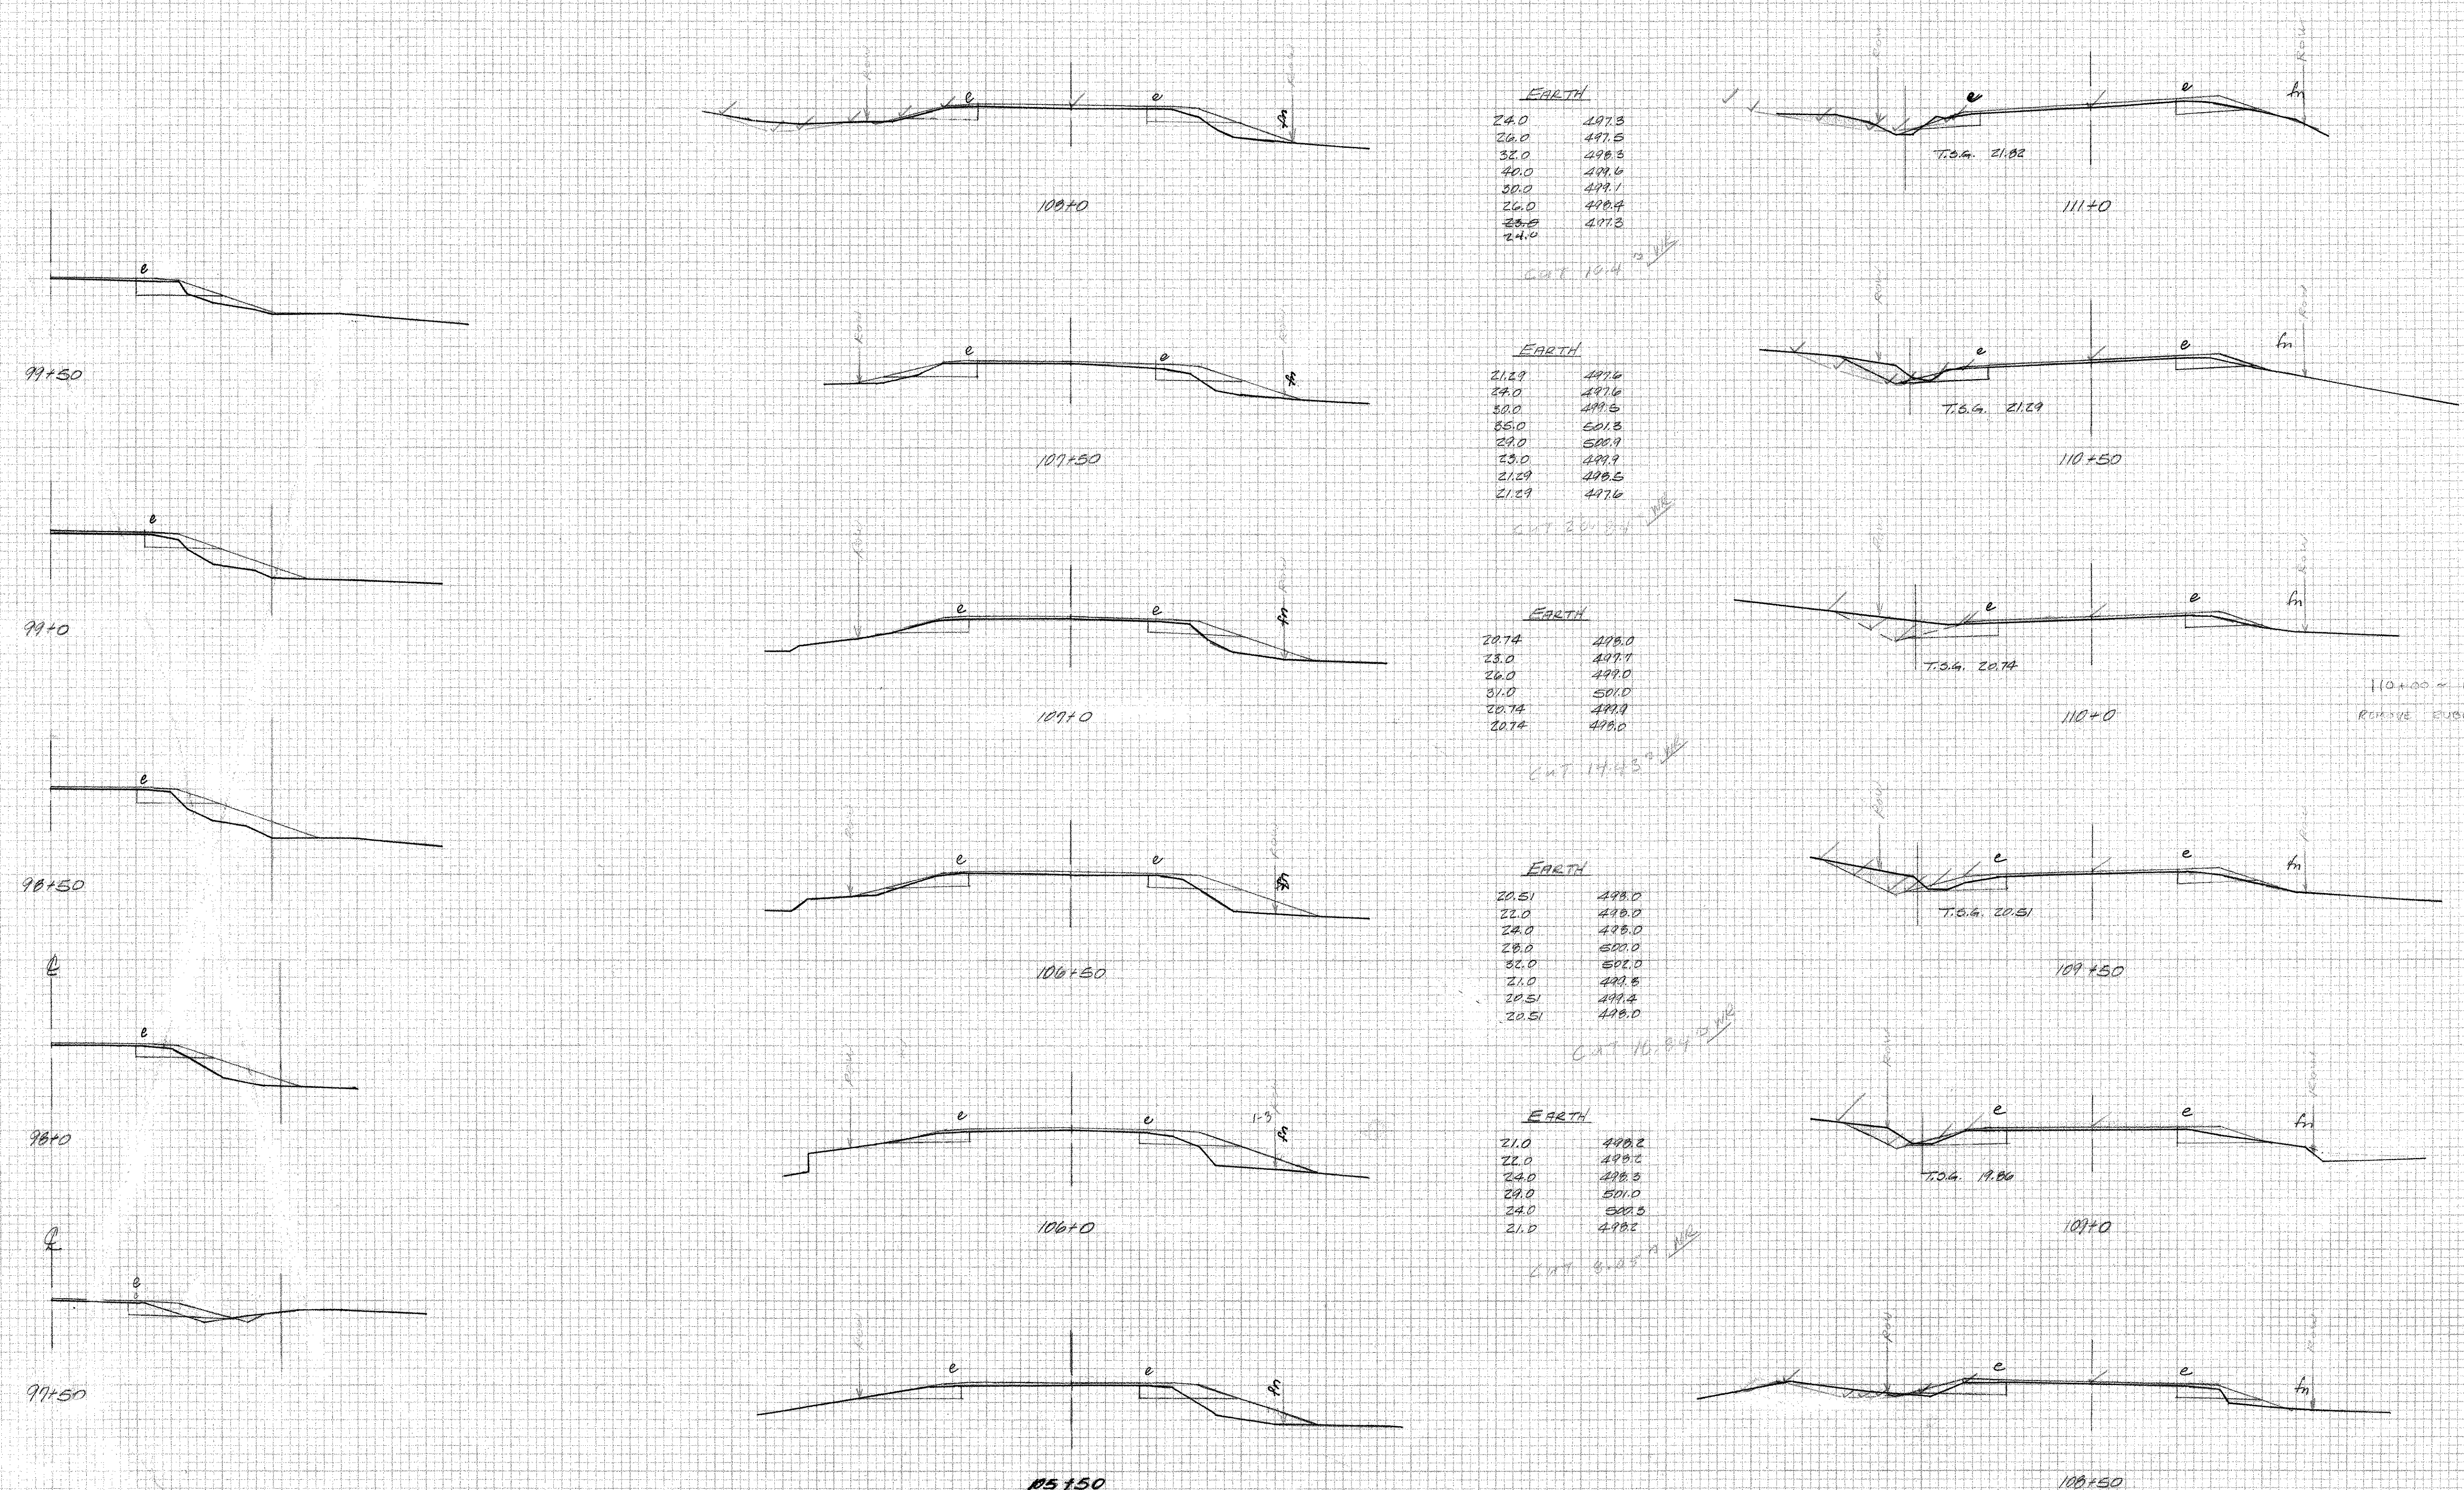

SHOREHAM-BRIDGPORT-ADDISON
 F 017-1(2)
 STA 97+50 - 99+50
 STA 105+50 - 111+0
 ORIGINAL SECTIONS 11-90