



101+20 ~ 101+42
 Conc. Slab C-C 1939 VR BR #17
 Remove Existing Structure

101+27
 New 7'-0" x 5'-1" x 94' CGMPPA
 (See BR 100)

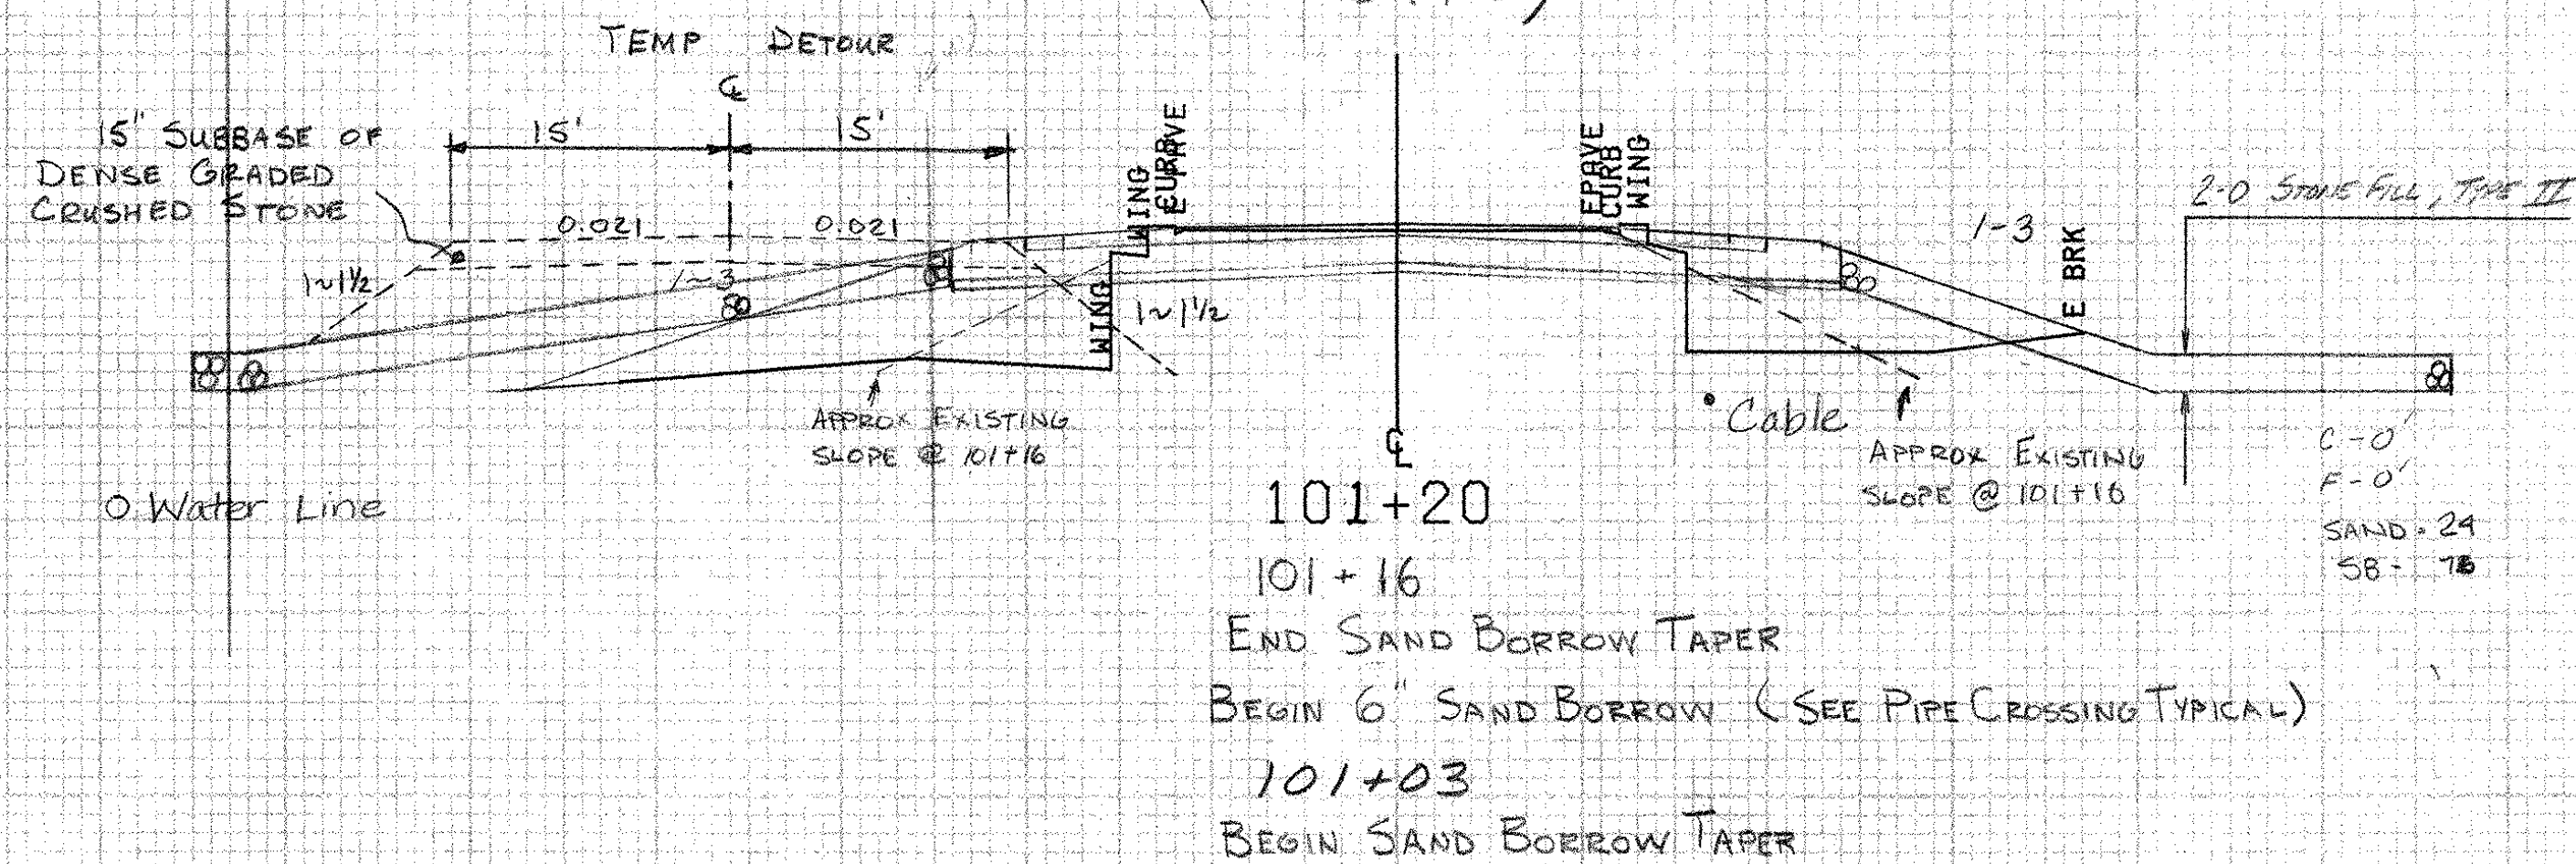


500

100+95 ~ 101+20 Lt.
 Removal and Disposal of
 of Guard Rail

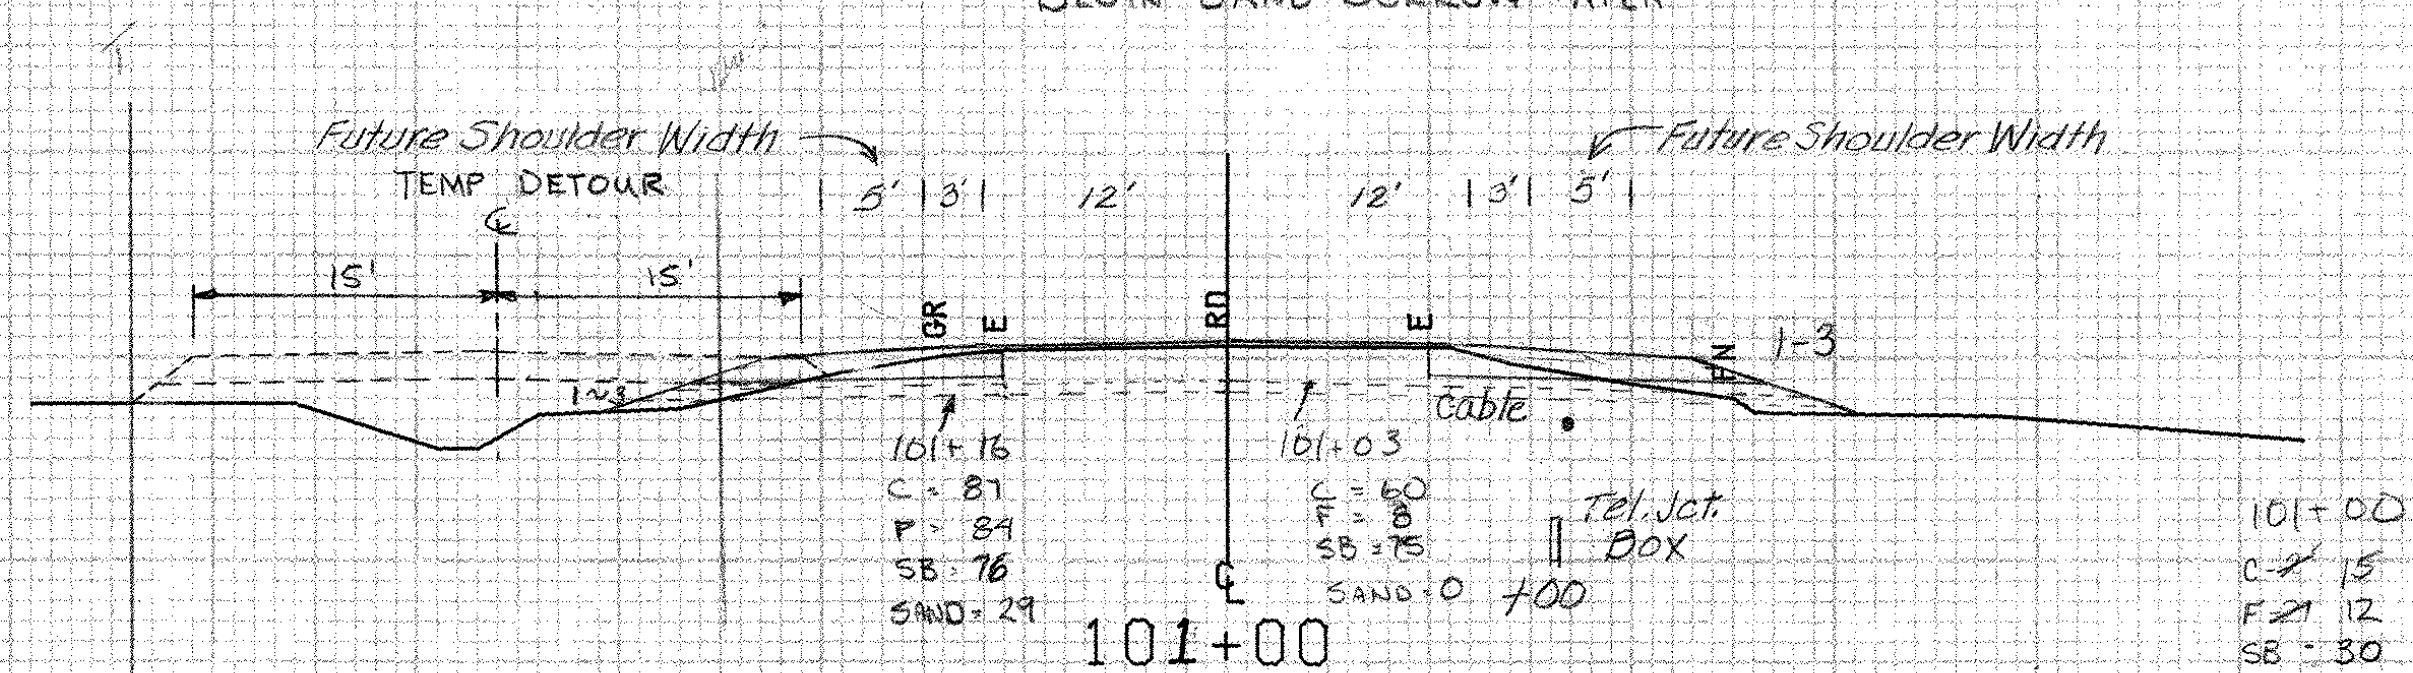

500


100+96 ~ 101+20 Rt.
 Removal and Disposal of
 of Guard Rail

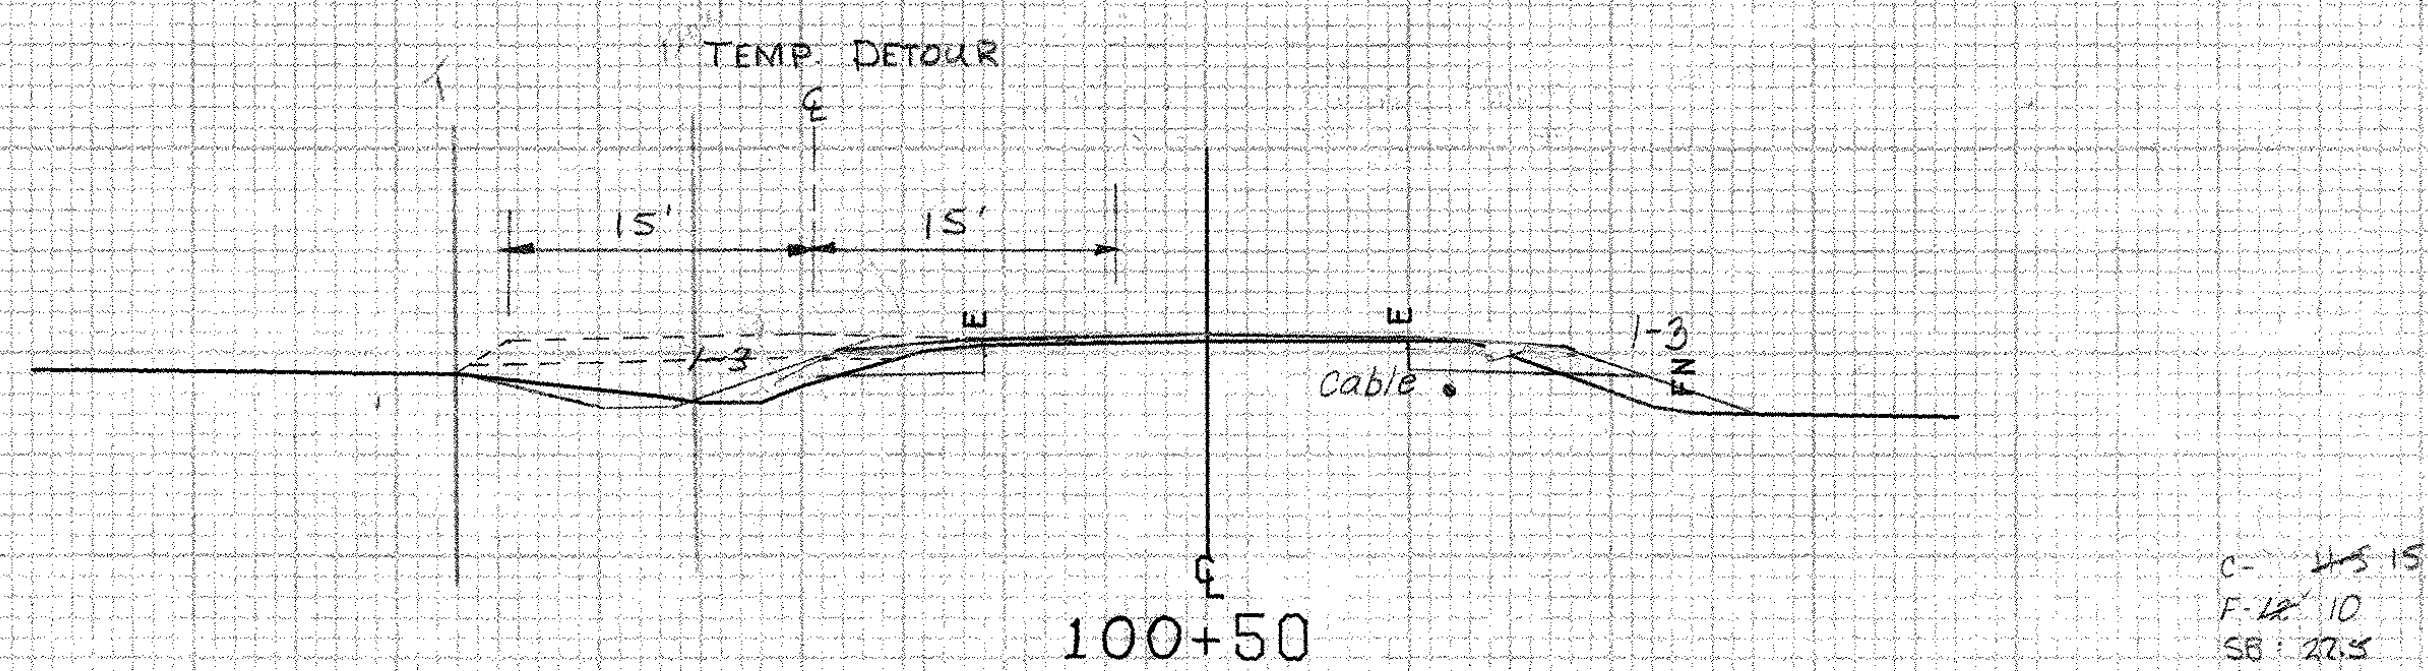

500

100+00 RT
 Begin Removing & Resetting Fence
 Begin Temporary Barbed Wire Fence (4-strand)
 BEGIN REMOVAL OF EXISTING FENCE (NON-PART.)

100+00 LT
 Begin GEOTEXTILE FABRIC for Silt Fence

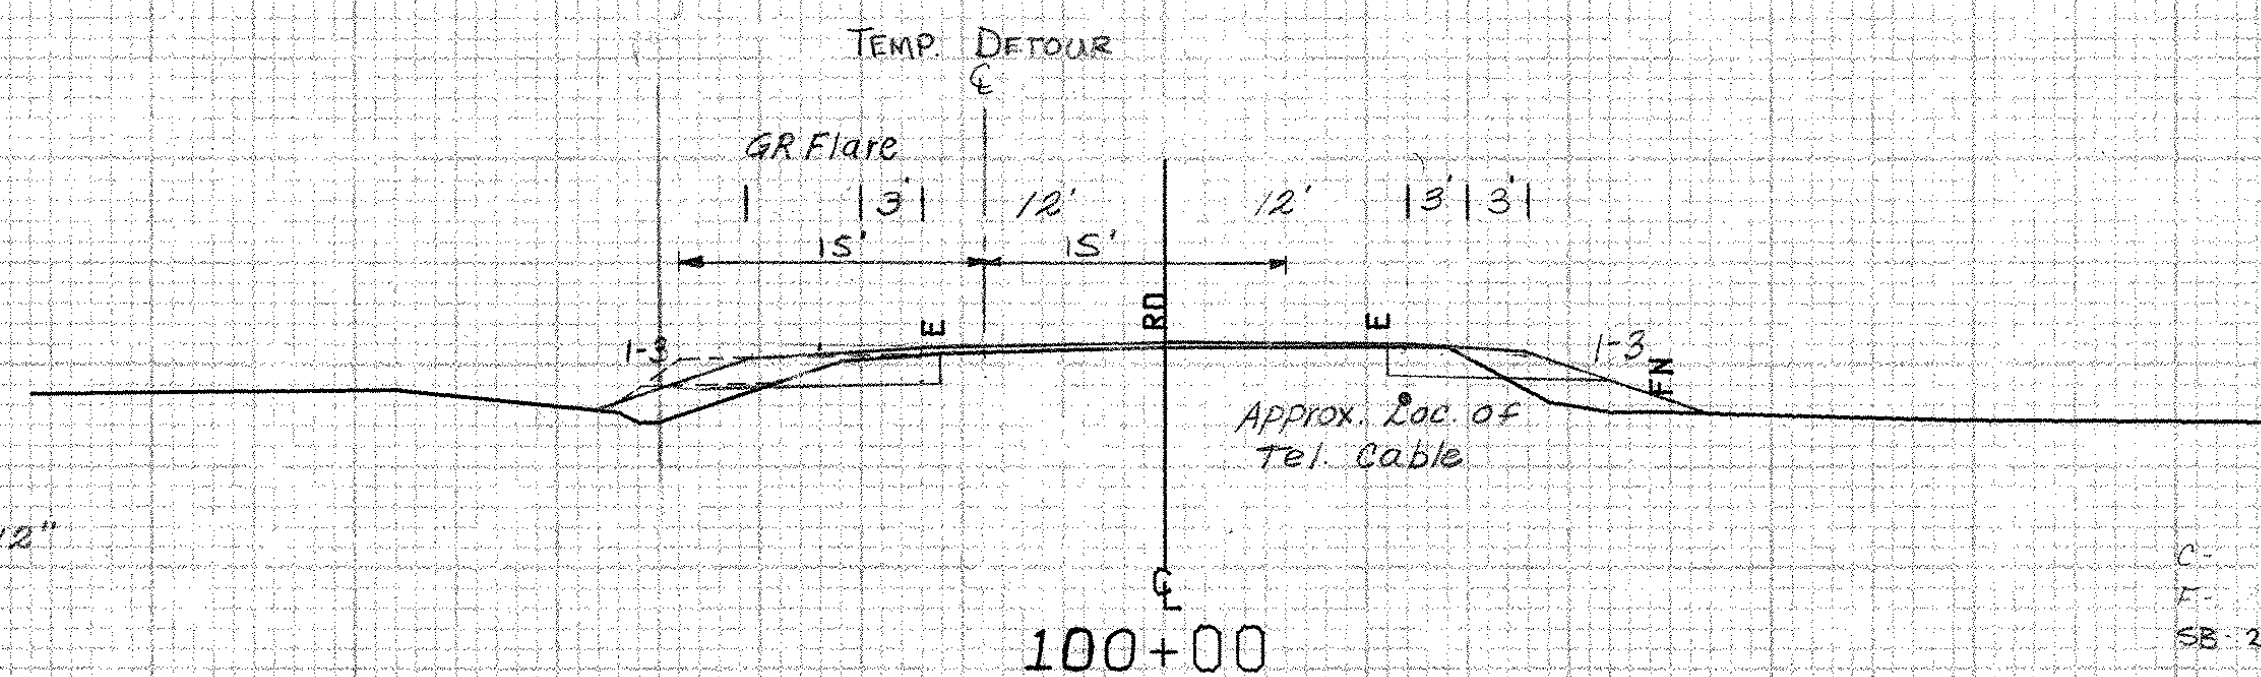

500

100+00 RT
 Begin GEOTEXTILE FABRIC for silt Fence

99+50 LT
 BEGIN CONSTRUCTION OF TEMPORARY DETOUR

SHOREHAM MM 549 ~ MM 558

FROM STA. 100+00	TO STA. 101+20
PROJECT NAME SHOREHAM-BRIDPORT-ADDISON	
NO. F017-1(2)	PLOTTED 03/29/84
SURVEYED BY FANTONI	03/84
SHEET 273 OF 420 SHEETS	SHEET 273 OF 477

SCALE 1" = 10 FEET