




C-3<sup>1</sup> 16  
F-28<sup>1</sup> 21  
SB-17.5

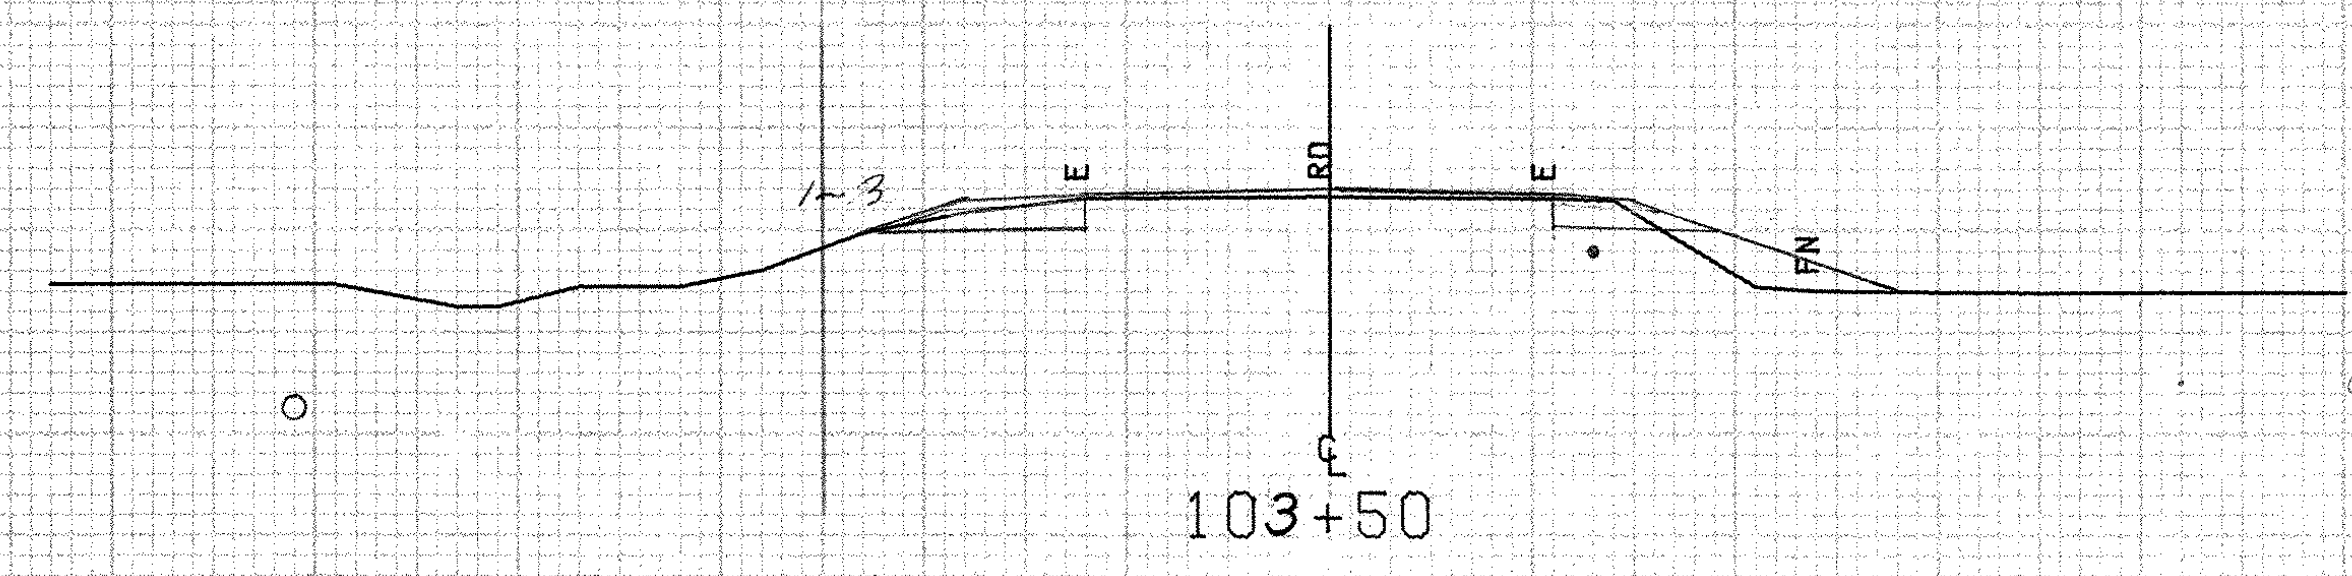

C-3<sup>1</sup> 17  
F-28<sup>1</sup> 18  
SB-110

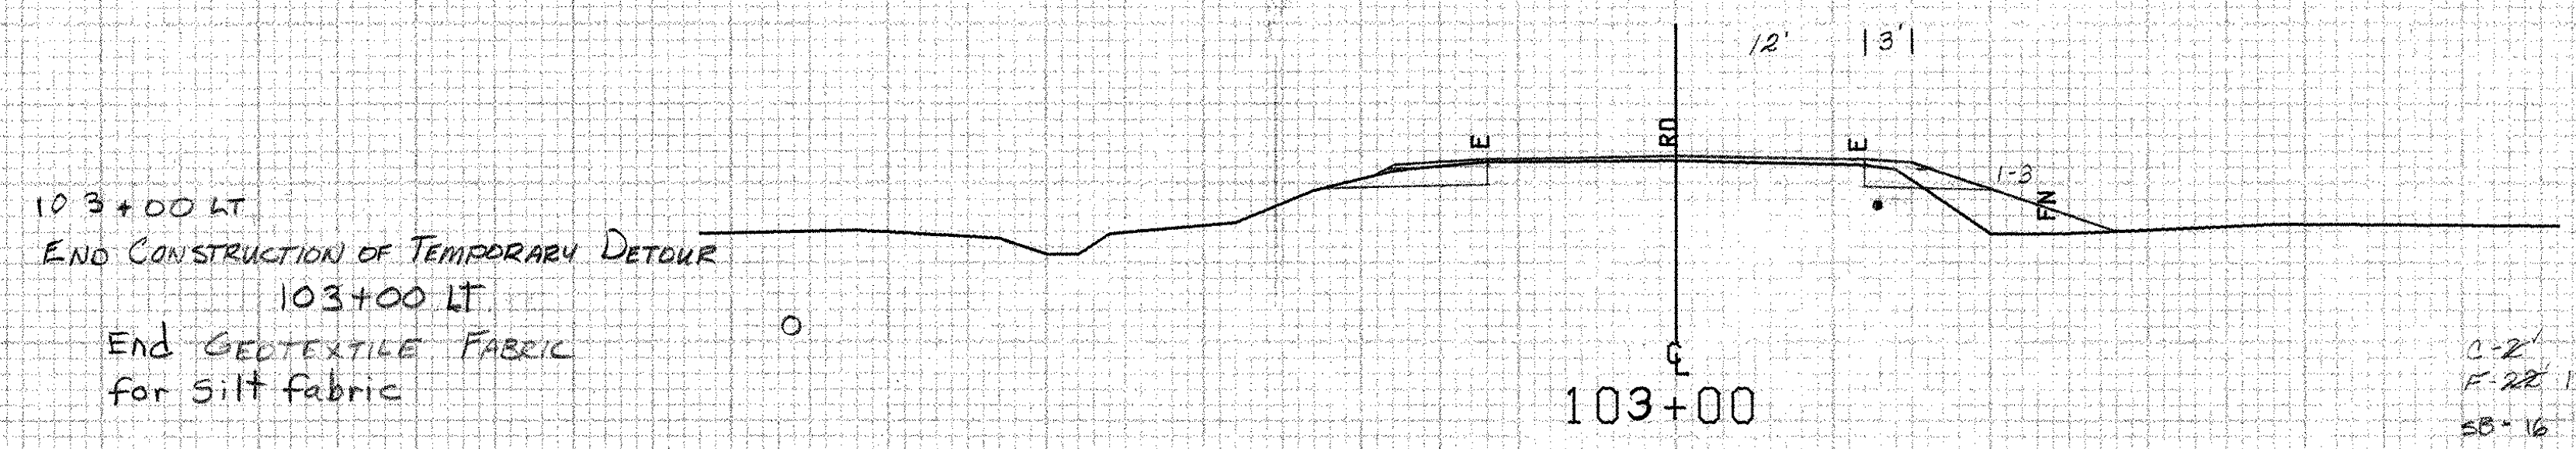

C-2<sup>1</sup> 15  
F-28<sup>1</sup> 18  
SB-16

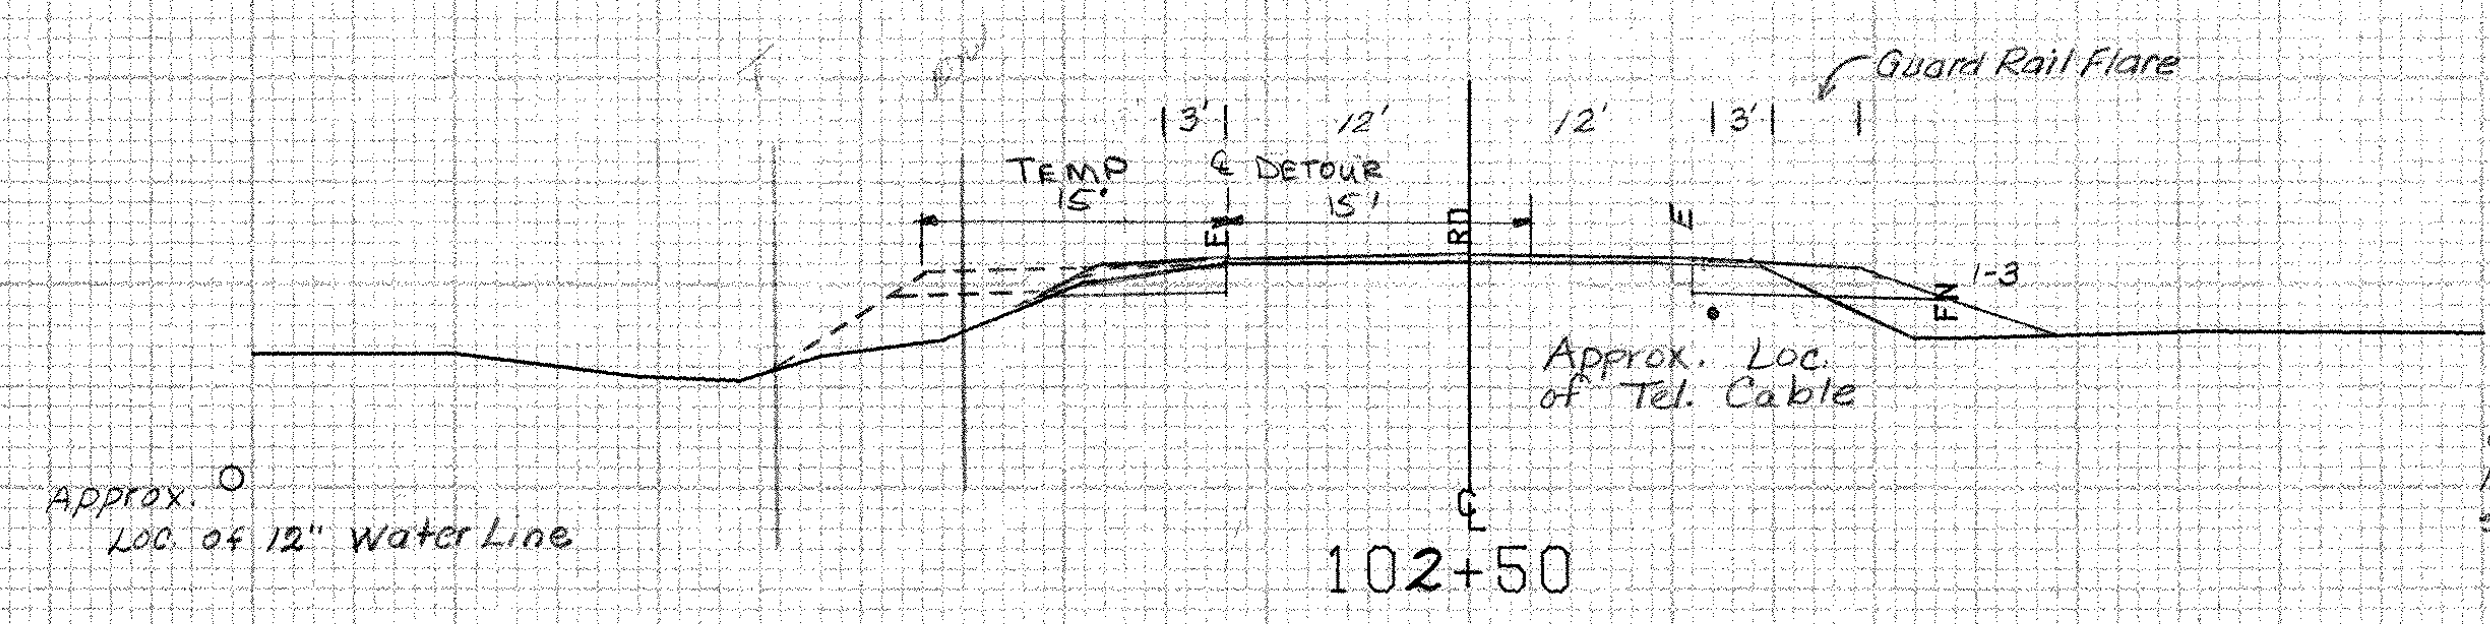

C-2<sup>1</sup> 19  
F-21<sup>1</sup> 15  
SB-20

SHOREHAM MM 5.49-MM 5.58

FROM STA.	102+50	TO STA.	104+00
PROJECT NAME	SHOREHAM-BRIDPORT-ADDISON		
NO.	F017-1(2)	PLOTTED	03/29/84
SURVEYED BY	FANTONI		03/84
SHEET	275 OF 420 SHEETS	SHEET	275 OF 477

SCALE 10 FEET