
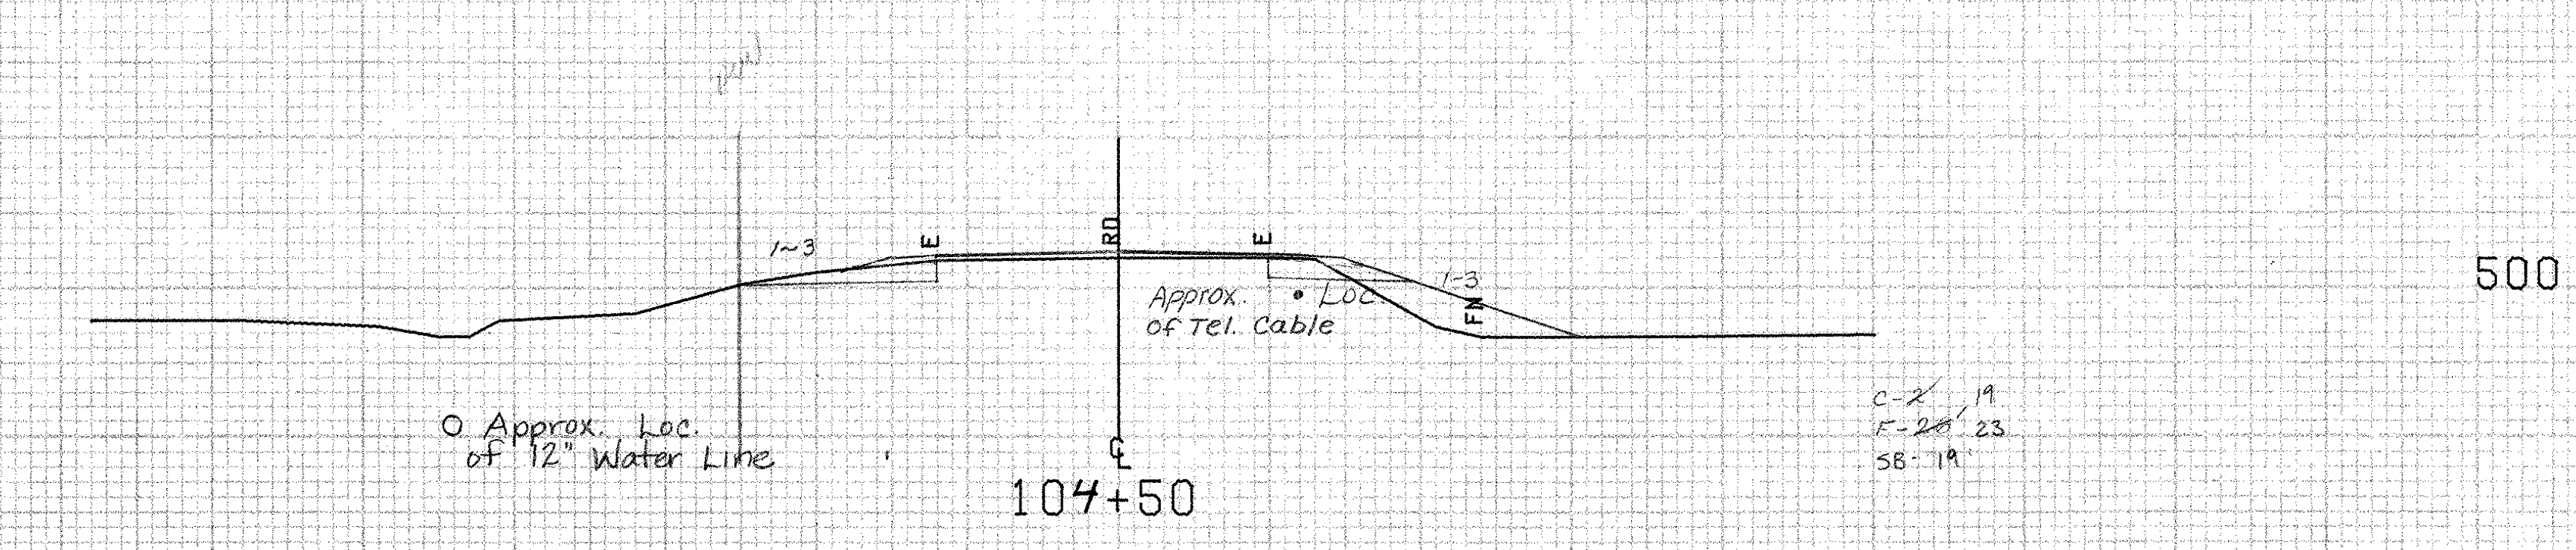


106+00 RT
 End Removing & Resetting Fence
 End Temporary Barbed Wire Fence (4-strand)
 END REMOVAL OF EXISTING FENCE (NON-PART.)

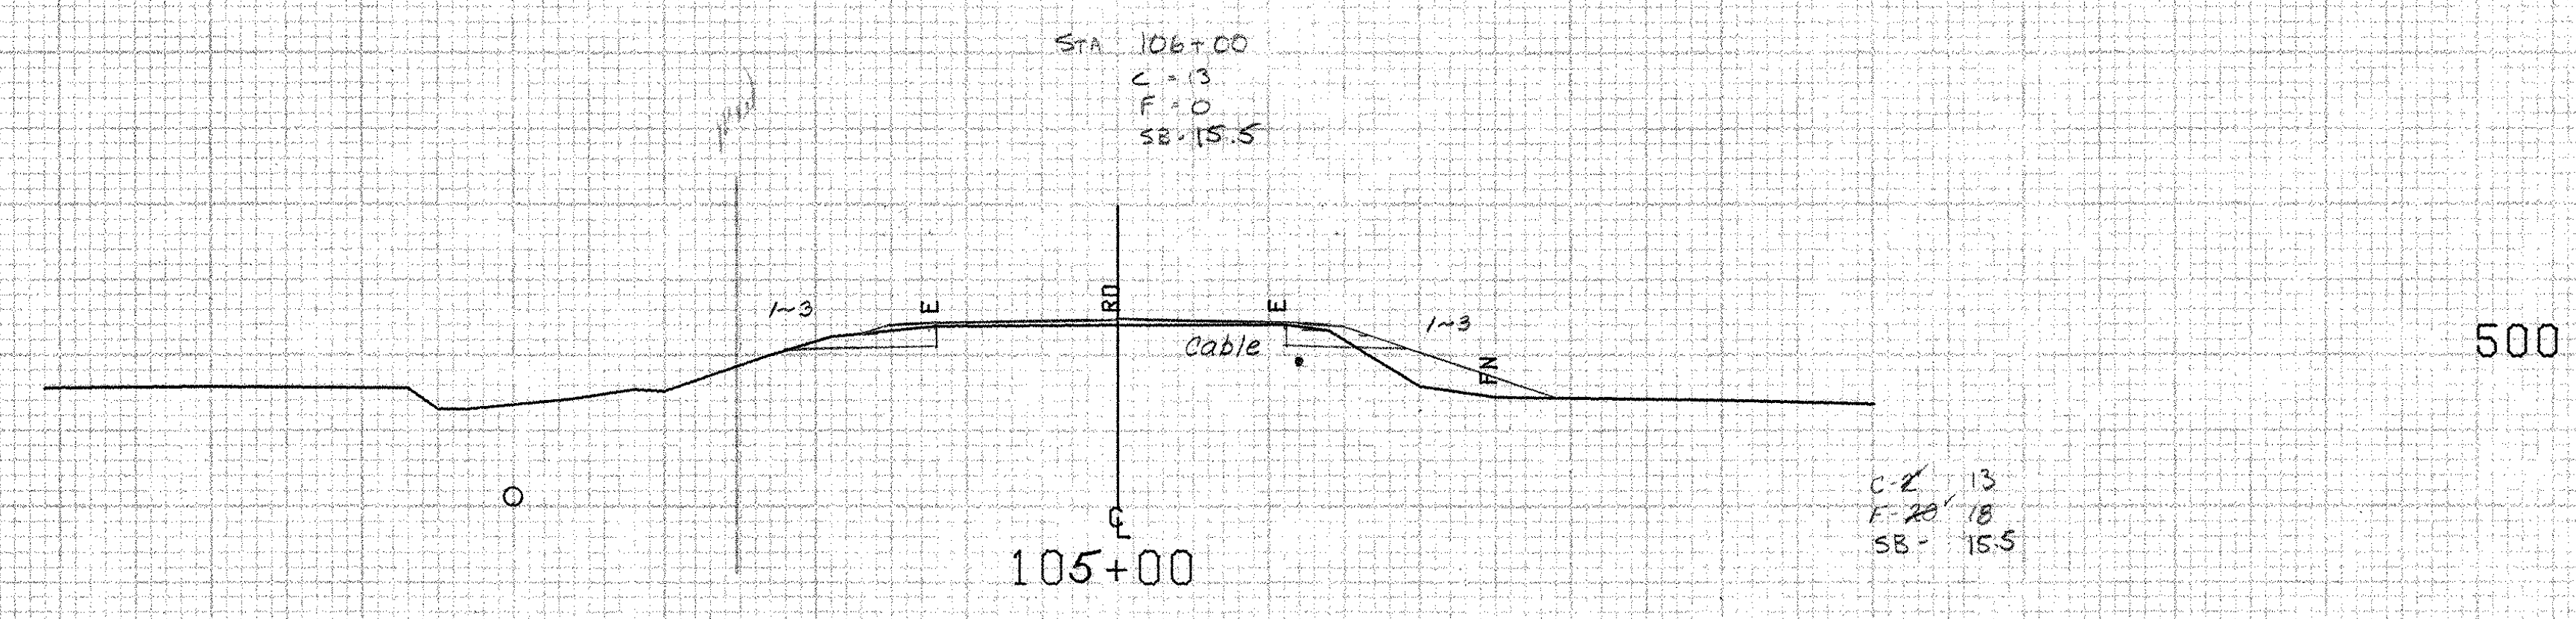

SHOREHAM MM 5.49 ~ MM 5.58

FROM STA.	104+50	TO STA.	105+00
PROJECT NAME	SHOREHAM-BRIDPORT-ADDISON		
NO.	FO17-1(2)		
SURVEYED BY	FANTONI	DATE	03/84
SHEET	276	OF 429 SHEETS	SHEET 276 OF 477

SCALE 1" = 10 FEET