
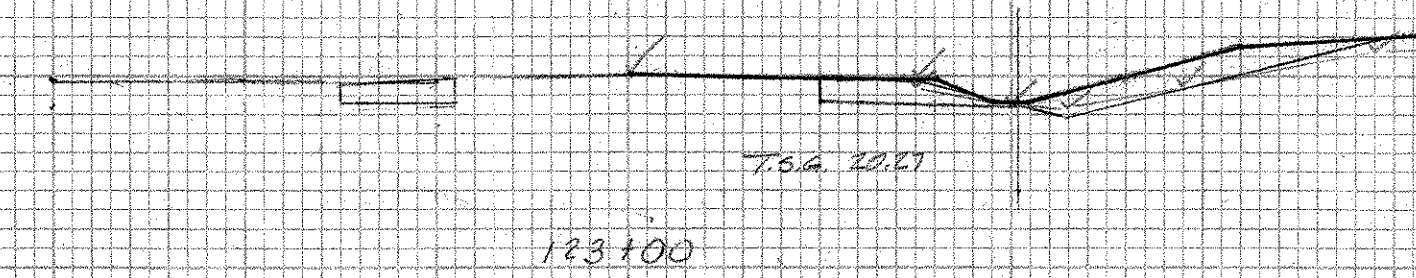
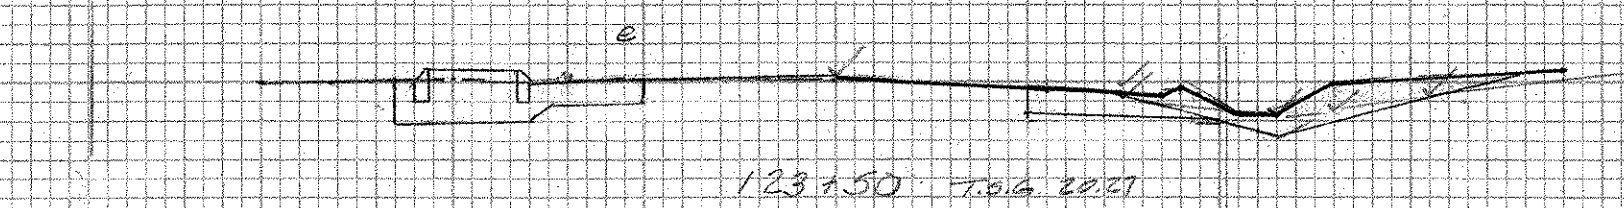
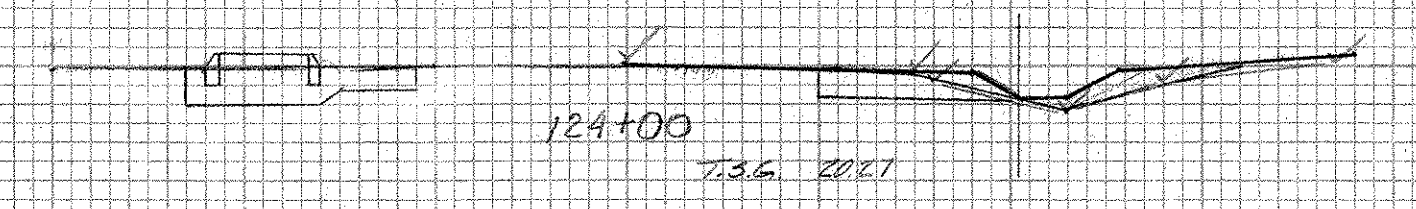
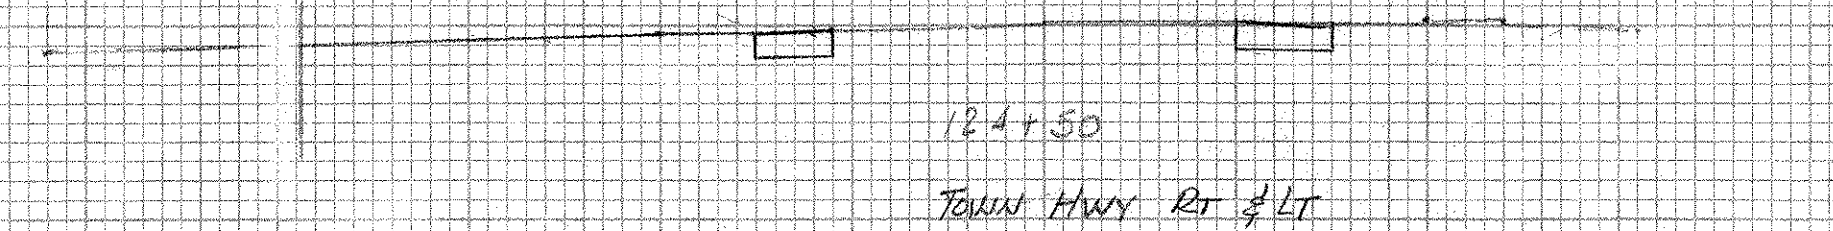
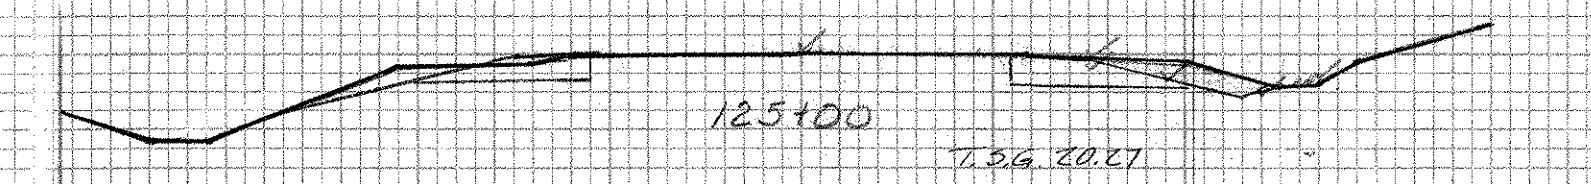
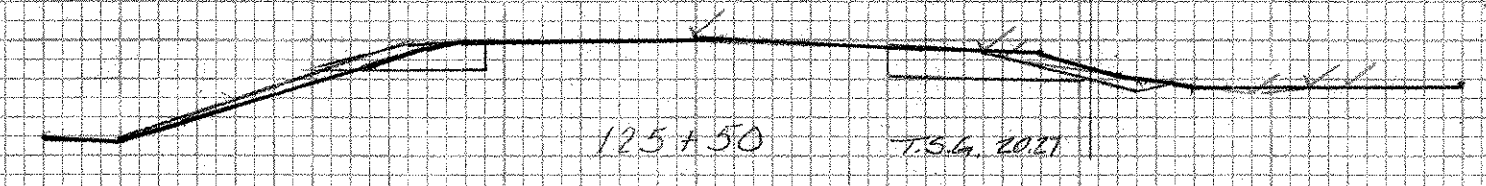
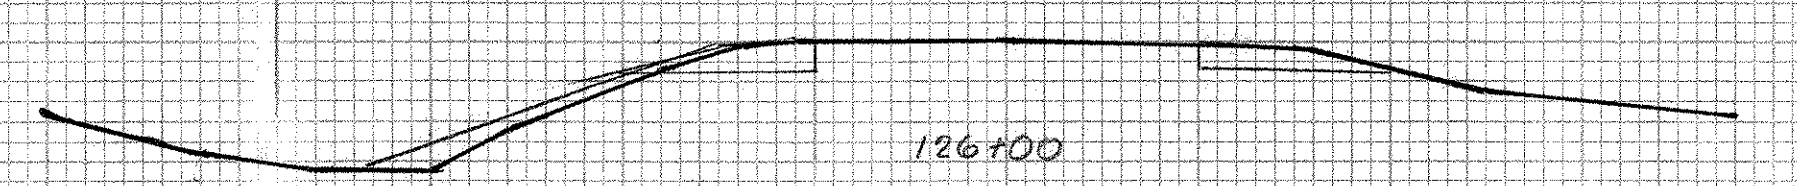
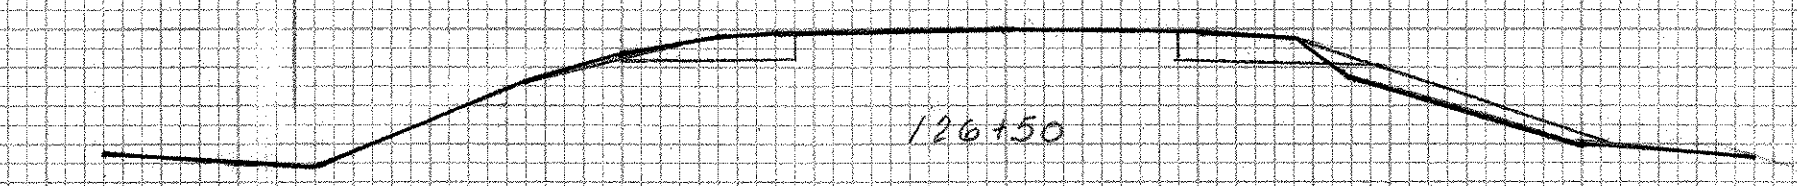


FINAL SURVEY NOTE BOOK No. _____
 SURVEYED BY _____
 PLOTTED BY _____
 TEMP. DATE _____
 AREAS CHECKED _____

ORIGINAL SURVEY NOTE BOOK No. _____
 SURVEYED BY _____
 PLOTTED BY _____
 TEMP. DATE _____
 AREAS CHECKED _____

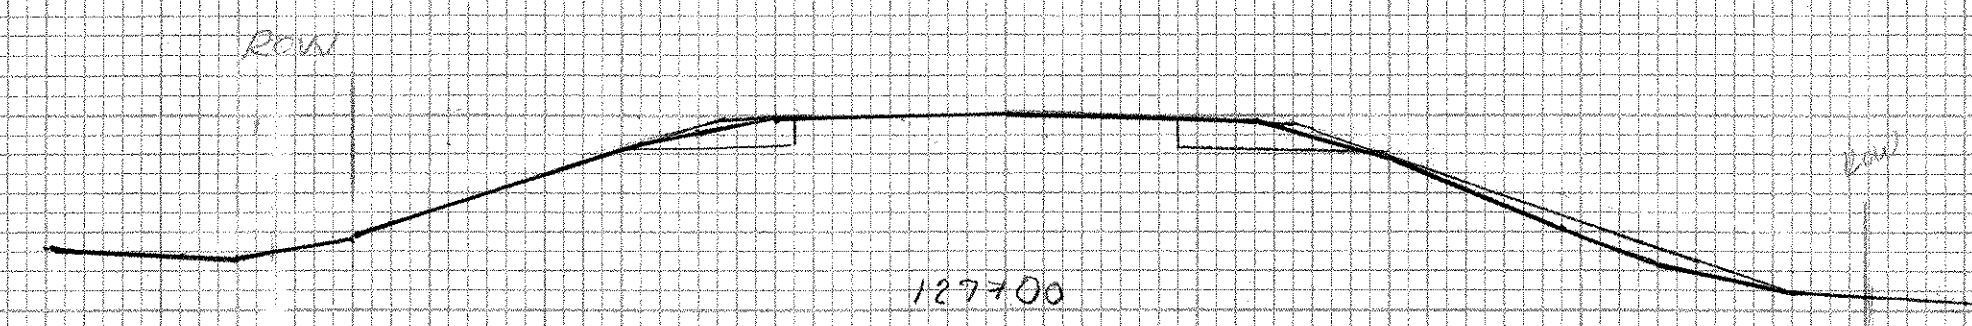

EARTH

20.27	428.2
20.0	427.5
25.0	428.2
20.27	428.7
20.27	428.2

EARTH










21.0	428.2
23.0	427.5
28.0	428.2
32.0	428.1
24.0	428.4
28.0	428.4
21.0	428.2

EARTH

25.0	428.5
20.0	428.5
31.0	428.3
32.0	428.6
34.0	428.4
26.0	428.0
23.0	428.5

EARTH

20.27	428.6
23.0	428.5
29.0	428.2
32.0	428.1
32.0	428.0
20.27	428.6

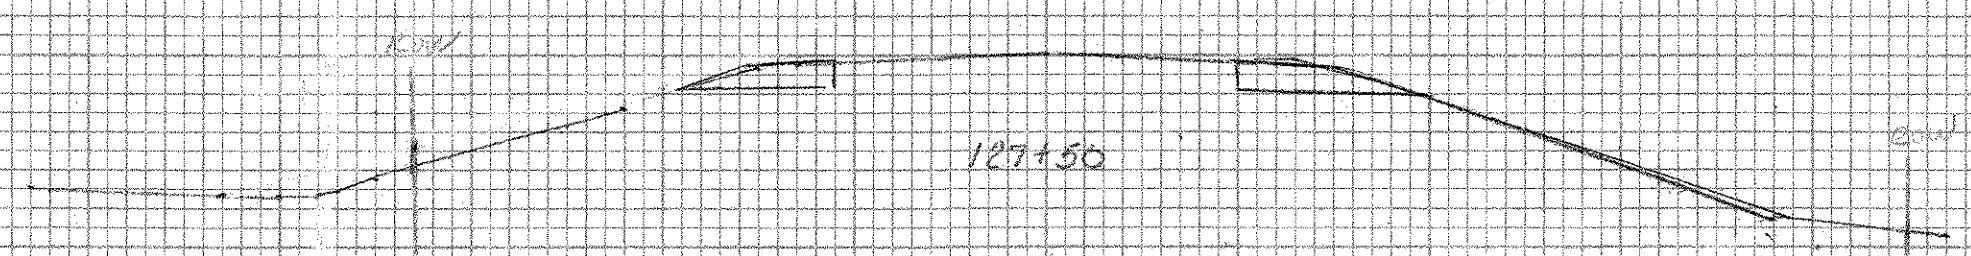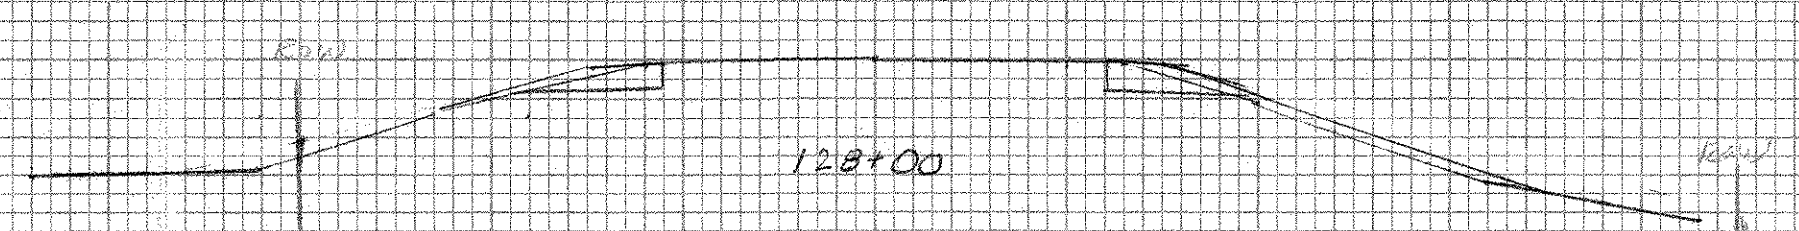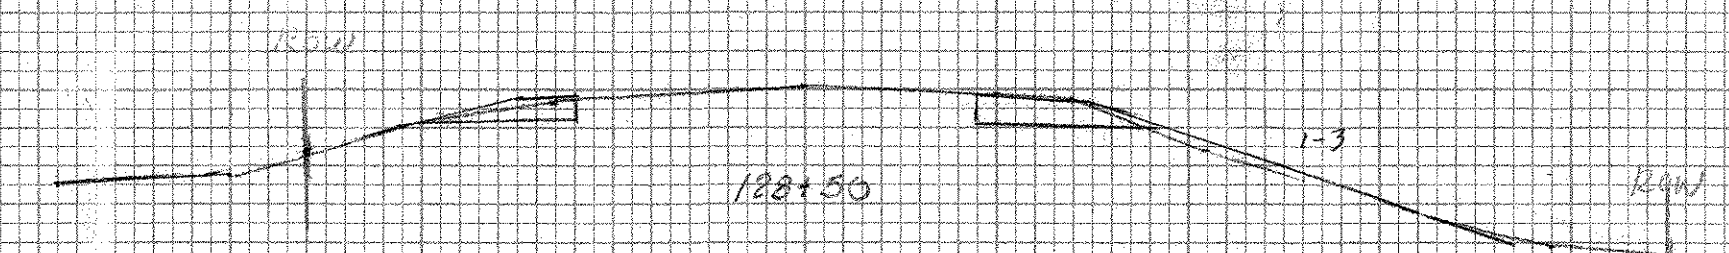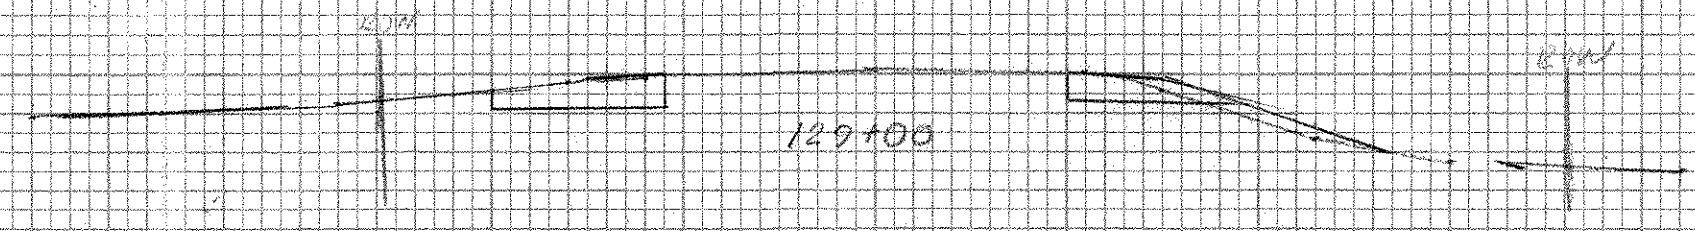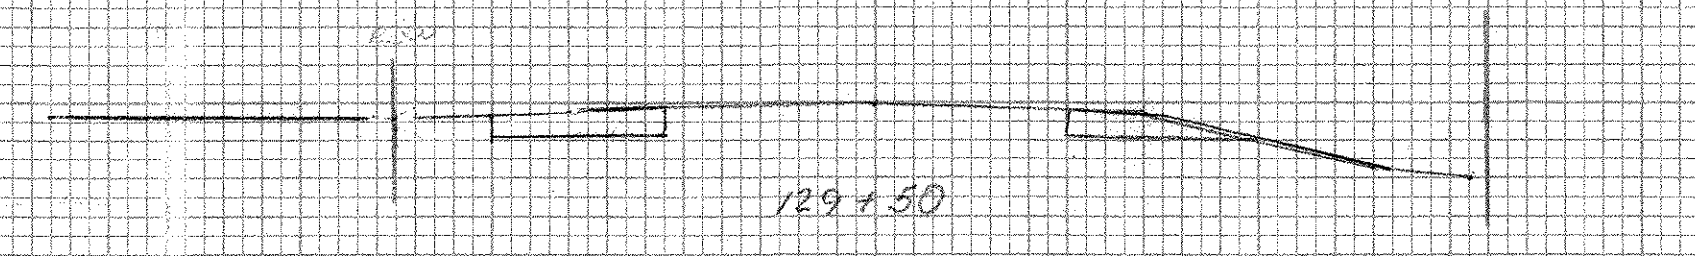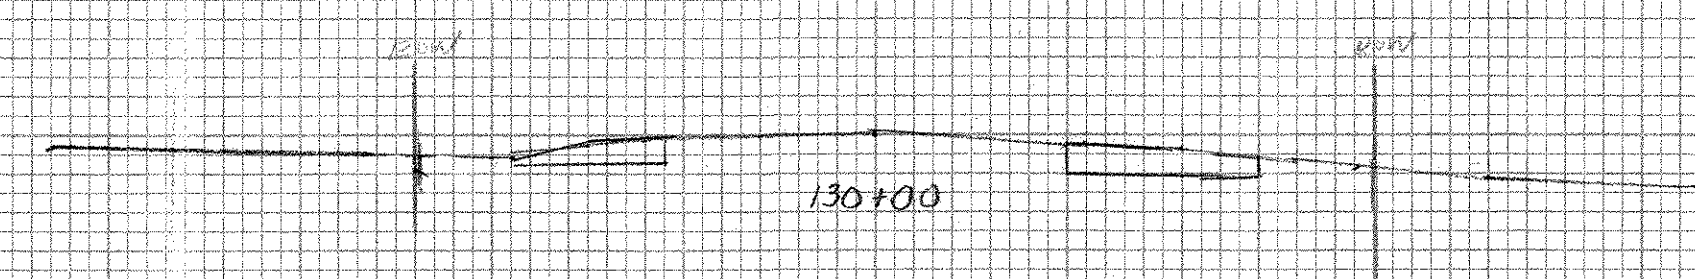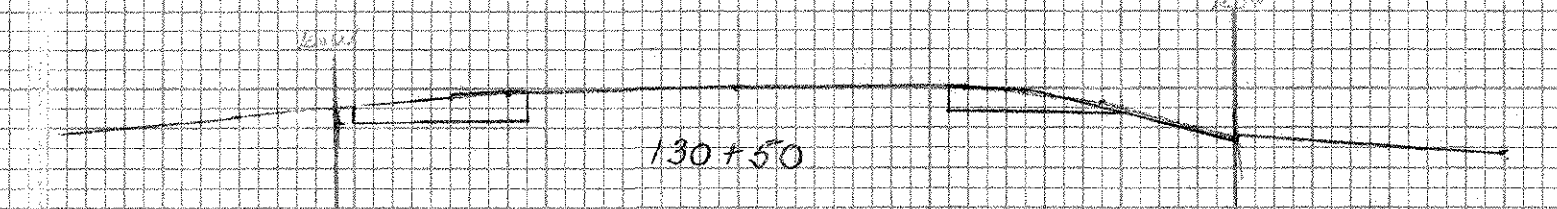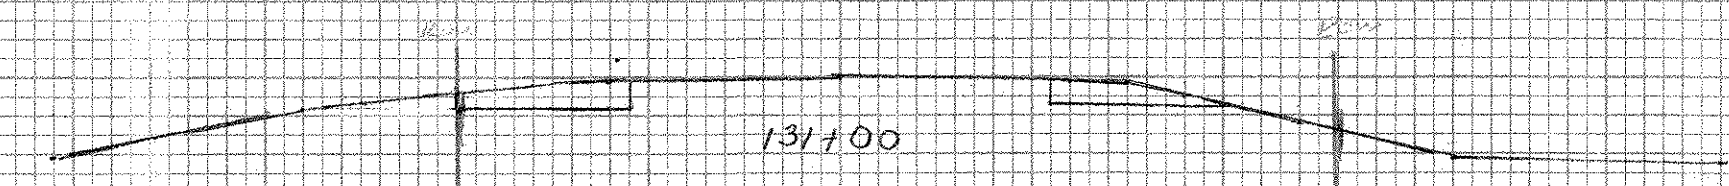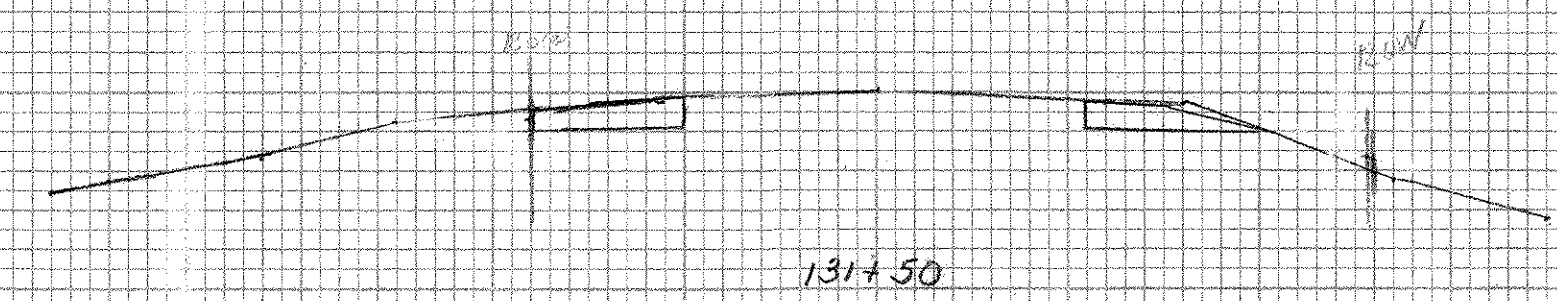

SHOREHAM-BRIDPORT-ADDISON
 FOIT-1(2)

Original Sections