


2

2

DATE	
BY	
REVIEWED	
PLOTTED	
DATE	
BY	
AREAS CHECKED	
NO.	

DATE	
BY	
REVIEWED	
PLOTTED	
DATE	
BY	
AREAS CHECKED	
NO.	

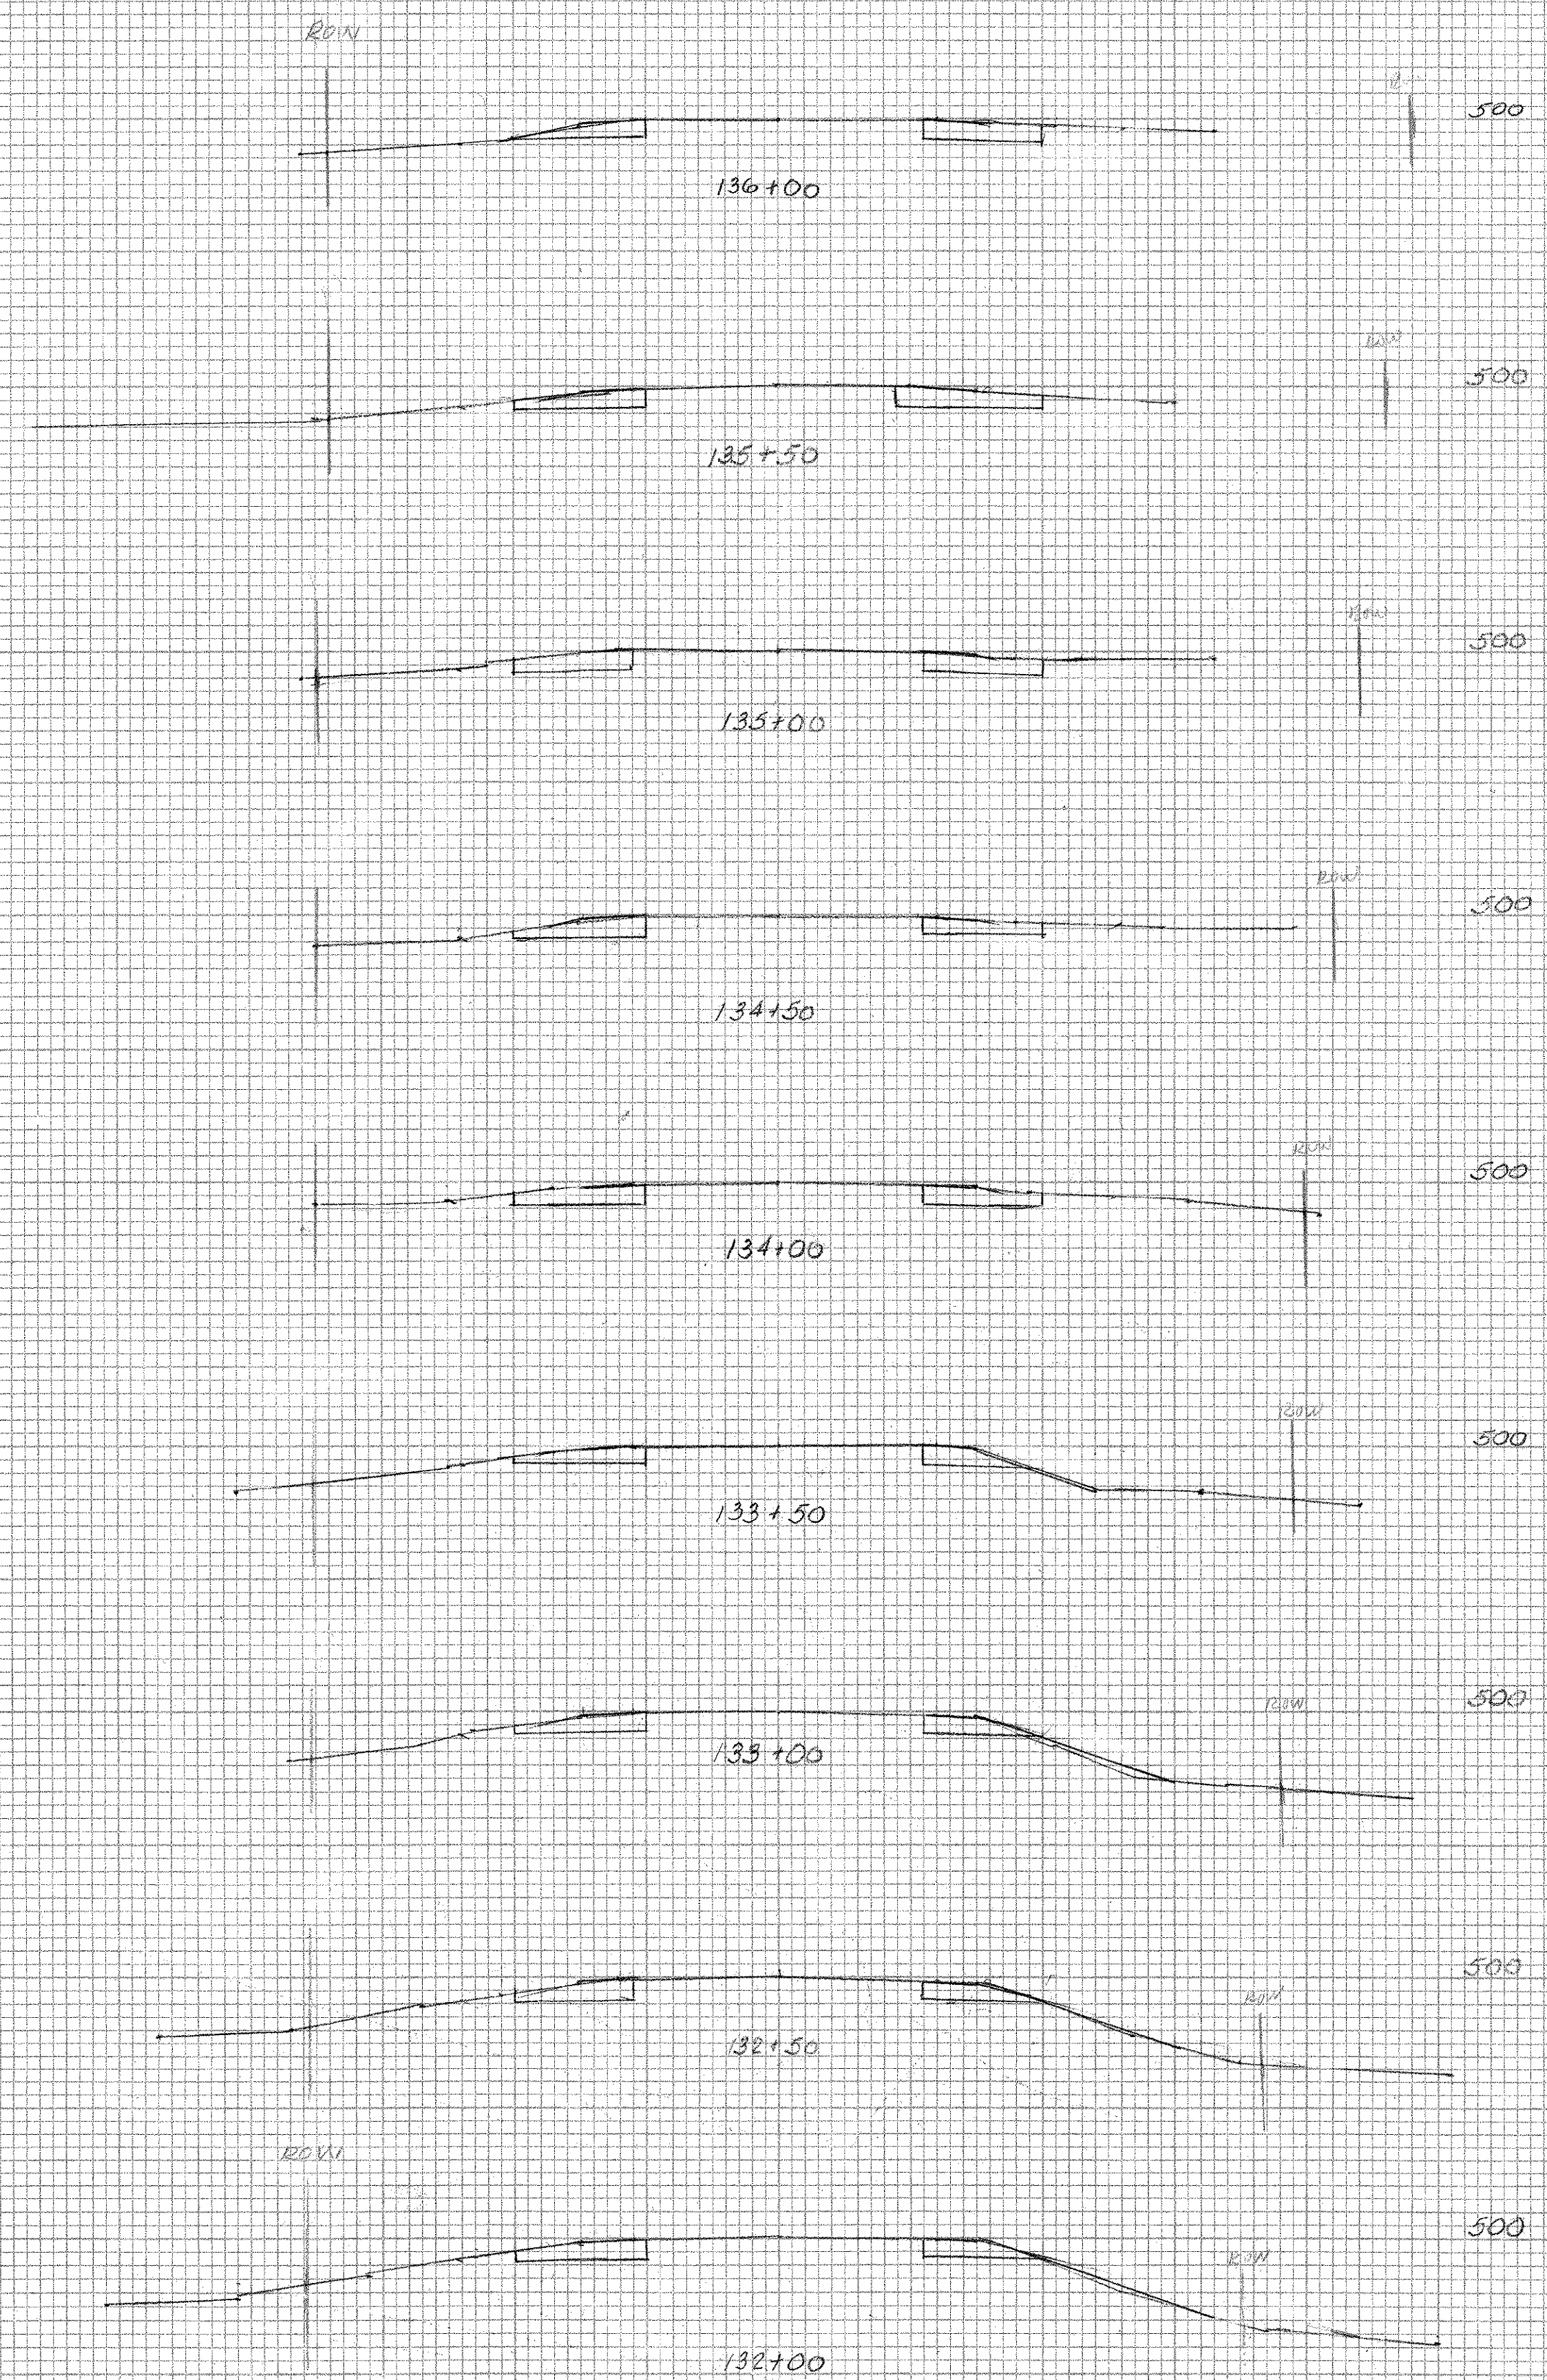

SHOREHAM-BRIDPORT-ADDISON
 F 017-1(2)
 132+00 - 136+00
 Original Sections

Plotted R. E. W. S. Y.