
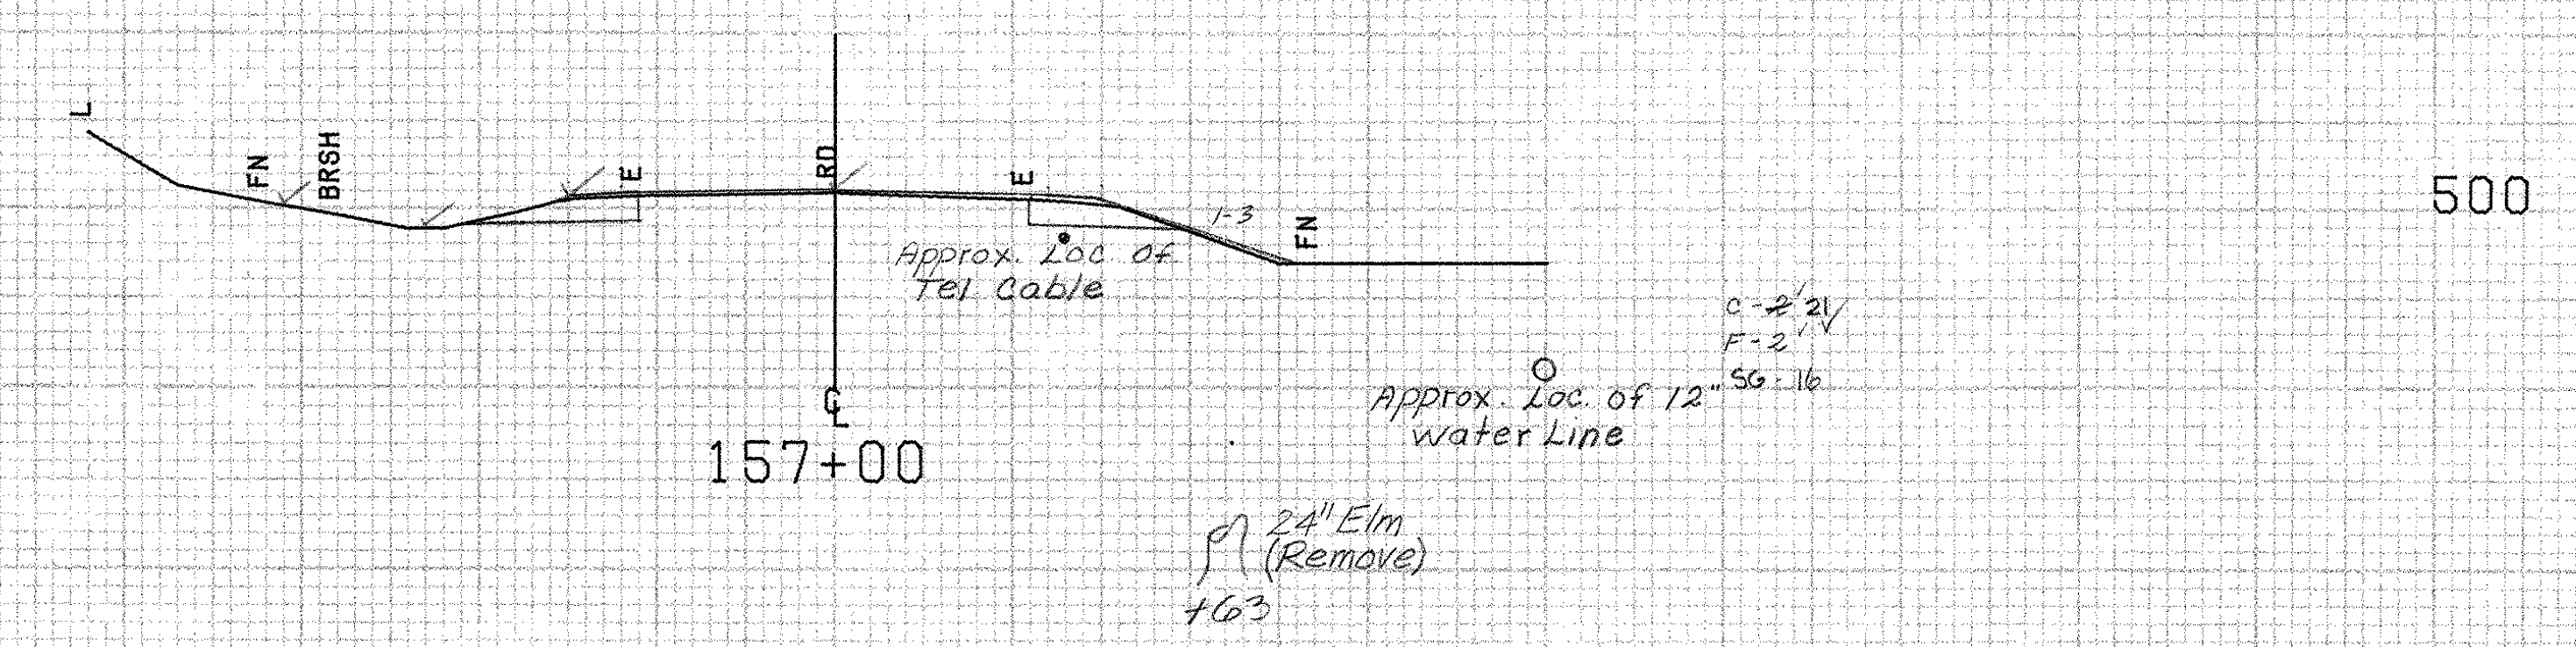
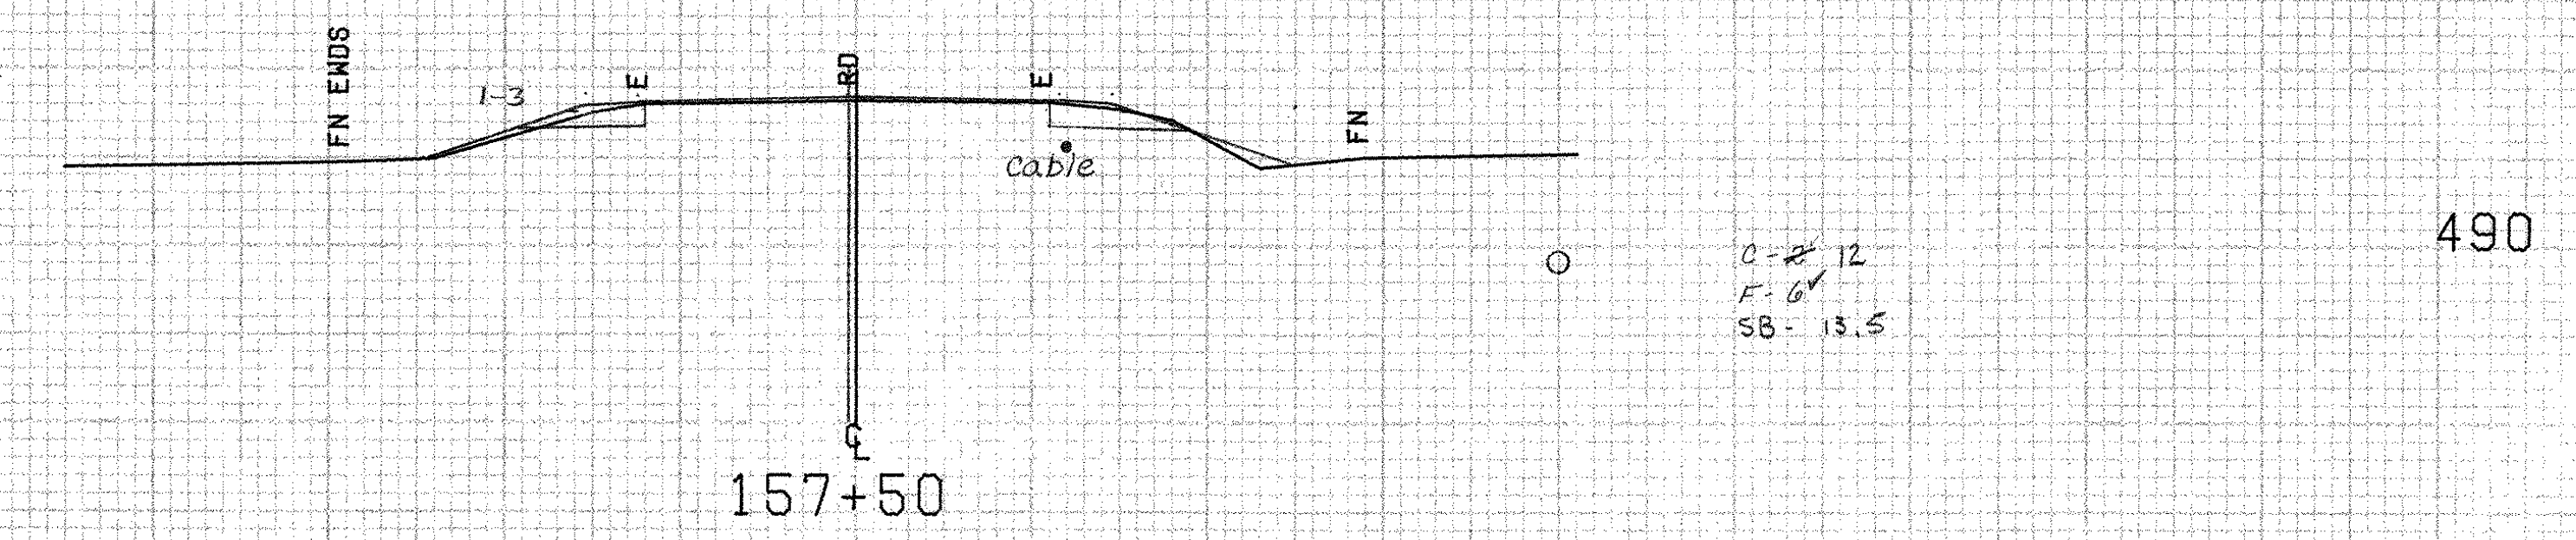
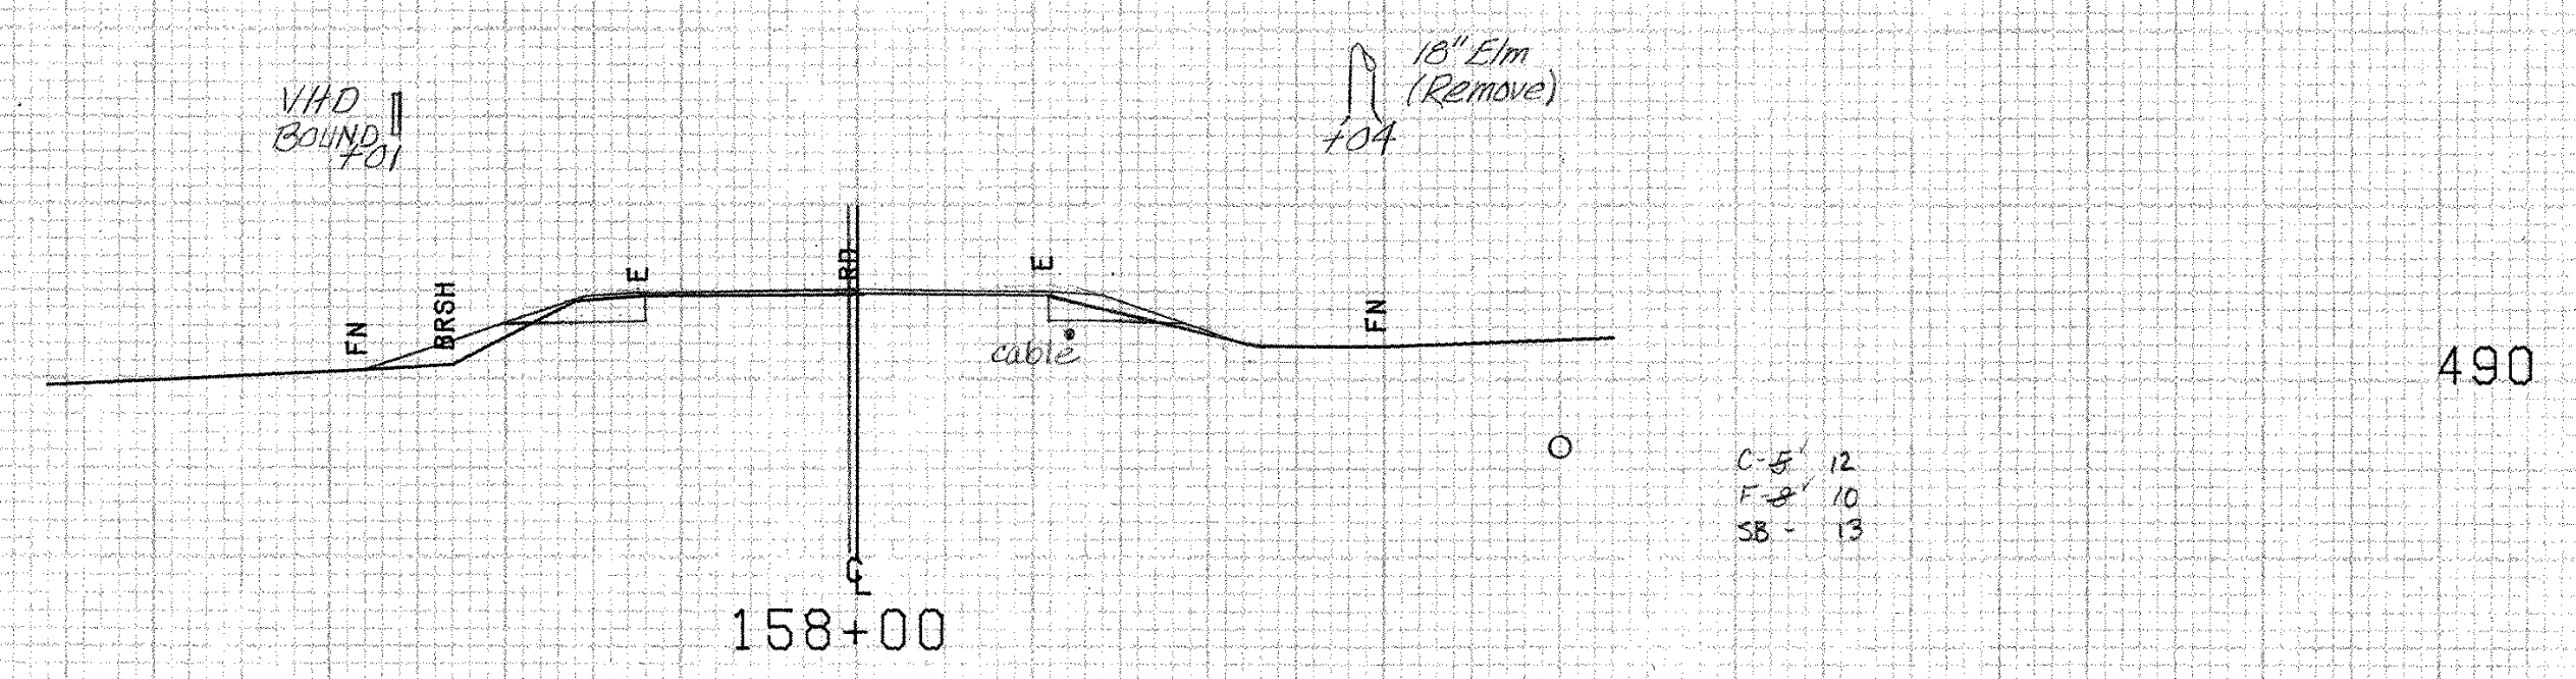


158+54 Lt.
Begin Removal & Disposal
of Guard Rail

158+63 Rt.
Begin Removal & Disposal
of Guard Rail

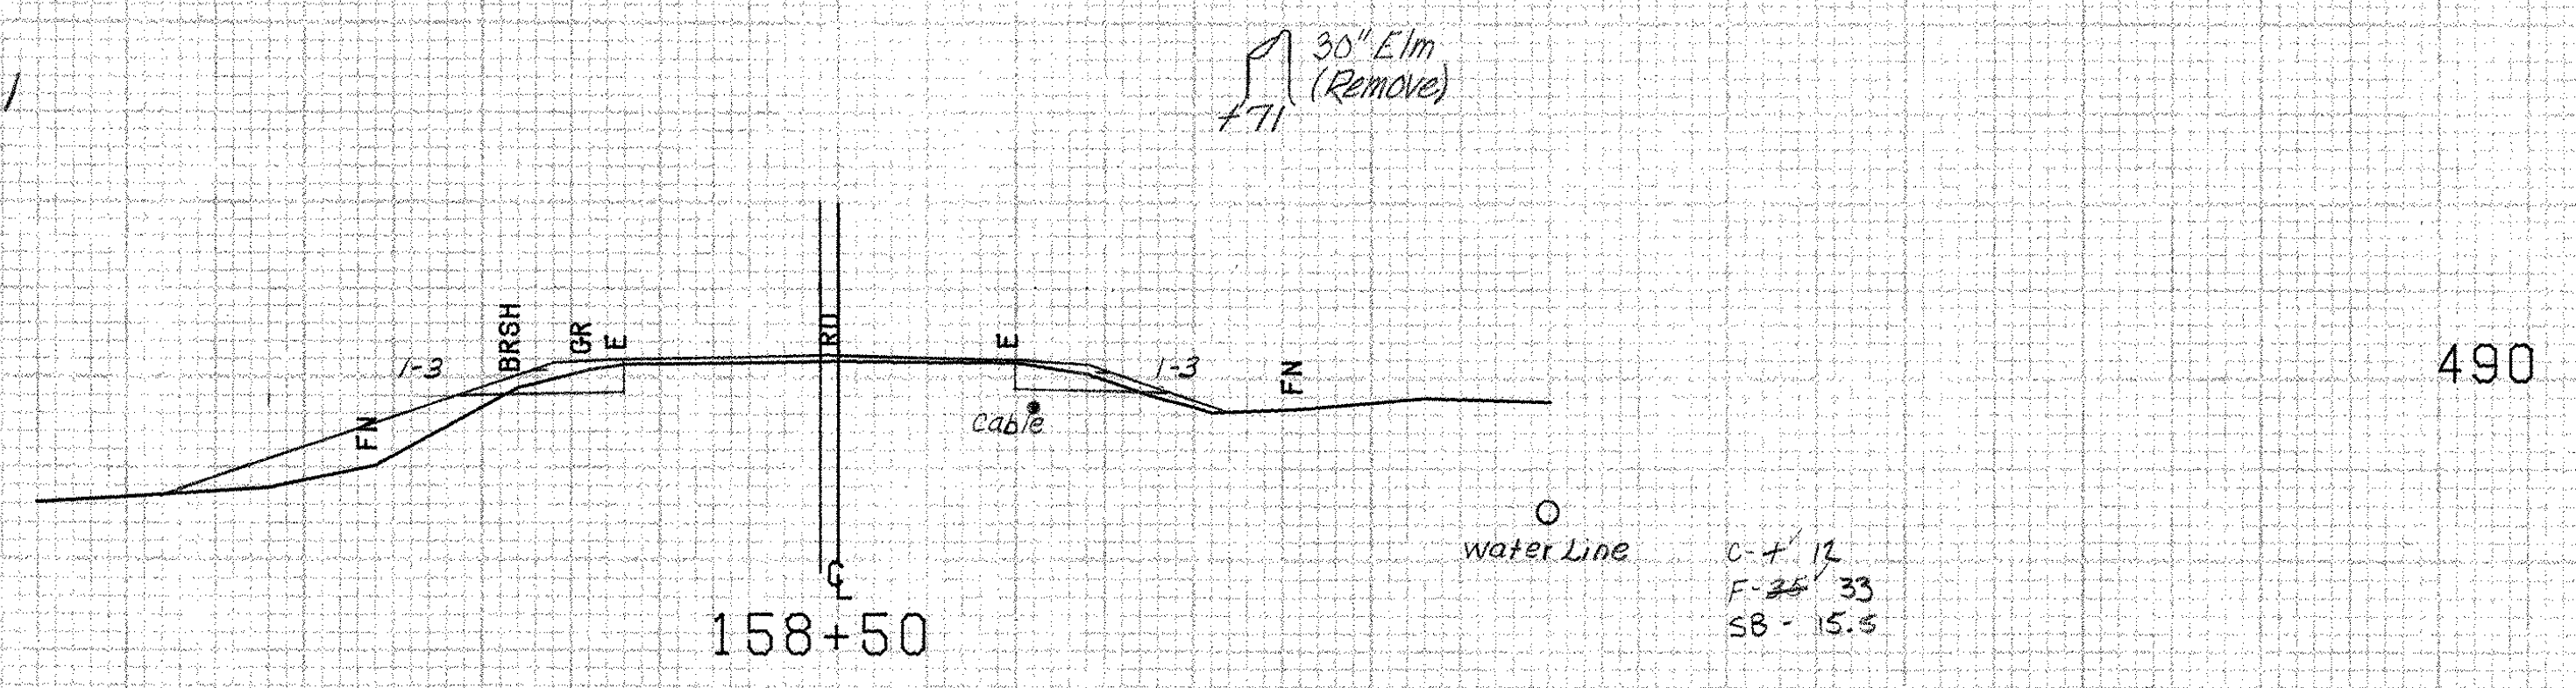

BRIDPORT MM 0.18-MM 0.29

FROM STA.	157+00	TO STA.	158+50
PROJECT NAME	SHOREHAM-BRIDPORT-ADDISON		
NO.	F017-1(2)	PLOTTED	02/10/84
SURVEYED BY	FANTONI	JAN	1984
SHEET	236 OF 420 SHEETS	SHEET	286 OF 477

SCALE 1" = 10 FEET