




460

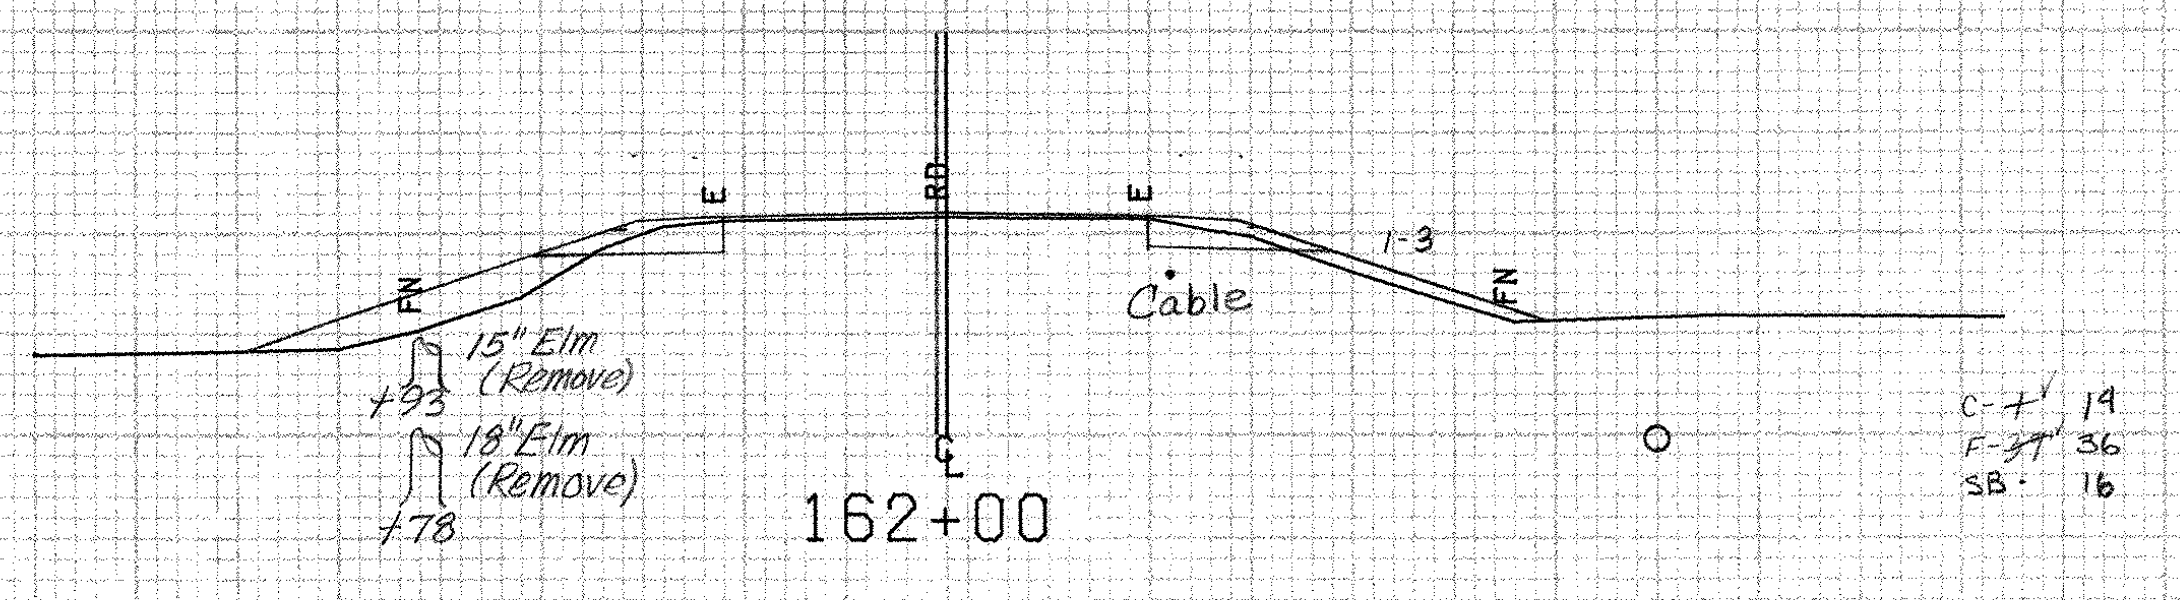

470

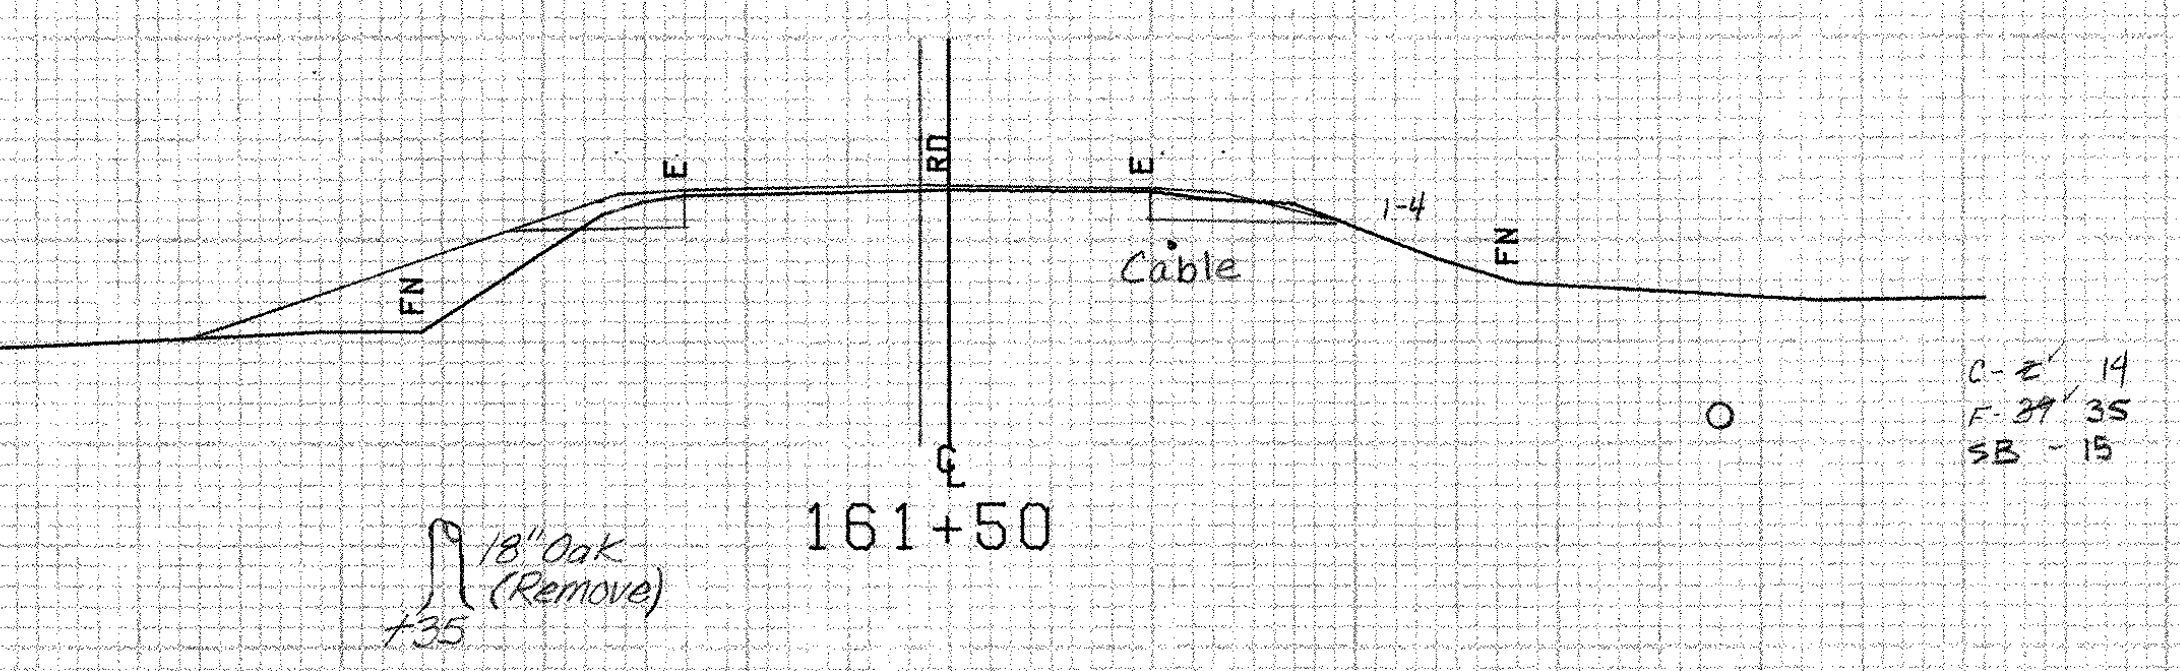

470

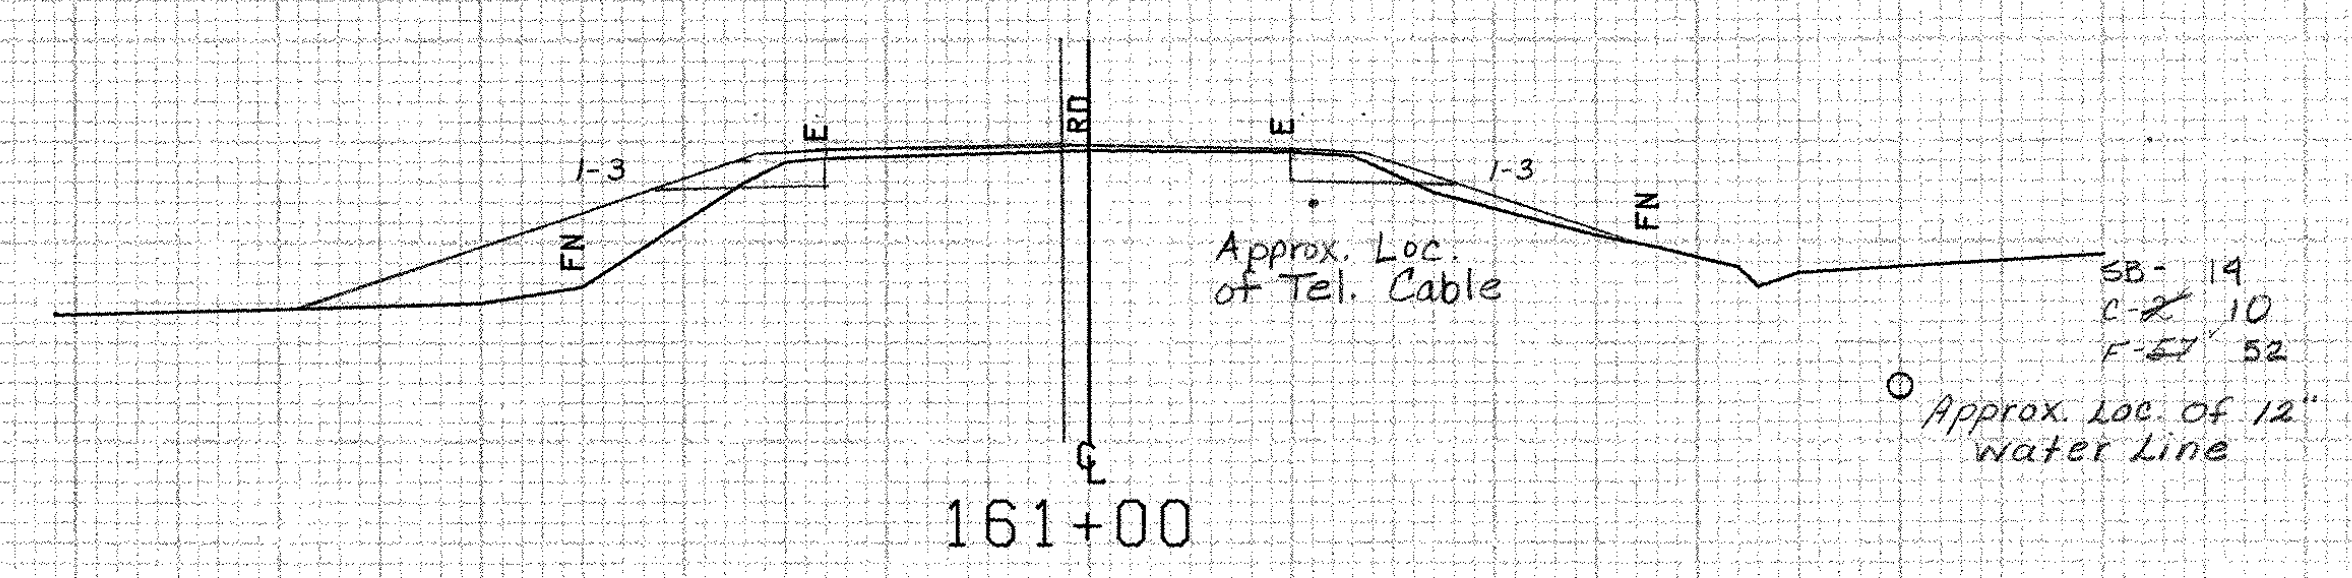

470

BRIDPORT MM 0.18 - MM 0.29

FROM STA.	161+00	TO STA.	162+50
PROJECT NAME	SHOREHAM-BRIDPORT-ADDISON		
NO.	F017-1(2)	PLOTTED	02/10/84
SURVEYED BY	FANTONI		
SHEET	288	OF	420 SHEETS
		SHEET	288 OF 477

SCALE 1" = 10 FEET