


163+00 ~ 165+00 LT  
 Removing & Resetting Fence  
 Temporary Barbed Wire Fence (4-strand)  
 REMOVAL OF EXISTING FENCE

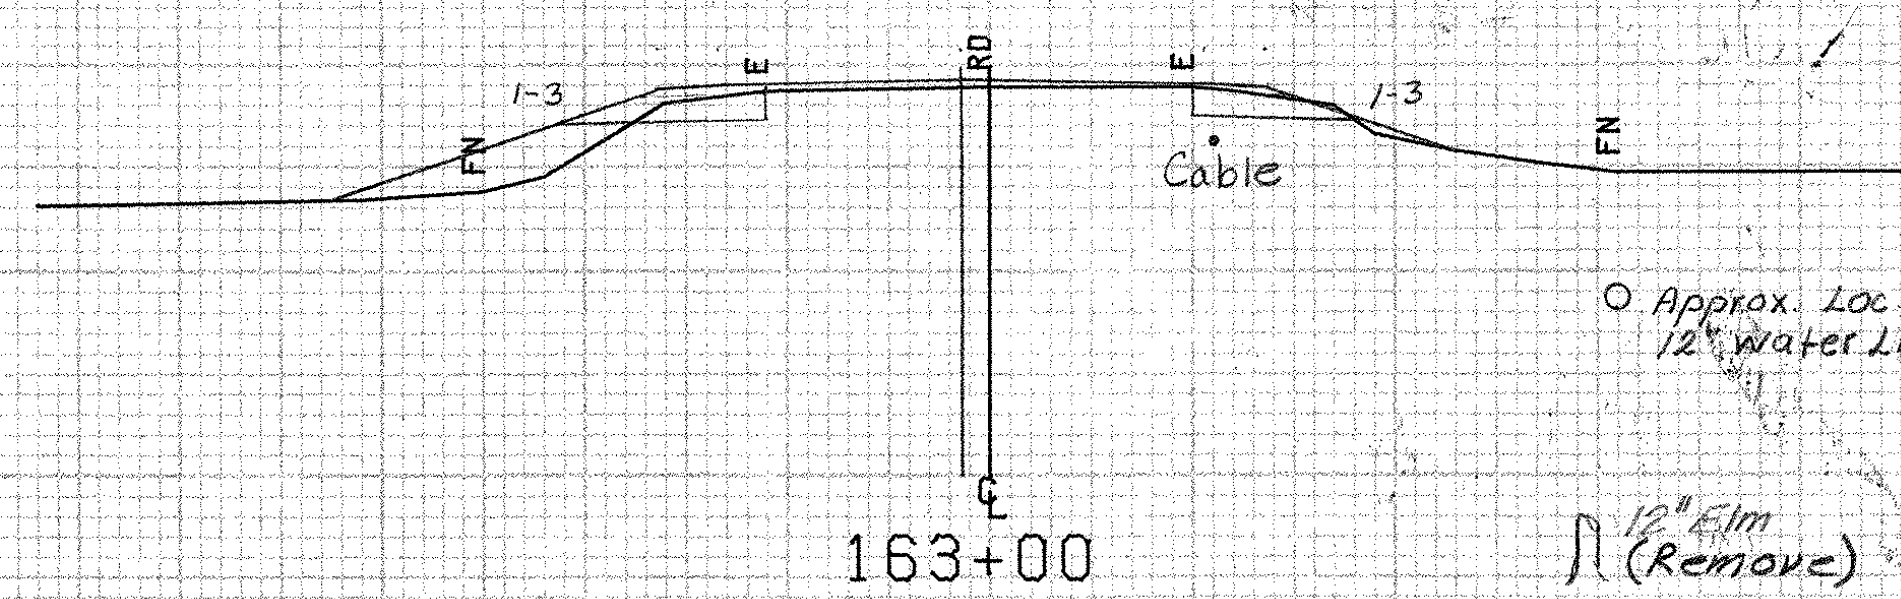

460

BRIDPORT MM 0.18 ~ MM 0.29

FROM STA. 163+00	TO STA. 163+00
PROJECT NAME SHOREHAM-BRIDPORT-ADDISON	
NO. F017-1(2)	PLOTTED 02/10/84
SURVEYED BY FANTONI	JAN 1984
SHEET 287 OF 440 SHEETS	SHEET 289 OF 477

SCALE 10 FEET