
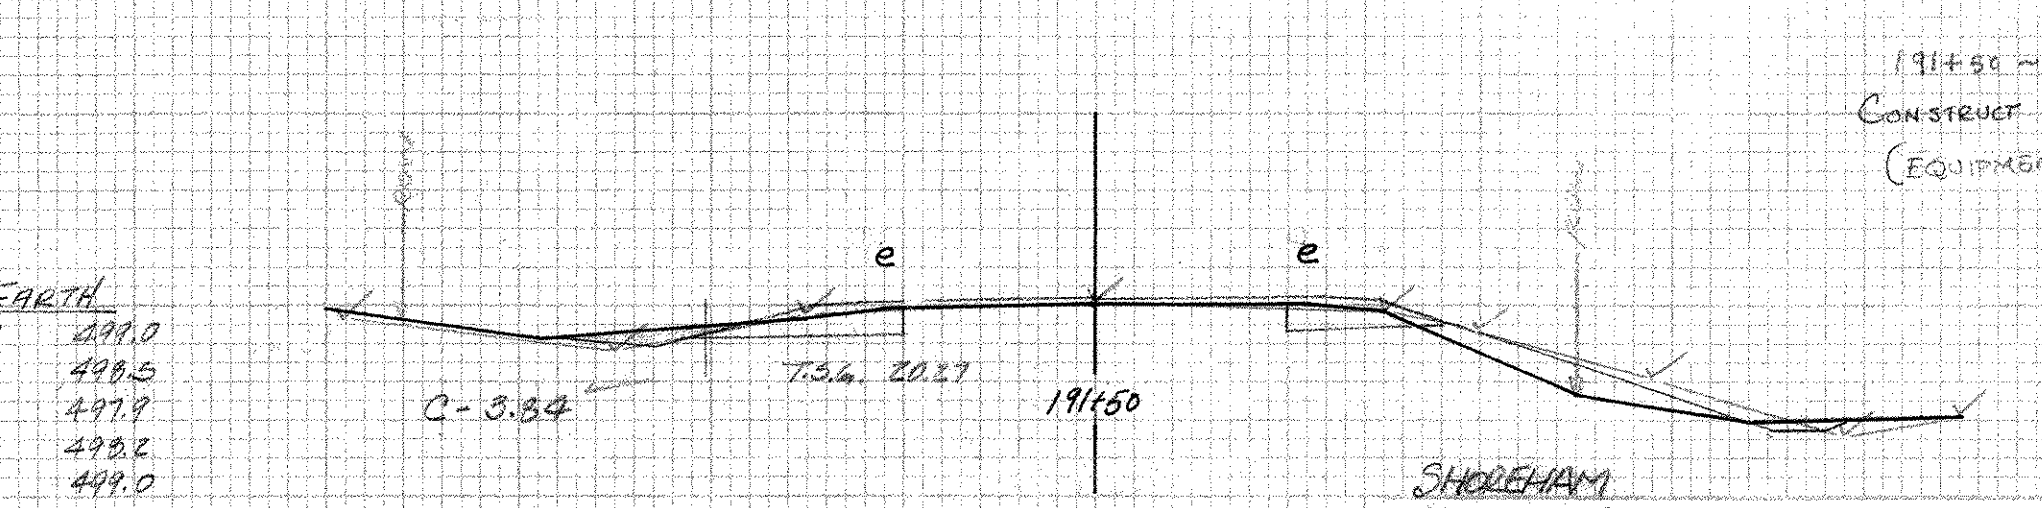
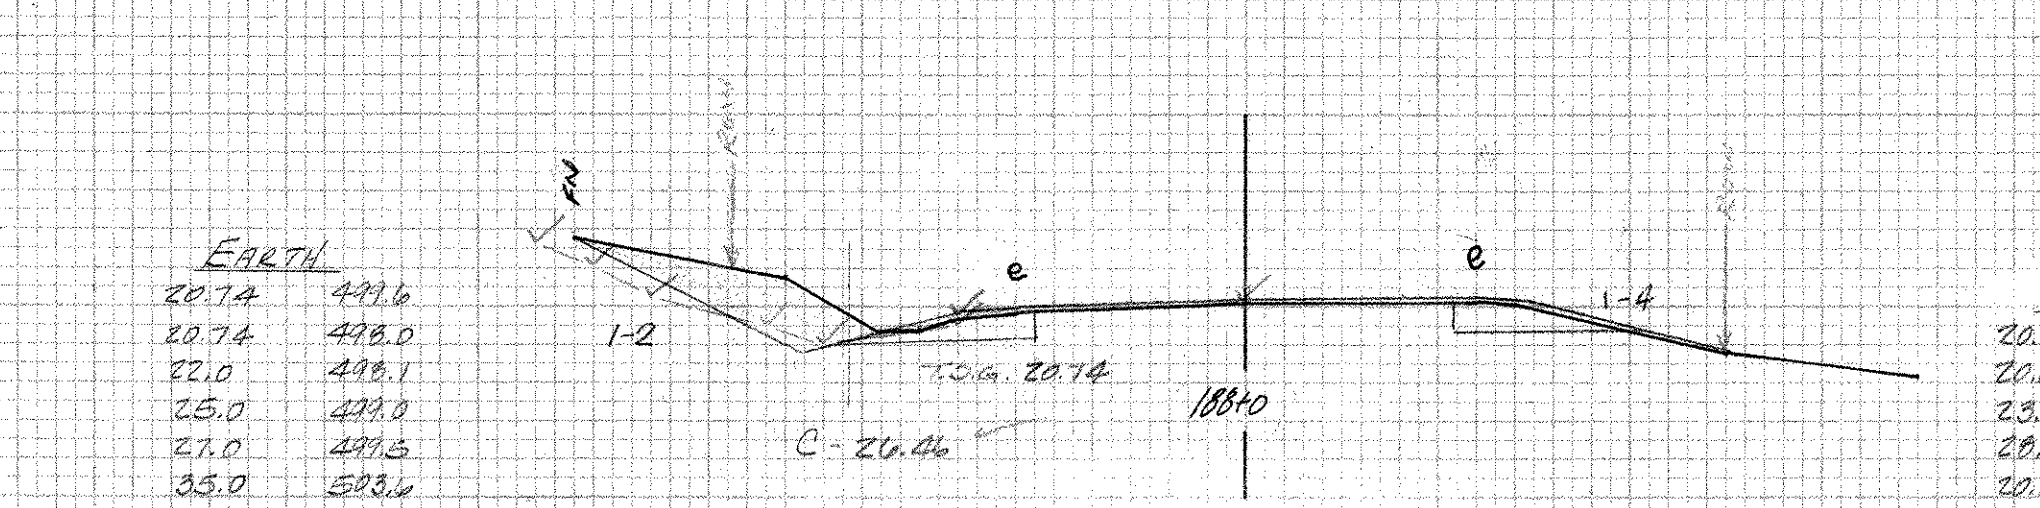
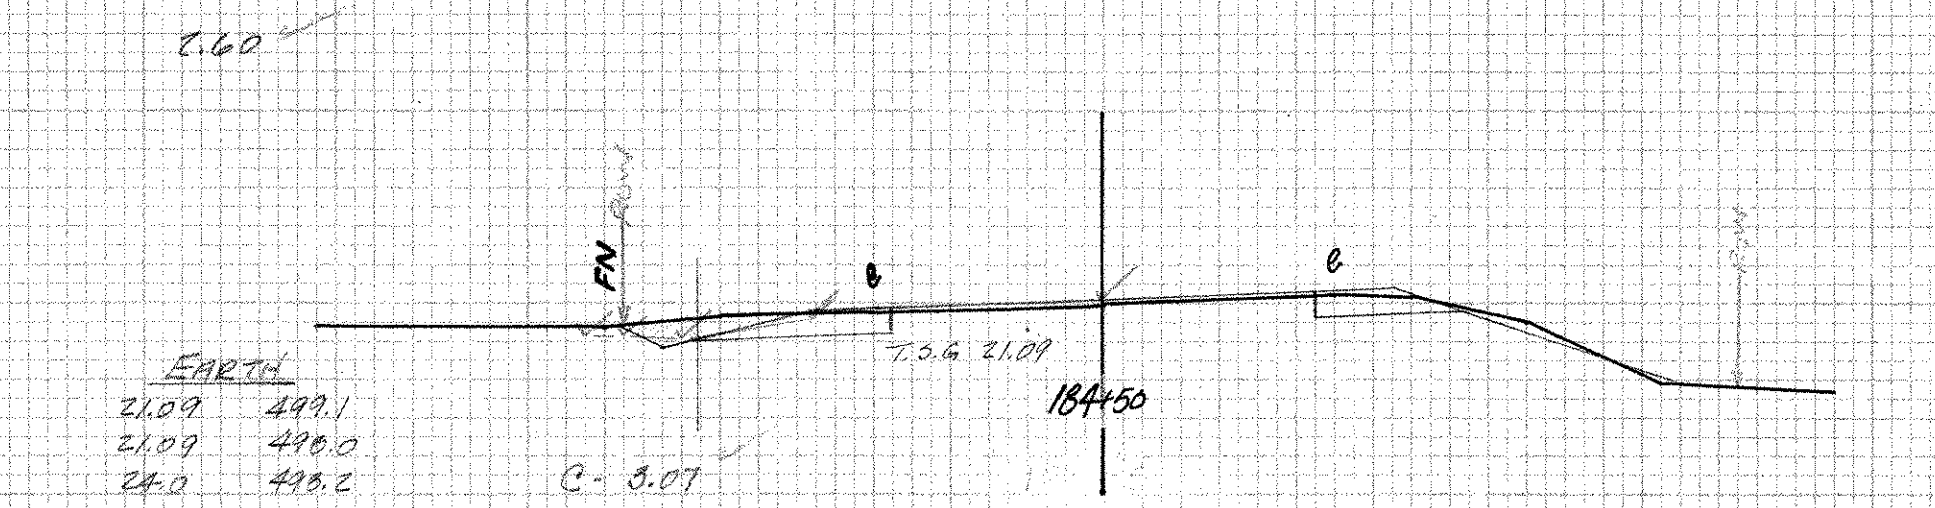
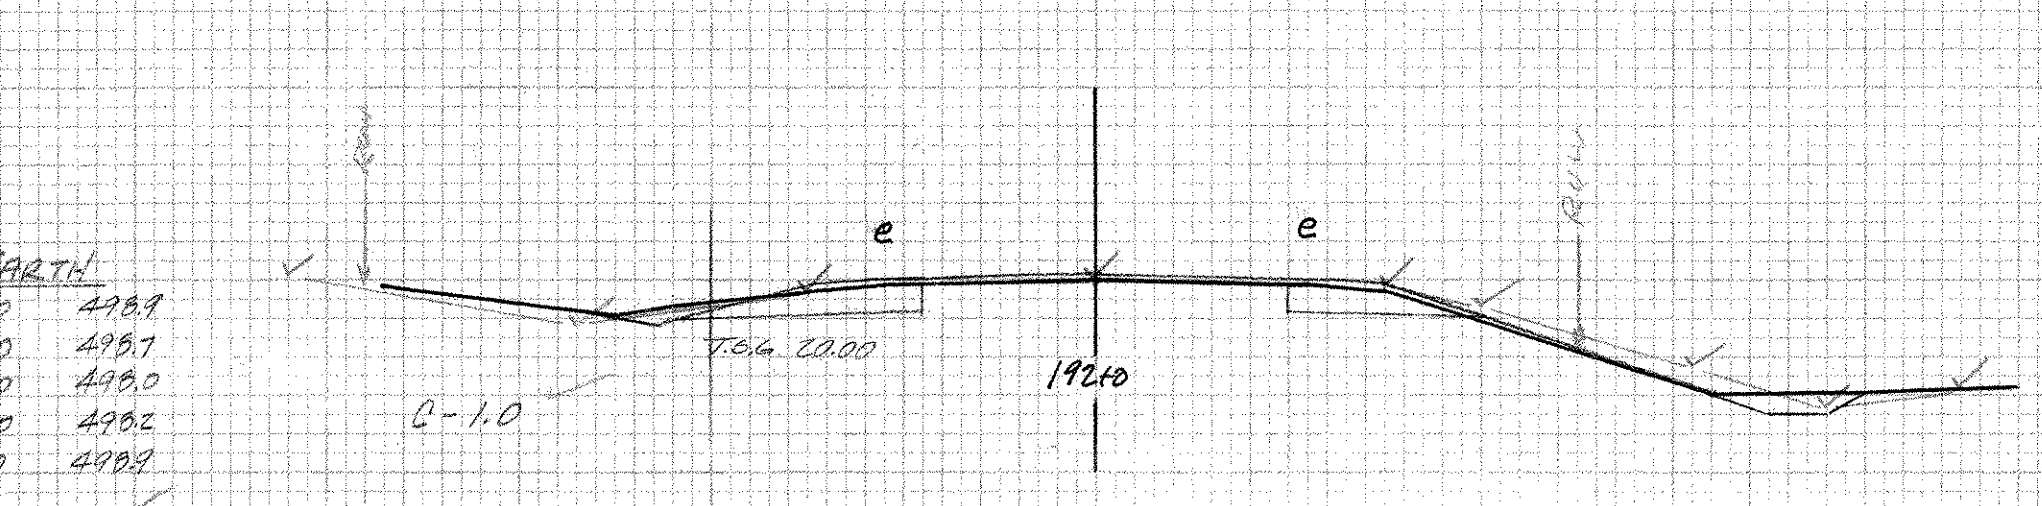
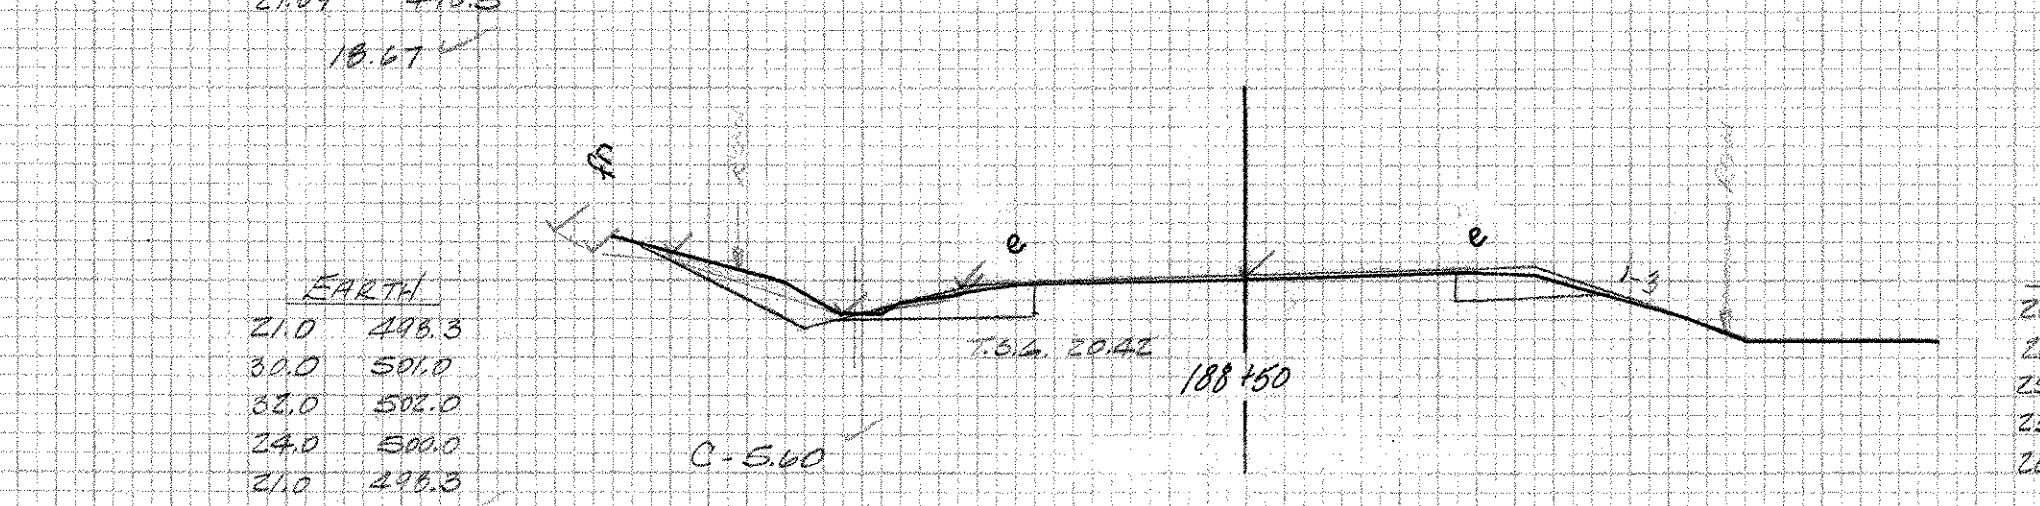
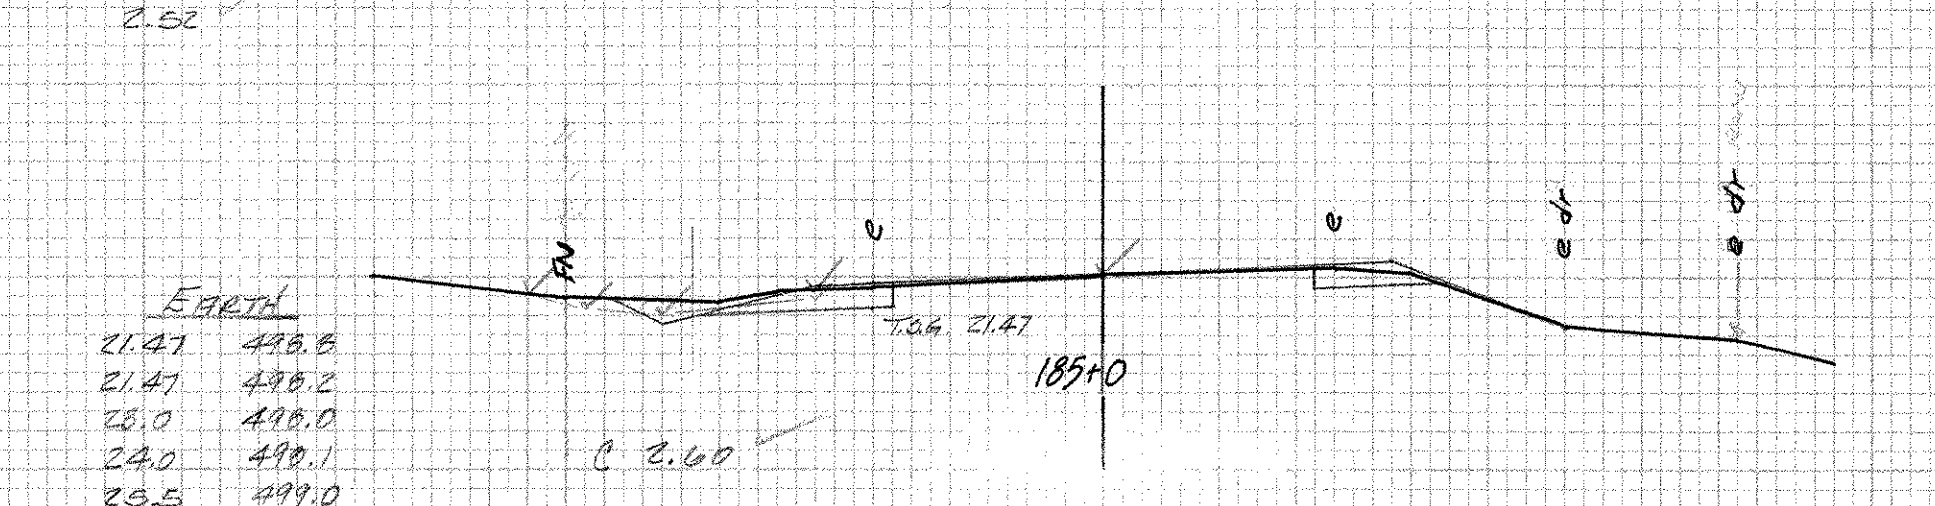
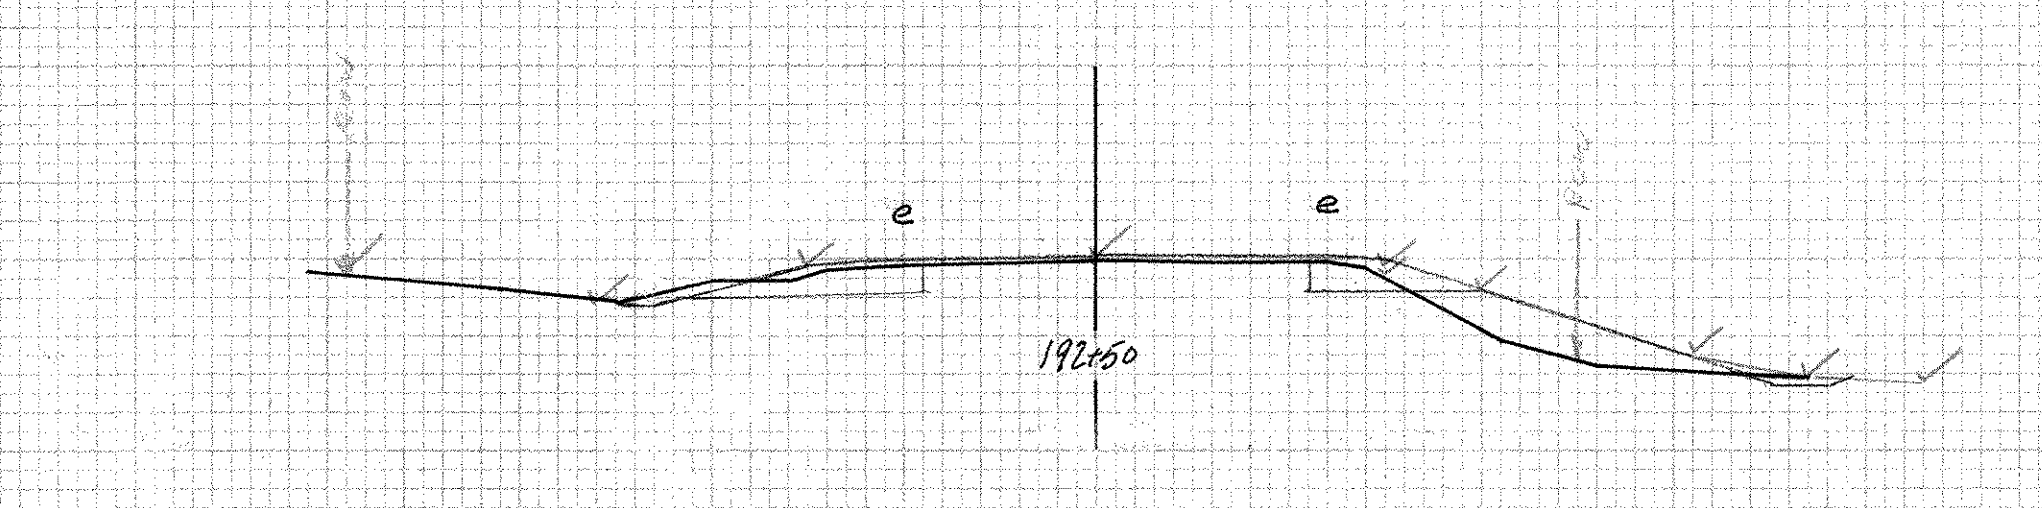
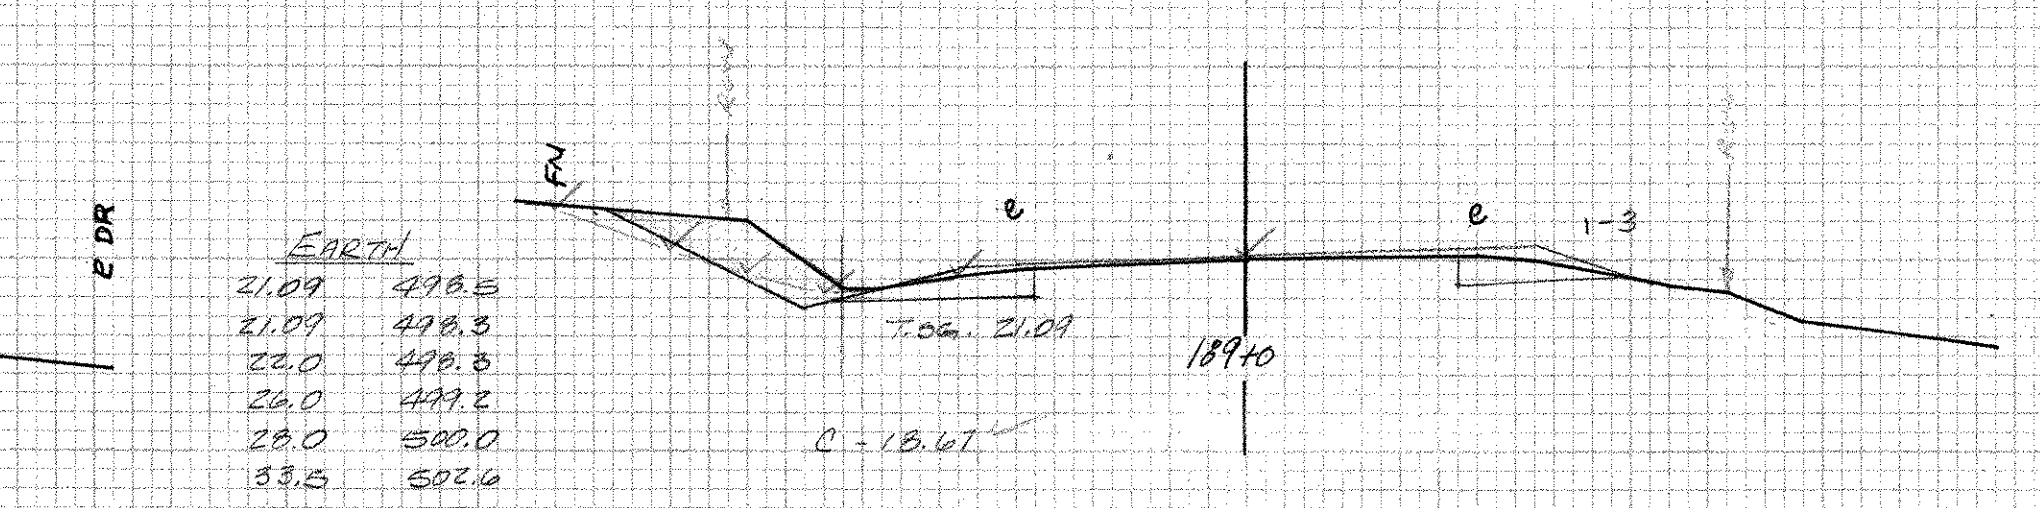
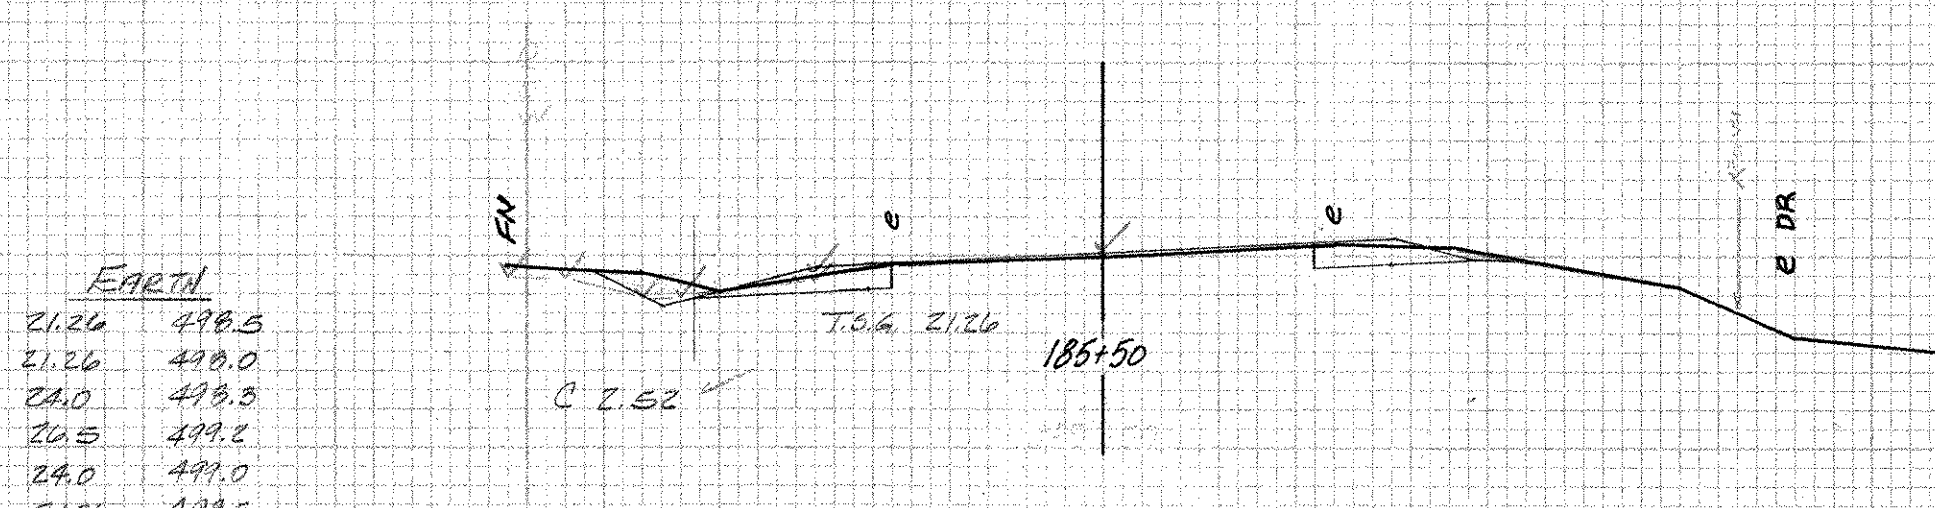
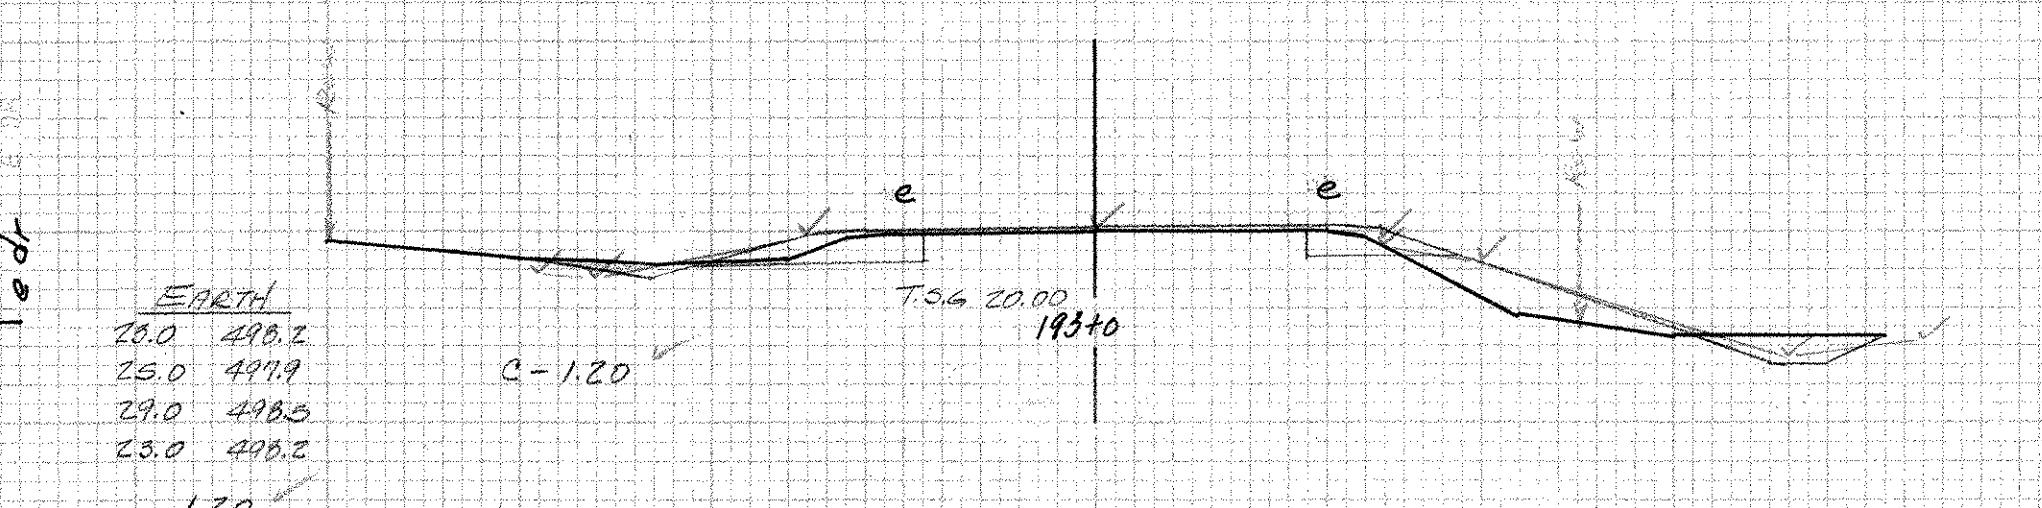
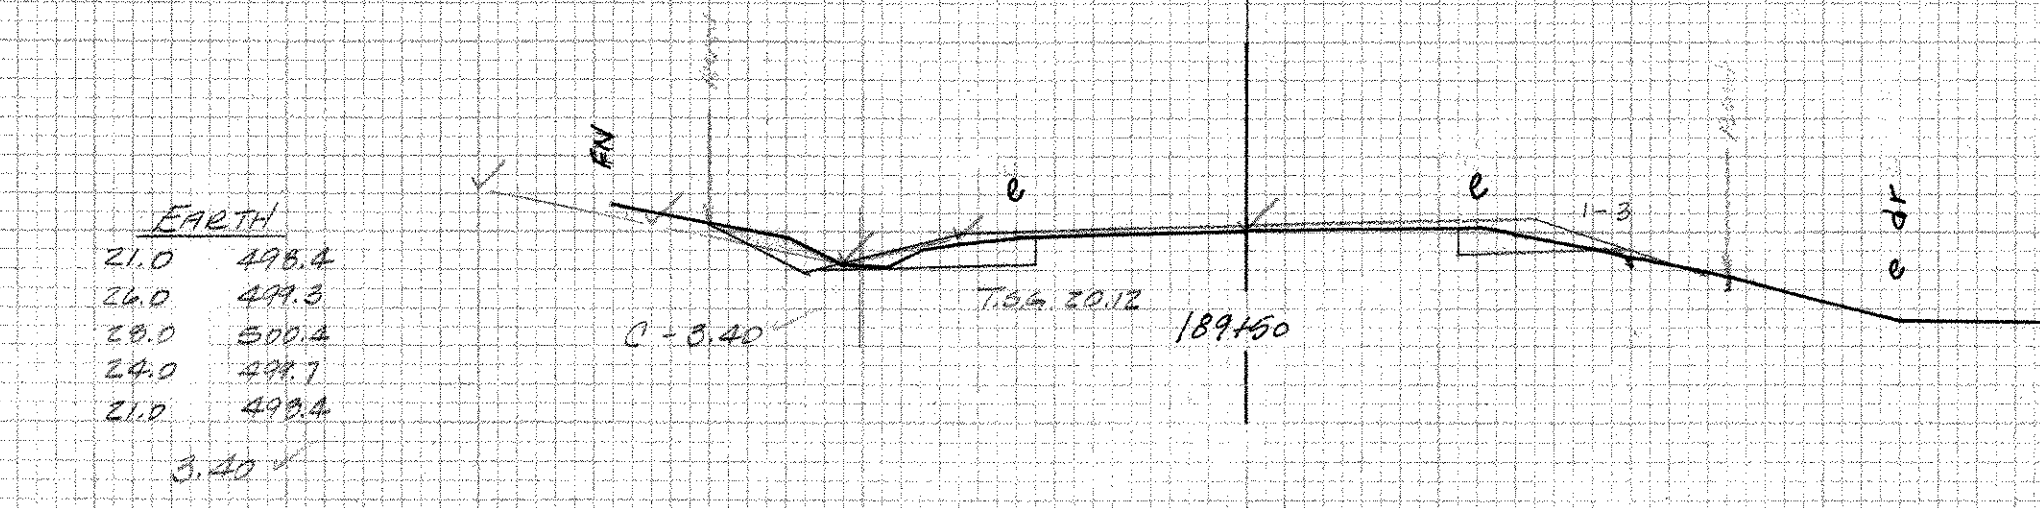
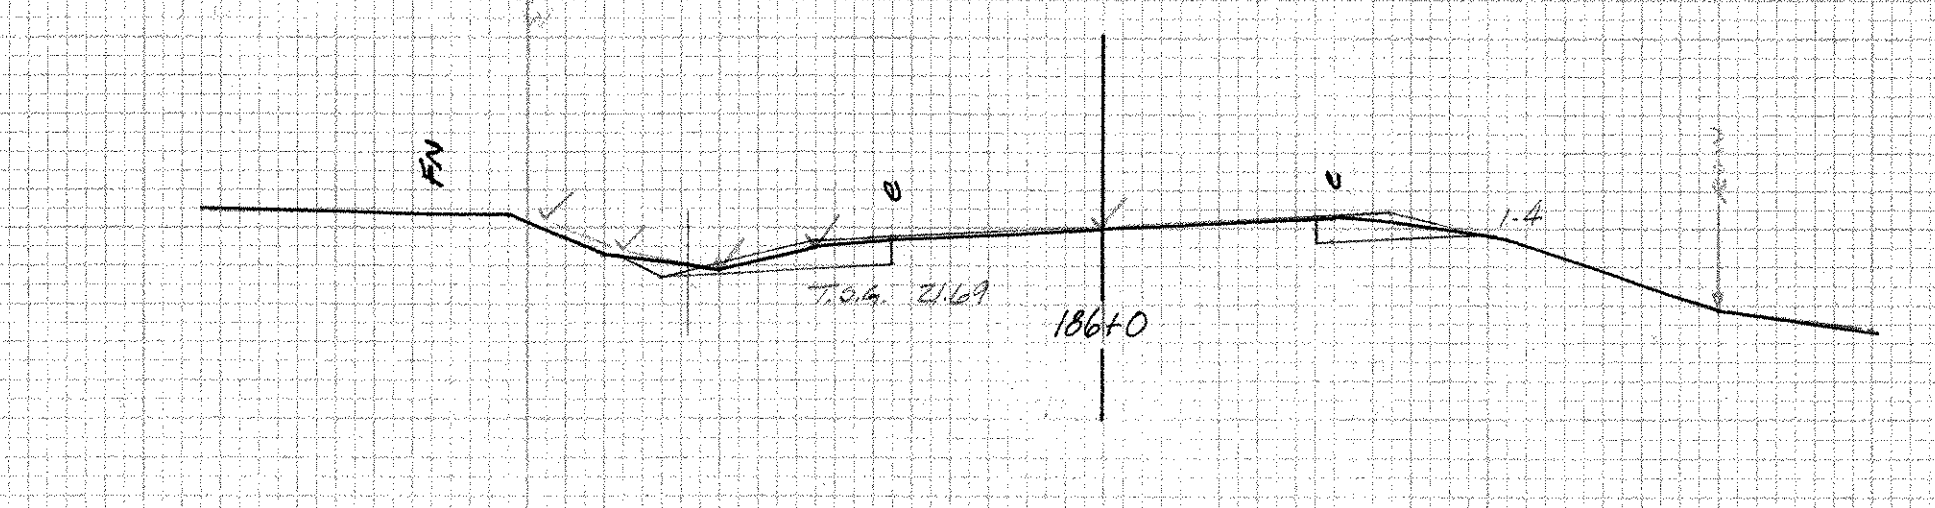
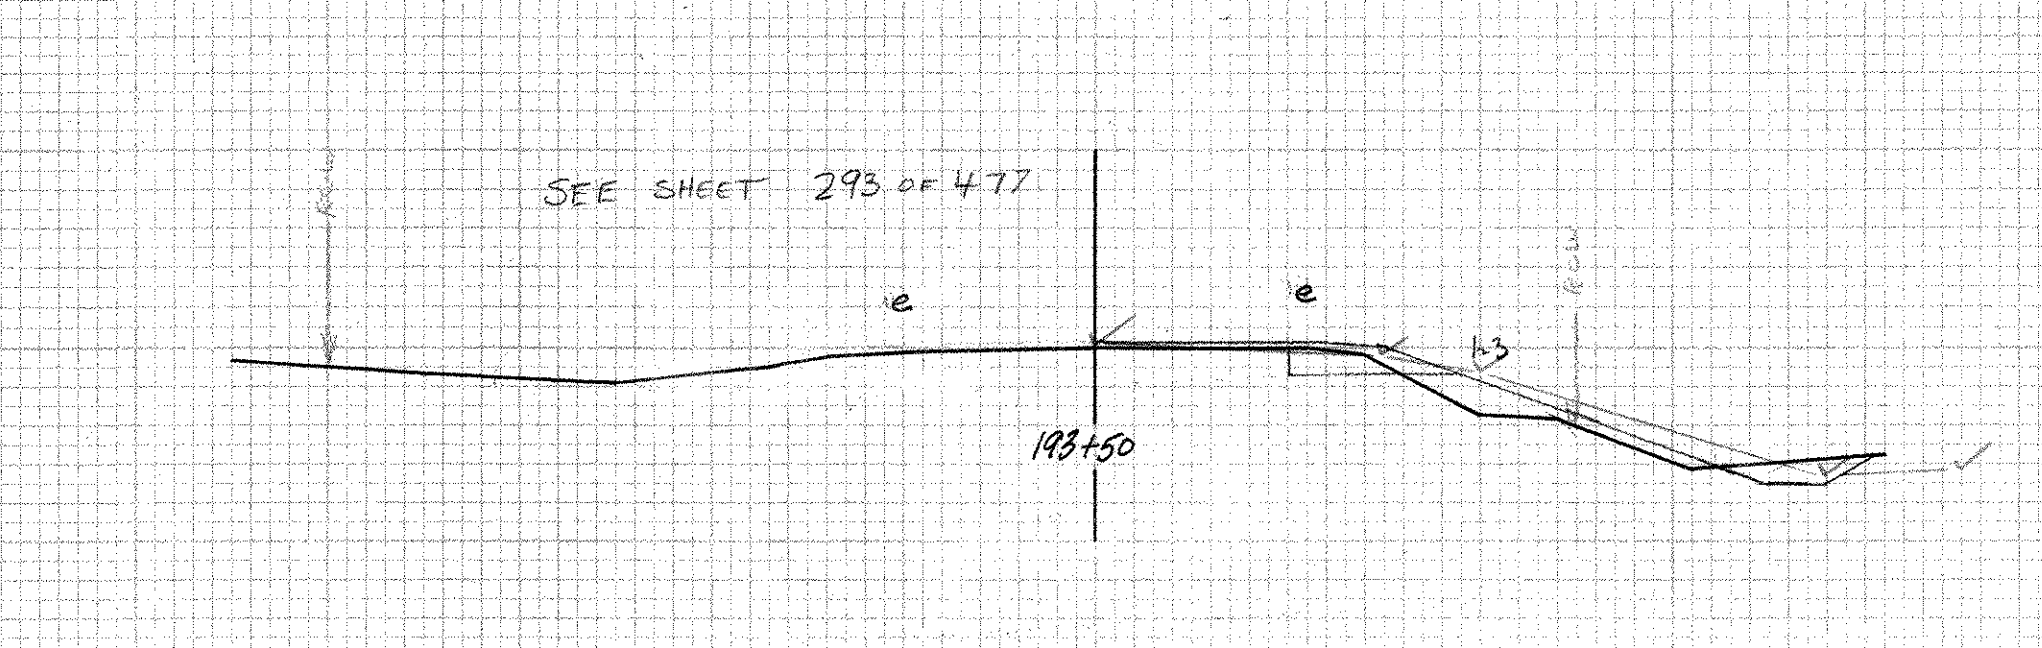
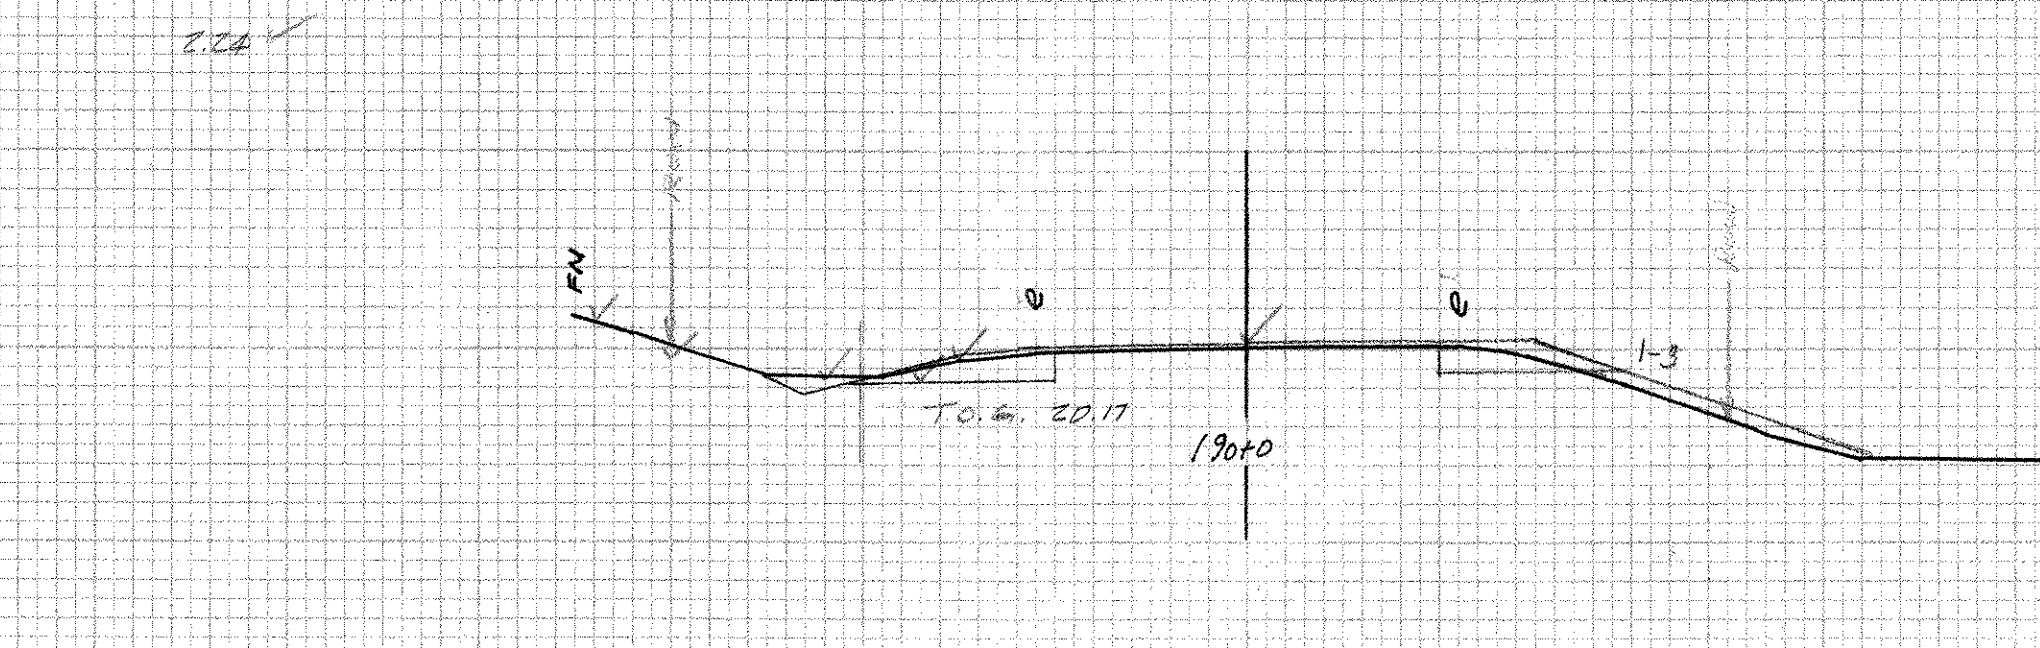
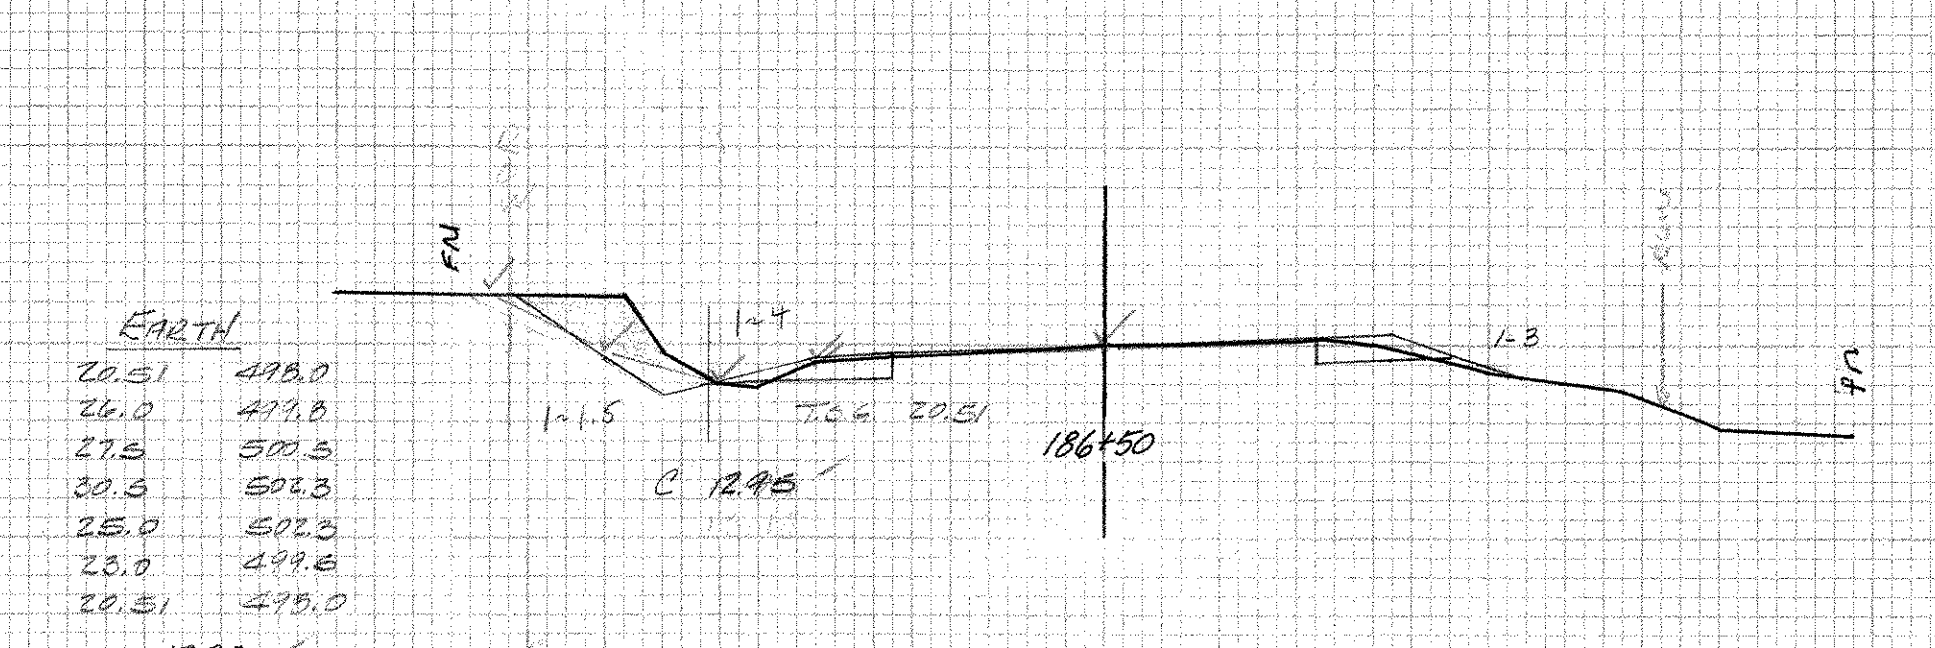
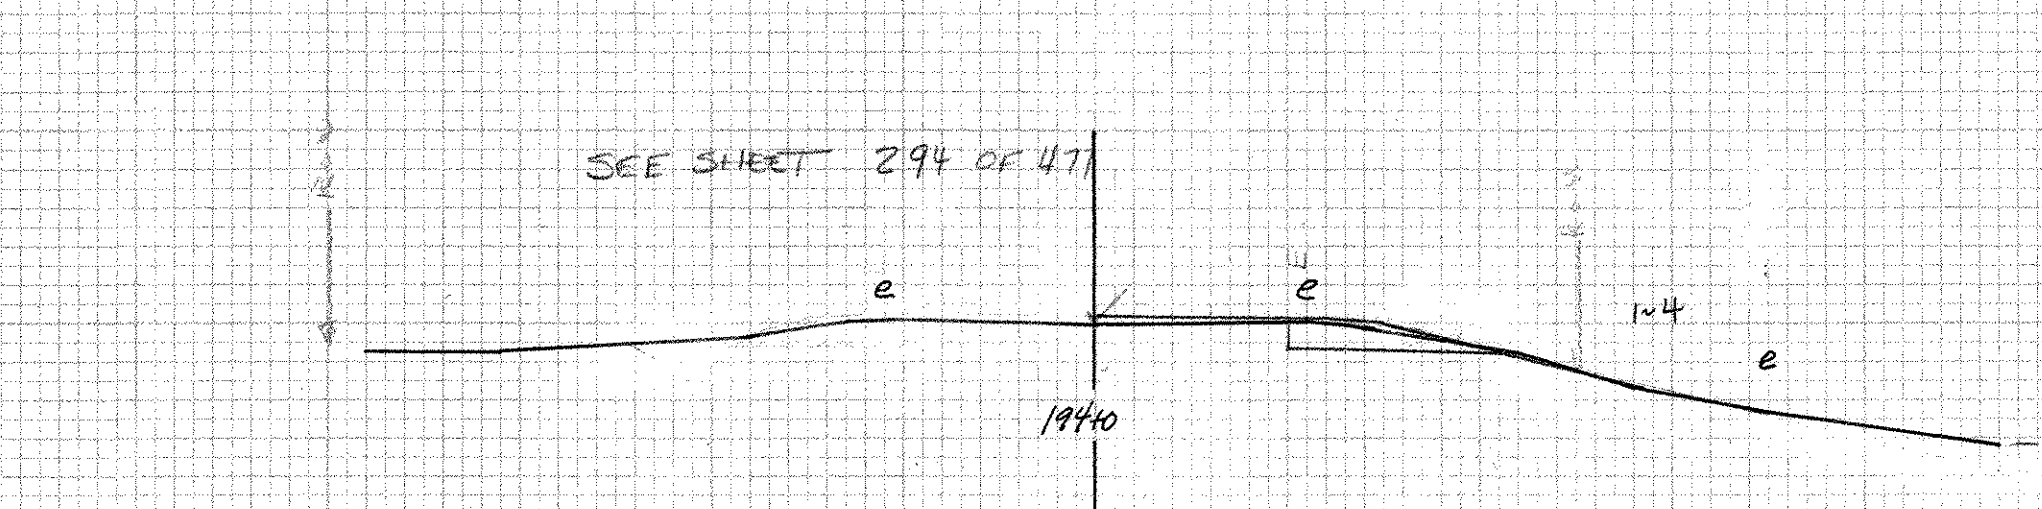
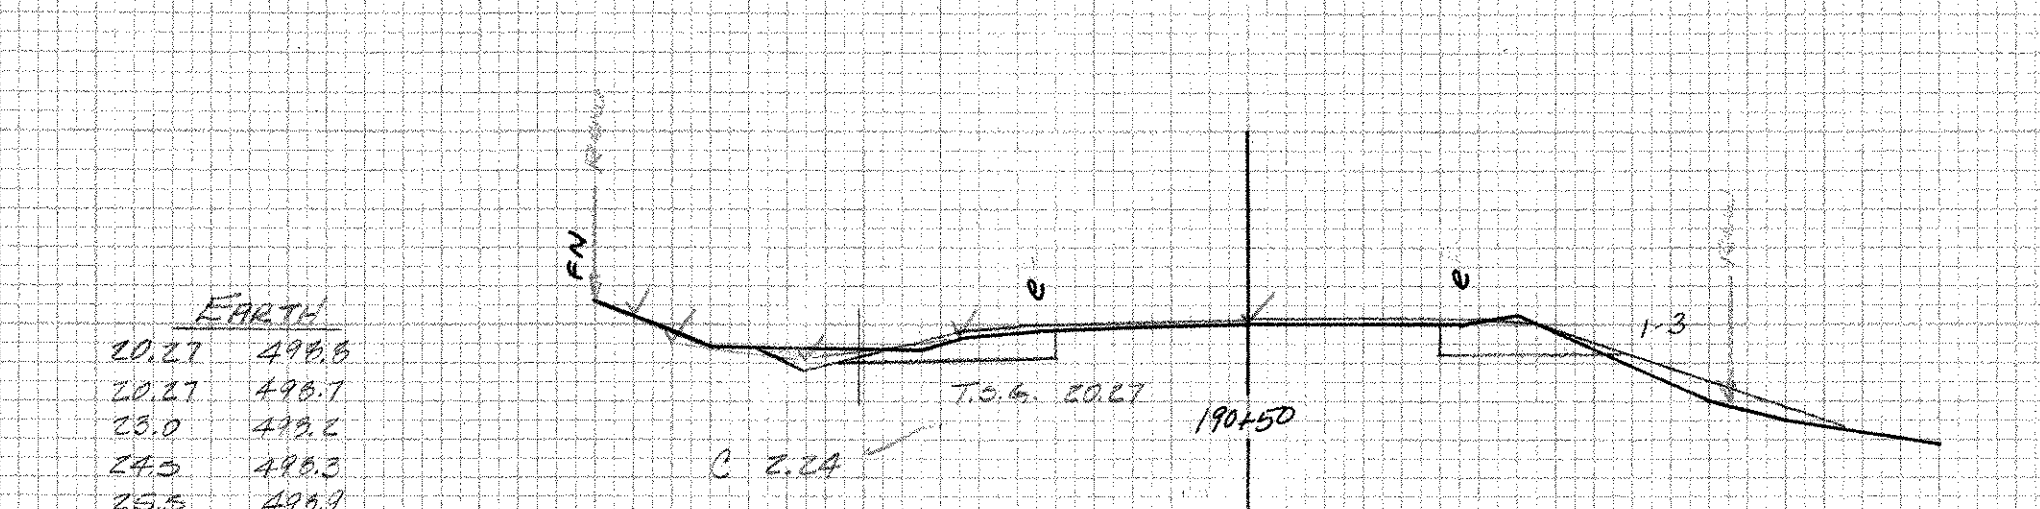
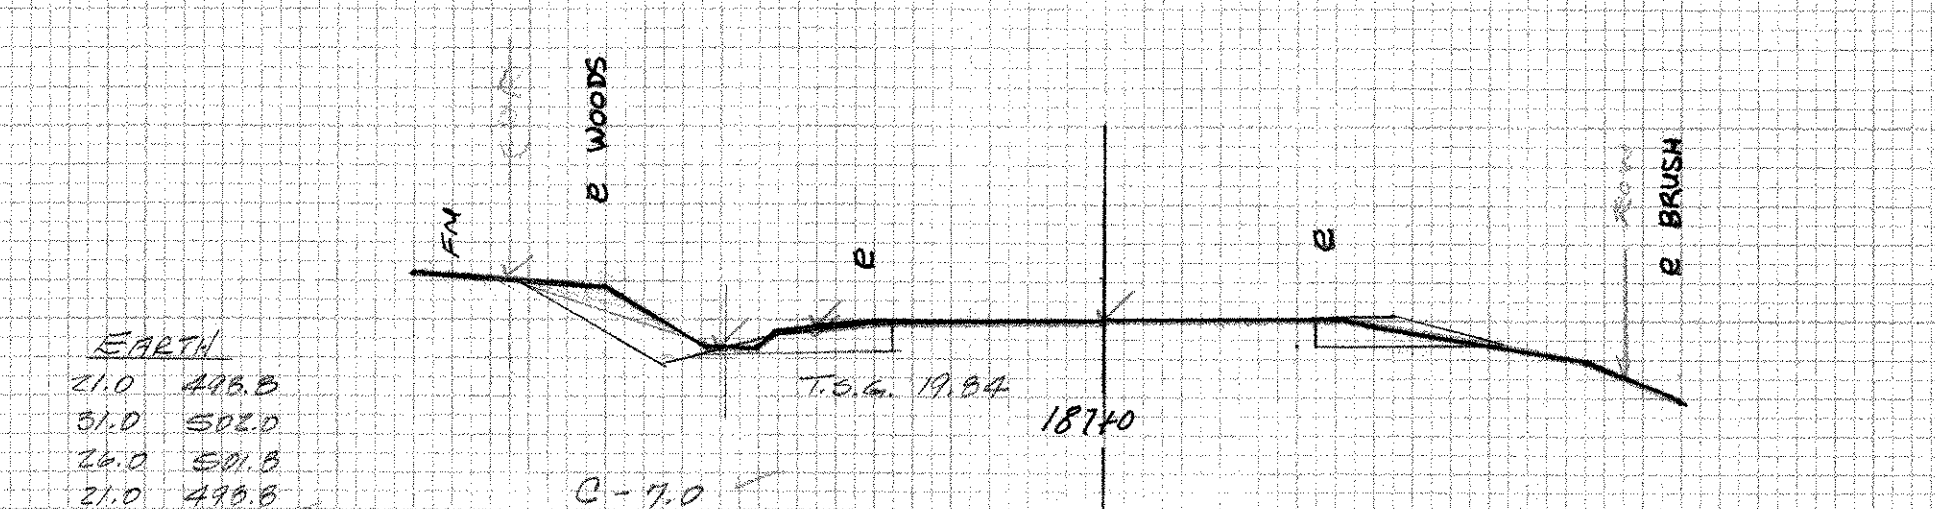
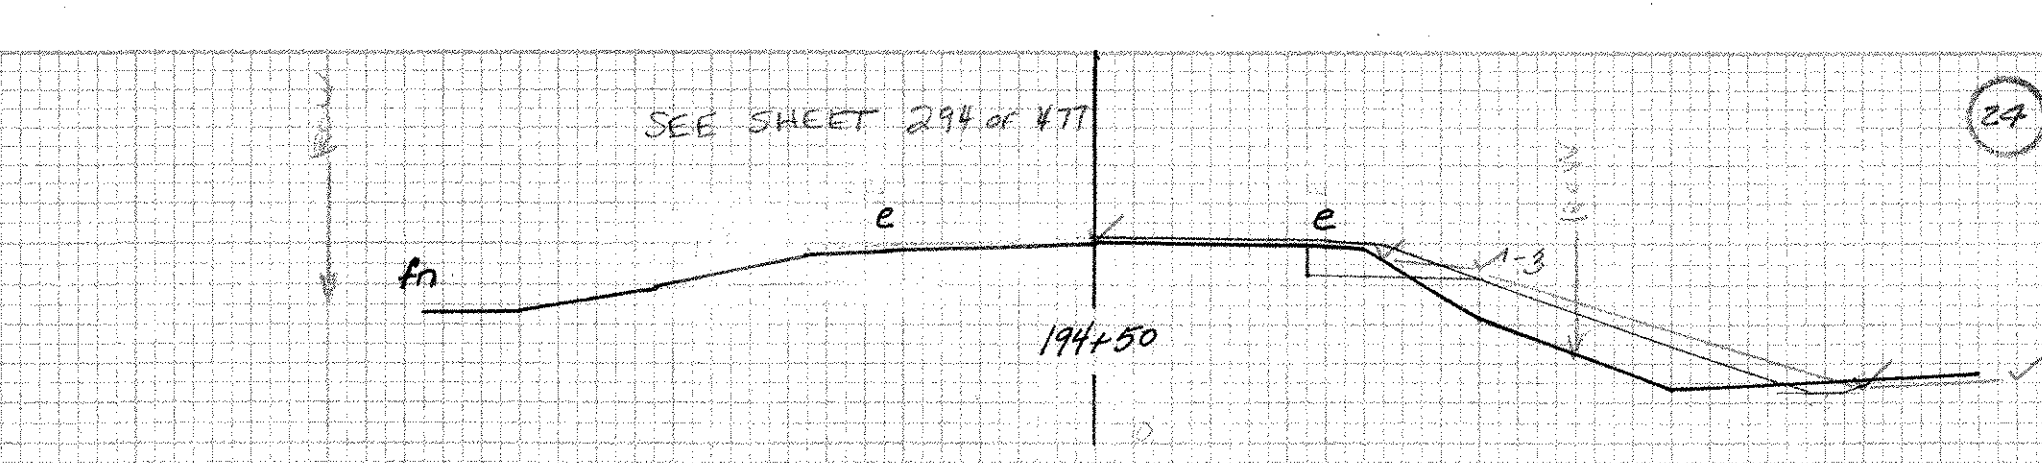
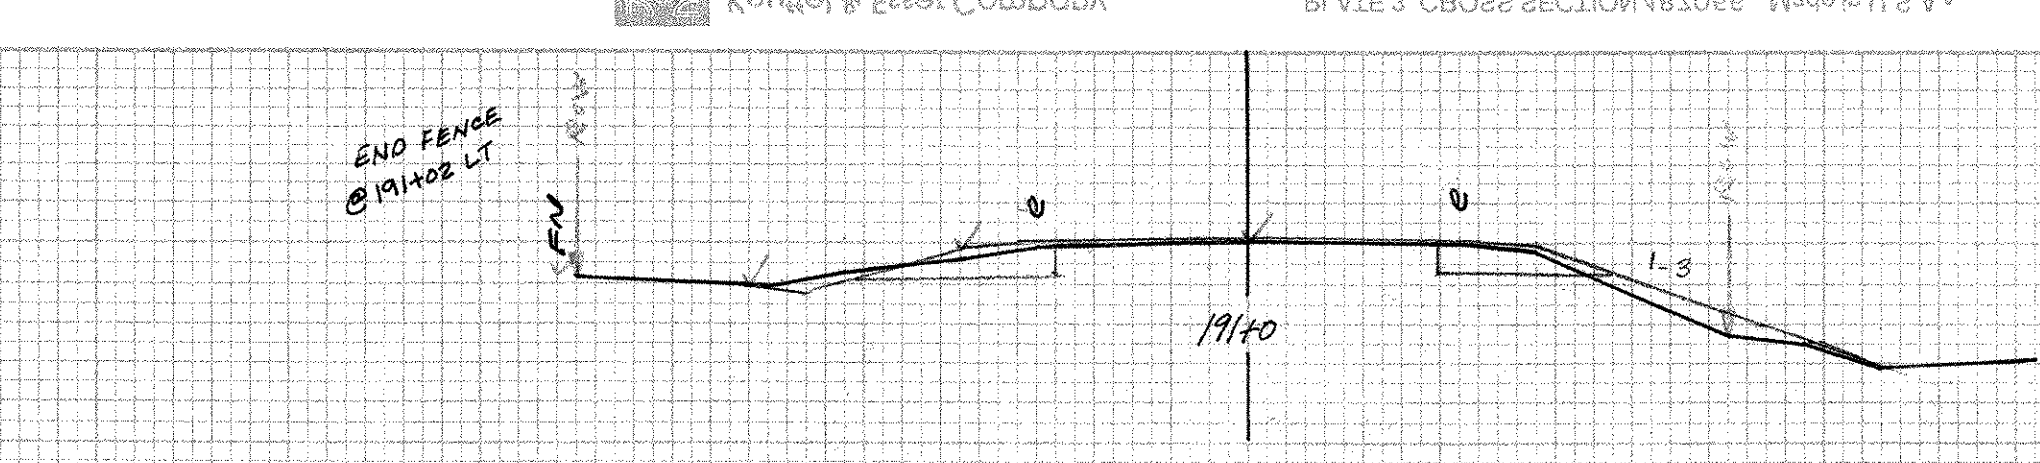


DATE	BY	SCALE	REVISIONS

DATE	BY	SCALE	REVISIONS

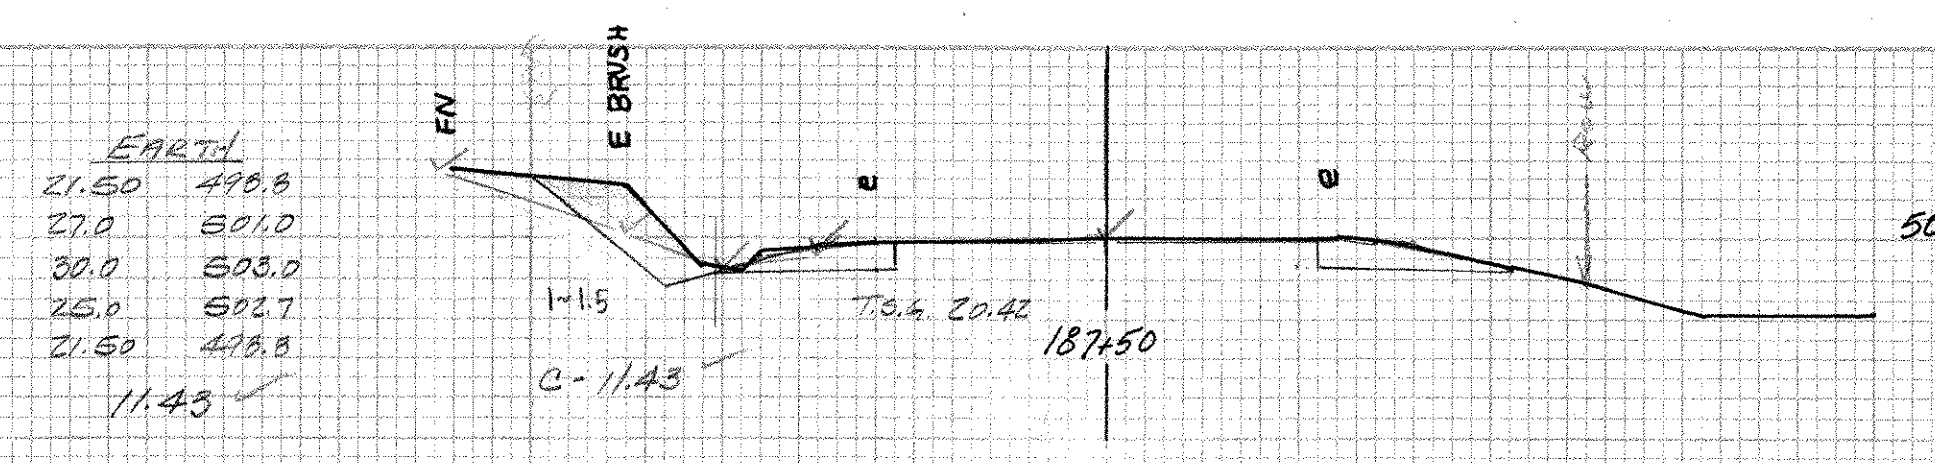

191+50 - 205+00 RT
 CONSTRUCT SPECIAL DITCH
 (EQUIPMENT RENTAL)

SHOREHAM BRIDPORT ADDISON ORIGINAL SECTIONS F-017-1(2) 11-70

184+50 - 194+50 SH 20-80F 477

DEC 14/1990