



DATE _____ BY _____
 SURVEYED _____ PLOTTED _____
 ORIGINAL SURVEY NOTE BOOK TEMPLATE AREAS CHECKED
 NO. _____

DATE _____ BY _____
 SURVEYED _____ PLOTTED _____
 ORIGINAL SURVEY NOTE BOOK TEMPLATE AREAS CHECKED
 NO. _____

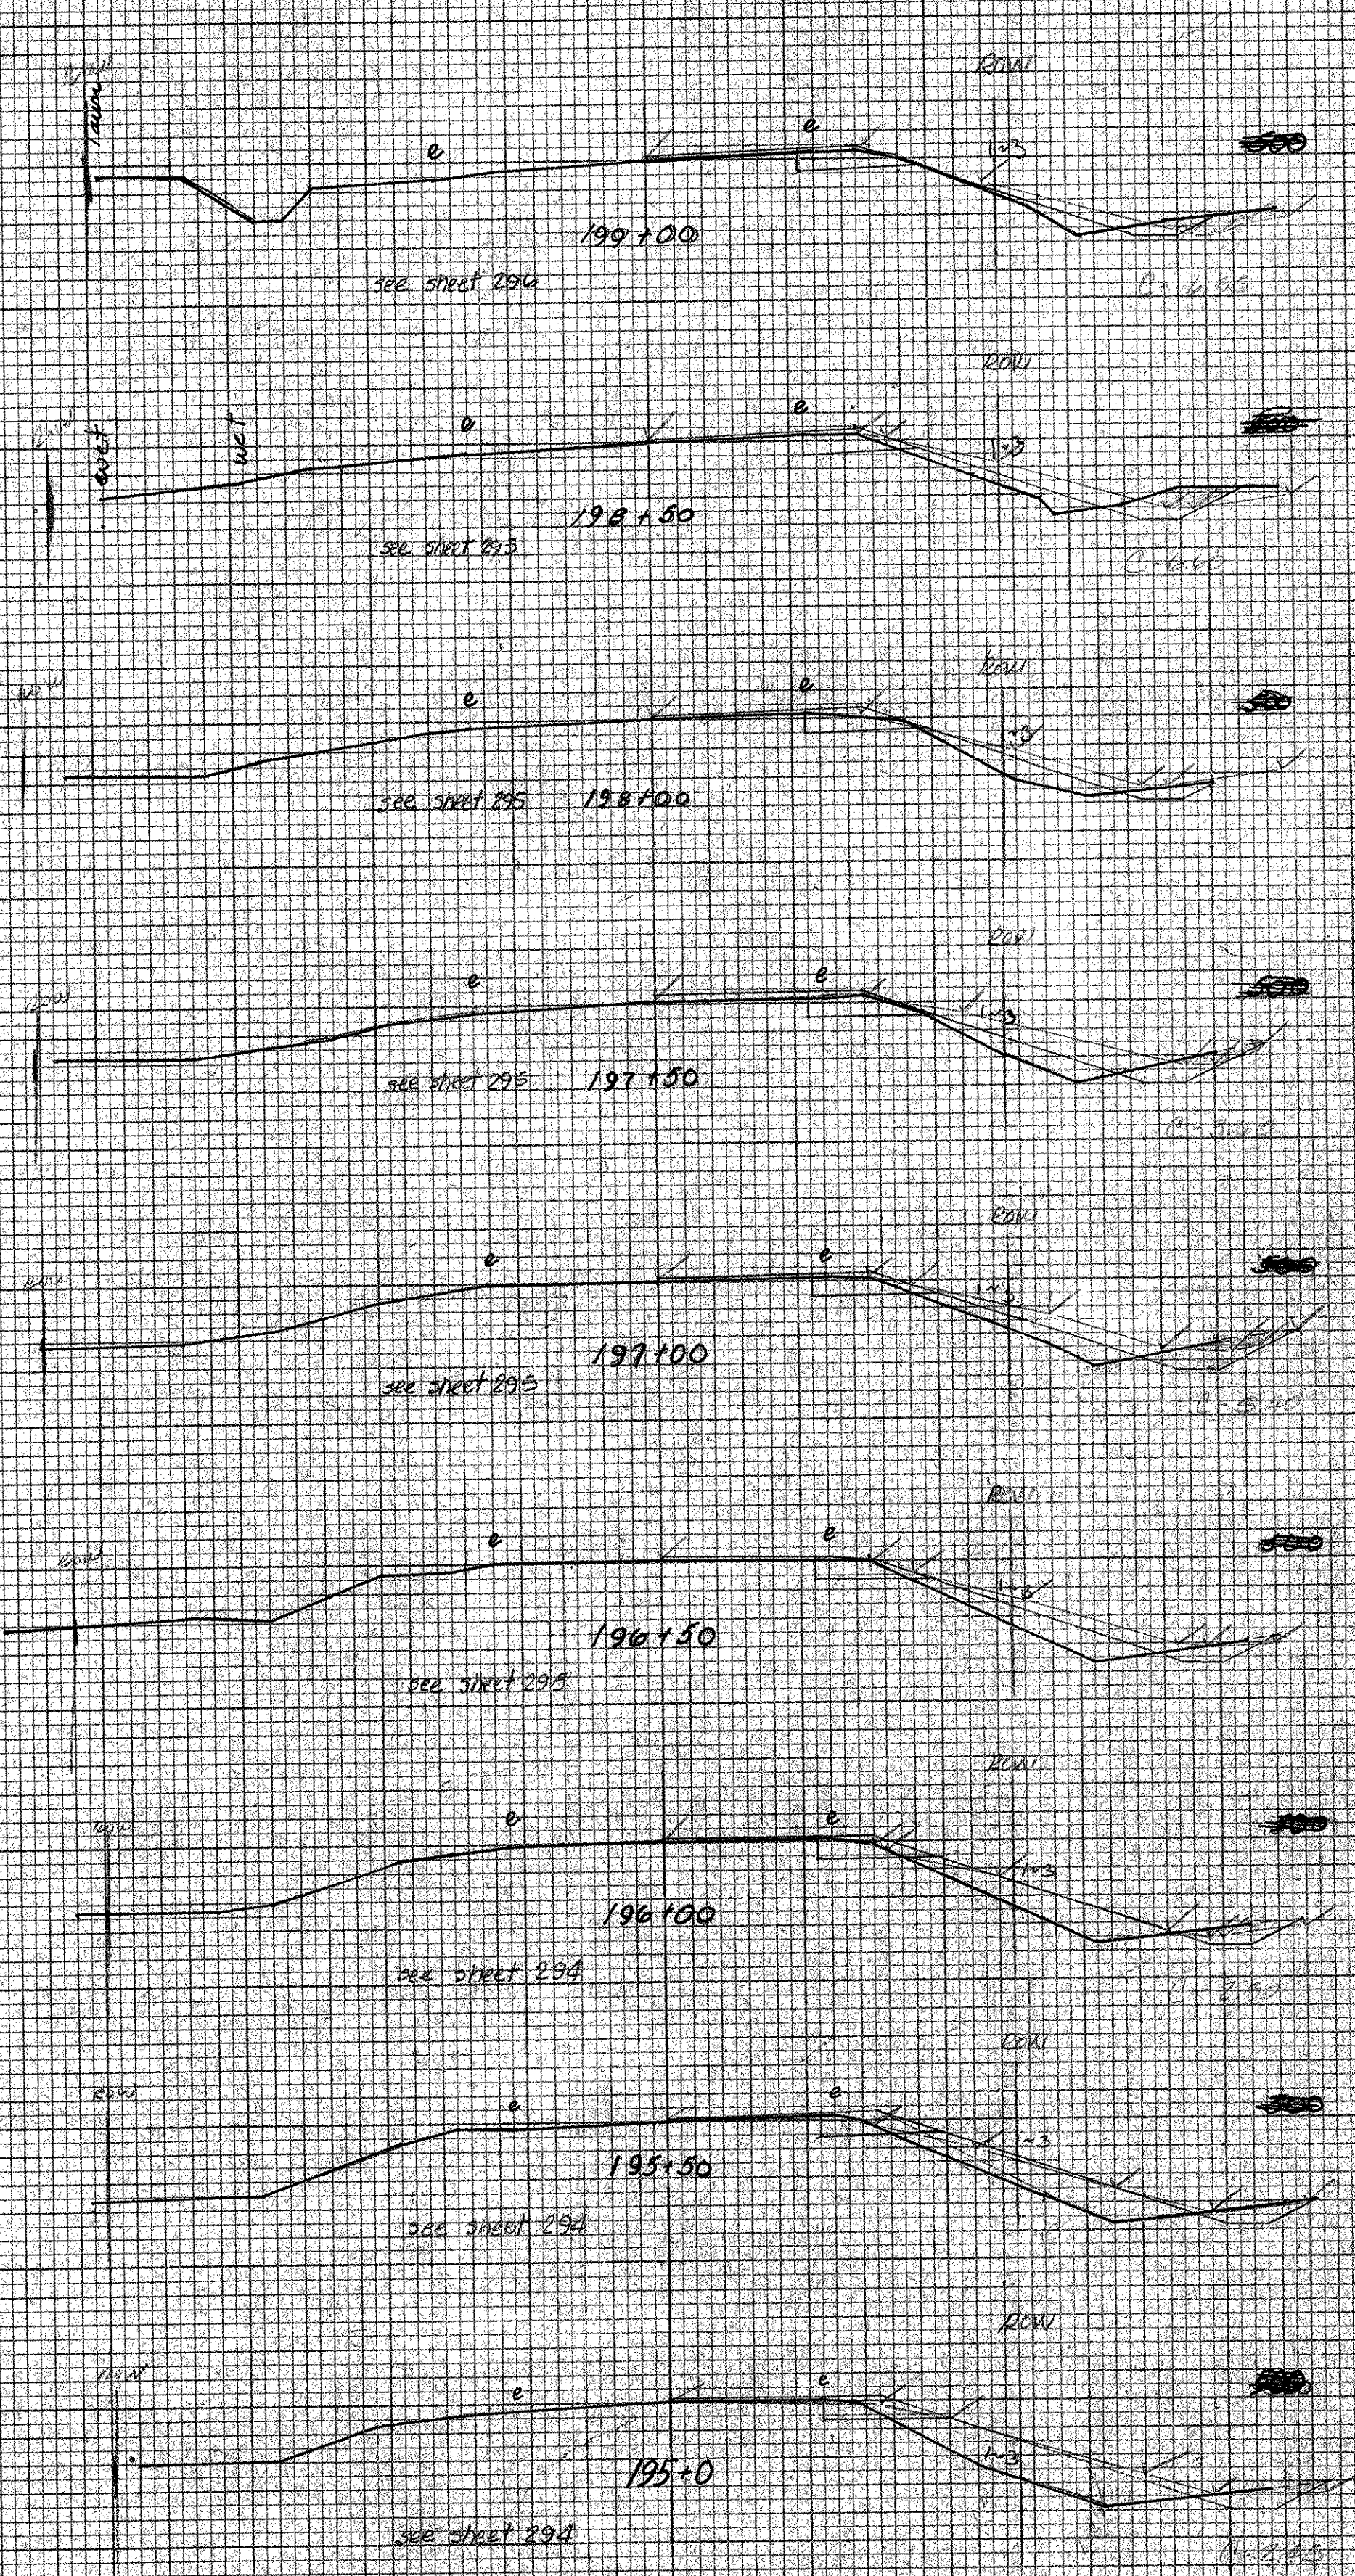

Station	Proposed	Existing
185+0	410	410
185+5	410	410
186+0	410	410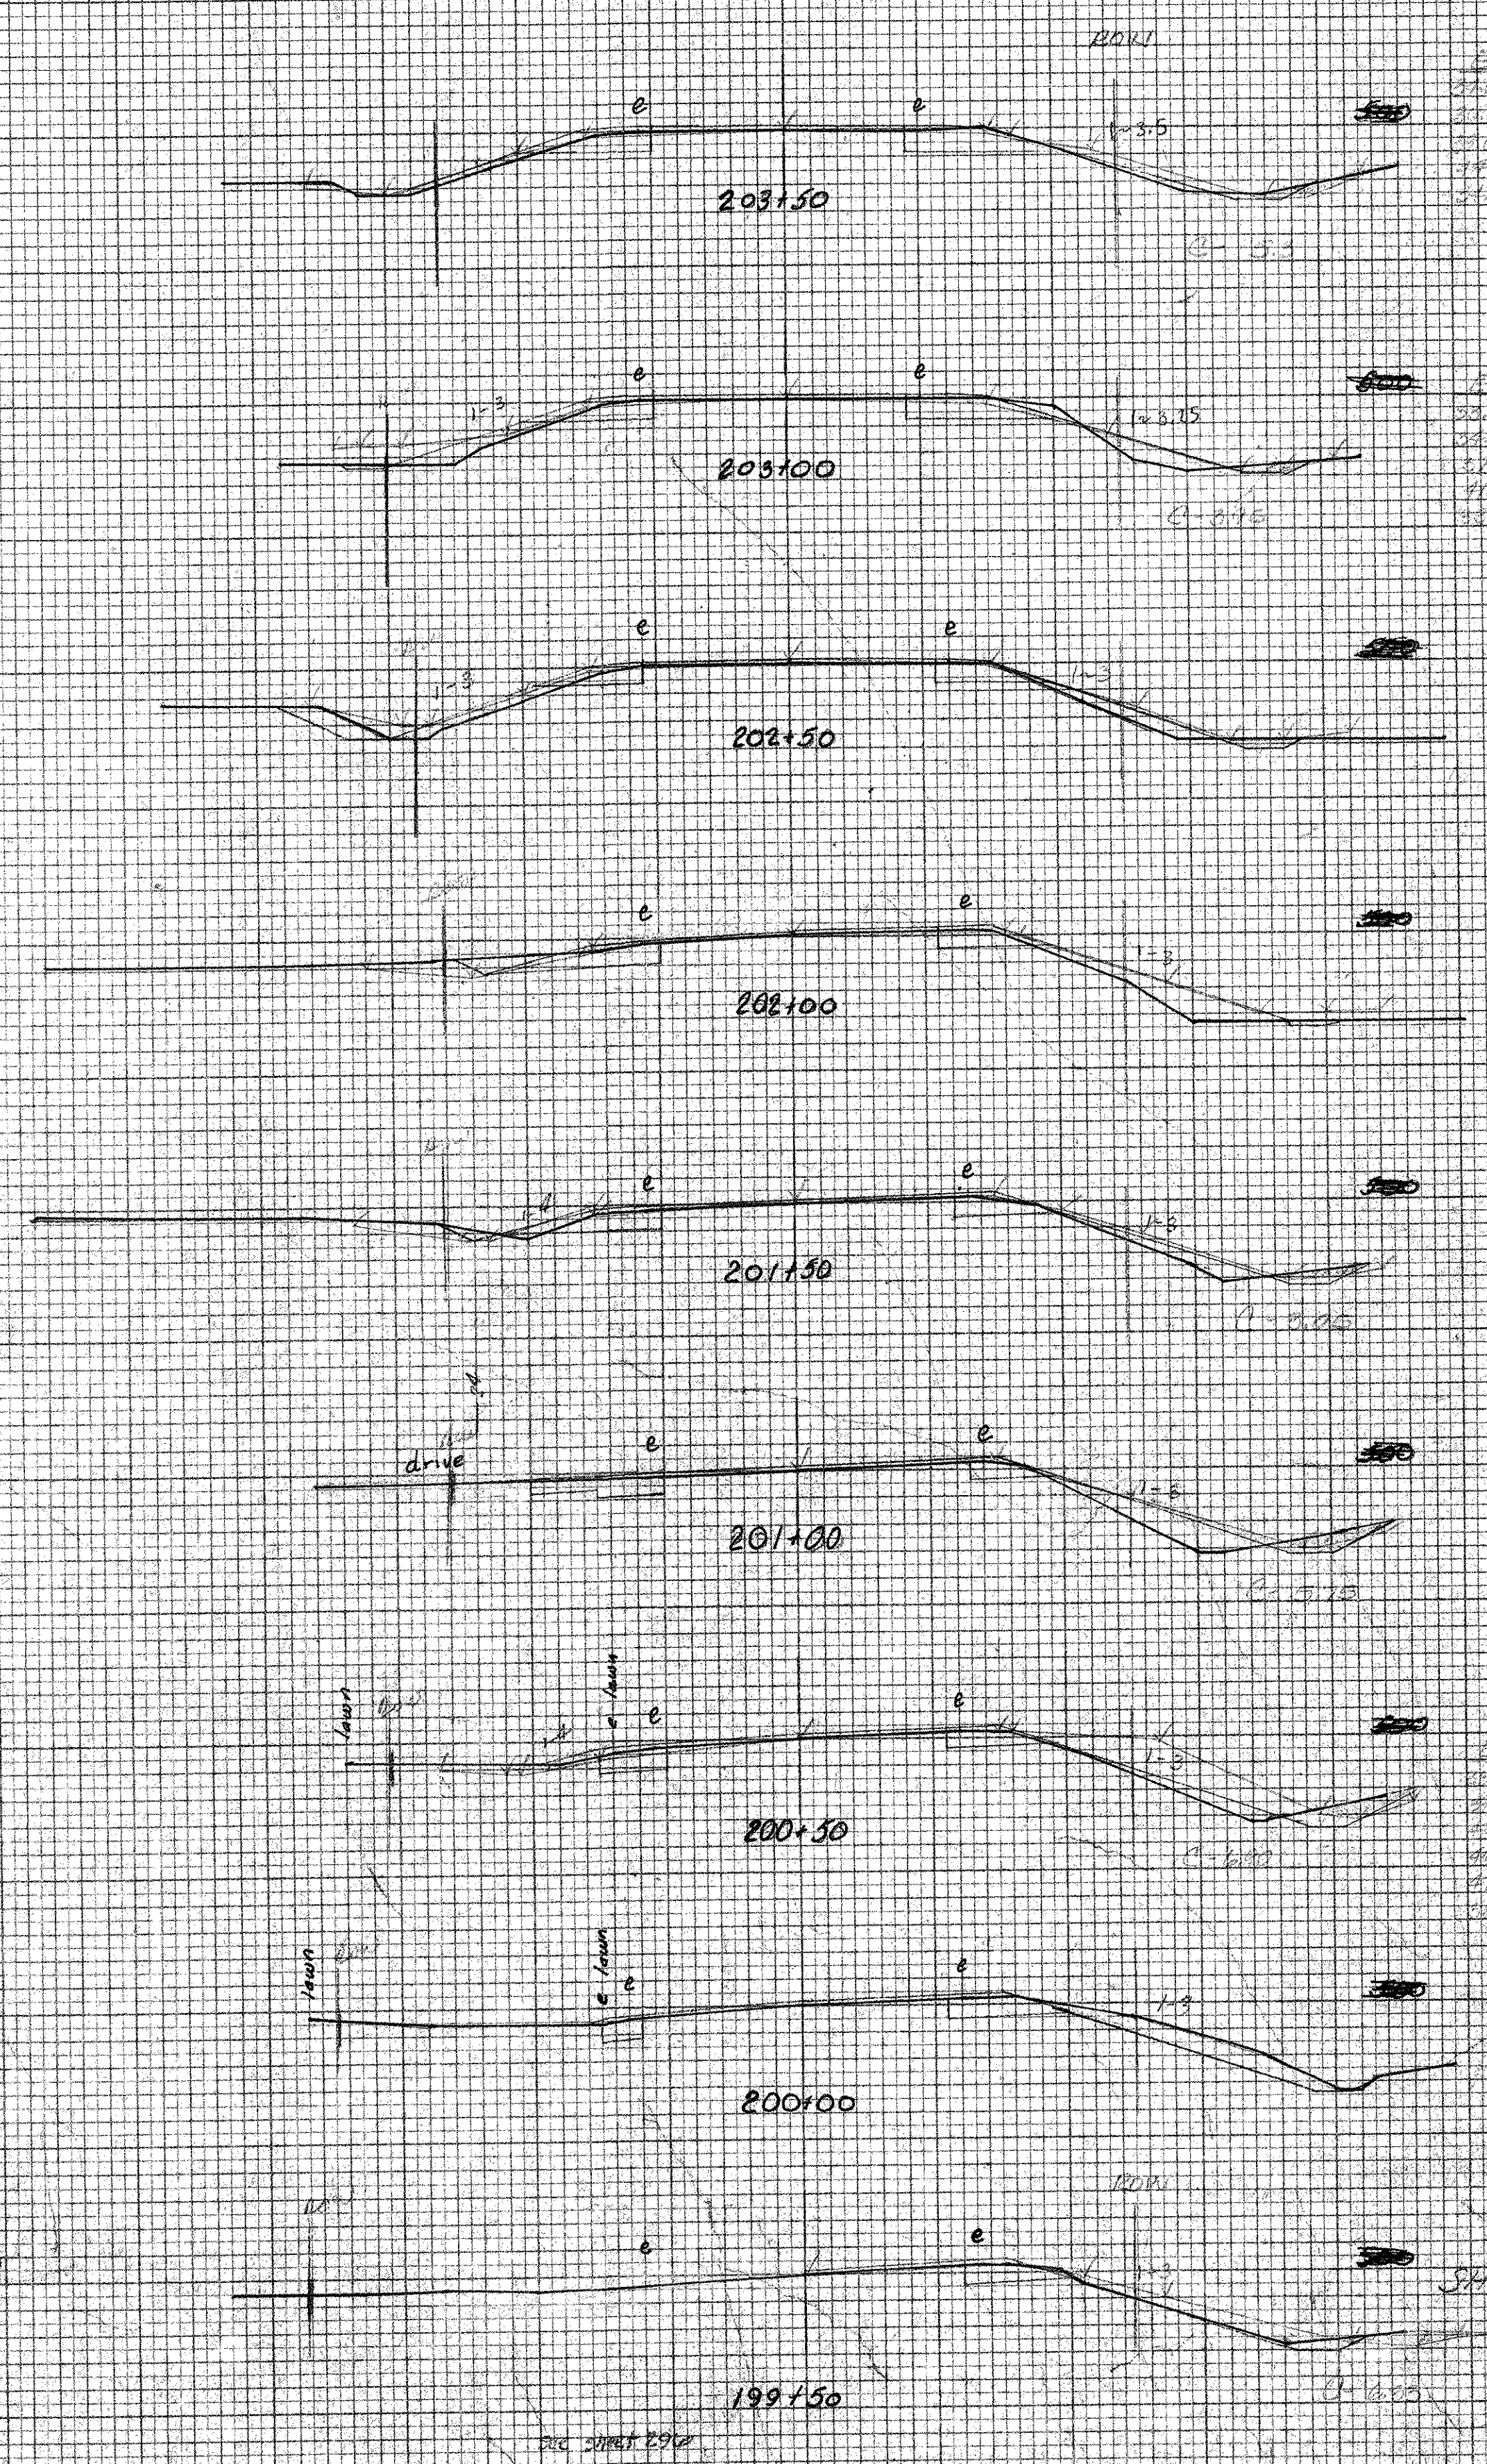
Station	Proposed	Existing
199+50	410	410
200+0	410	410
200+5	410	410
201+0	410	410
201+5	410	410
202+0	410	410
202+5	410	410
203+0	410	410
203+5	410	410

SHORTLY FOR PORT ADDITION
 F 017-112
 195+00 - 203+50
 Original Sections
 1/17/21