




193+80 LT ~ 199+45 LT  
Construct Special Ditch (Common)

193+64 LT  
Construct Drive (16' Gravel)  
New 15" x 34" RCP Class III or CSP, 064"

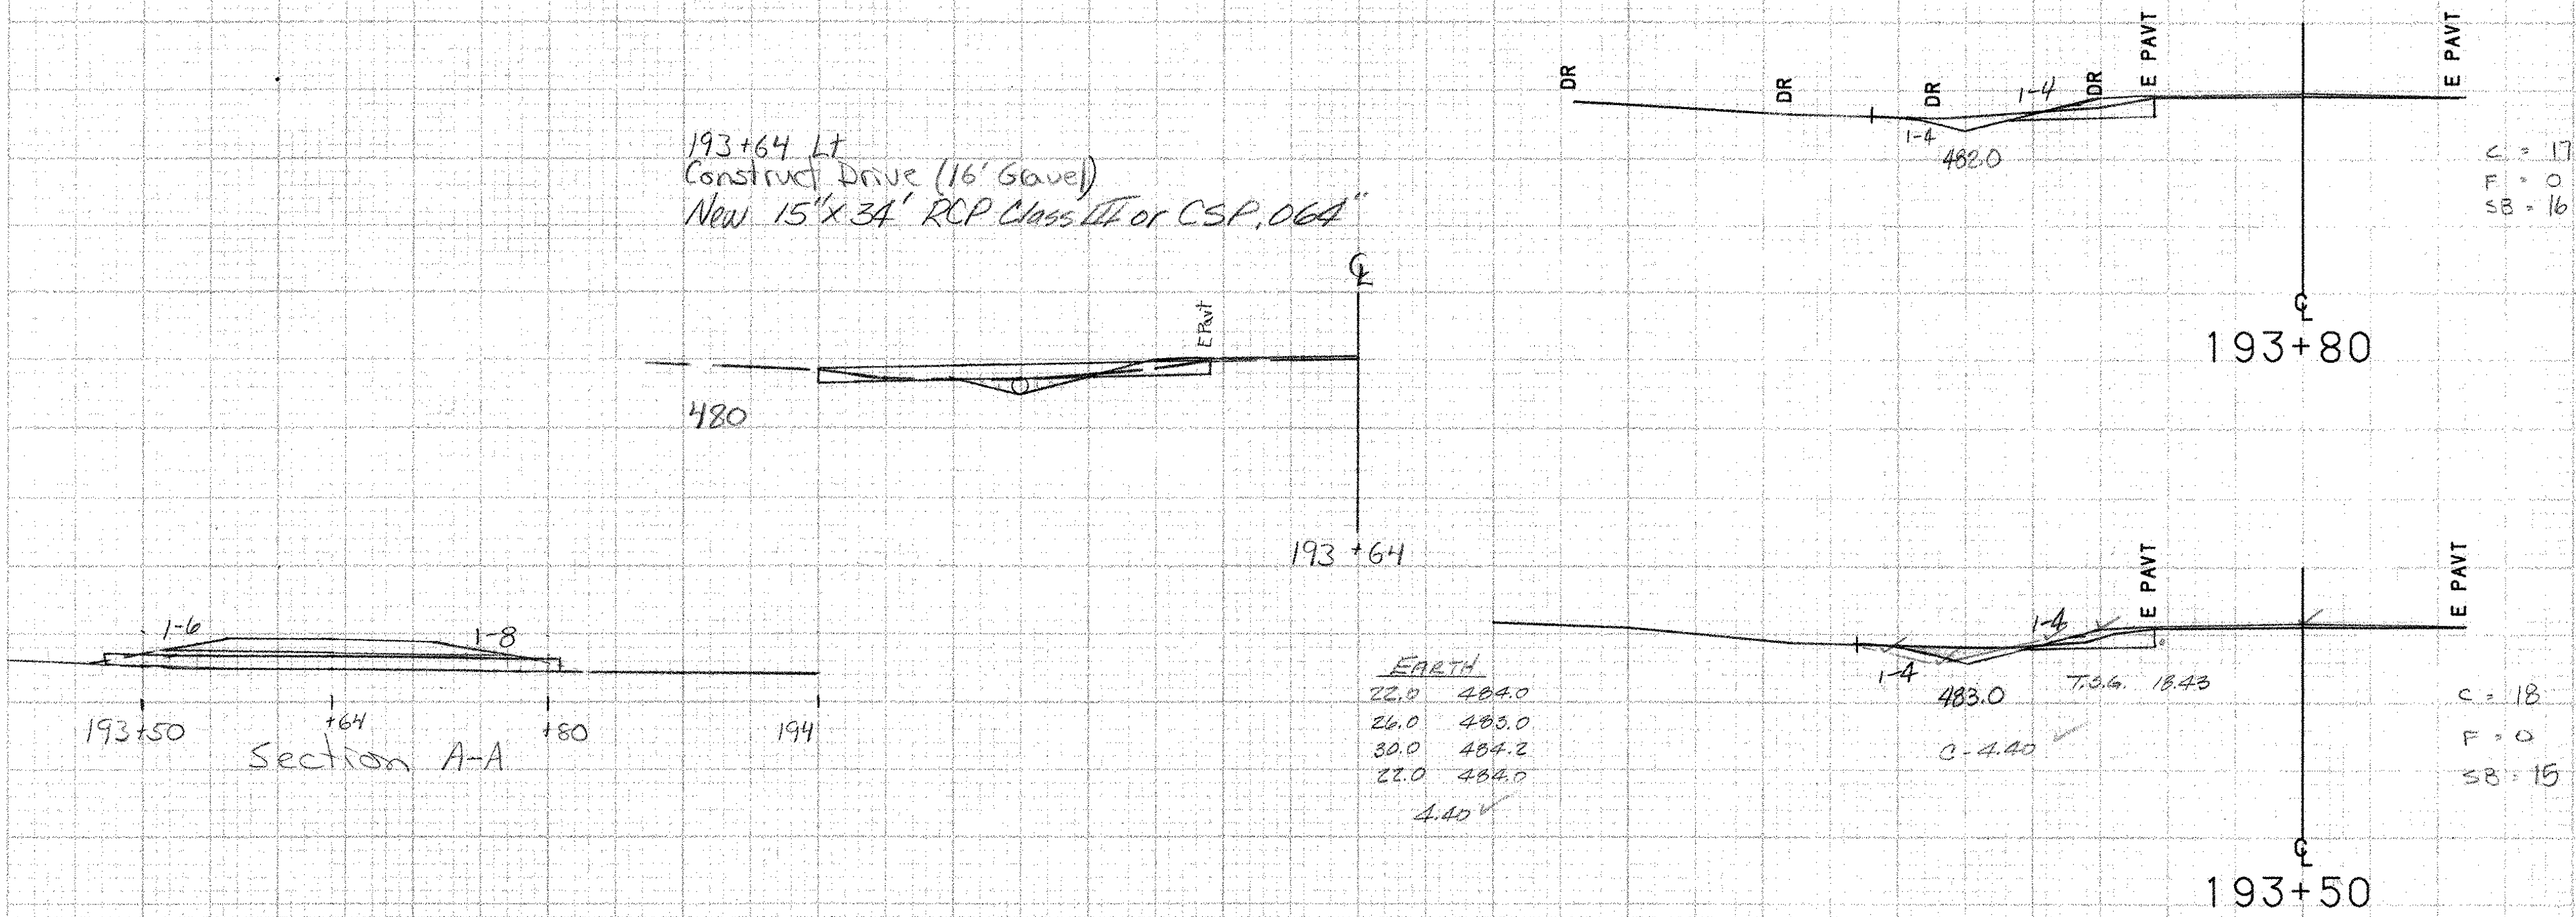

Earth	
22.0	484.0
26.0	483.0
30.0	484.2
22.0	484.0
4.40 ✓	

193+00 LT ~ 193+50 LT  
Construct Special Ditch (Common)

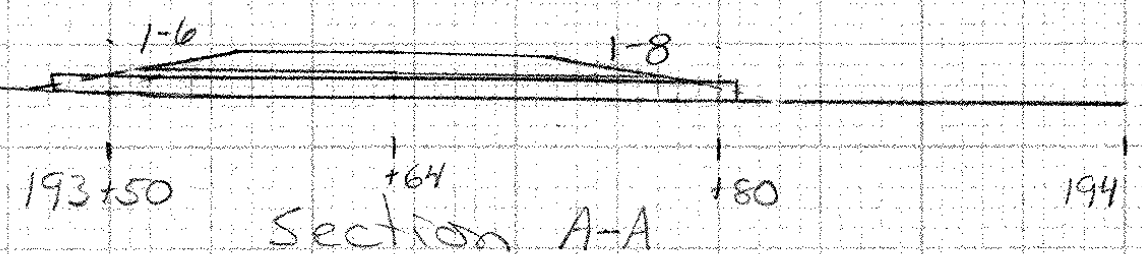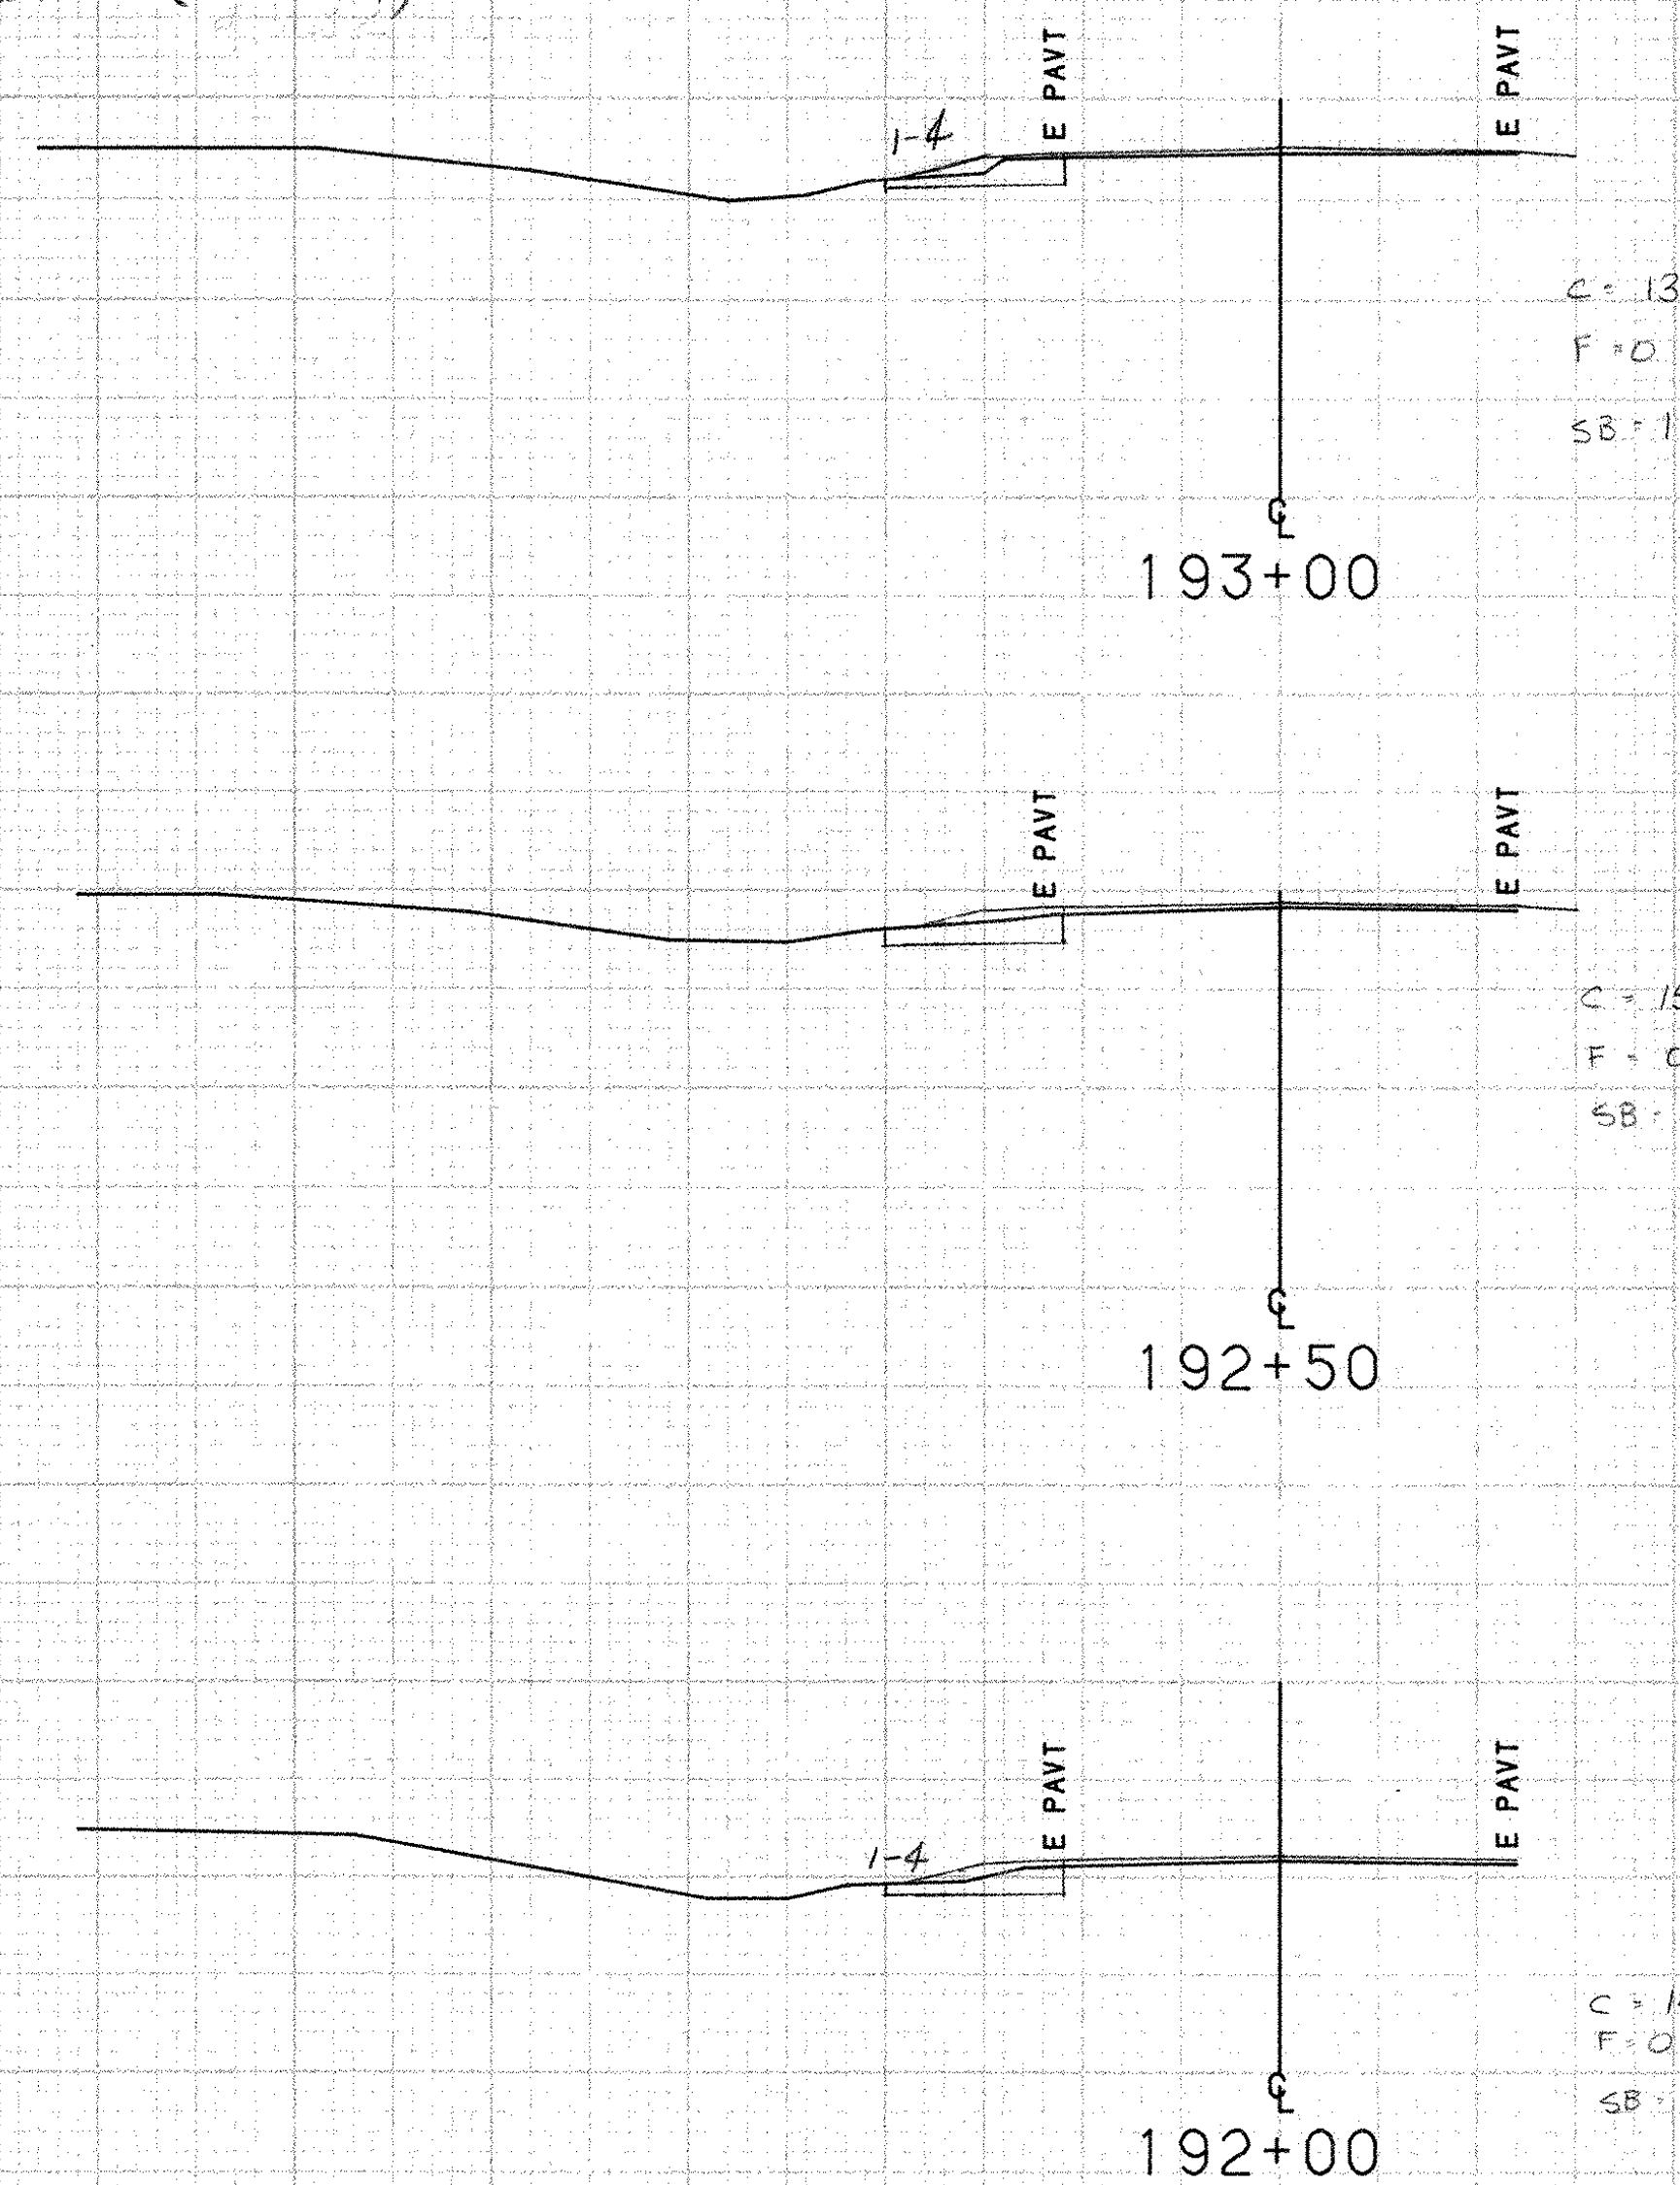

FROM STA.	192+00	TO STA.	193+80
PROJECT NAME	SHOREHAM-BRIDPORT-ADDISON		
NO.	F017-1 (2)	PLOTTED	05/27/88
SURVEYED BY	MOREAU	05/88	0130
SHEET	293	OF 420 SHEETS	SHEET 293 OF 477

SCALE 1" = 10 FEET

CUT-W W/G 4-21-92

Bridport MM 0.85 ~ MM 0.88