
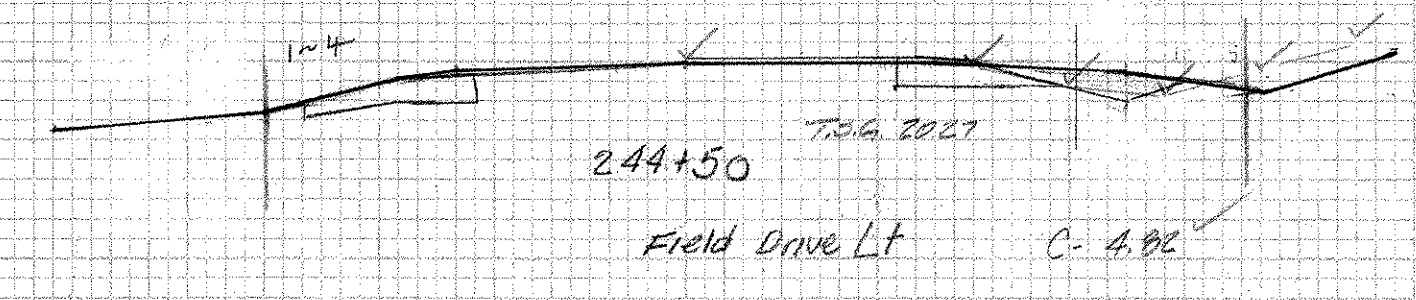


DATE: _____
 BY: _____
 ORIGINAL SURVEY NO. _____
 REVISIONS: _____
 PLOTTED: _____
 NOTE BOOK NO. _____
 TEMPLATE: _____
 AREA DIVISION: _____








DATE: _____
 BY: _____
 ORIGINAL SURVEY NO. _____
 REVISIONS: _____
 PLOTTED: _____
 NOTE BOOK NO. _____
 TEMPLATE: _____
 AREA DIVISION: _____

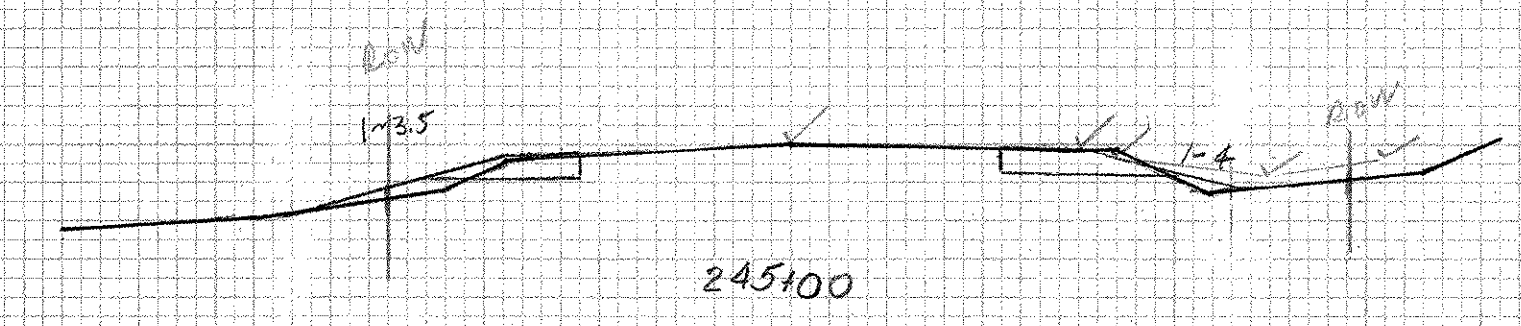

EARTH

20.0	499.6
24.0	498.2
28.0	496.8
32.0	495.4
36.0	494.0
40.0	492.6
44.0	491.2
48.0	489.8
52.0	488.4
56.0	487.0
60.0	485.6


4.86

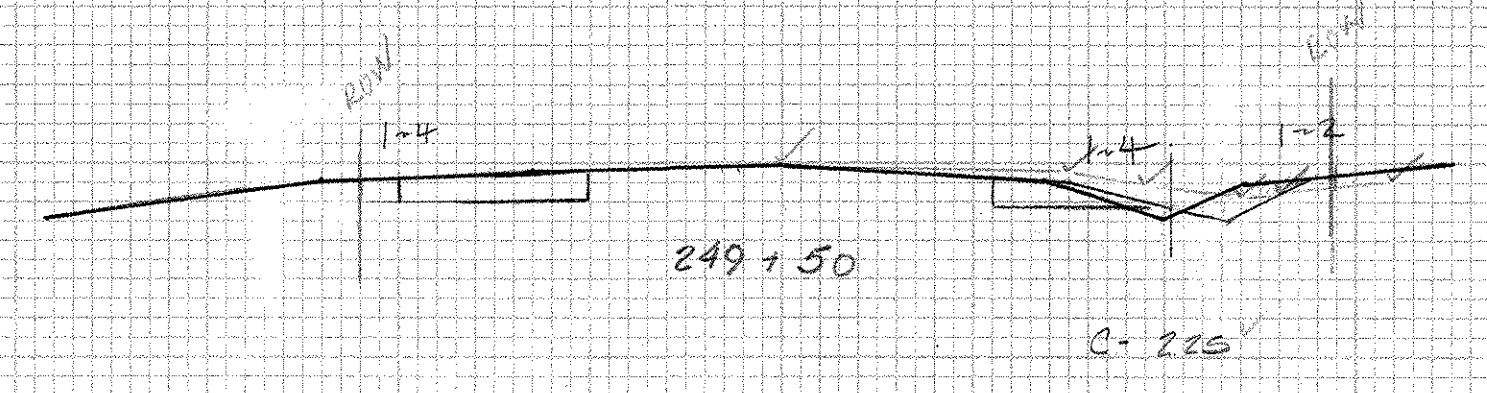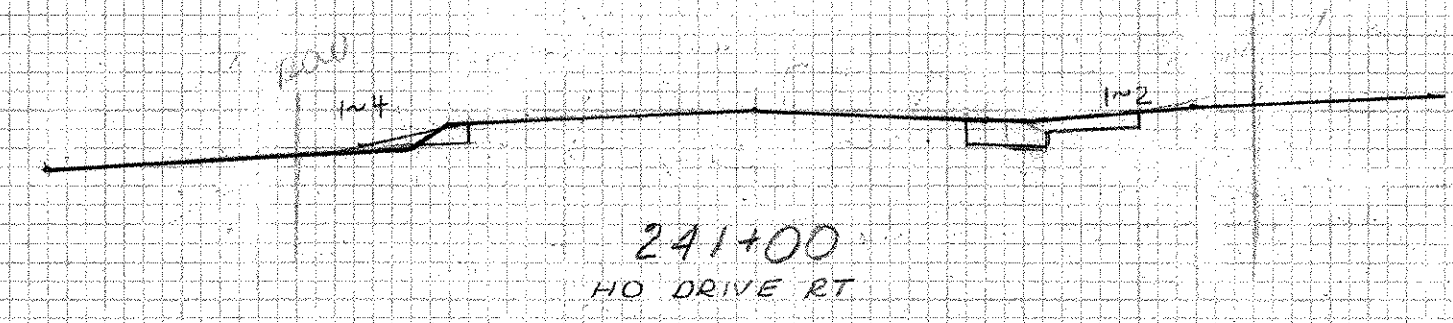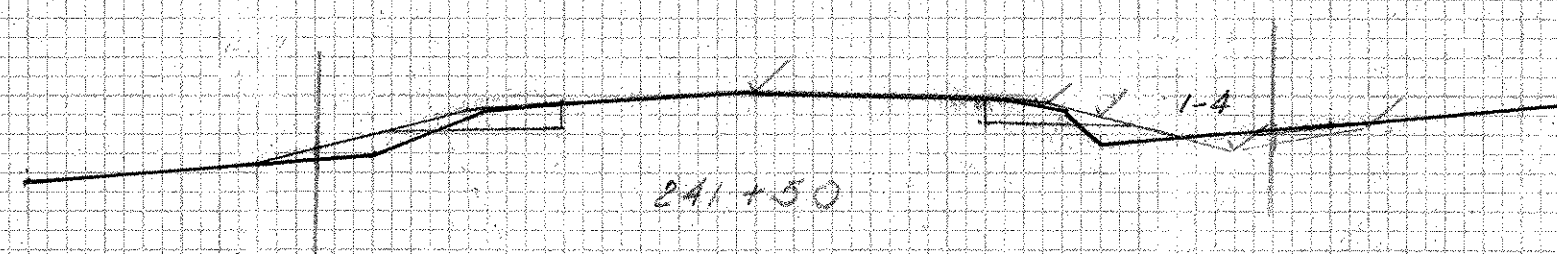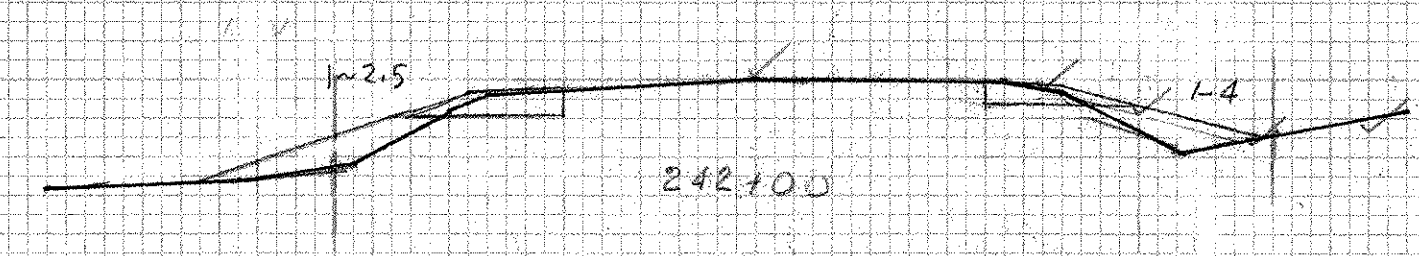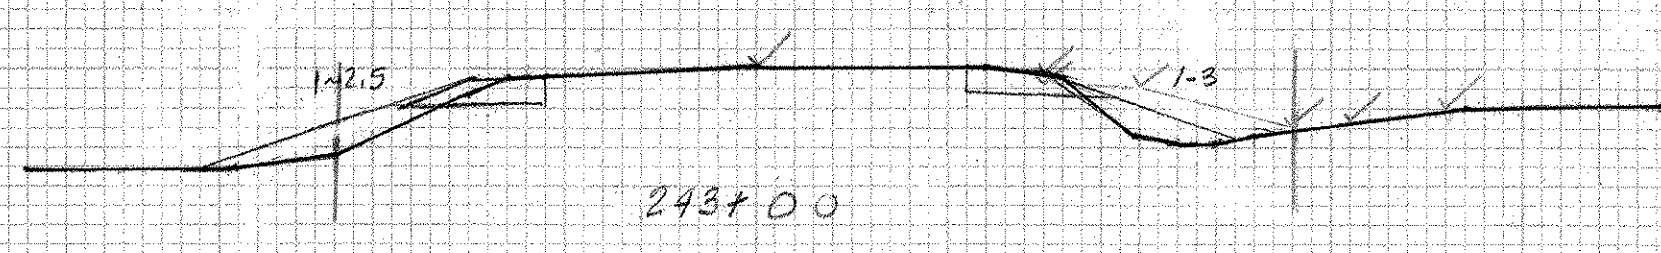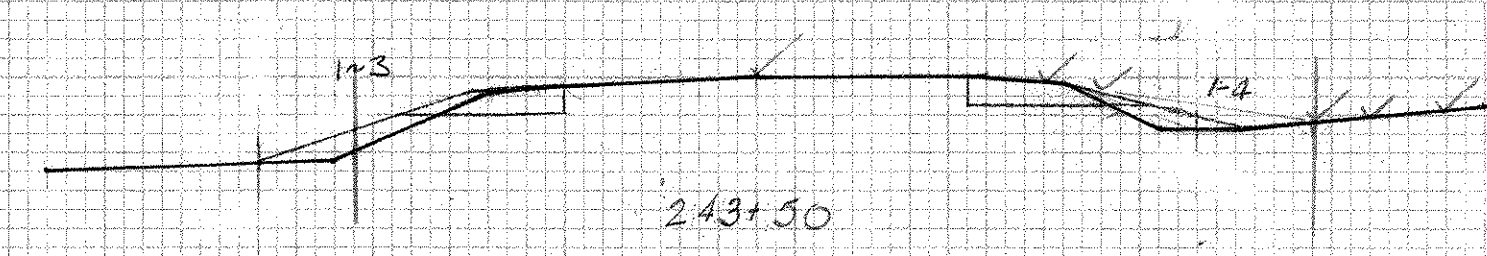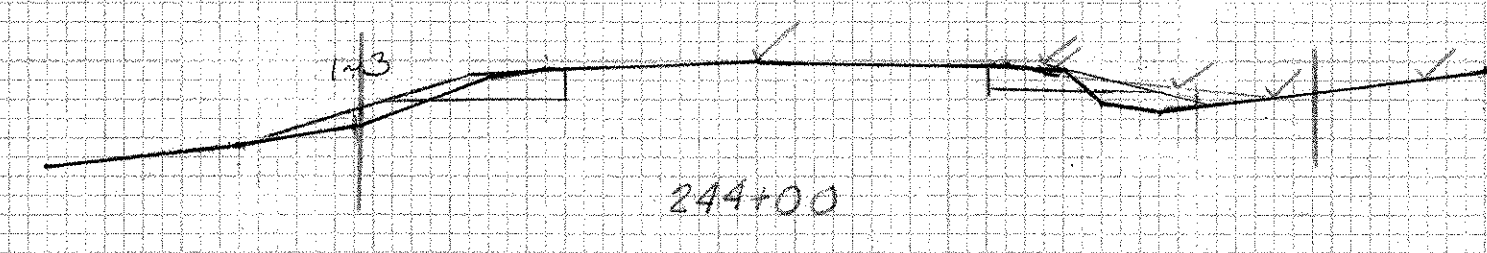

EARTH

26.0	496.6
24.0	496.2
22.0	495.8
20.0	495.4
18.0	495.0
16.0	494.6
14.0	494.2
12.0	493.8
10.0	493.4
8.0	493.0
6.0	492.6
4.0	492.2
2.0	491.8
0.0	491.4


2.35

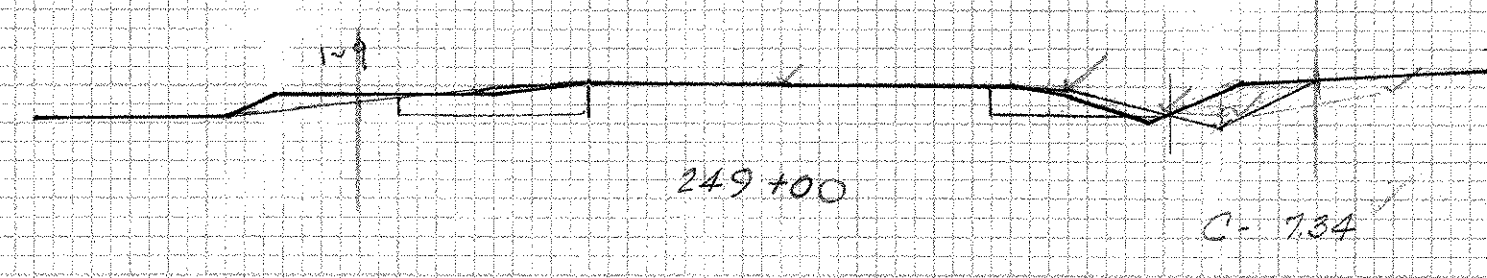

EARTH

20.0	498.6
24.0	498.2
28.0	497.8
32.0	497.4
36.0	497.0
40.0	496.6
44.0	496.2
48.0	495.8
52.0	495.4
56.0	495.0
60.0	494.6


7.84

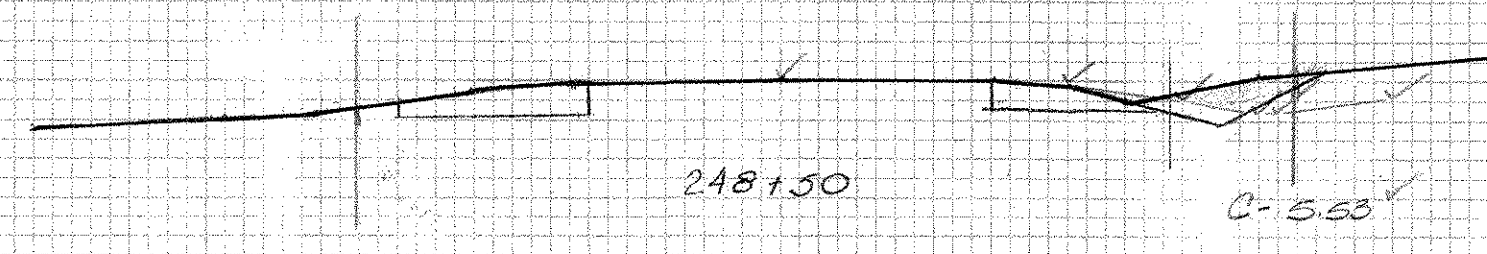

EARTH

20.0	499.1
24.0	498.6
28.0	498.1
32.0	497.6
36.0	497.1
40.0	496.6
44.0	496.1
48.0	495.6
52.0	495.1
56.0	494.6
60.0	494.1



5.60

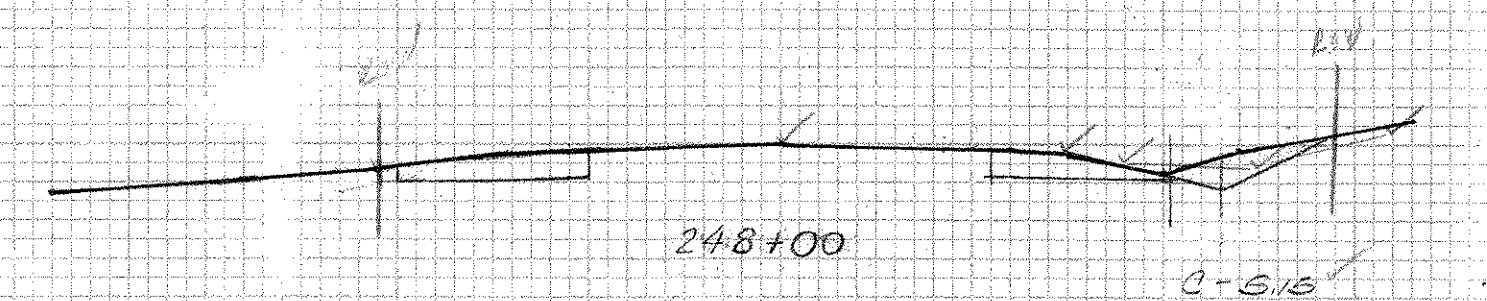

EARTH

22.0	499.0
24.0	498.7
26.0	498.4
28.0	498.1
30.0	497.8
32.0	497.5
34.0	497.2
36.0	496.9
38.0	496.6
40.0	496.3
42.0	496.0
44.0	495.7
46.0	495.4
48.0	495.1
50.0	494.8
52.0	494.5
54.0	494.2
56.0	493.9
58.0	493.6
60.0	493.3

5.16

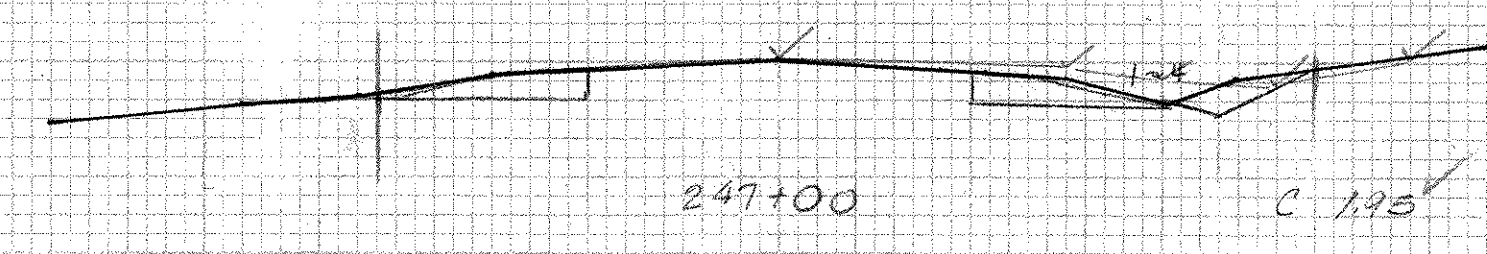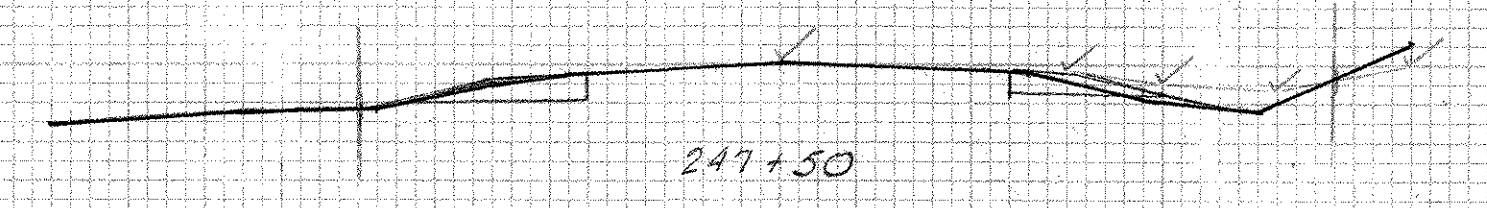

EARTH

28.0	499.0
26.0	498.6
24.0	498.2
22.0	497.8
20.0	497.4
18.0	497.0
16.0	496.6
14.0	496.2
12.0	495.8
10.0	495.4
8.0	495.0
6.0	494.6
4.0	494.2
2.0	493.8
0.0	493.4

1.95

